


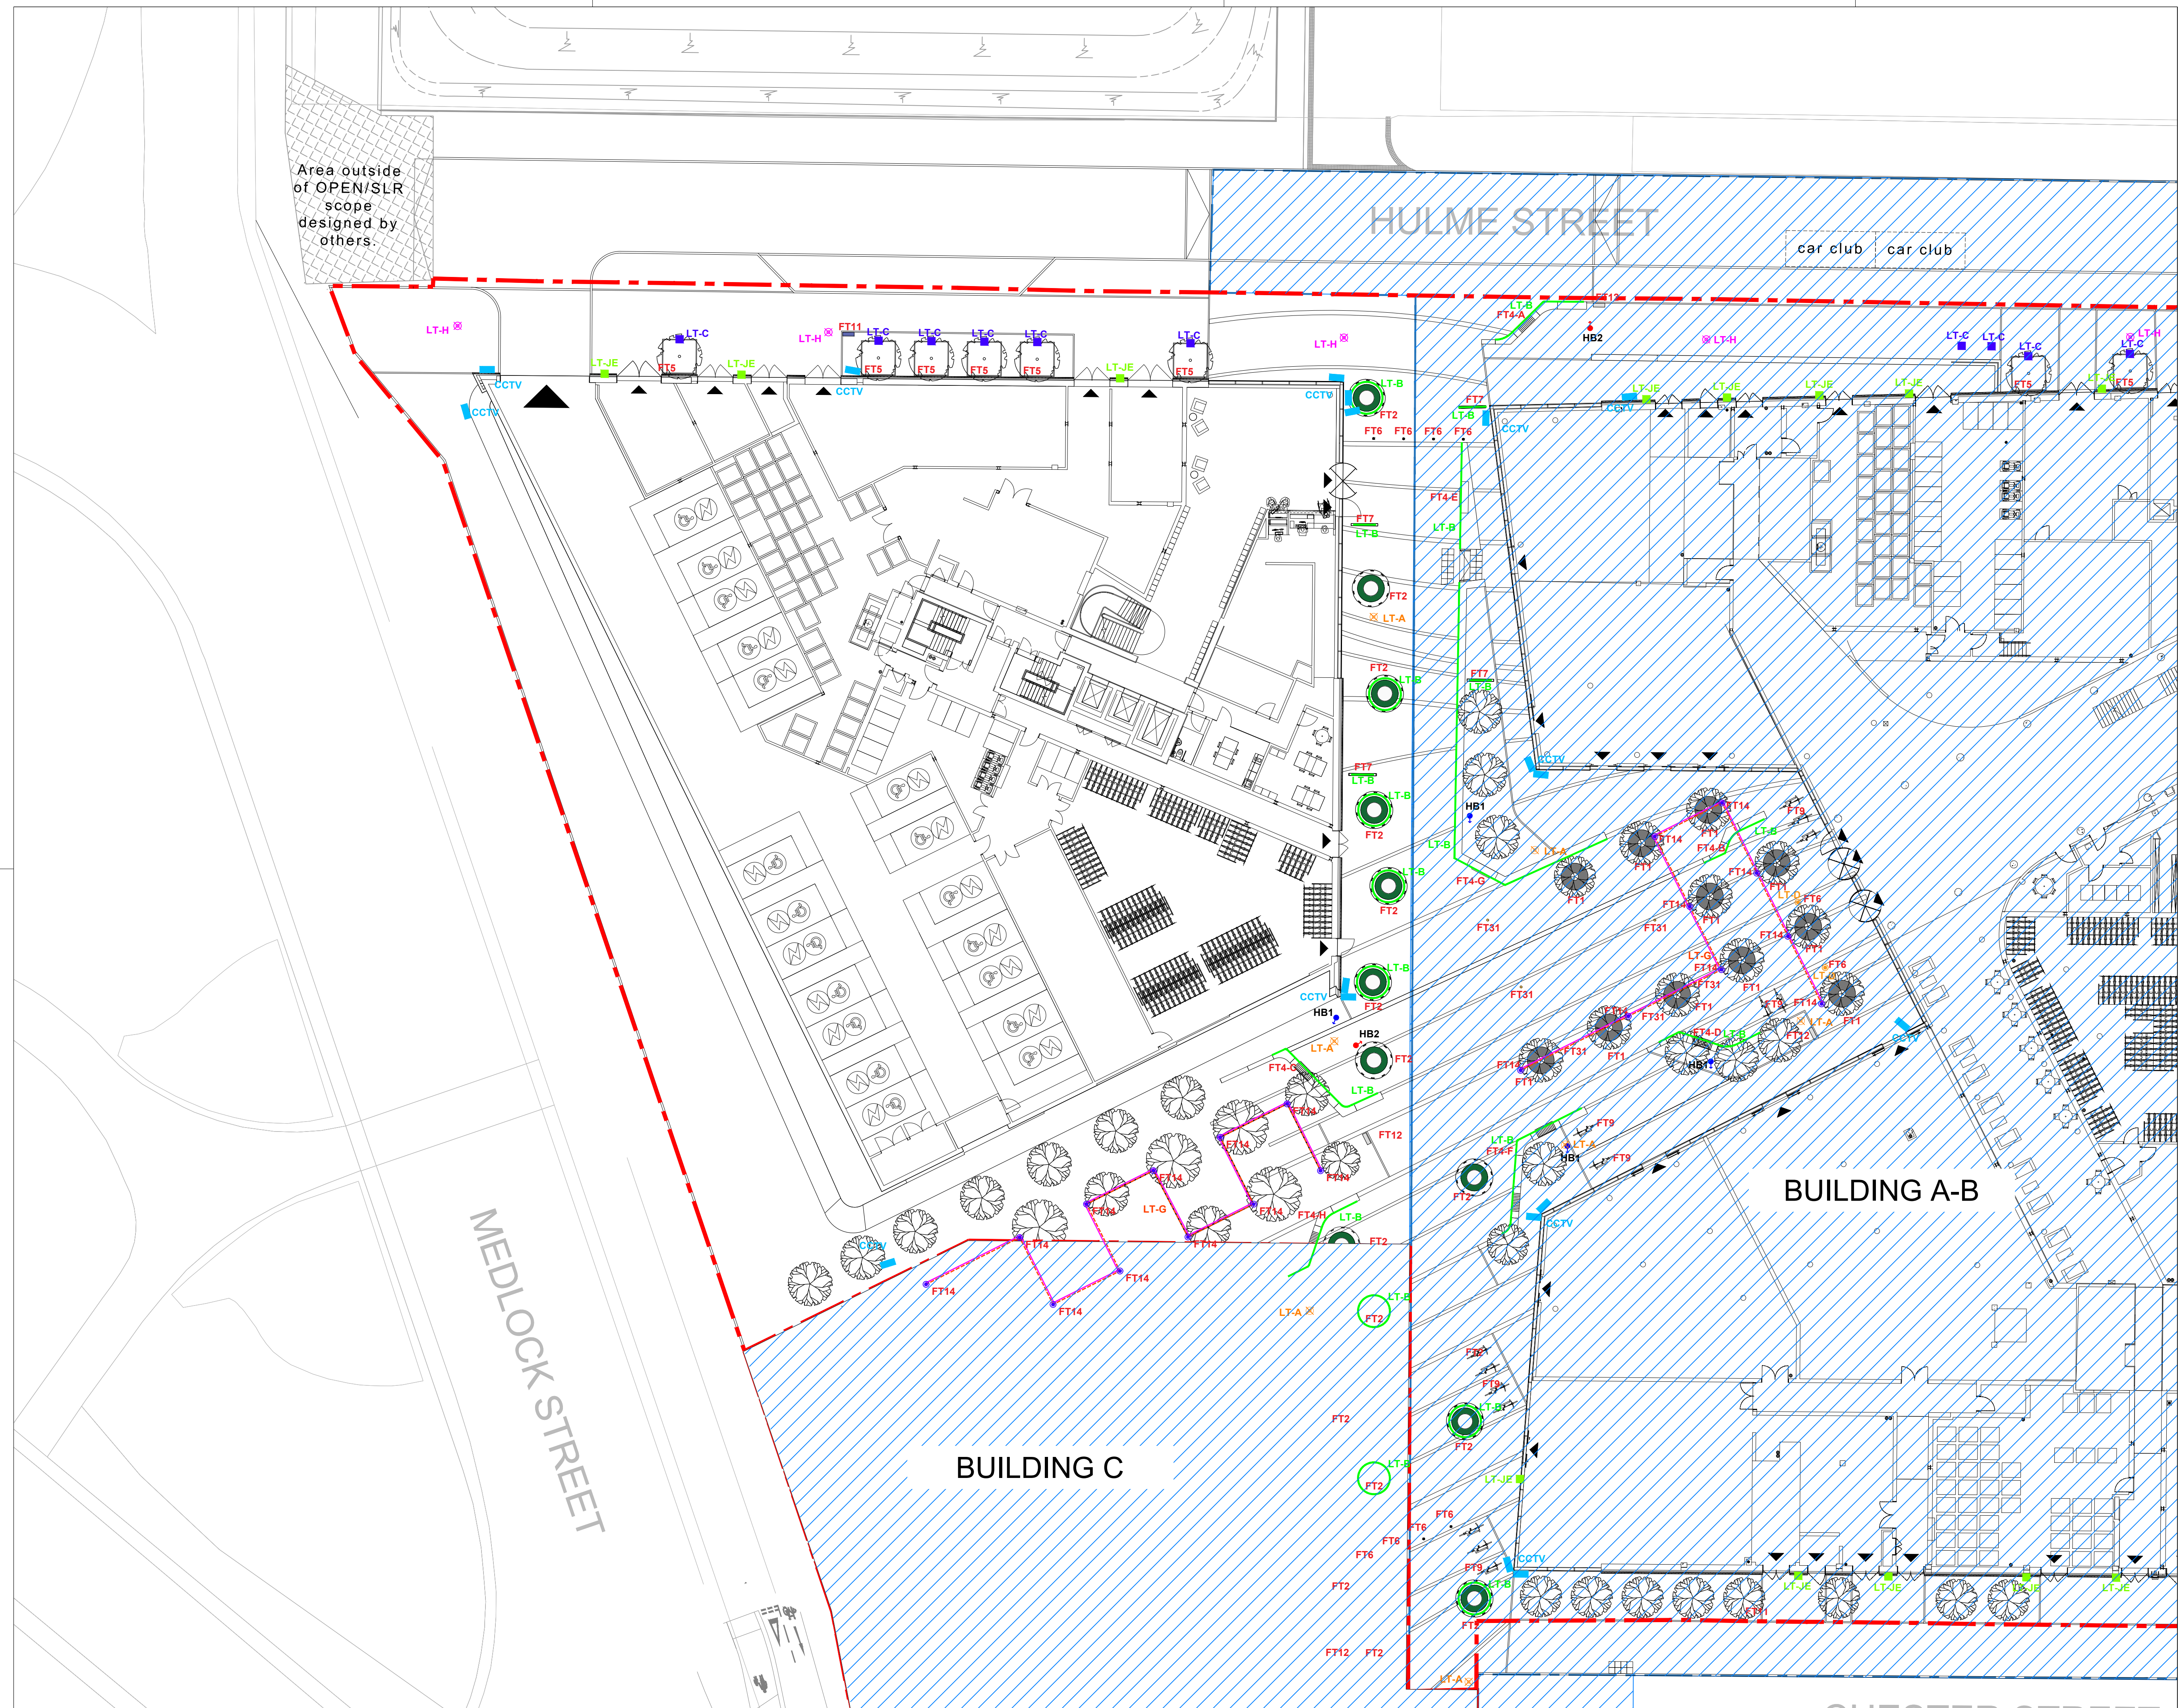

NOTES

- This drawing is to be read in conjunction with all other drawings and specifications.
- Do not scale off this drawing. Written dimensions to be taken only.
- Any discrepancies found between this drawing and other drawings and specifications in the construction documents must be referred to the Landscape Architect prior to work commencing.
- This drawing must not be copied in whole or in part without prior written consent of Optimised Environments Ltd.
- Survey information is based upon aspect surveyors Topographical as Survey.

CDM INFORMATION

KEY PLAN

11	AS BUILT	CO	23.06.25
10	Extent of Green Slope Reduce	CO	16.02.25
09	FT UPDATED AS PER ADJACENT DEV	SB	15.11.24
08	GF UPDATES	SB	14.08.24
07	BOLLARDS ADDED & LIGHTING & WINDRAFFLE UPDATED	SB	17.05.24
06	REMOVED TREES	SB	19.09.23
05	TREES REINSTATED AND FT UPDATED	SB	23.08.23
04	Architectural Update	CO	03.08.23
03	Architectural Update	CO	19.08.23
02	Lighting Added	CO	27.04.23
01	Drawing number update	CO	24.02.23
-	STAGE 4	CO	22.03.23
Issue	Revision	Initial	Date

open
optimised environments

optimised environments ltd
2nd Floor | Quarterline Two | 21 Lister Square | Edinburgh | EH3 9GL
t: 0131 221 9830 | e: optimisedenvironments.com

EDINBURGH

LONDON
Warford Court | 23 Throgmorton Street | London | EC2N 3AT
t: 020 79474662 | e: optimisedenvironments.com

MANCHESTER
13 Swan Street | Manchester | M4 5JJ
t: 0161 996 7550 | e: optimisedenvironments.com

Client
Downing Living (Manchester) Ltd

Project
PLOT 11 FIRST STREET SOUTH
Manchester

Drawing Title
**BUILDING D FURNITURE PLAN
PUBLIC REALM
SHEET 1 OF 1**

Scale Bar
2m 4m 6m 8m 10m
North

Scale: 1:100@A1 Date: Jan 2022

By: CO Status: AS BUILT

Checked: AW Approved: AW

Drawing Number
M90183_D_L202

Rev
11

Computer File: R:\Projects\2019\M90183_FirstStreet\AUTOCAD\SHEETS\PHASE D