



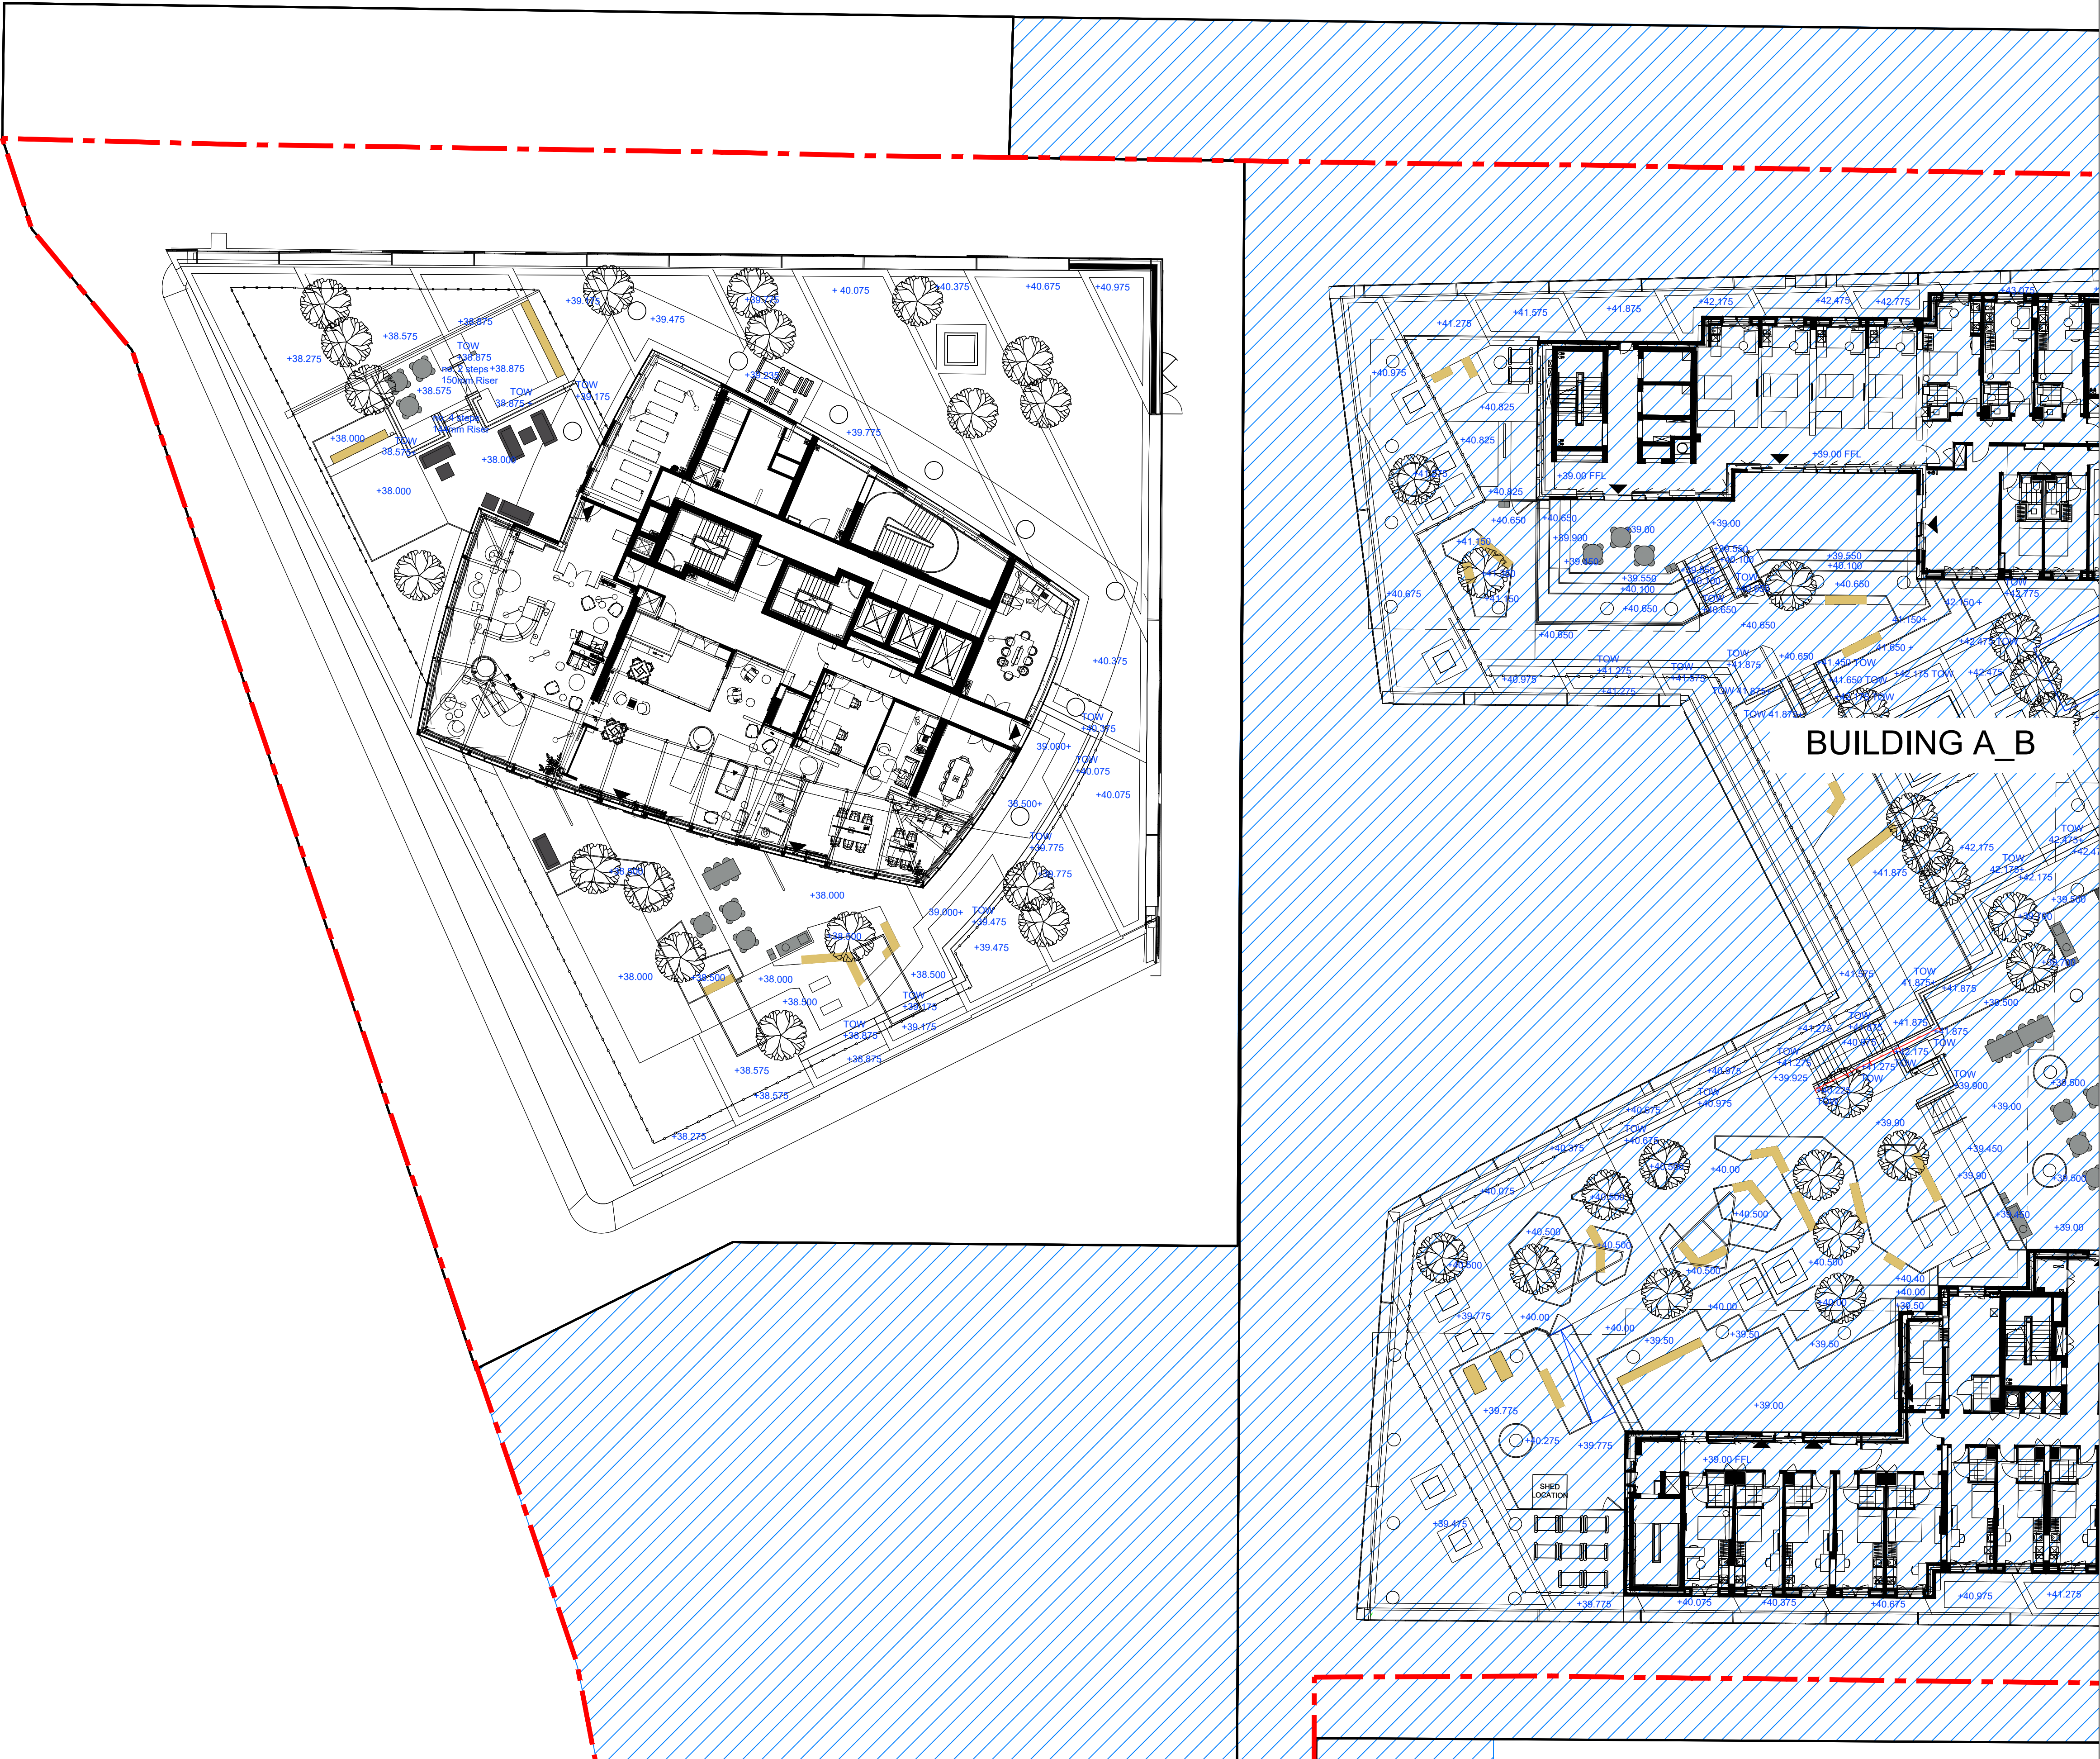

- NOTES
1. This drawing is to be read in conjunction with all other drawings and specifications.
 2. Do not scale off this drawing. Written dimensions to be taken only.
 3. Any discrepancies found between this drawing and other drawings and specifications in the construction documents must be referred to the Landscape Architect prior to work commencing.
 4. This drawing must not be copied in whole or in part without prior written consent of Optimised Environments Ltd.
 5. Survey information is based upon aspect surveyors Topographical as Survey.

CDM INFORMATION

KEY PLAN

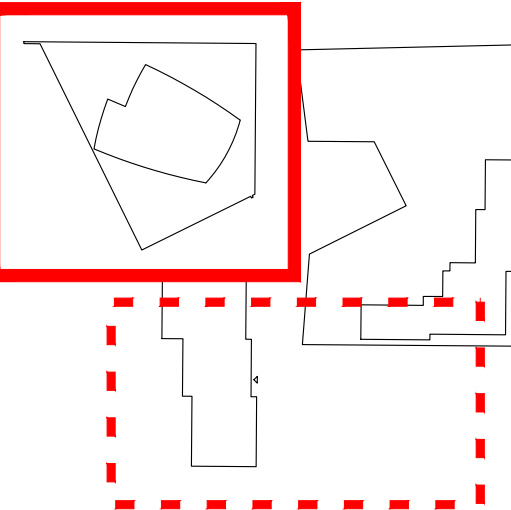

17	AS BUILT	CO	23.06.25
16	Line work and Levels updated	SB	19.03.25
15	Trees relocated and step level updated	SB	11.02.25
14	Podium entrance relocated & wall moved	CO	16.09.24
13	Podium entrance relocated	CO	02.09.24
12	Landscape amended	SB	14.08.24
11	Line work and levels. Updated	SB	22.05.24
10	Levels updated in accordance with client instruction	SB	29.01.24
09	Line work and levels. Updated	SB	09.01.24
08	Line work and levels. Updated	SB	11.12.23
07	Line work Updated	SB	19.09.23
06	TREES REINSTATED	SB	23.08.23
05	Architectural Update	CO	19.08.23
04	Architectural Update	CO	27.04.23
03	Podium Layout Update	CO	22.02.23
02	DWG name type	CO	04.01.23
-	STAGE 4 UPDATE	CO	15.12.22
Issue	Revision	Initial	Date

open
optimised environments

optimised environments ltd
EDINBURGH 2nd Floor | Quartermile Two | 2 Lister Square | Edinburgh | EH3 9GL
t: 0131 221 9820 | e: optimisedenvironments.com
LONDON Wanford Court | 29 Throgmorton Street | London | EC2N 3AT
t: 020 79474662 | e: optimisedenvironments.com
MANCHESTER 13 Swan Street | Manchester | M4 5JZ
t: 0161 696 7550 | e: optimisedenvironments.com

Client
Downing Living (Manchester) Ltd

Project
PLOT 11 FIRST STREET SOUTH
Manchester

Drawing Title
**BUILDING D
LEVELS & GRADES PODIUM**

Scale Bar
2m 4m 6m 8m 10m
North

Scale: 1:200@A1 Date: Jan 2022

By: CM Status: AS BUILT

Checked: AW Approved: AW

Drawing Number
M90183_D_L610 Rev
17

Computer File: R:\Projects\2019\M90183_FirstStreet\AUTOCAD\SHEETS\PHASE D