


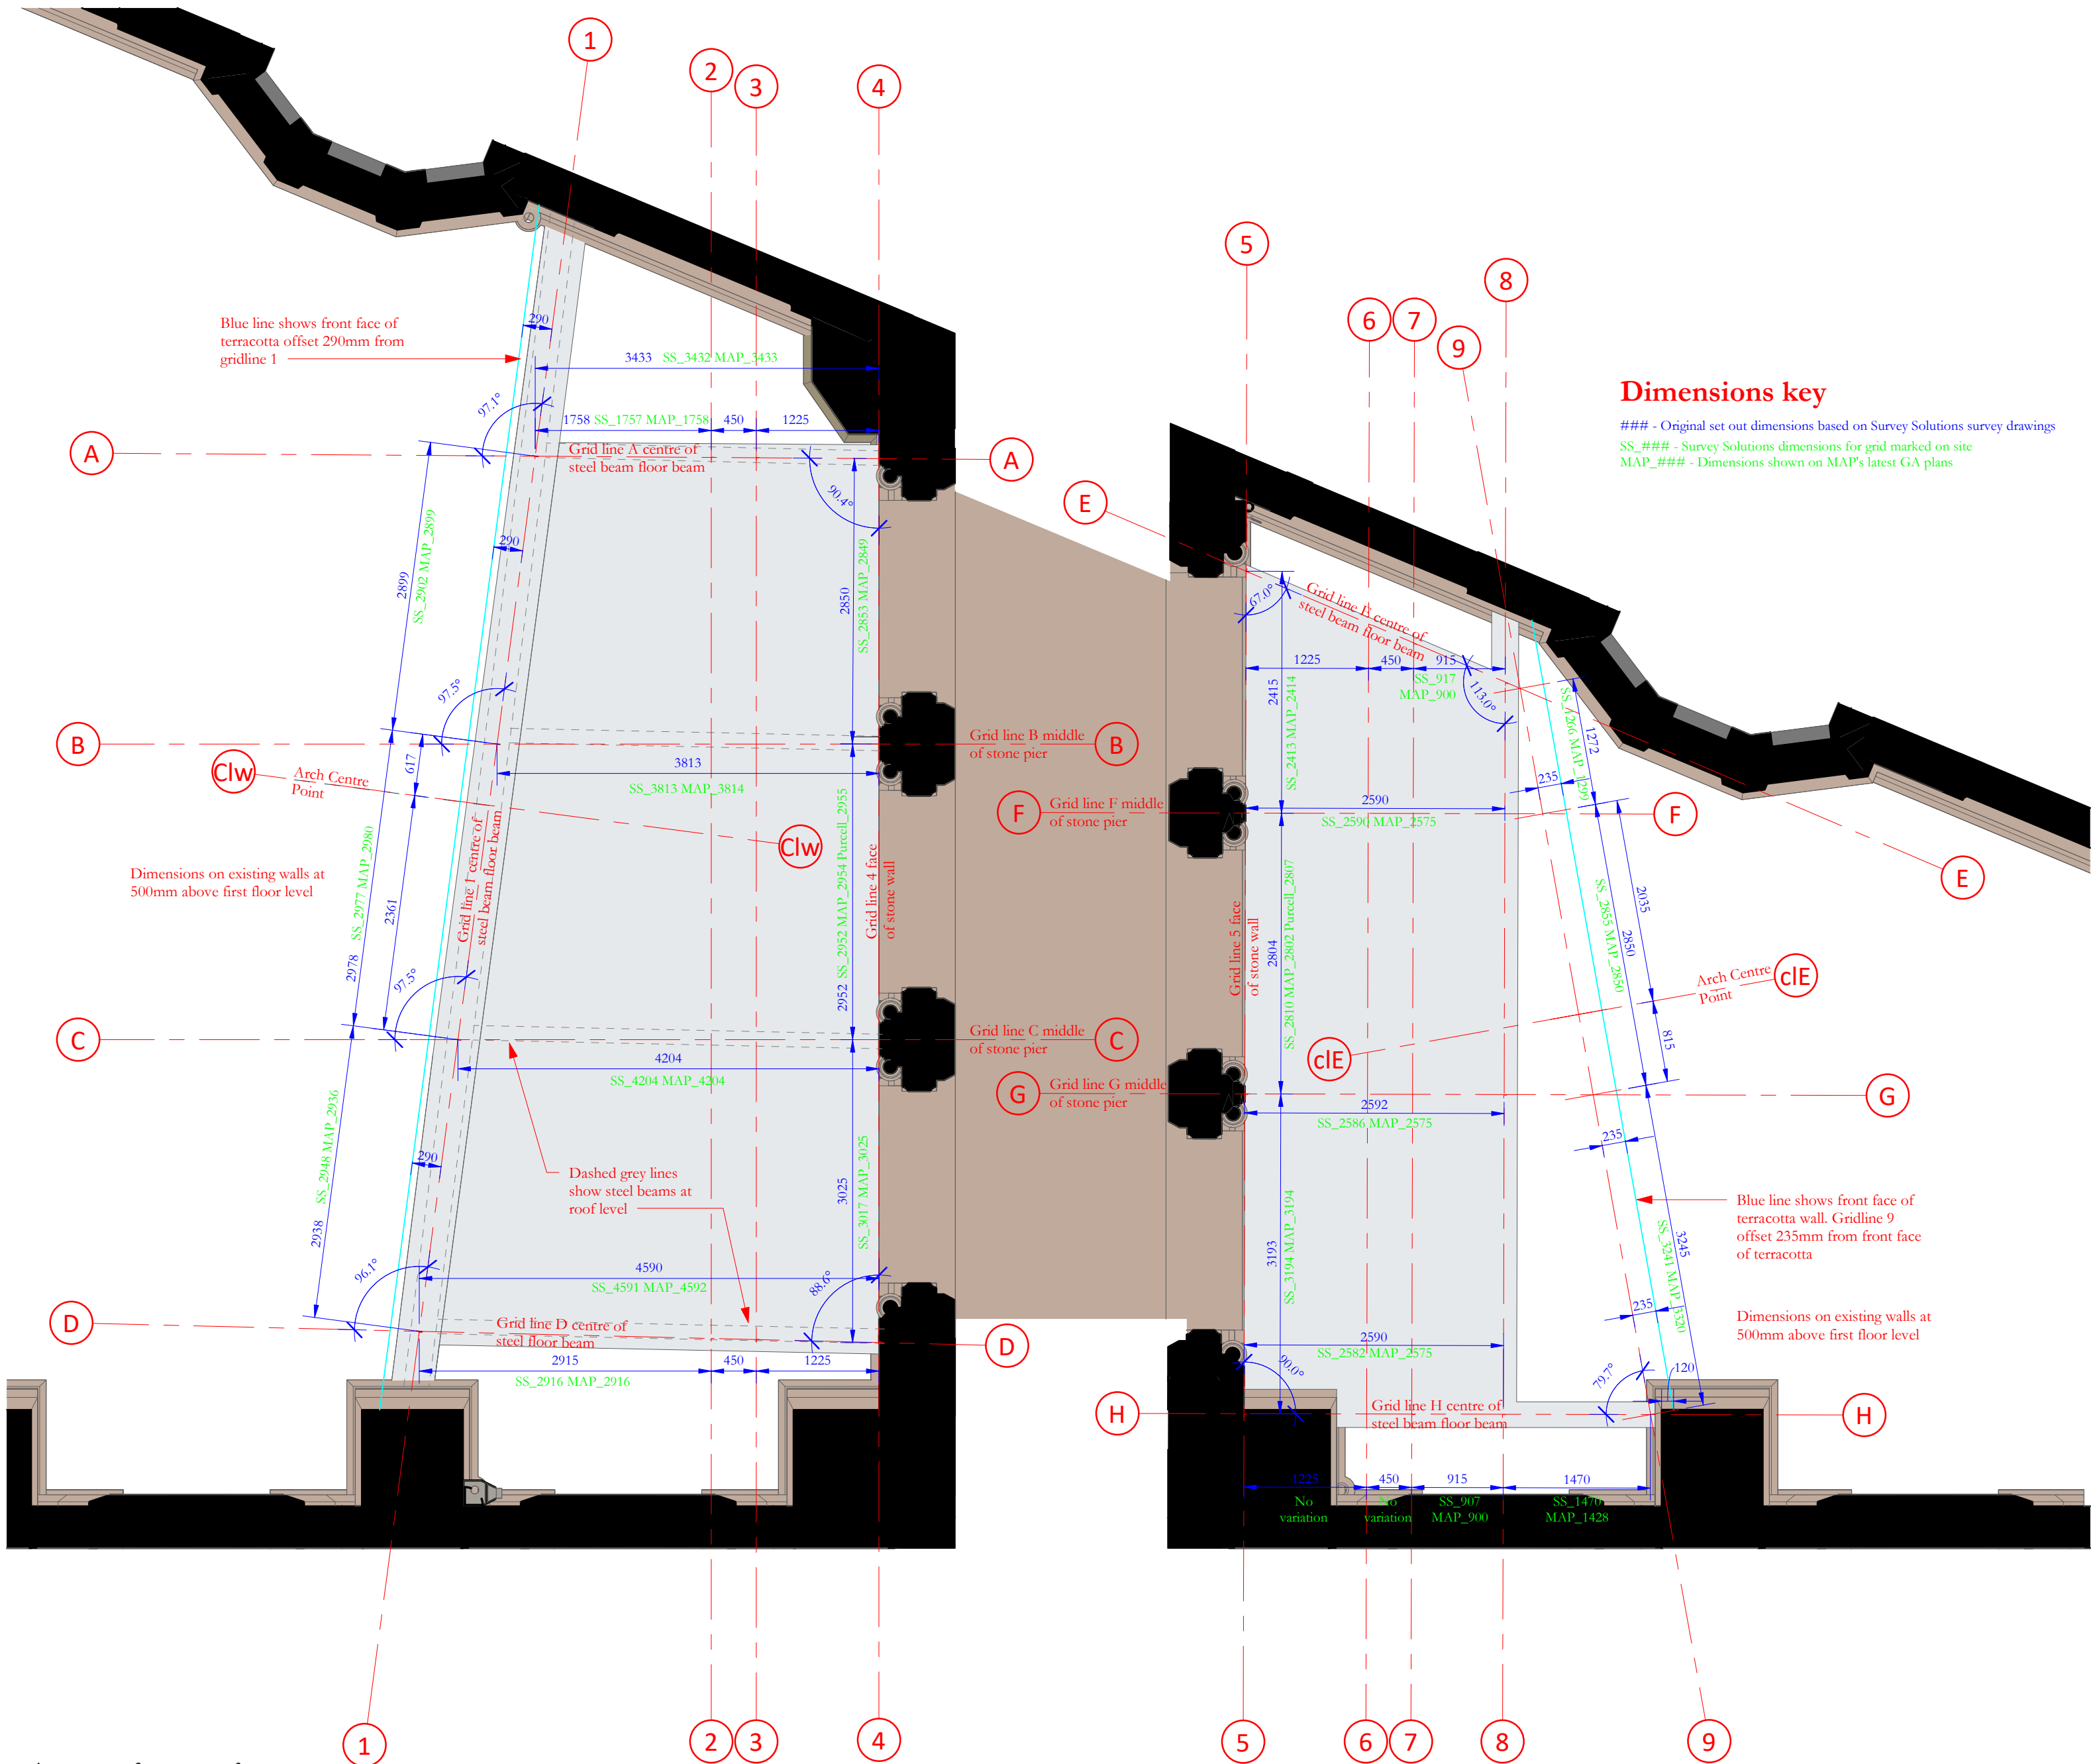

Scale Bars to be used as guidance only - refer to sheet size below									
1:100	mm	1000	3000	5000	7000				
1:200	mm	5000	8000	10000	12000				
1:500	M	5	15	25	35				
1:1250	M	10	30	50	70	90			

Notes:
Drawings are based on survey data and may not accurately represent what is physically present.
Do not scale from this drawing. All dimensions are to be verified on site before proceeding with the work.
All dimensions are in millimeters unless noted otherwise.
Purcell shall be notified in writing of any discrepancies.

Revision 03: Dimension for arch centre amended on east and west elevation 3mm on west side and 6mm on east side

Revision 02: Survey Solutions' dimensions for site marked grid and MAP's dimensions shown on GA plans shown in green below original setting out dimensions for comparison

Revision 01: Grid line B, C, F and G dimensions amended, Grid line 9 relocated, and position of arch centres adjusted based on site checks

-	30/03/2023	JC	GR	First Issue
01	22/03/2024	GR	JRC	See note in revision cloud
02	28/10/2024	GR	JRC	See note in revision cloud
03	14/03/2025	JC	GR	See note in revision cloud
ISSUE	DATE	APPROVED	DRAWN	DESCRIPTION



Project Office, Room 308, Town Hall, MANCHESTER M60 2L1
+44 (0) 7970 097 432
www.purcelluk.com

PROJECT STATUS	RIBA STAGE 5		
CLIENT	MANCHESTER CITY COUNCIL		
PROJECT	OUR TOWN HALL		
DRAWING TITLE	Link Bridge Extension Setting Out Grid Plan at Level 01		
SIZE & SCALE	A2: 1 : 50		
DRAWING STATUS	S4 Construction		
JOB NUMBER	236959		
DRAWING NO.	OTH-PUR-EX-ZZ-DWG-A-4431 03		
REV			

© PURCELL 2019. PURCELL ® IS THE TRADING NAME OF PURCELL ARCHITECTURE LTD.