



NOTES


ALL DIMENSIONS TO BE CHECKED ON SITE PRIOR TO ANY MANUFACTURING OR FABRICATION AND ANY ANOMALIES TO BE BROUGHT TO THE ATTENTION OF THE ARCHITECT.

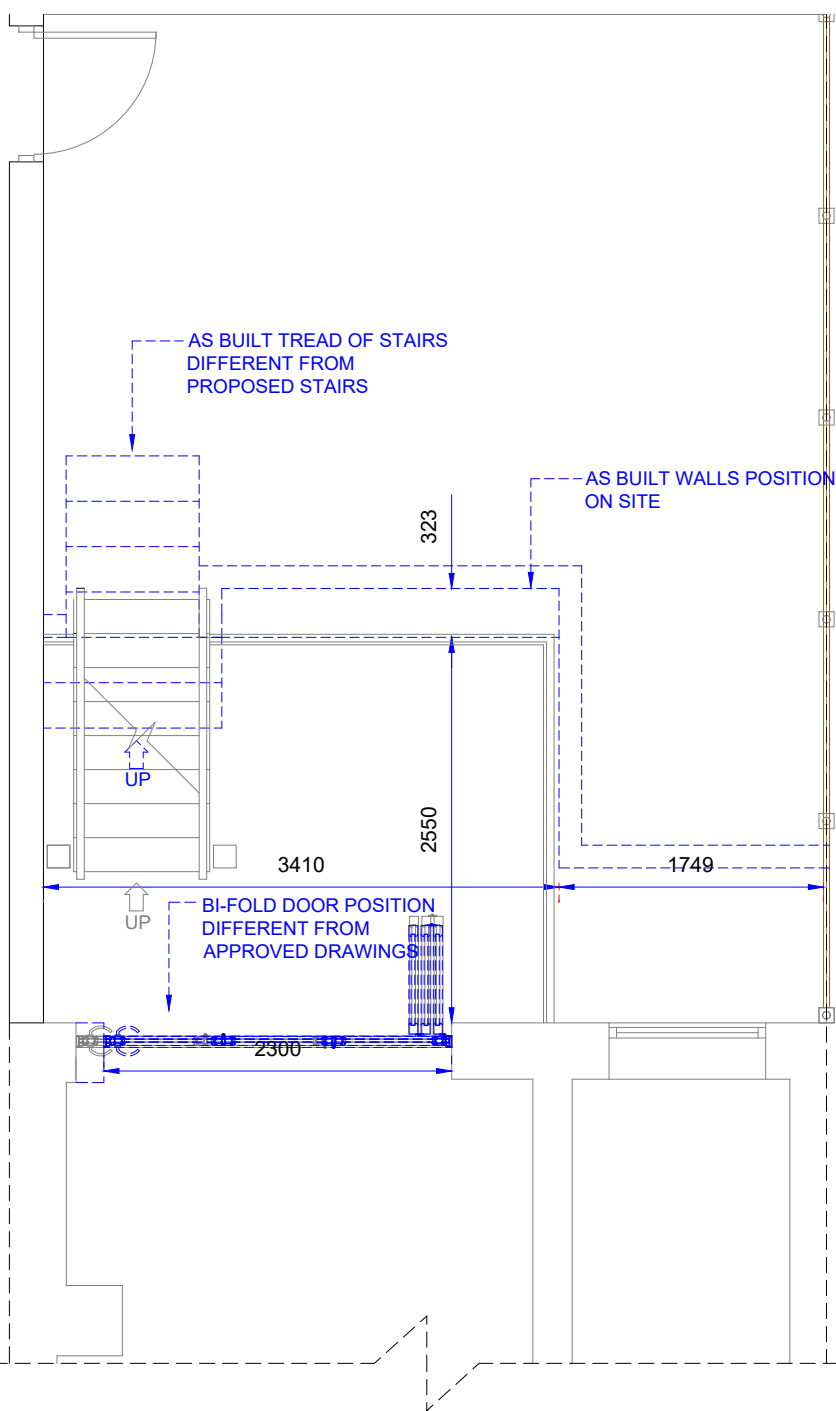

PROPOSED BASEMENT FLOOR PLAN

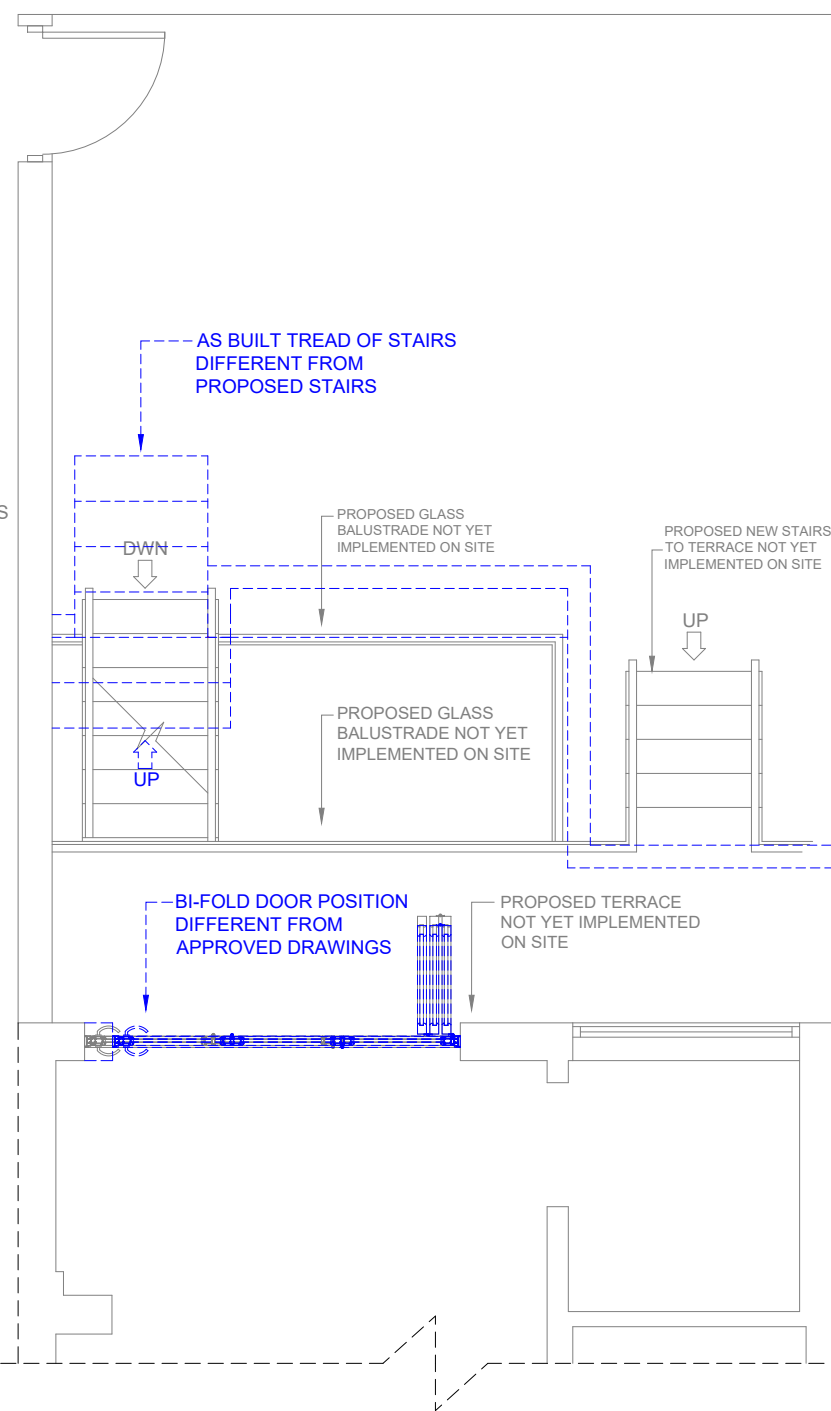

PROPOSED GROUND FLOOR PLAN

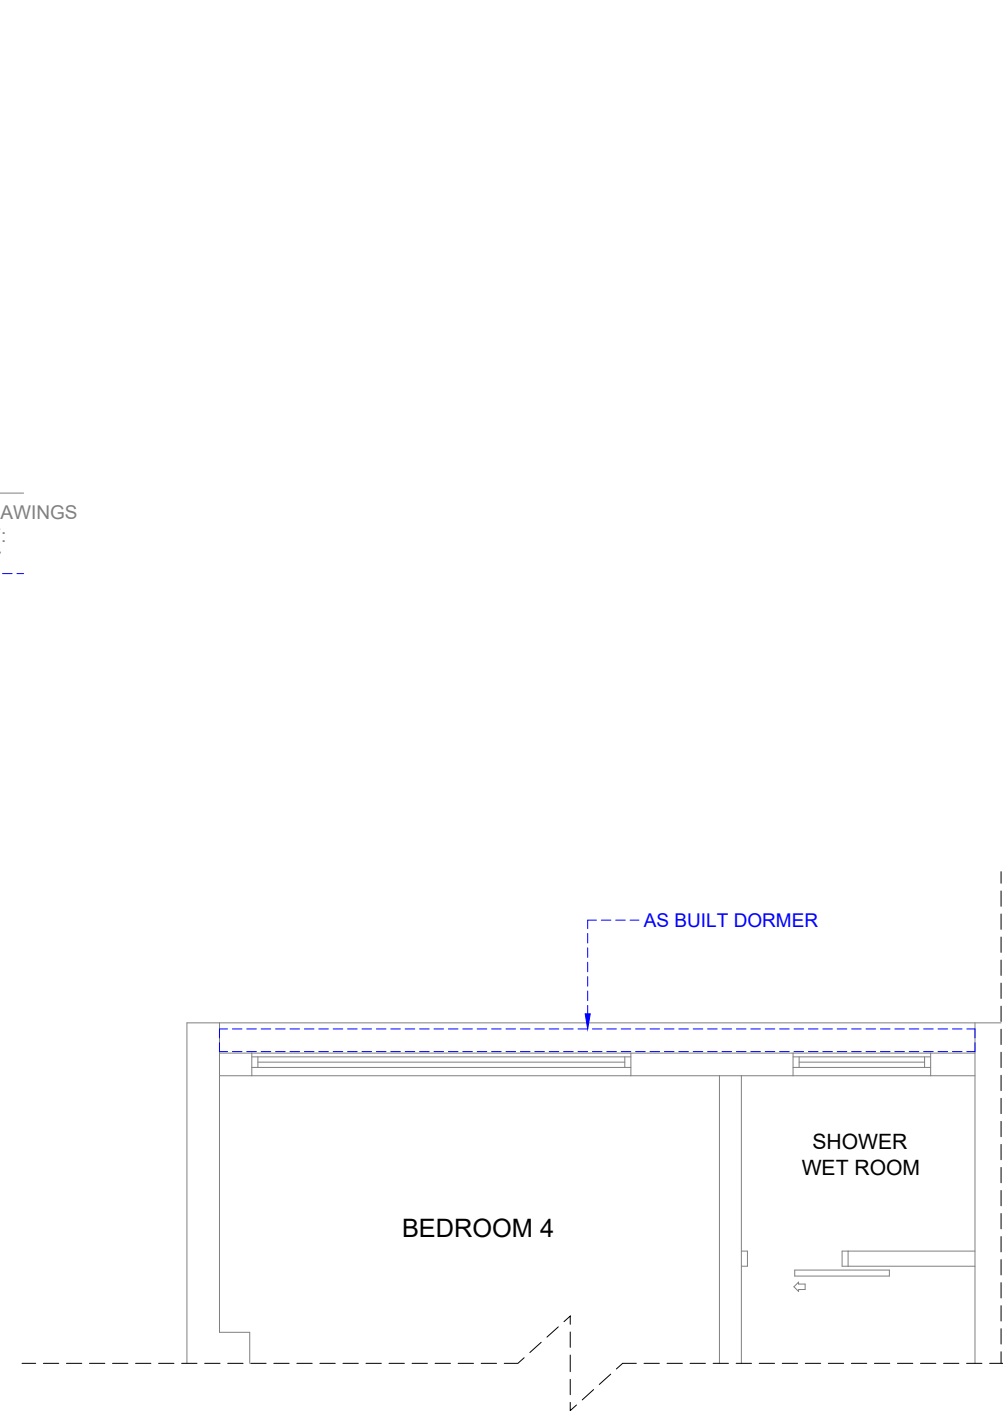

PROPOSED SECOND FLOOR PLAN



B	REV AS BUILT DRAWINGS	ET	27.08.25
A	FIRST ISSUE	ET	24.10.23
REV	AMENDMENTS	BY	DATE

PROJECT
PROPOSED ALTERATIONS / EXTENSION
22 BAMFORD ROAD
DIDSBURY
MANCHESTER
M20 2GW

CLIENT
MS CATHERINE SULLIVAN

DRAWING TITLE
PROPOSED BASEMENT AND
GROUND FLOOR PLANS

DRAWN	ET	DATE	27.08.25
CHECKED		SCALE	1:50 (A2)
APPROVED			

HOWARD & SEDDON A.R.I.B.A.
CHARTERED ARCHITECTS
64 WASHWAY ROAD
SALE, CHESHIRE, M33 7RE
TEL No. 0161 - 973 8296
FAX No. 0161 - 962 3485
E-MAIL : ADMIN@HOWARDANDEDDON.CO.UK

JOB No.	DRG No.	REVISION
13,314	200	B

AS BUILT ISSUE

THIS DRAWING IS A RECORD DRAWING AND IS NOT SUBJECT TO CHANGE