


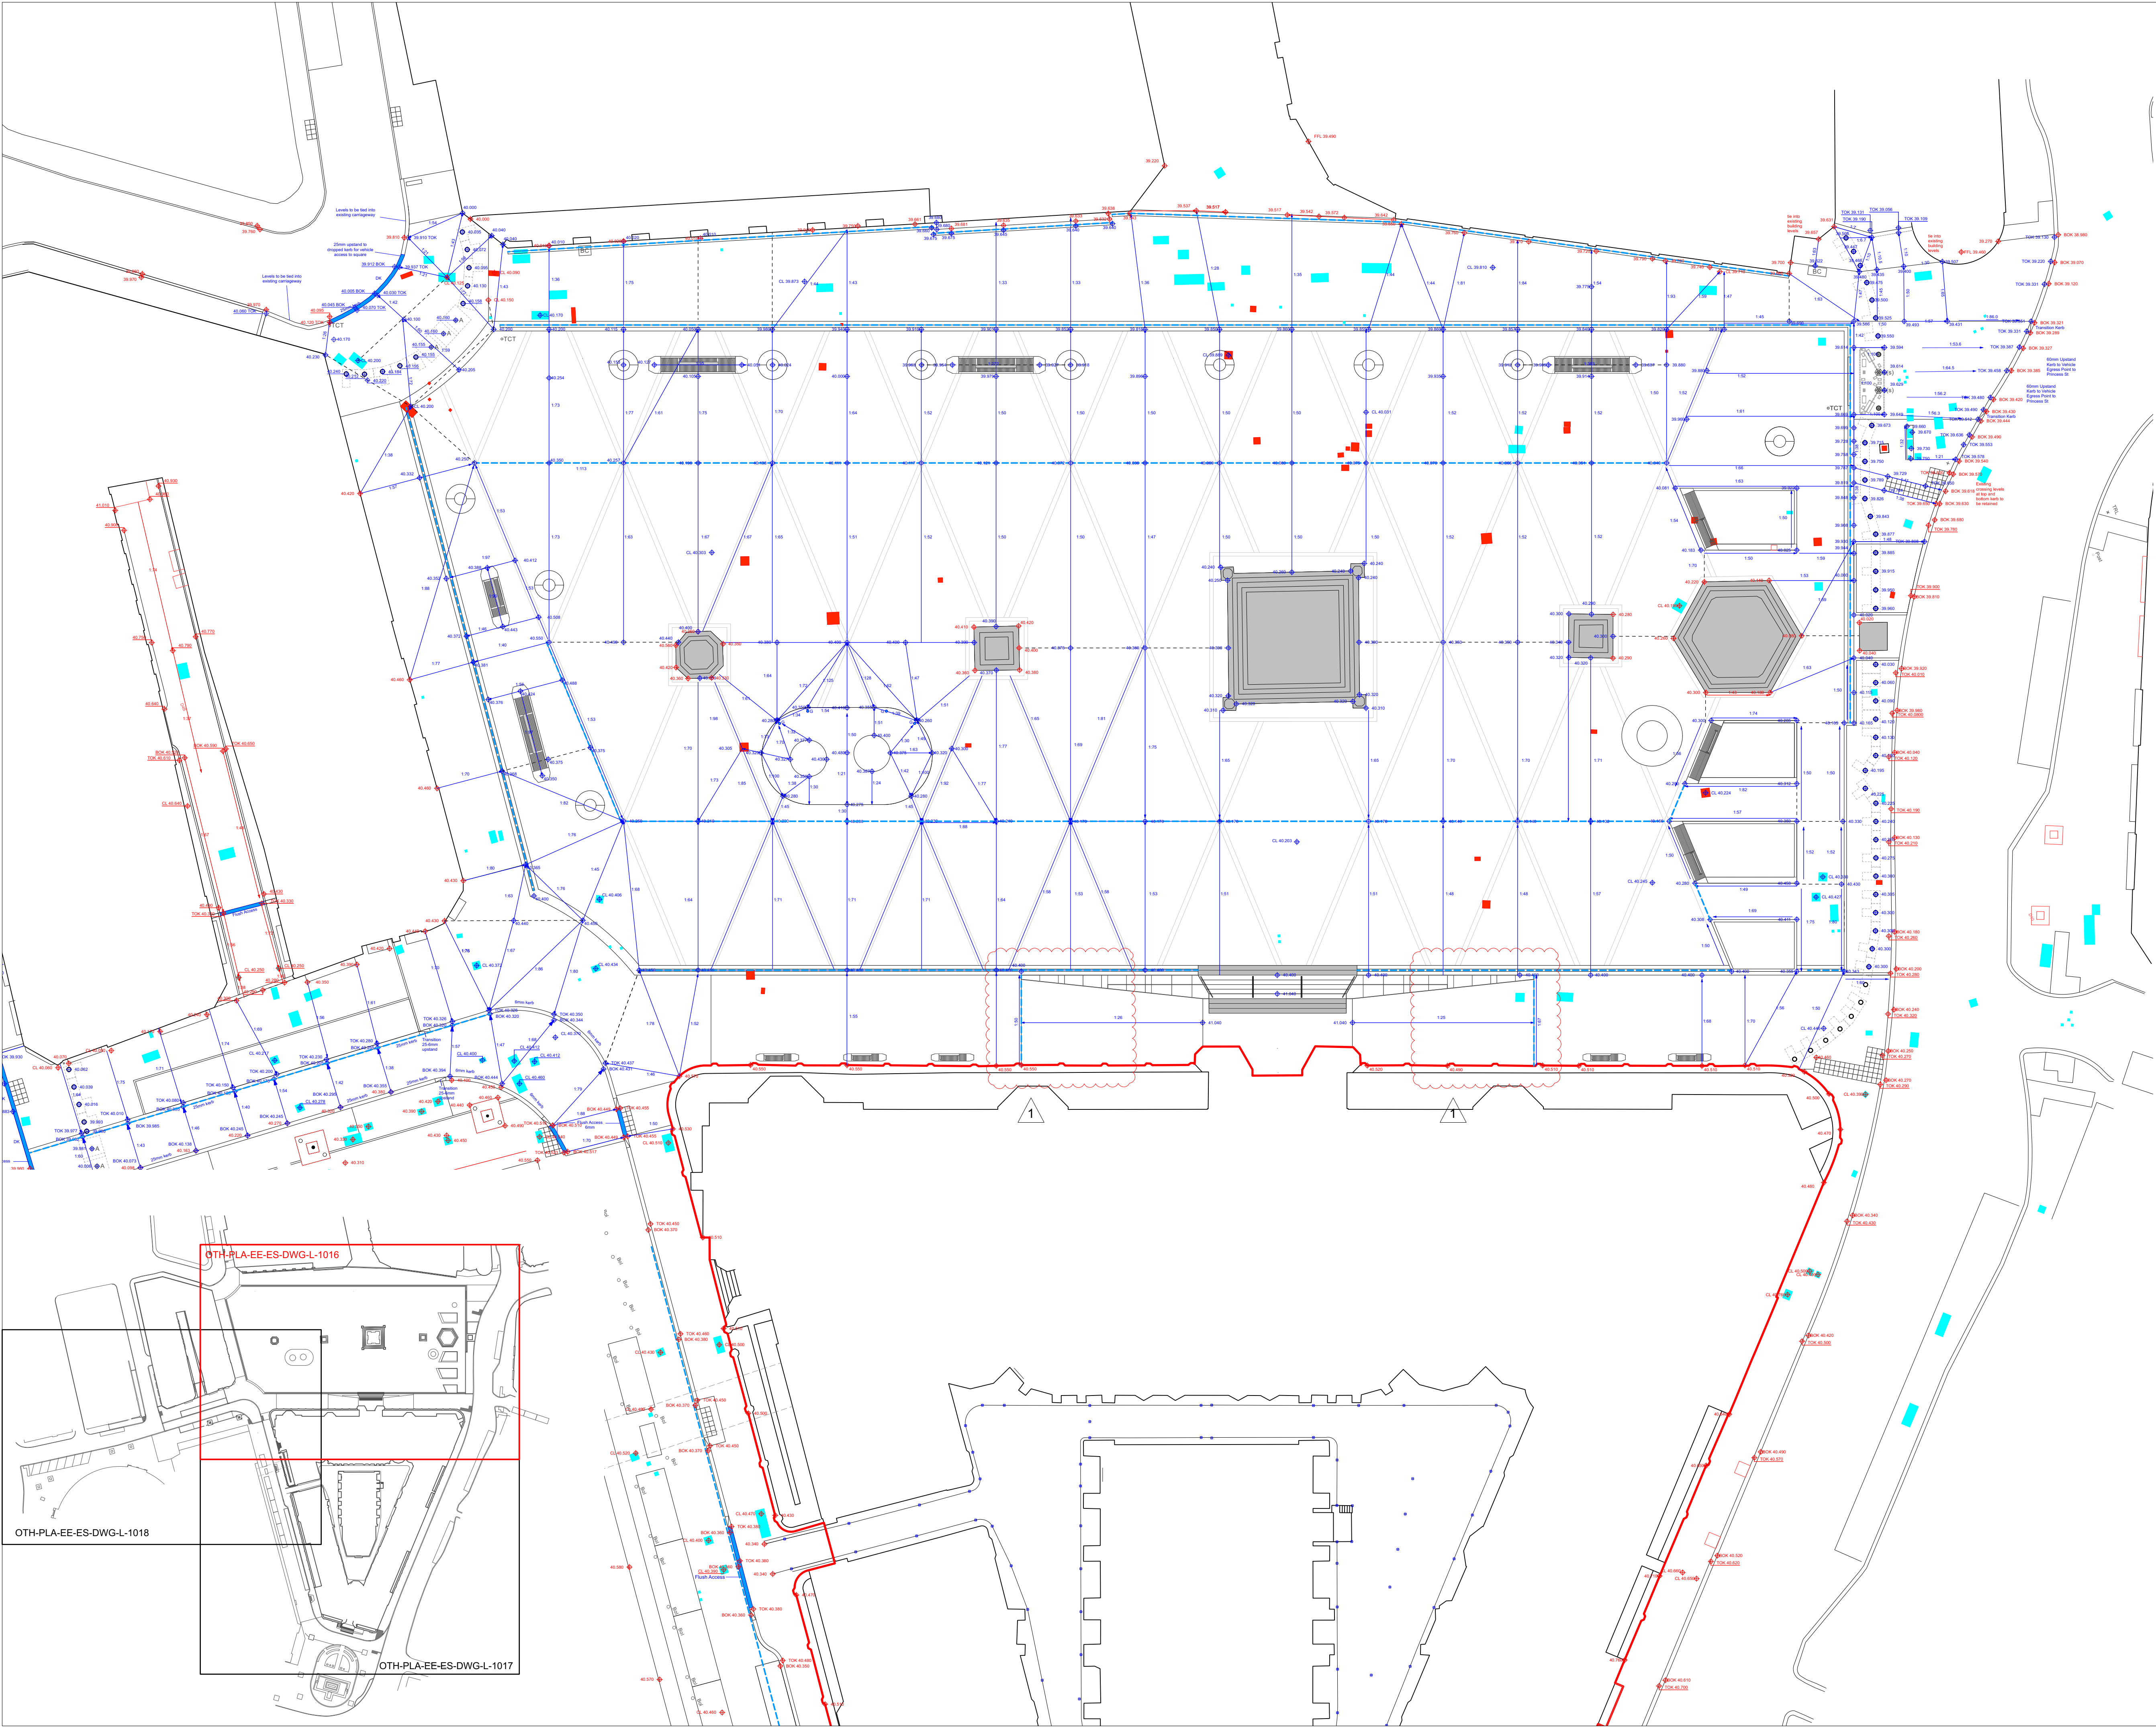

OTH-PLA-EE-ES-DWG-L-1018

OTH-PLA-EE-ES-DWG-L-1016

OTH-PLA-EE-ES-DWG-L-1017

NOTES

1. This drawing is a copyright of Plantit I.E. Limited and may not be reproduced in whole or part without written permission from Plantit I.E. Limited.

KEY

BOUNDARIES

Red Line Boundary

Section 27B Works

LEVELS & DRAINAGE

Proposed surface gradient

Proposed spot level

Existing spot level

High point in surface

Proposed drainage channel / slot drain

Refer to Ramboll drawing for full details of proposed drainage: OTH-PLA-EE-KX-DWG-C-1100 - 1102

Existing manholes & utility covers to be retained

Proposed manholes & utility covers to be removed

Existing manholes & utility covers to be confirmed

Existing cover level

Proposed cover level

Refer to drawing OTH-PLA-EE-ES-DWG-L-1012 for detailed levels to the courtyard

Revision Notes:

1. Additional levels/gradient information provided to Town Hall entrance ramp as clouded.

CD4	12/04/24	Refer to Revision Notes	SY	MS
C03	07/11/23	Refer to Revision Notes	SY	MS
C02	17/11/21	Draft Construction Issue	SR	MS/KR
C01	01/04/21	Construction Issue	SR	MS/KR
06	26/02/21	Stage 4 Issue (Re-Coordination)	SR	MS/KR
05	14/11/19	Refer to revision notes	SR	MS/KR
04	11/10/19	Stage 4 Issue - revisions as described	SR	MS/KR
03	06/09/19	Planning Issue	SR	MS/KR
02	26/07/19	Stage 4	SR	MS/KR
01	21/06/19	For information	SR	MS/KR
Revision	Date	Description	Drawn	Appr.

Plantit I.E. Limited

E: info@plantit-ie.com

W: plantit-ie.com

MANCHESTER

2 Back Grafton St., Altrincham, WA14 1DY

T: 0161 928 9281

LONDON

Unit 6 Waterside, 44-48 Wharf Road, London, N1 7UX

T: 0207 253 5678

LIVERPOOL

No. 8 Princes Parade, Princes Dock, Liverpool, L3 1DL

T: 0151 705 6746

Client

Manchester City Council

Project

Our Town Hall

Drg Title

Proposed Levels Detail Area 1 of 3
Albert Square

Created on

19.06.19

Created by

SR

Approved by

MS/KR

Scale

1:250

Size

A1

Workstage

Stage 5

Drg No.

OTH-PLA-EE-ES-DWG-L-1016

Suitability

S4

Revision

C04

© Plantit I.E. Limited