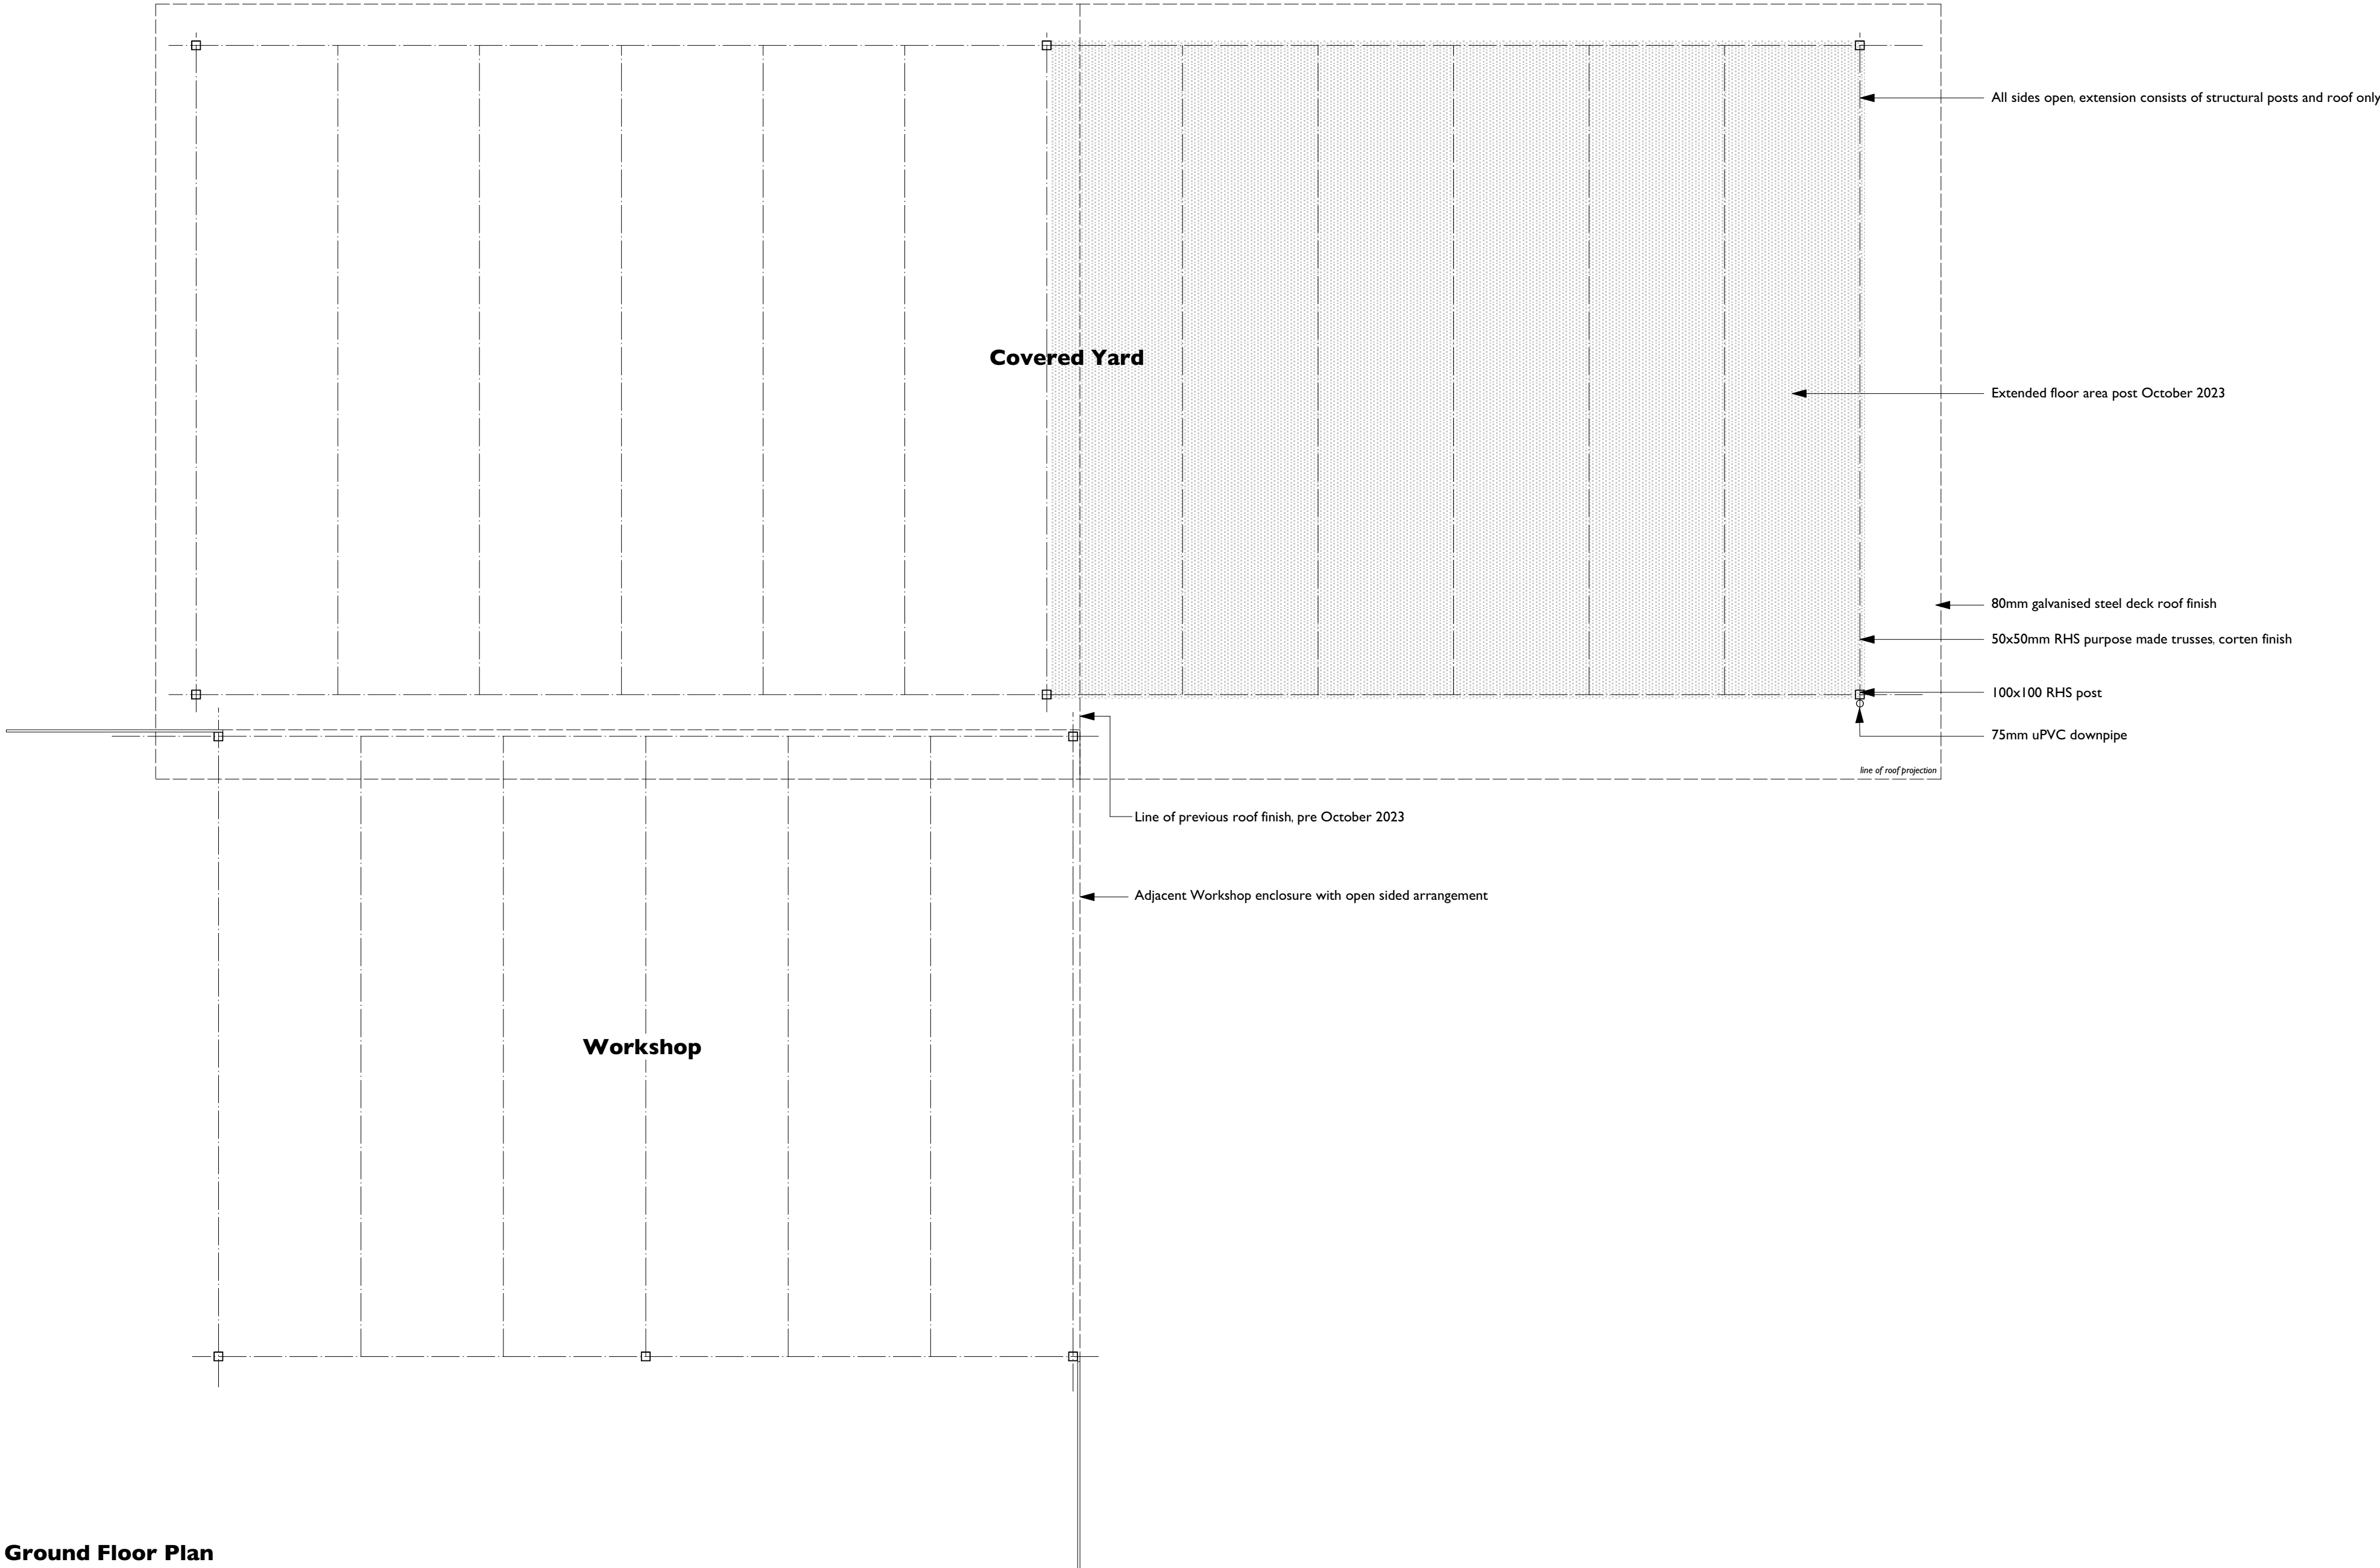
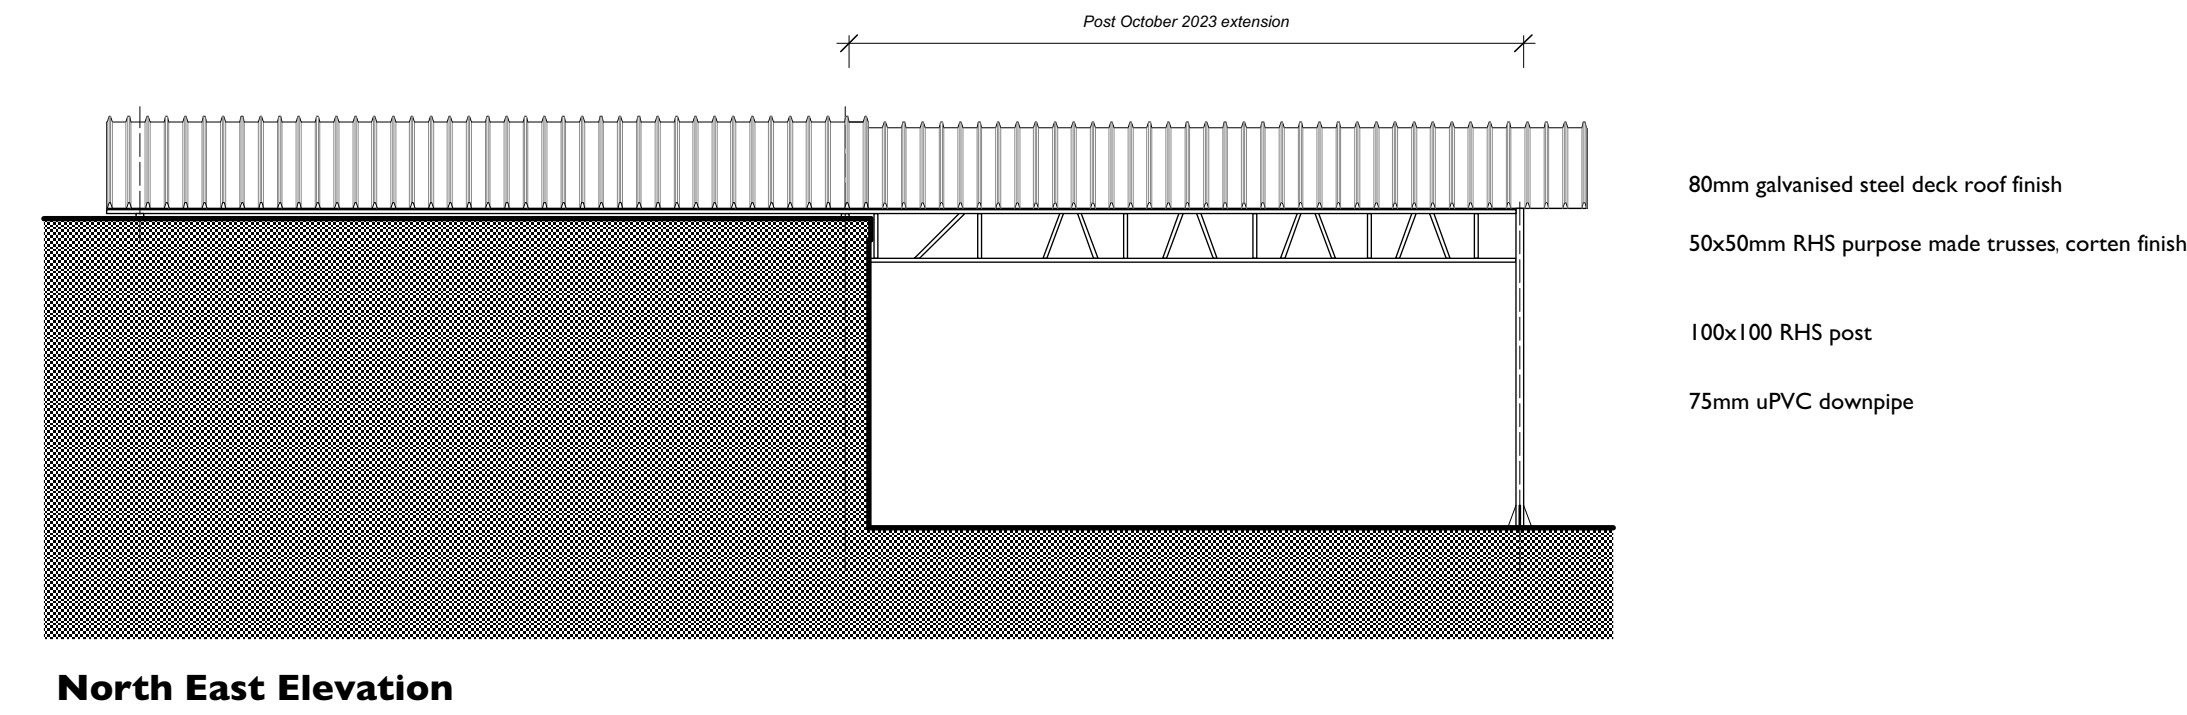
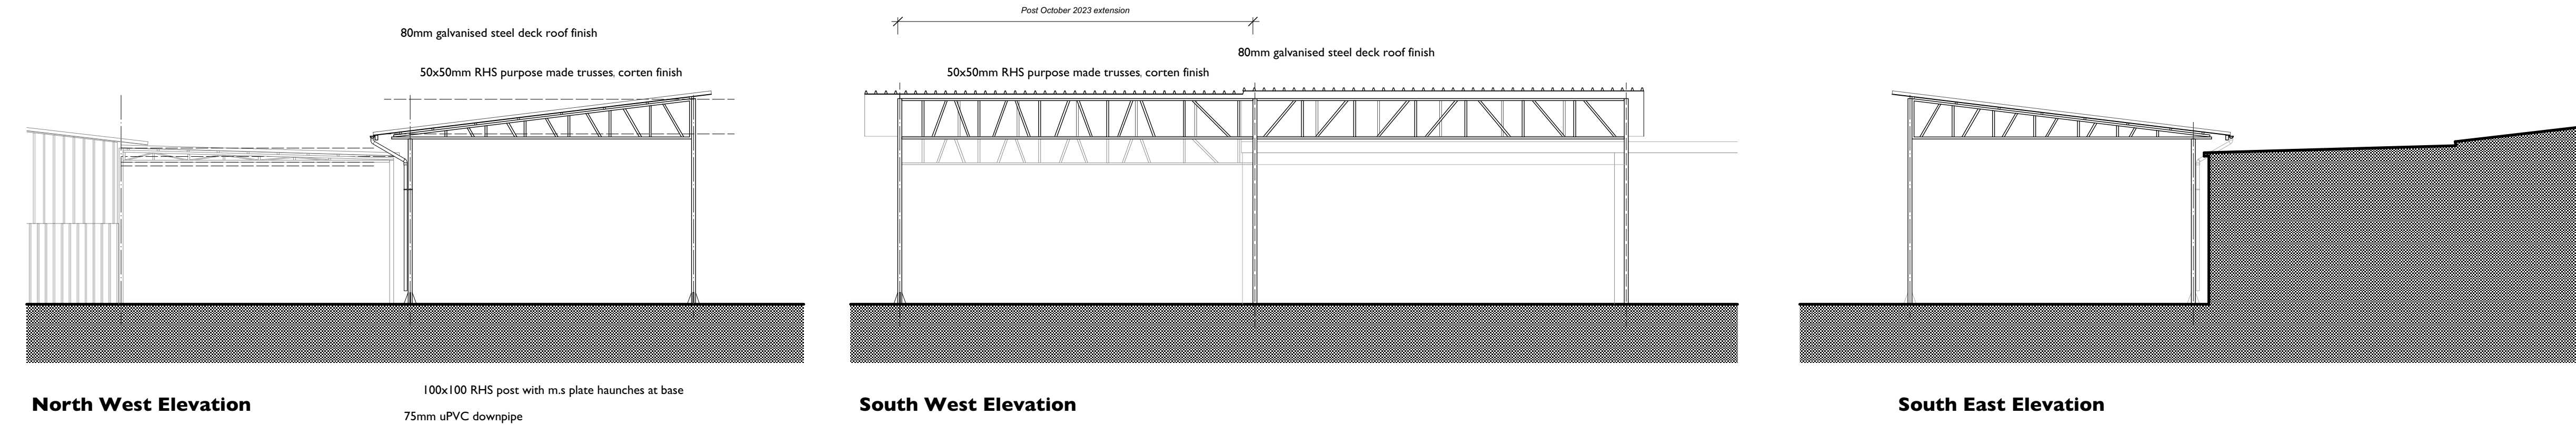


© reiform architects
note:
This drawing is copyright.
Do not scale off dimensions. all dimensions are to be checked on site by contractor. Contractor to report any dimensional discrepancies, errors or omissions prior to commencing on site.
Make Good to all surfaces disturbed
ALL STRUCTURAL STEELWORK AND RELATING STRUCTURES TO BE TO THE STRUCTURAL ENGINEERS DESIGNS.
CALCULATIONS AND CONFIRMATION THIS DRAWING IS TO BE READ IN CONJUNCTION WITH ALL THE APPROPRIATE STRUCTURAL ENGINEER'S INFORMATION.
IF IN ANY DOUBT ASK

Rev.	Date	Comments

reiform [architects and urban strategists] ltd 14 Ashol Road Whalley Range Manchester M14 6QH T+44(0) 161 760 680 e reiform@reiform.co.uk		
Client	Merc Yard Ltd	
Project Title	Automotive Maintenance Canopy At 37-39 Rosebank Road, Newton Heath, Manchester, M40 2UN	
Drawing Title	Status	4
Covered Yard As Built Plans & Elevations	Scale	1:100/1:50 @A1
Job No.	Drawing No.	Rev.
RD DF 25-495	011	-