



NOTES


ALL DIMENSIONS TO BE CHECKED ON SITE PRIOR TO ANY MANUFACTURING OR FABRICATION AND ANY ANOMALIES TO BE BROUGHT TO THE ATTENTION OF THE ARCHITECT.

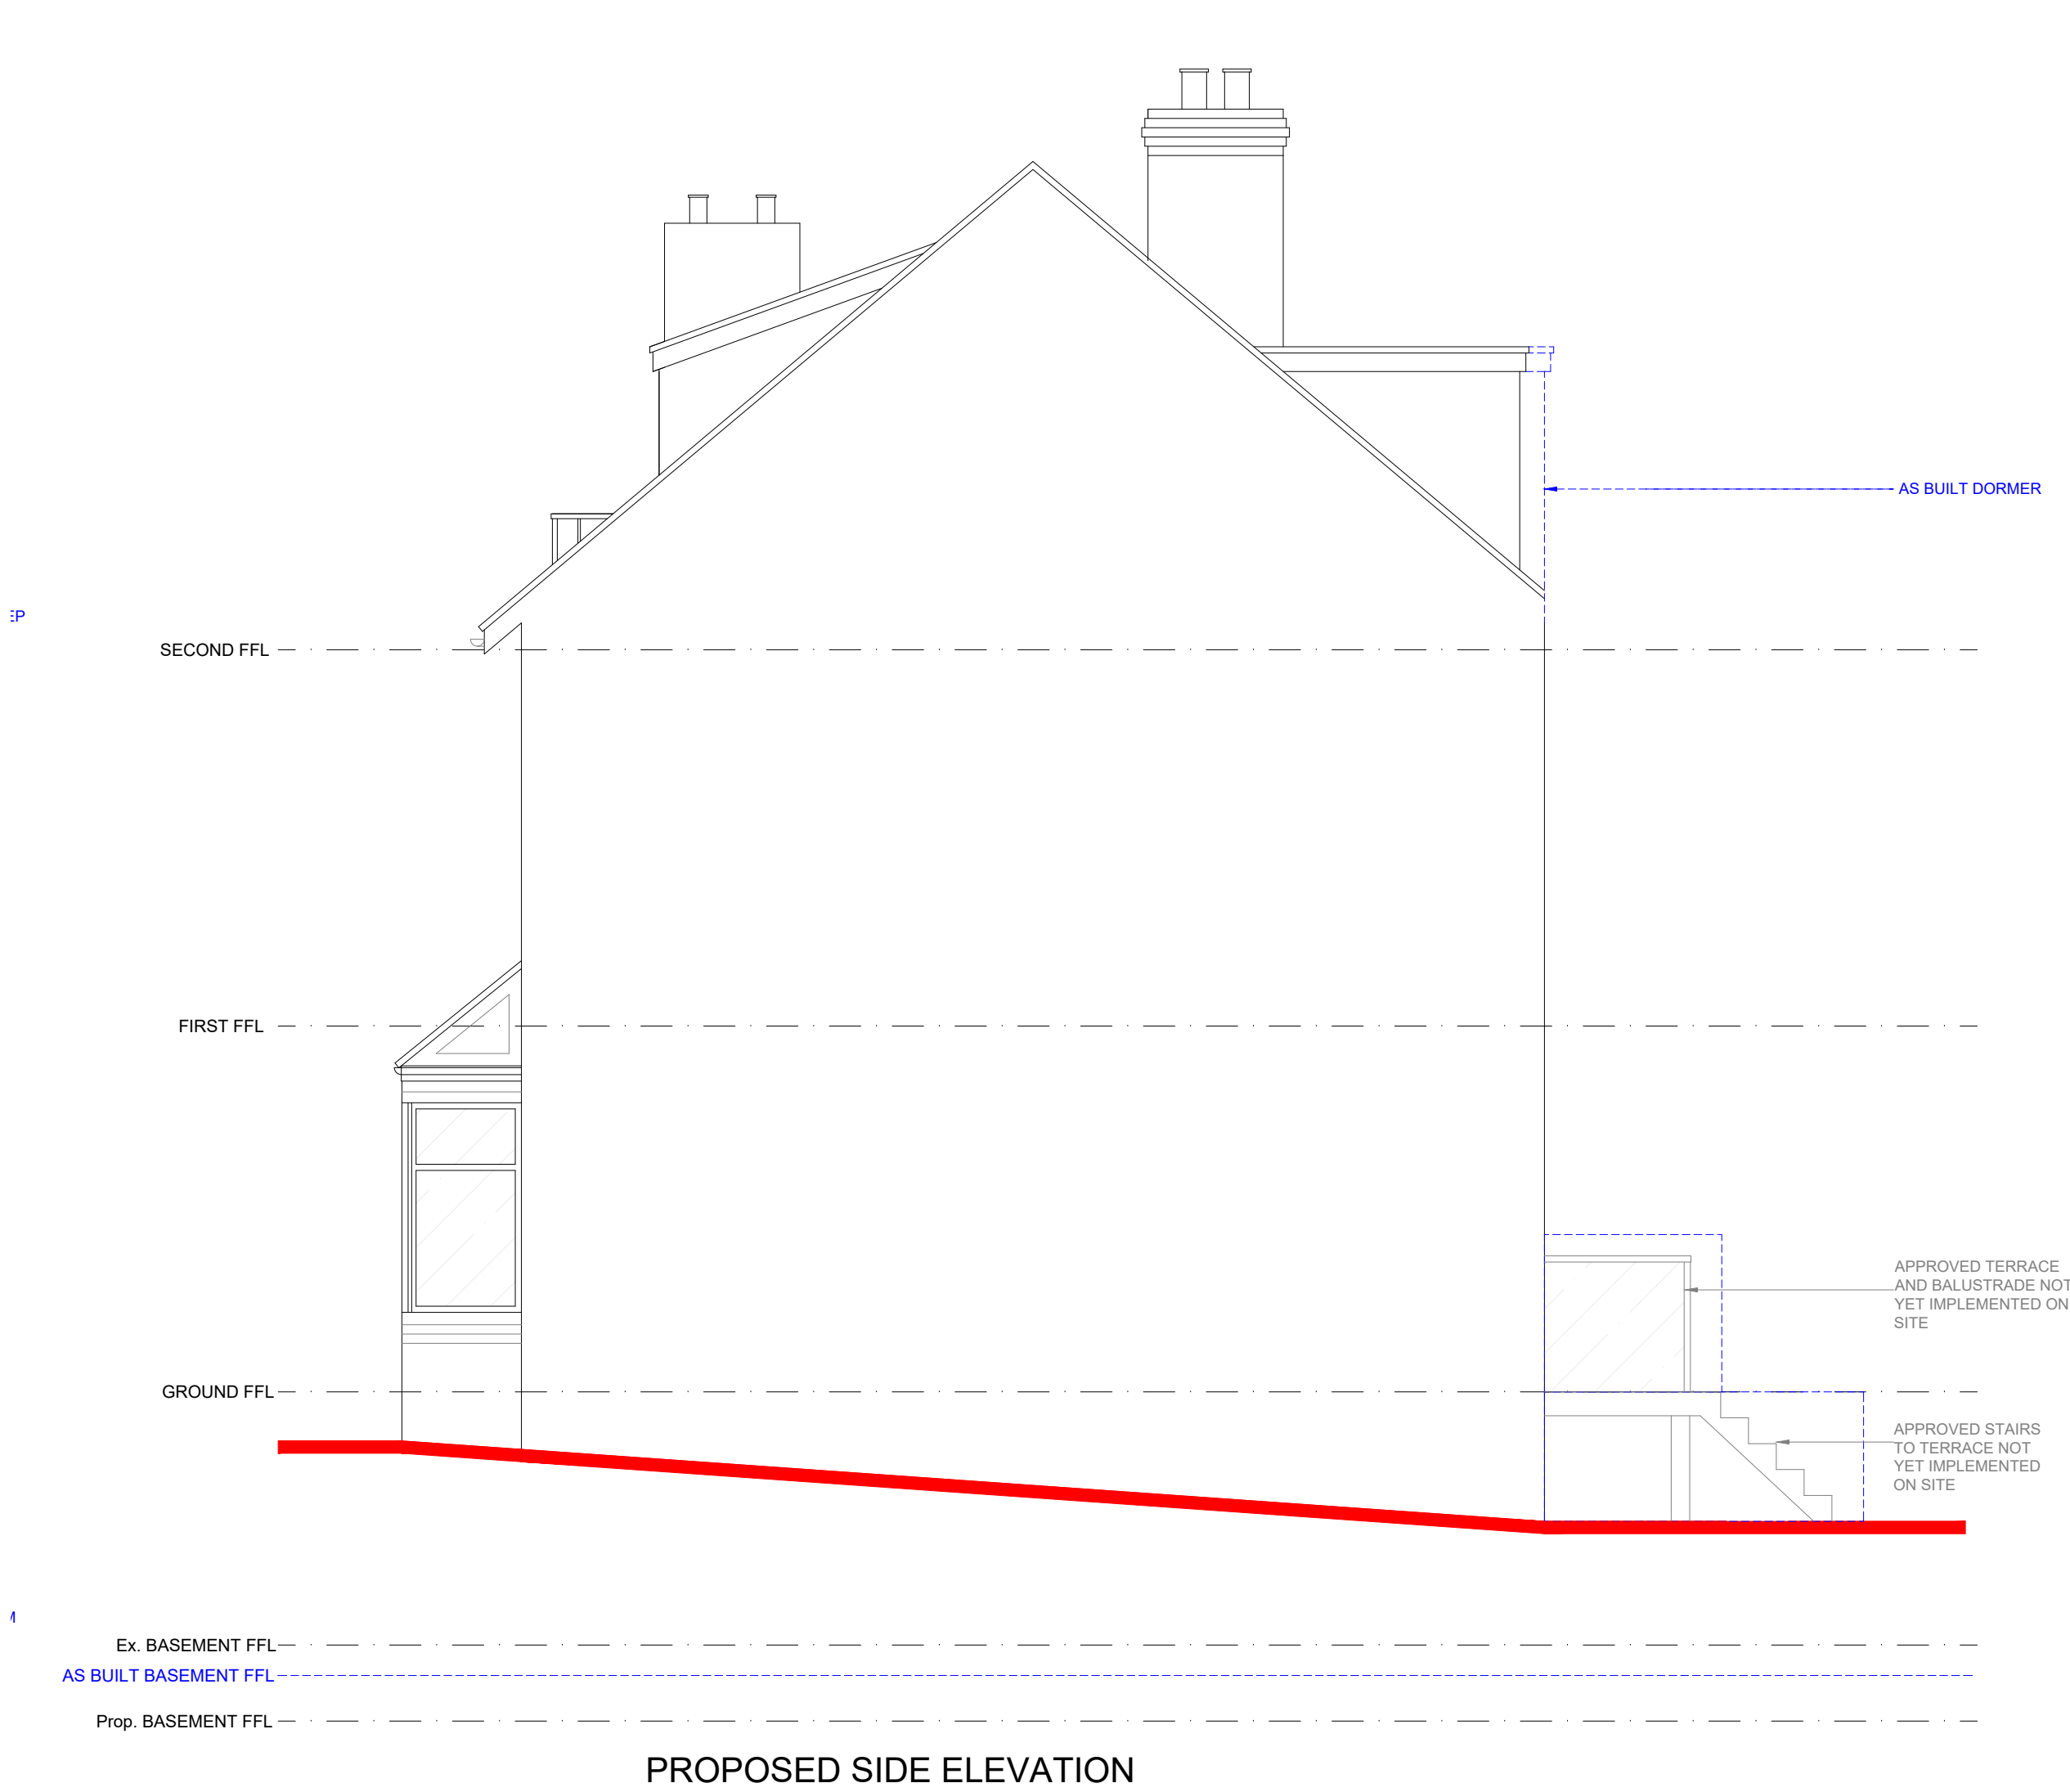

PROPOSED SIDE ELEVATION

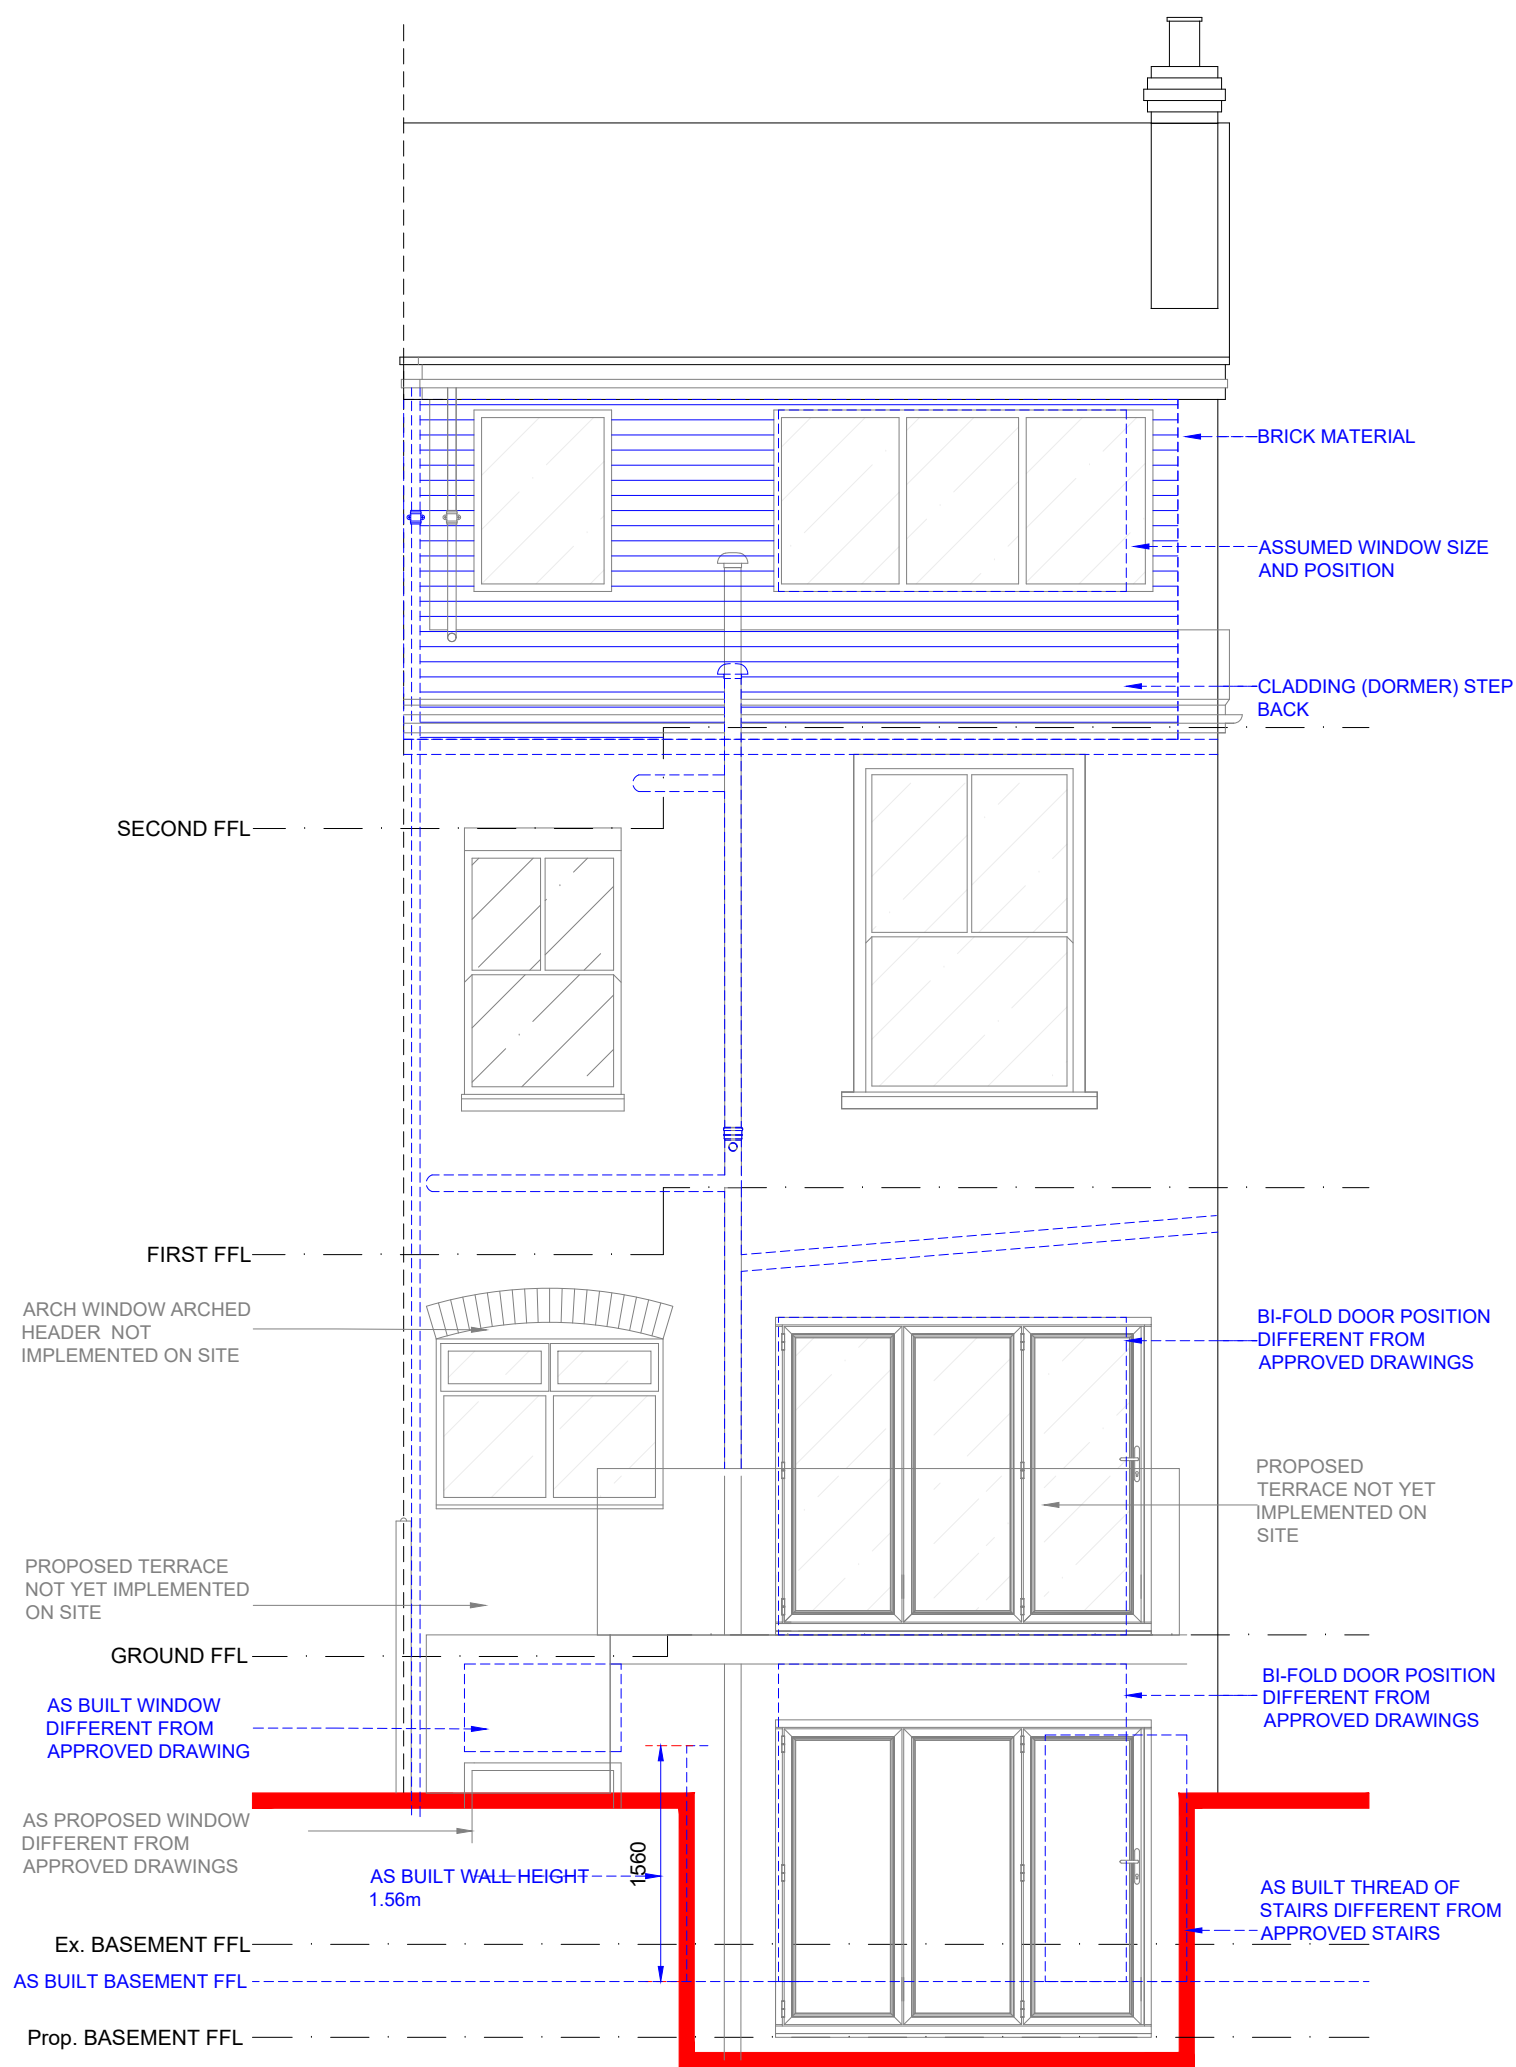

PROPOSED REAR ELEVATION (2)

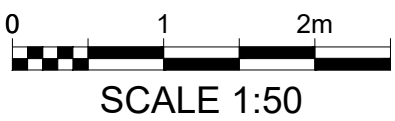

B	REV REAR WINDOW	ET	27.08.25
A	FIRST ISSUE	ET	24.10.23
REV	AMENDMENTS	BY	DATE

PROJECT
PROPOSED ALTERATIONS / EXTENSION
22 BAMFORD ROAD
DIDSBURY
MANCHESTER
M20 2GW

CLIENT
MS CATHERINE SULLIVAN

DRAWING TITLE
PROPOSED ELEVATIONS

DRAWN	ET	DATE	27.08.25
CHECKED		SCALE	1:50 (A1)
APPROVED			



JOB No.	DRG No.	REVISION
13,314	202	B

AS BUILT ISSUE

THIS DRAWING IS A RECORD DRAWING AND IS NOT SUBJECT TO CHANGE