


LOCATION PLAN

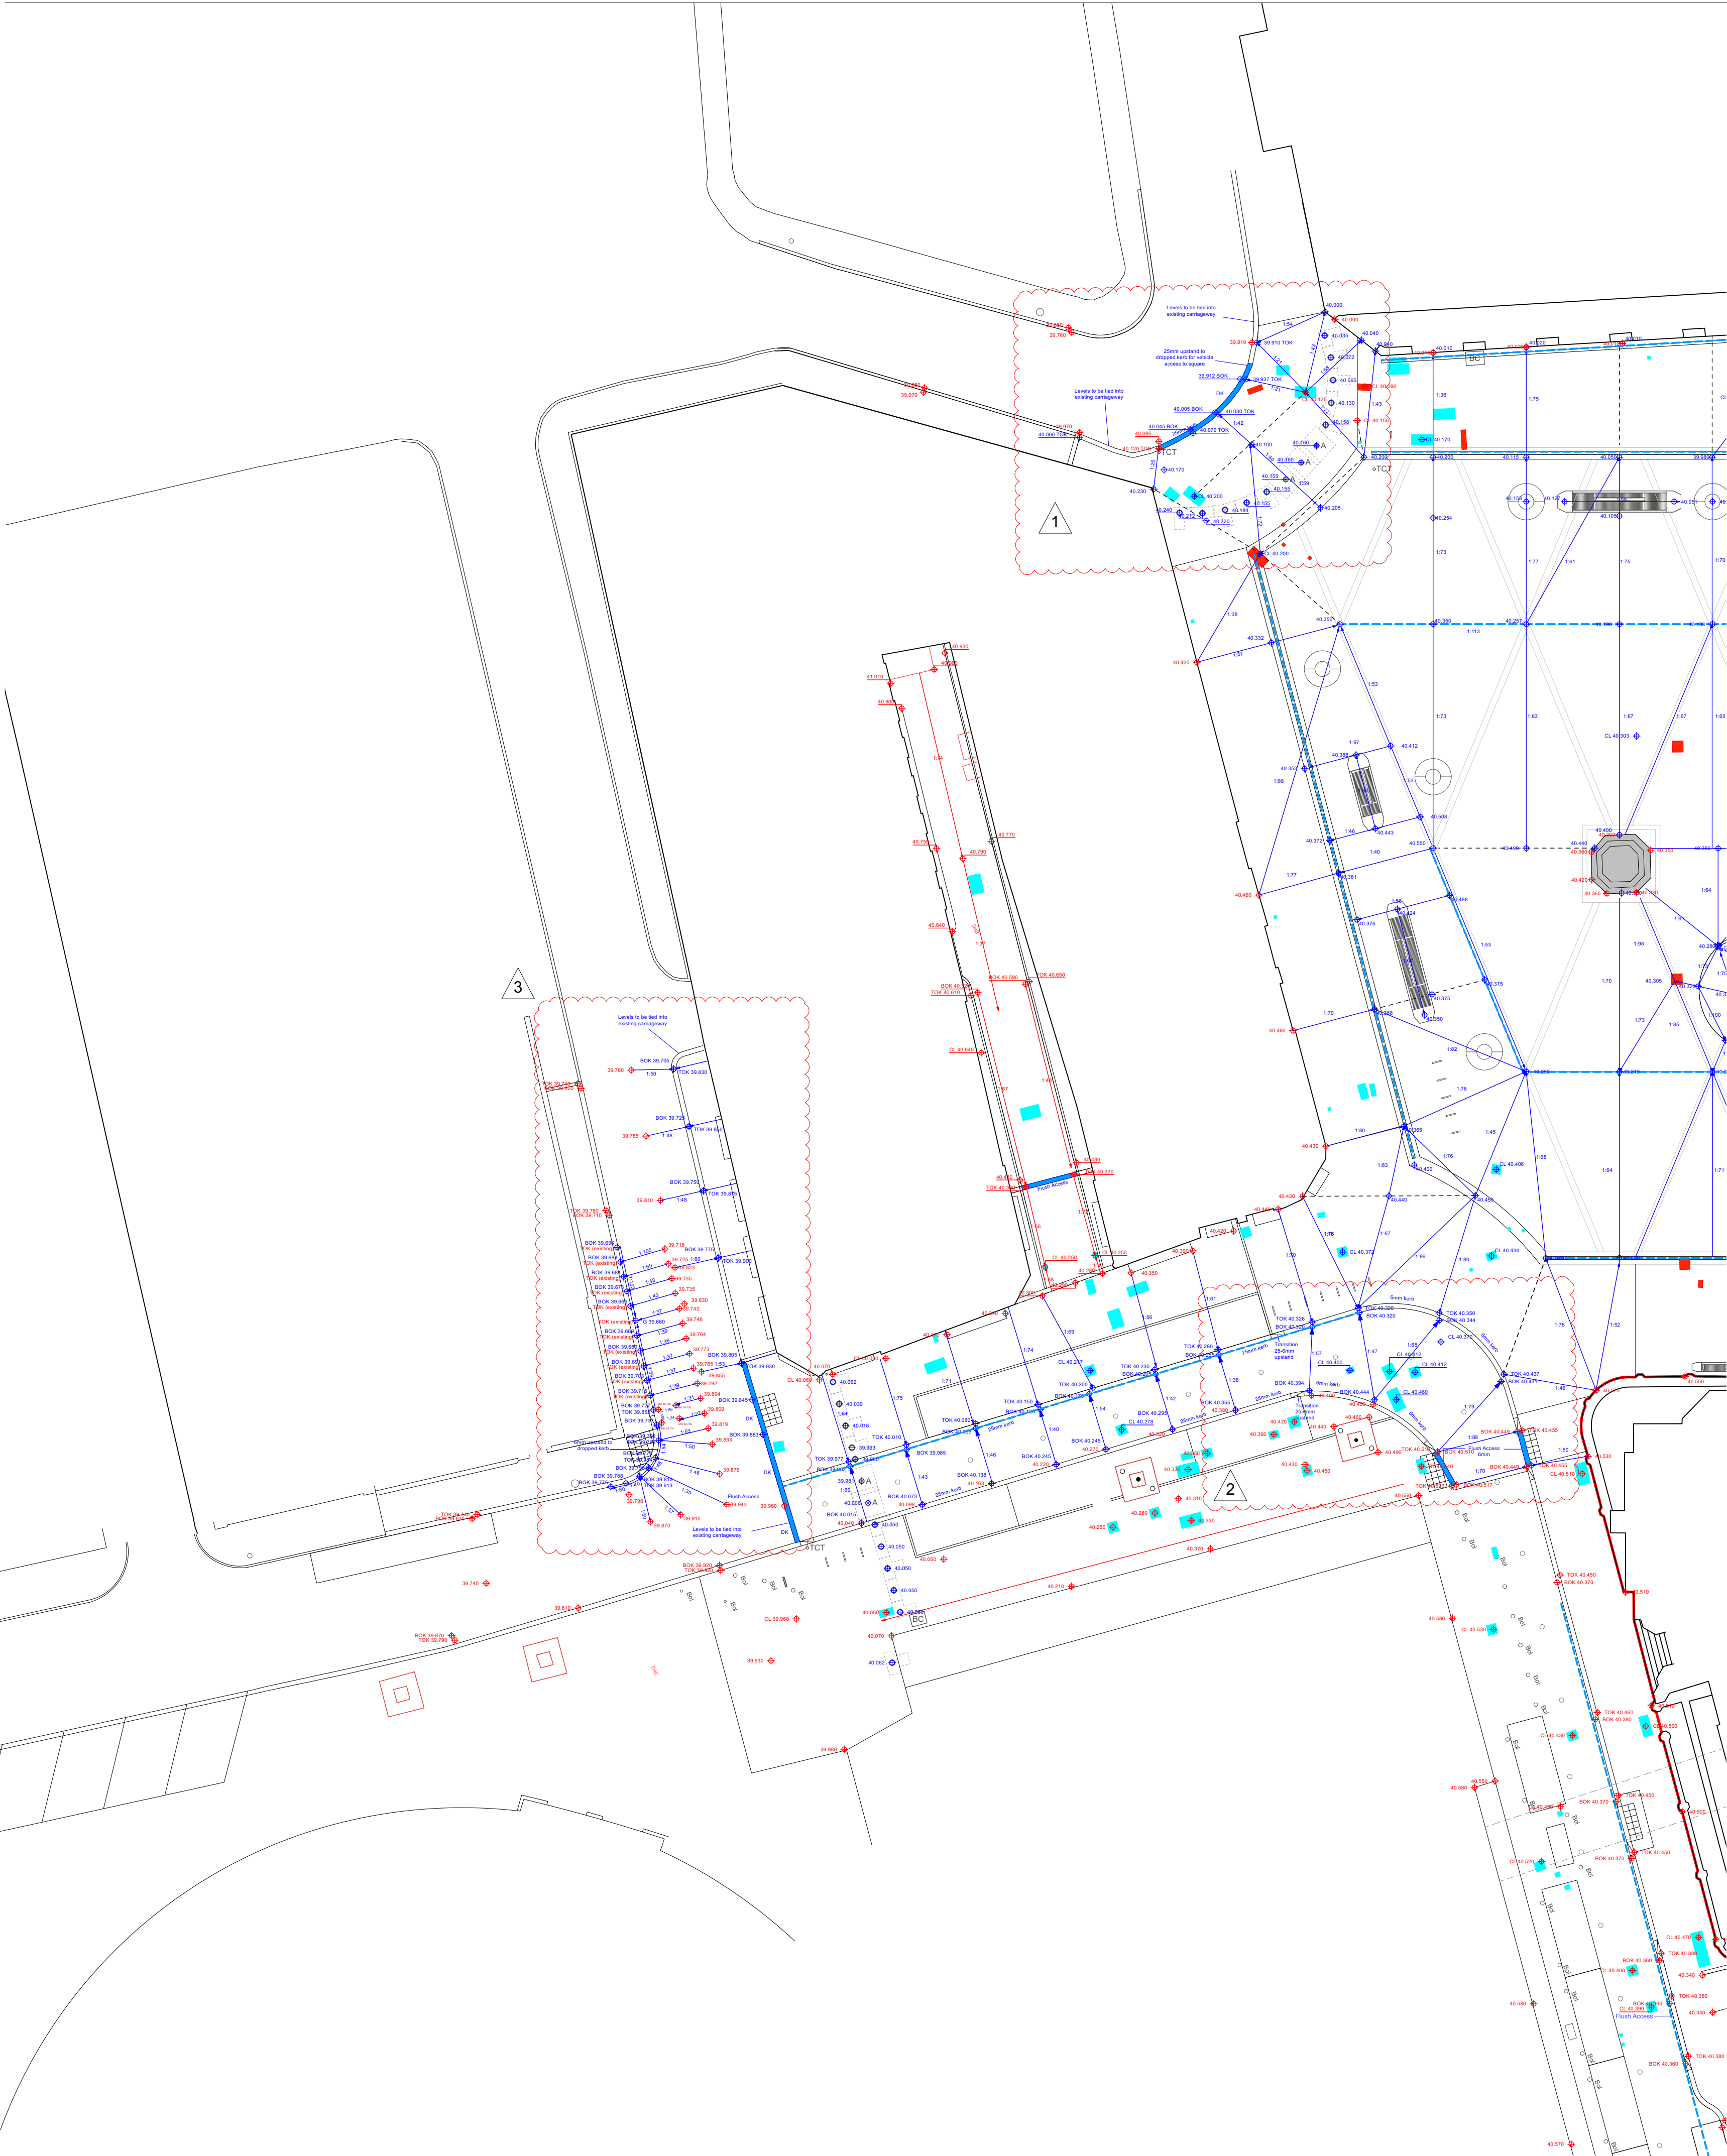

NOTES

1. This drawing is for the proposed works.
2. All dimensions are in millimetres unless otherwise stated.
3. All dimensions are to the centre of the line.
4. The dimensions of all materials must be checked to ensure they are correct.
5. The drawing must be used in conjunction with the relevant specification and standard drawings.
6. The drawing must be used in conjunction with the relevant specification and standard drawings.
7. The drawing must be used in conjunction with the relevant specification and standard drawings.

KEY

BOUNDARIES

- Red Line Boundary
- Section 278 Works

LEVELS & DRAINAGE

- Proposed surface gradient
- Proposed spot level
- Existing spot level
- High point in surface
- Proposed drainage channel / slot drain
- Refer to Ramboll drawings for full details of proposed drainage: OTH-PLA-EE-ES-DWG-C-1100 - 1102
- Existing manholes & utility covers to be retained
- Existing manholes & utility covers to be removed
- Existing manholes & utility covers to be confirmed
- Proposed cover level

Refer to drawing OTH-PLA-EE-ES-DWG-L-1012 for detailed levels to the courtyard

Revision Notes:

1. Additional notes added on kerb upstand. Linework updated to reflect as built kerb alignment.
2. Levels updated to show 6mm upstand to Mount St radius section as agreed with project access group.
3. Levels added as per Adana levels survey and in line with sketch drawing OTH-PLA-EE-ES-SKE-L-0069 agreed with MCC Highways.

C03	07/11/23	Refer to Revision Notes	SY	MS
C02	17/11/21	Draft Construction Issue	SR	MS/KR
C01	01/04/21	Construction Issue	SR	MS/KR
06	26/02/21	Stage 4 Issue (Re-Coordination)	SR	MS/KR
05	14/11/19	Refer to revision notes	SR	MS/KR
04	11/10/19	Stage 4 Issue - revisions as described	SR	MS/KR
03	06/09/19	Planning Issue	SR	MS/KR
02	26/07/19	Stage 4	SR	MS/KR
01	21/06/19	For information	SR	MS/KR

Revision	Date	Description	Drawn	Apprvd.

Planit I.E. Limited

E: info@planit-ie.com W: planit-ie.com

MANCHESTER
2 Back Grafton St., Altrincham, WA14 1DY
T: 0161 928 9281

LONDON
Unit 6 Waterside, 44-48 Wharf Road, London, N1 7UX
T: 0207 253 5678

LIVERPOOL
No. 8 Princes Parade, Princes Dock, Liverpool, L3 1DL
T: 0151 705 6746

Client Manchester City Council

Project Our Town Hall

Drg Title Proposed Levels Detail Area 3 of 3 Mount Street

Created on 19.06.19 Created by SR Approved by MS/KR

Scale 1:250 Size A1 Workstage Stage 5

Drg No. OTH-PLA-EE-ES-DWG-L-1018 Suitability S4 Revision C03

© Planit I.E. Limited