



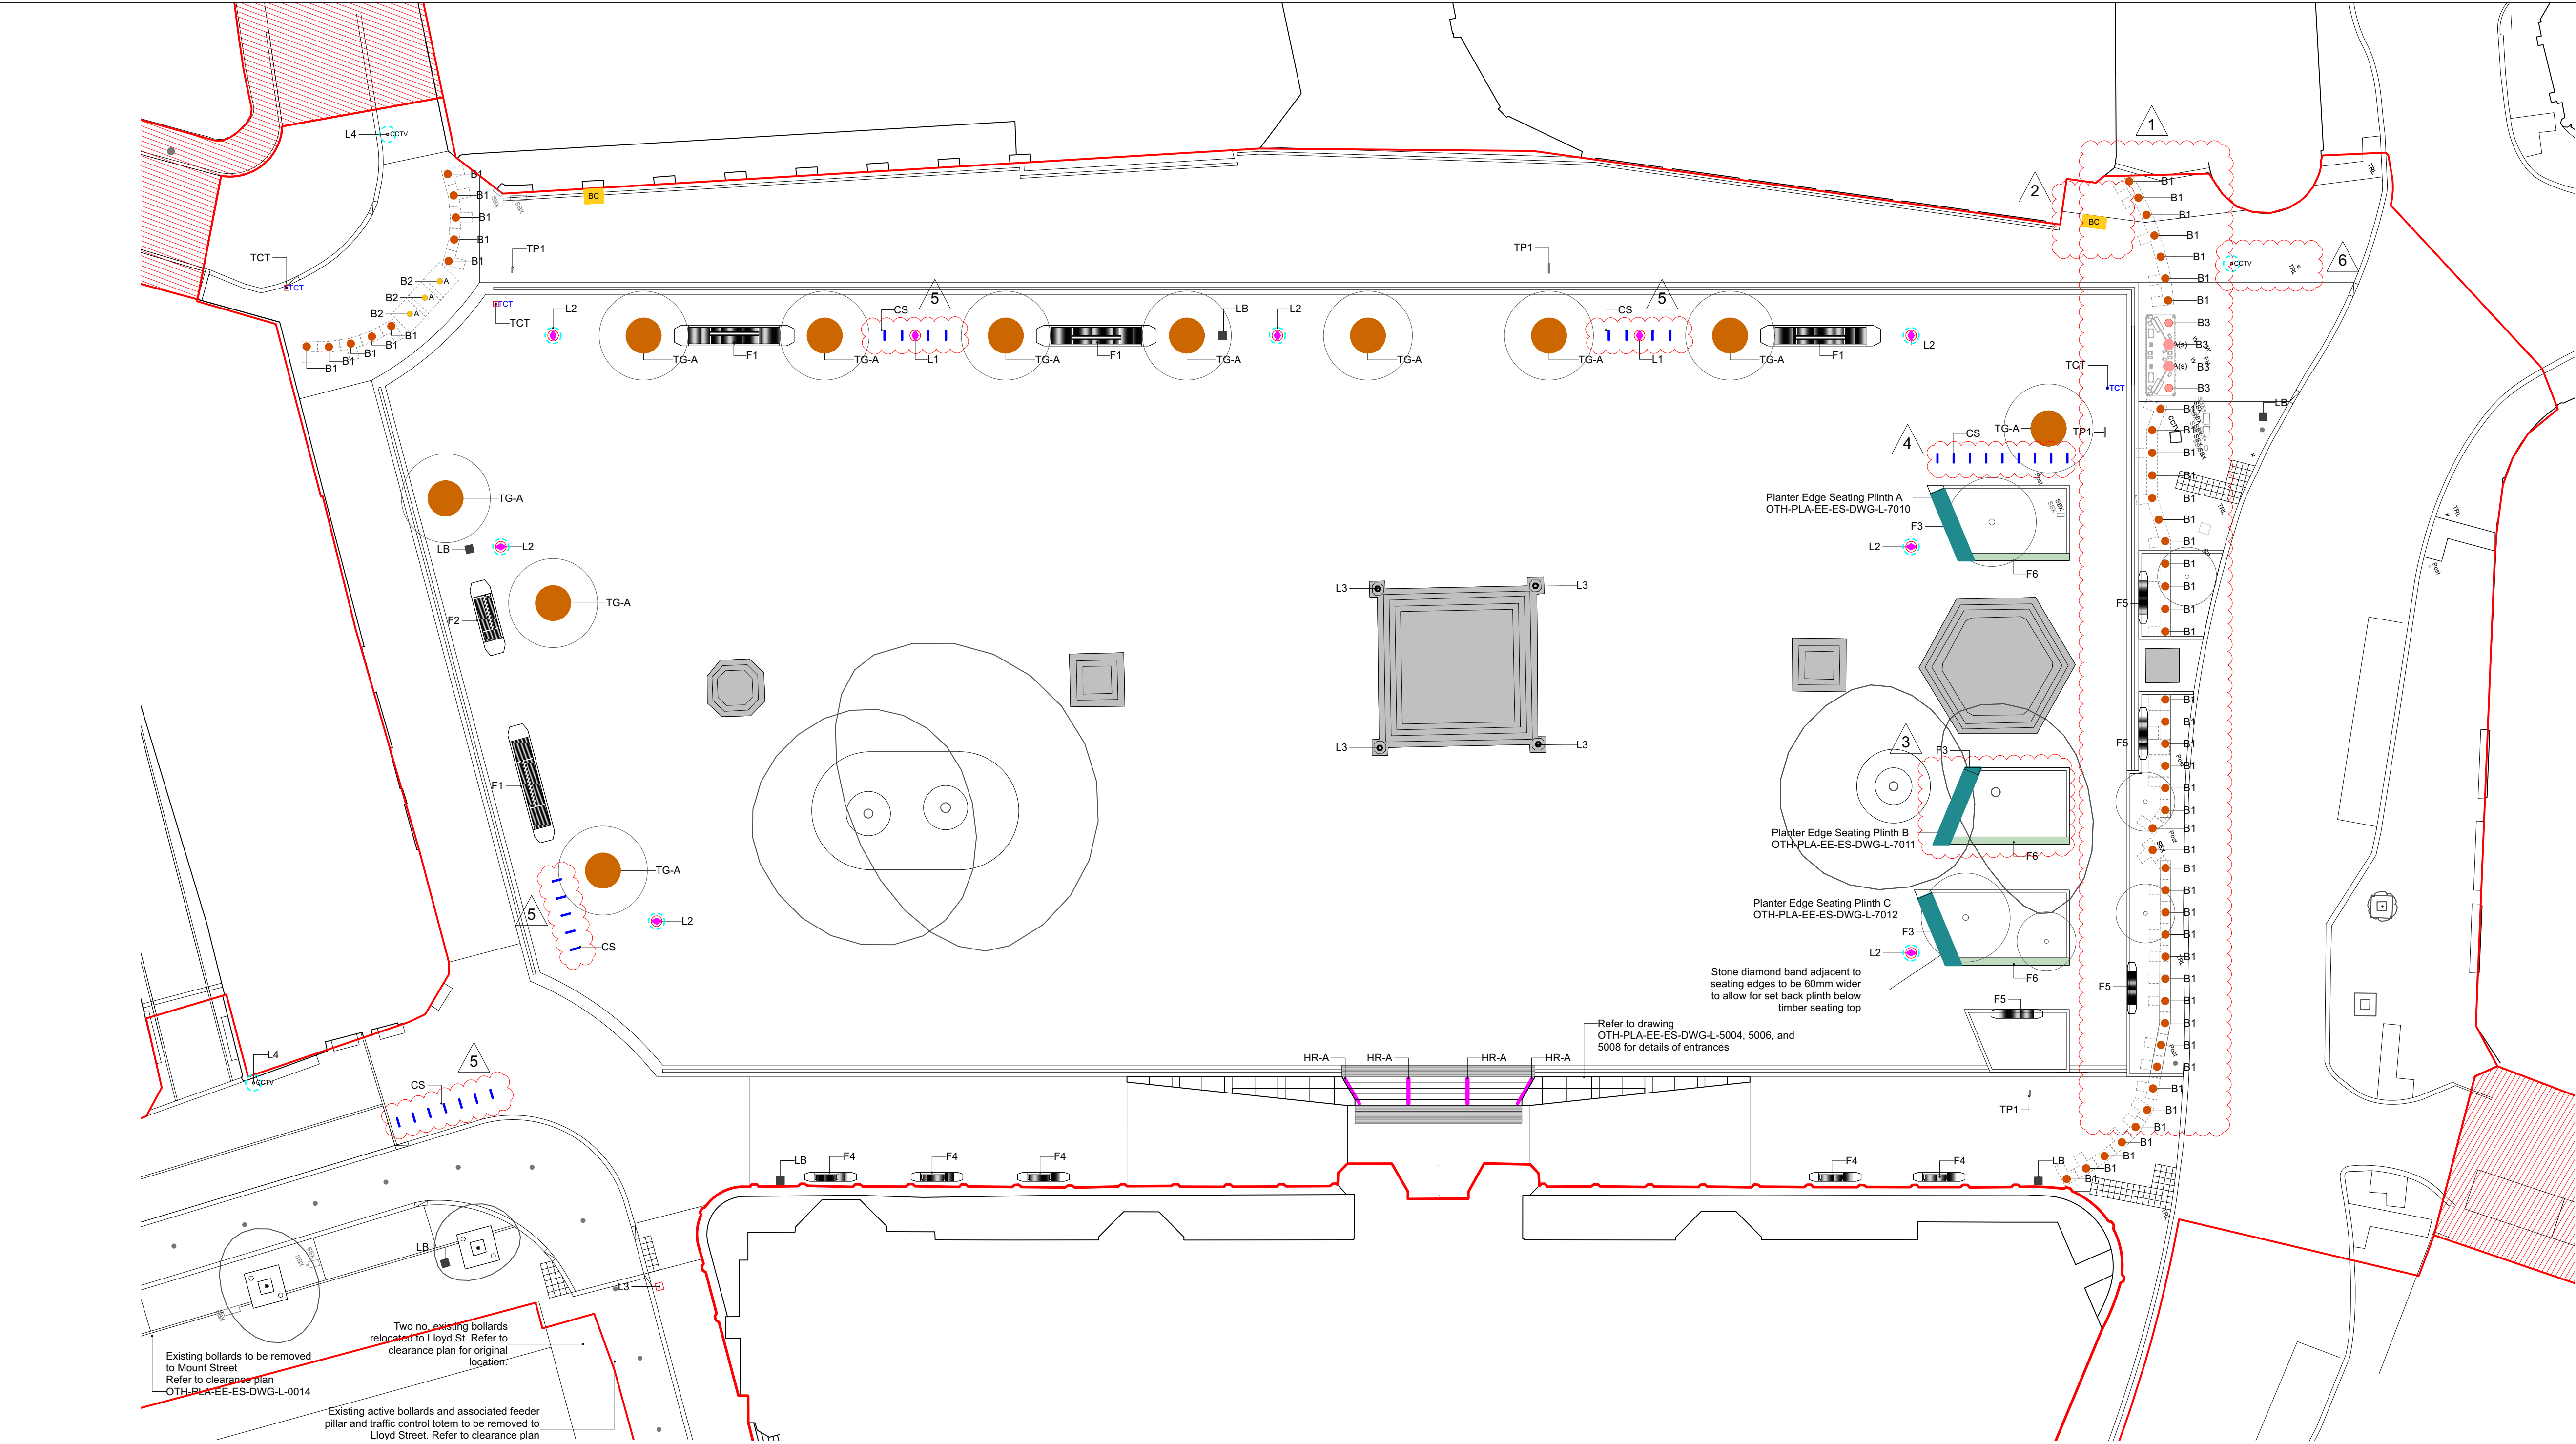

LOCATION PLAN

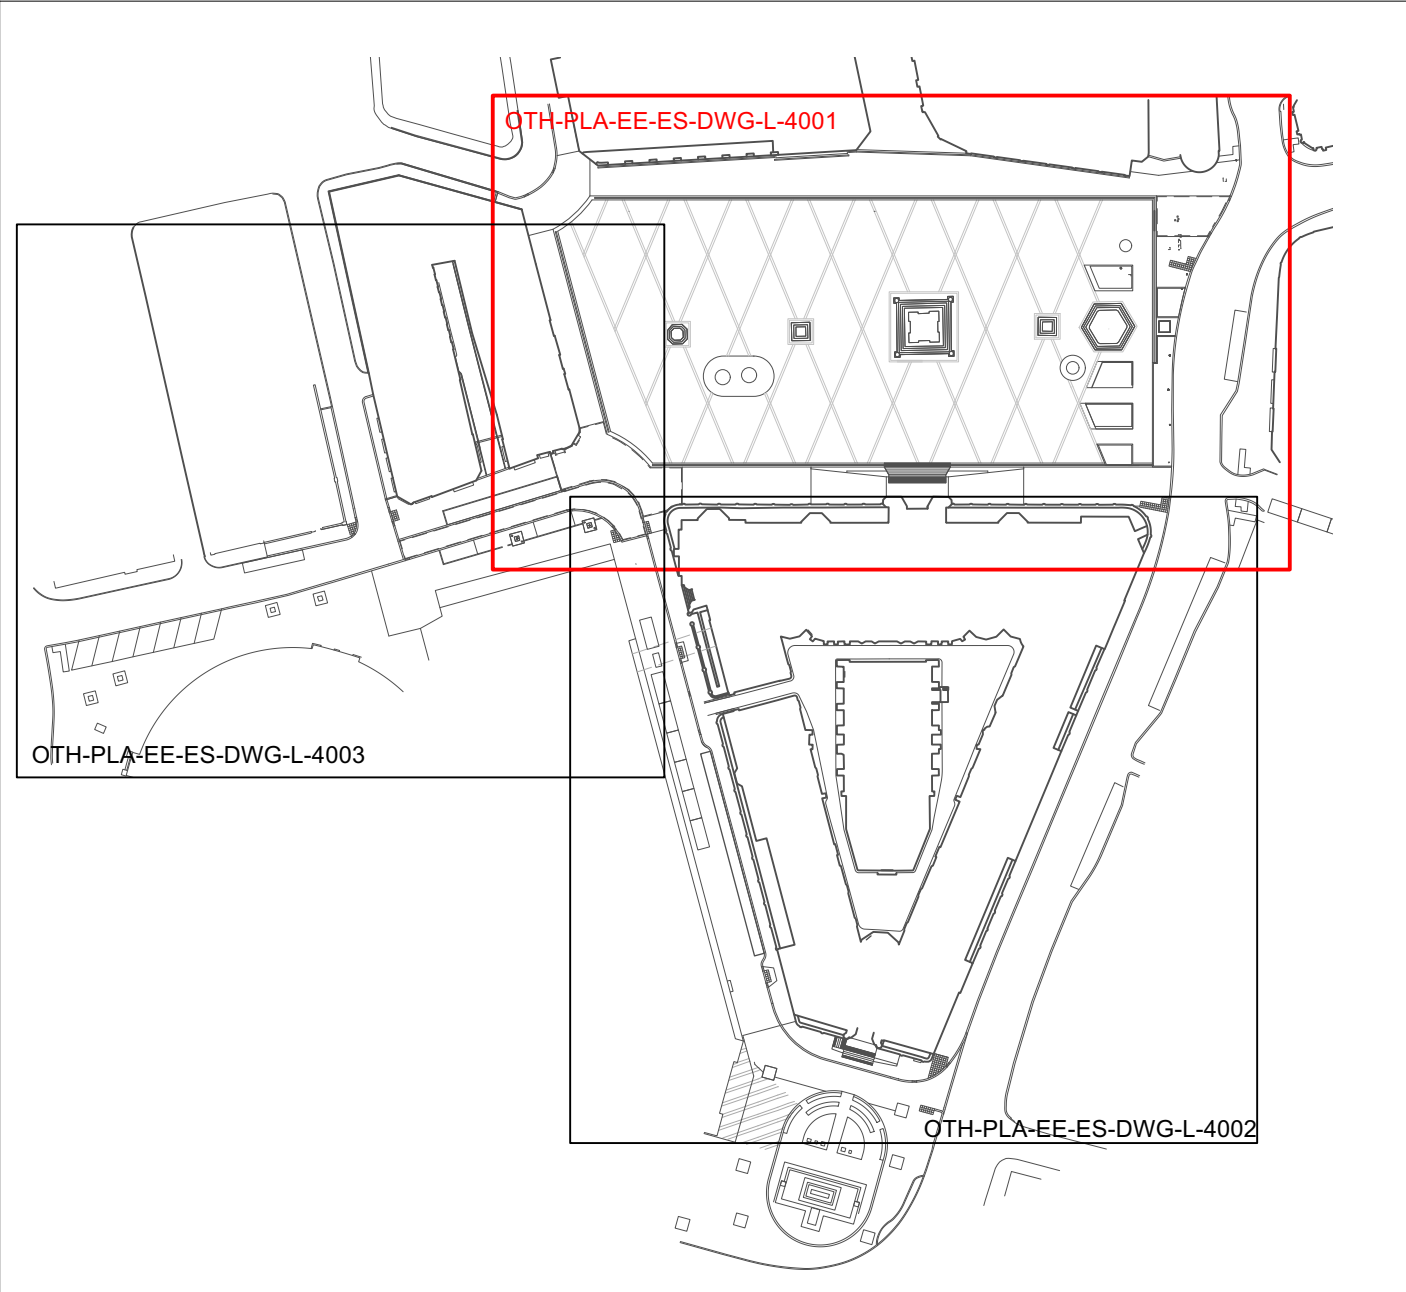

Revision Notes:

1. Updates to Princess St HVM bollard line - positions adjusted to avoid CCTV column clash and shallow services. Omission of 1no bollard due to realignment.
2. Bollard cabinet position updated as agreed with LPA.
3. Change to planter edge and seat detail to avoid existing tree root clash.
4. Relocation of cycle stands to avoid service cover clash.
5. Minor amendments to cycle stand positions / spacing.
6. Updates to TFGM equipment and lighting etc around HVM line.

C02	07/11/23	Construction Issue	SY	MS/KR
C01	01/04/21	Construction Issue	SR	MS/KR
08	26/02/21	Stage 4 Issue (Re-Coordination)	SR	MS/KR
07	14/11/19	Refer to revision notes	SR	MS/KR
06	11/10/19	Stage 4 Issue - revisions as described	SR	MS/KR
05	06/09/19	Planning Issue	SR	MS/KR
04	26/07/19	Stage 4 Issue	SR	MS/KR
03	31/05/19	Stage 3+ Issue	SR	MS/KR
02	21/01/19	Refer to revision notes	SR	MS/KR
01	30/11/18	Stage 3 Issue	SR	MS/KR

NOTES

1. Drawings are for information only.
2. All dimensions are in millimetres unless otherwise stated.
3. All dimensions are in millimetres unless otherwise stated.
4. The dimensions of all materials must be checked on site before being used.
5. The dimensions of all materials must be checked on site before being used.
6. The dimensions of all materials must be checked on site before being used.
7. Check of construction and setting out to be agreed on site.

KEY

BOUNDARIES

- Red Line Boundary
- Section 278 Works

LIGHTING & CCTV

Refer to main lighting drawing OTH-PLA-EE-ES-DWG-L-0045 for lighting general arrangement and any associated drawings and specifications.

- L1 Bespoke Lighting Column 14m height
- L2 Bespoke Lighting Column with CCTV 14m height
- L3 Heritage Lighting Column
- L4 CCTV column - 4m height
- Existing lighting column to be retained/relocated to Mount St. & Princess St.

FURNITURE

For furniture foundation details refer to Ramboll drawings OTH-RAH-EE-ES-DWG-N-0106 & OTH-RAH-EE-ES-DWG-N-0107

- F1 Large Seating Plinths
To Albert Square. Bespoke design: natural stone plinth feet, steel structural frame and timber seating tops
Refer to detail drawing OTH-PLA-EE-ES-DWG-L-7000
For foundation details, refer to Ramboll drawings OTH-RAH-EE-ES-DWG-N-0106 & OTH-RAH-EE-ES-DWG-N-0107
- F2 Small Seating Plinths
To Albert Square. Bespoke design: natural stone plinth feet, steel structural frame and timber seating tops
Refer to detail drawing OTH-PLA-EE-ES-DWG-L-7003
For foundation details, refer to Ramboll drawings OTH-RAH-EE-ES-DWG-N-0106 & OTH-RAH-EE-ES-DWG-N-0107
- F3 Planter Edge Seating Plinth
To Albert Square. Bespoke design: natural stone base, steel structural frame and timber seating tops
Refer to detail drawing OTH-PLA-EE-ES-DWG-L-7010 to 7013 for further details.
For foundation details, refer to Ramboll drawings OTH-RAH-EE-ES-DWG-N-0106 & OTH-RAH-EE-ES-DWG-N-0107
- F4 Freestanding benches
To planting areas. Steel structural frame with timber seating tops.
Refer to detail drawing OTH-PLA-EE-ES-DWG-L-7002.
- F5 Railing benches
To planting areas. Steel frame with timber seating tops.
Refer to detail drawing OTH-PLA-EE-ES-DWG-L-7002.
- F6 Natural stone plinth / seating edge to planter
To planting areas. Natural stone.
Refer to detail drawing OTH-PLA-EE-ES-DWG-L-7013.
- CS Cycle stands
Refer to detail drawing OTH-PLA-EE-ES-DWG-L-7004 for further details.
For foundation details, refer to Ramboll drawings OTH-RAH-EE-ES-DWG-N-0106 & OTH-RAH-EE-ES-DWG-N-0107
- TG-A Tree grilles
Refer to detail drawing OTH-PLA-EE-ES-DWG-L-4005
- TG-B Tree grilles to Princess Street
Refer to detail drawing OTH-PLA-EE-ES-DWG-L-7007
- LB Litter bins
Refer to detail drawing OTH-PLA-EE-ES-DWG-L-7005
- HR-A Handrails to Albert Square Entrance
detail drawing OTH-PLA-EE-ES-DWG-L-7009
- HR-B Handrails to Cooper Street Entrance
detail drawing OTH-PLA-EE-ES-DWG-L-7008

VEHICLE SECURITY FEATURES

Refer to Arup security specification in conjunction with this drawing. For final positions of bollards and associated features refer to specialist suppliers layout and fabrication drawings

- B1 Static Bollard
Refer to drawings OTH-PLA-EE-ES-DWG-L-7003 for further details.
For foundation details, refer to ATG Access Ltd drawings and specifications.
- B2 Active (Telescopic) Bollard
Refer to drawings OTH-PLA-EE-ES-DWG-L-7003 for further details.
For foundation details, refer to ATG Access Ltd drawings and specifications.
- B3 Active (Sliding) Bollard
A bollard array including 3 active and 2 sliding bollards. For foundation details, refer to Head Ltd drawings and specifications.
- BCP Telescopic Bollard Control Panel
For foundation details, refer to ATG Access Ltd drawings and specifications.
- TCT Traffic Control Totem
For foundation details, refer to ATG Access Ltd drawings and specifications.
- Existing bollards to be retained on Mount St. & Lloyd St.

WAYFINDING

- TP1 Wayfinding Elements
Refer to separate wayfinding drawing OTH-PLA-EE-ES-DWG-L-4003.
- Existing post box relocated
- Existing Ocean Digital display board relocated

Additional Existing Features Retained

- Existing post retained
Related to tramline and/or existing crossings
- Existing traffic light retained
- Existing signpost retained
- Existing service box retained

Revision	Date	Description	Drawn	Appr.

Planit I.E. Limited

E: info@planit-ie.com W: planit-ie.com

MANCHESTER
2 Back Grafton St., Altrincham, WA14 1DY
T: 0161 928 9281

LONDON
Unit 6 Waterside, 44-48 Wharf Road, London, N1 7UX
T: 0207 253 5678

LIVERPOOL
No. 8 Princes Parade, Princes Dock, Liverpool, L3 1DL
T: 0151 705 6746

Client Manchester City Council

Project Our Town Hall

Drg Title Furniture General Arrangement 1 of 3

Created on	Created by	Approved by
19.09.18	SR	MS/KR

Scale	Size	Workstage
1:250	A1	Stage 5

Drg No.	Suitability	Revision
OTH-PLA-EE-ES-DWG-L-4000	S4	C02

© Planit I.E. Limited

