



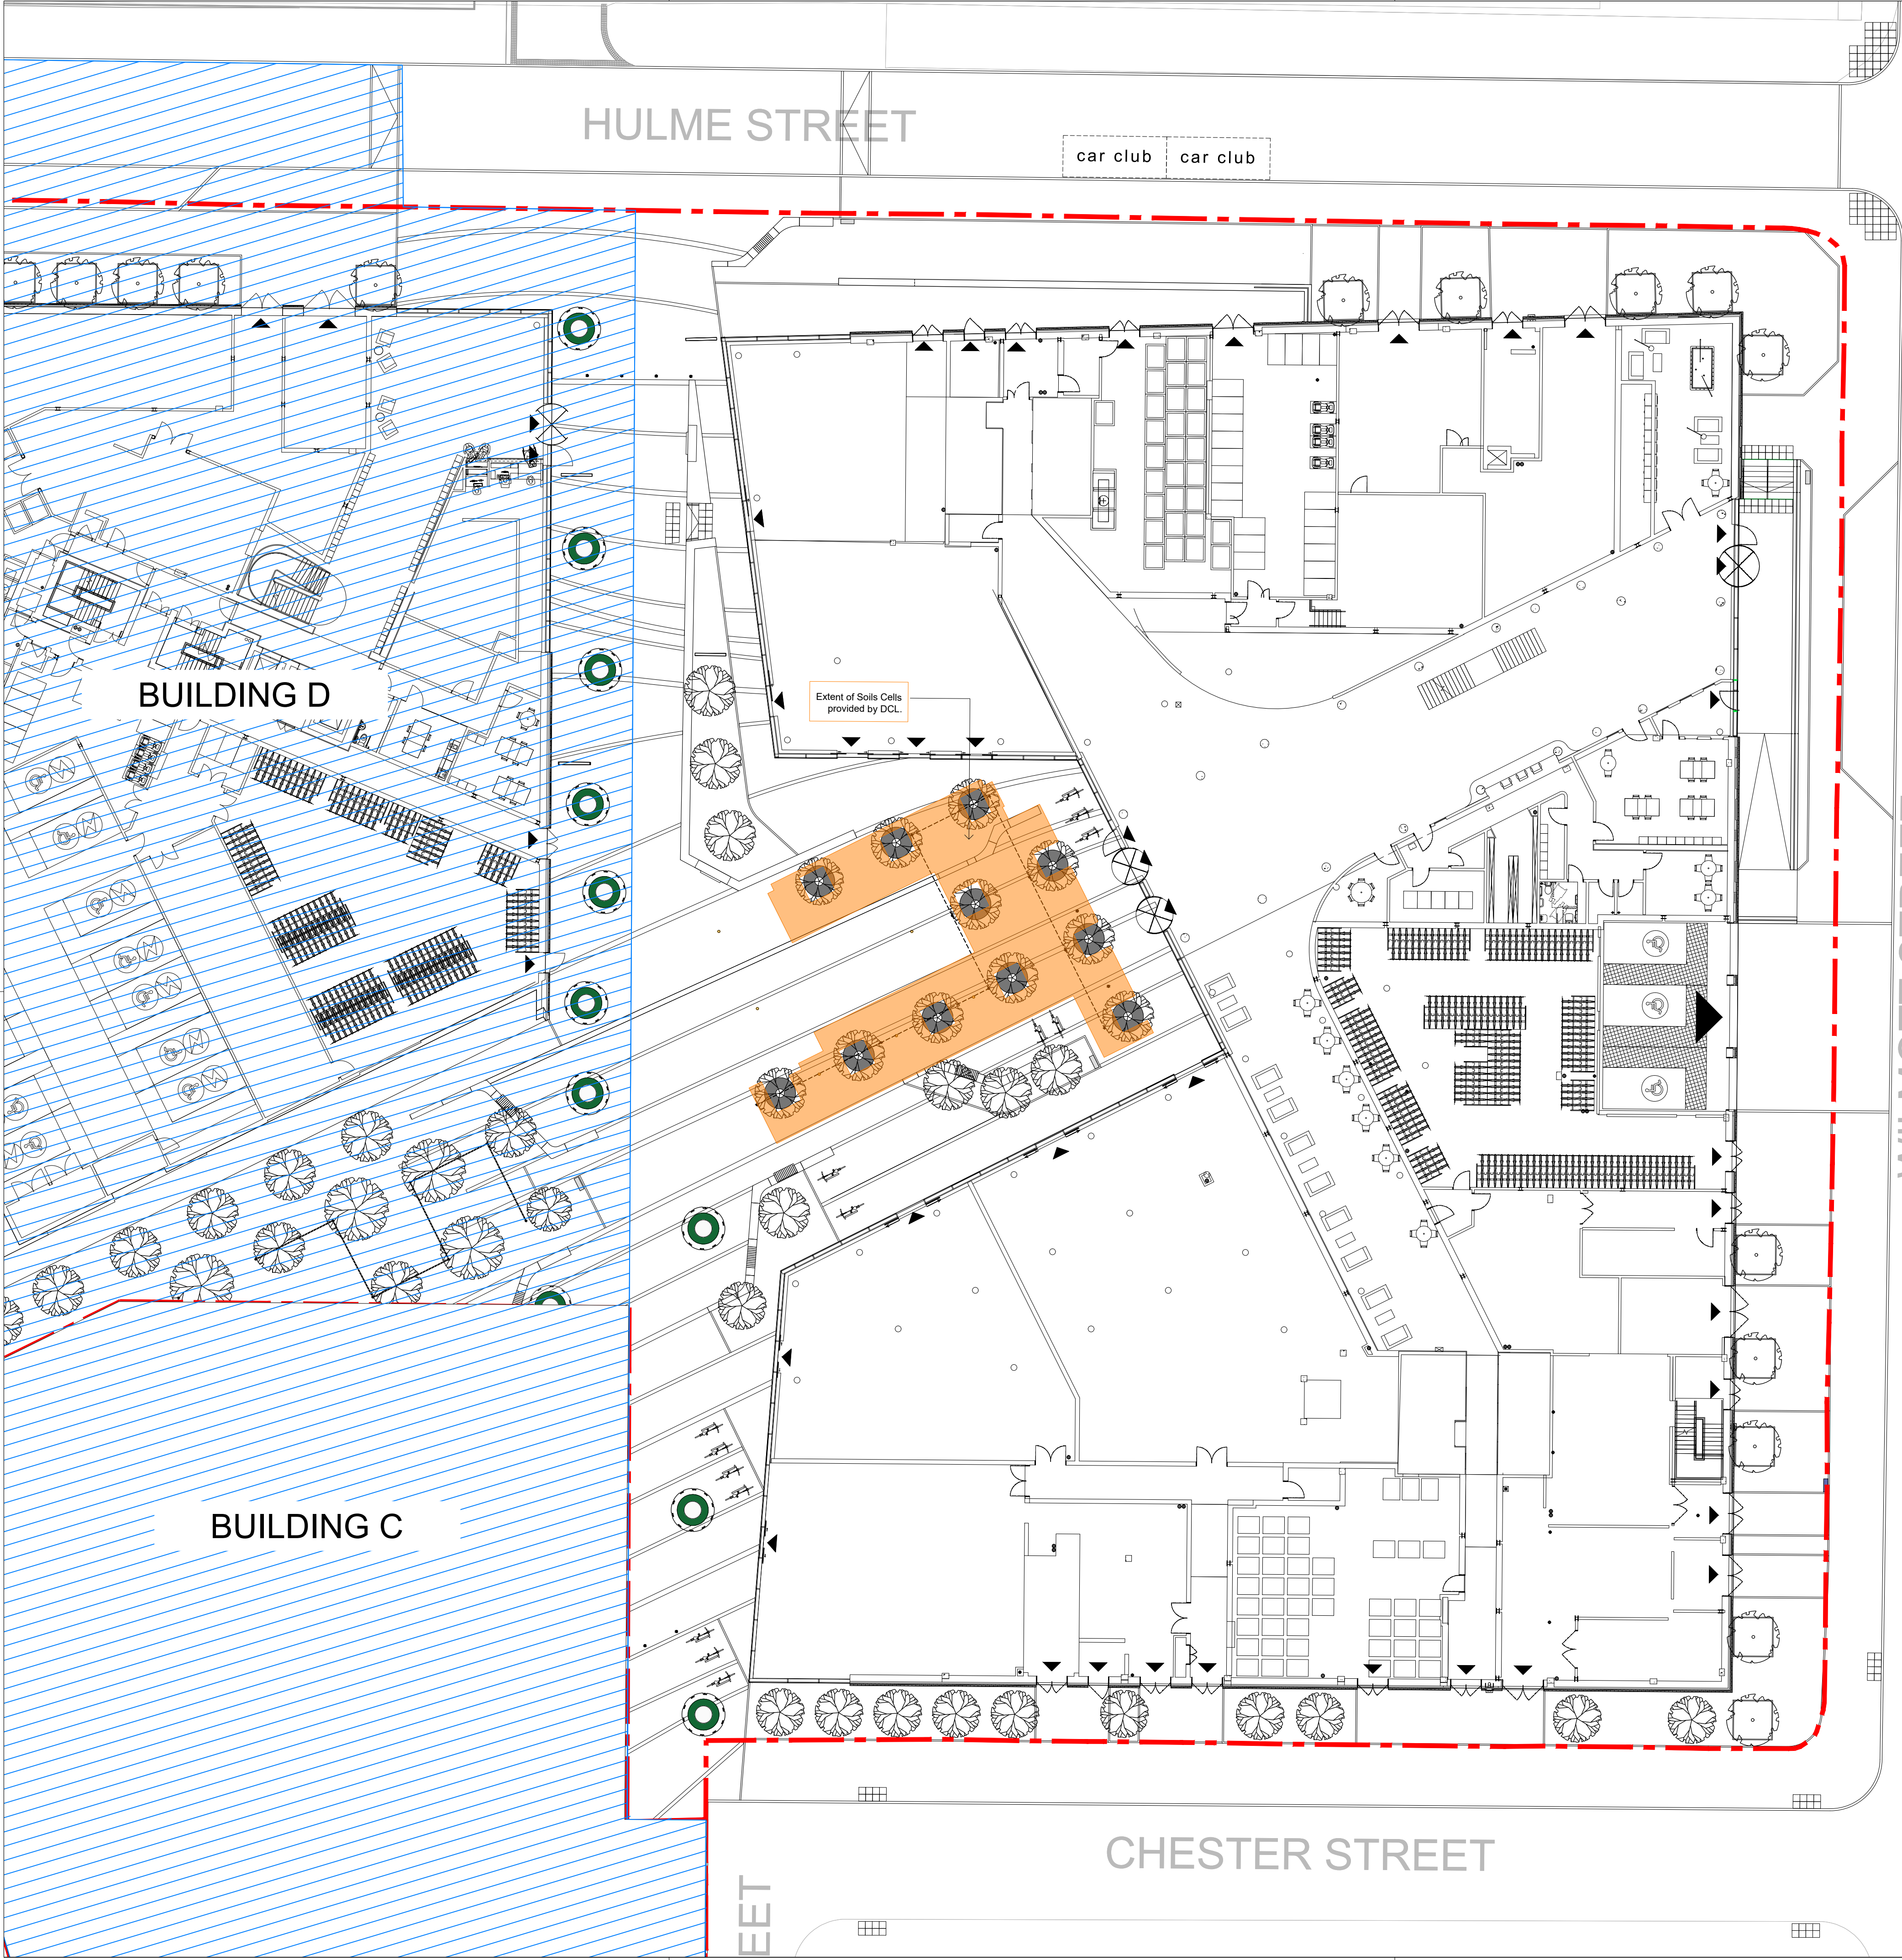

- NOTES
1. This drawing is to be read in conjunction with all other drawings and specifications.
 2. Do not scale off this drawing. Written dimensions to be taken only.
 3. Any discrepancies found between this drawing and other drawings and specifications in the construction documents must be referred to the Landscape Architect prior to work commencing.
 4. This drawing must not be copied in whole or in part without prior written consent of Optimised Environments Ltd.
 5. Survey information is based upon aspect surveyors Topographical as Survey.

CDM INFORMATION

KEY PLAN

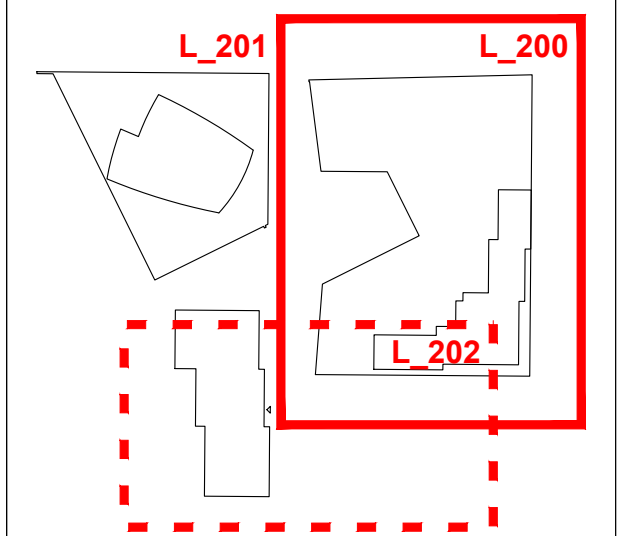

-	AS BUILT	CO	06.03.25
Issue	Revision	Initial	Date

open
optimised environments

optimised environments ltd
EDINBURGH 2nd Floor | Quartermile Two | 2 Lister Square | Edinburgh | EH3 9GL
t: 0131 221 9820 | e: optimisedenvironments.com
LONDON Warford Court | 28 Throgmorton Street | London | EC2N 2AT
t: 020 79474562 | e: optimisedenvironments.com
MANCHESTER 13 Swan Street | Manchester | M4 5JJ
t: 0161 696 7550 | e: optimisedenvironments.com

Client
Downing Living (Manchester) Ltd

Project
PLOT 11 FIRST STREET SOUTH
Manchester

Drawing Title
**EXTENT OF CONSTRUCTED
SOIL CELLS**
Sheet 1 of 1

Scale Bar	North
2m 4m 6m 8m 10m	
Scale: 1:200@A1	Date: Feb 2025
By: CO	Status: AS BUILT
Checked: BP	Approved: BP
Drawing Number M90183_AB_250306.01	Rev -