


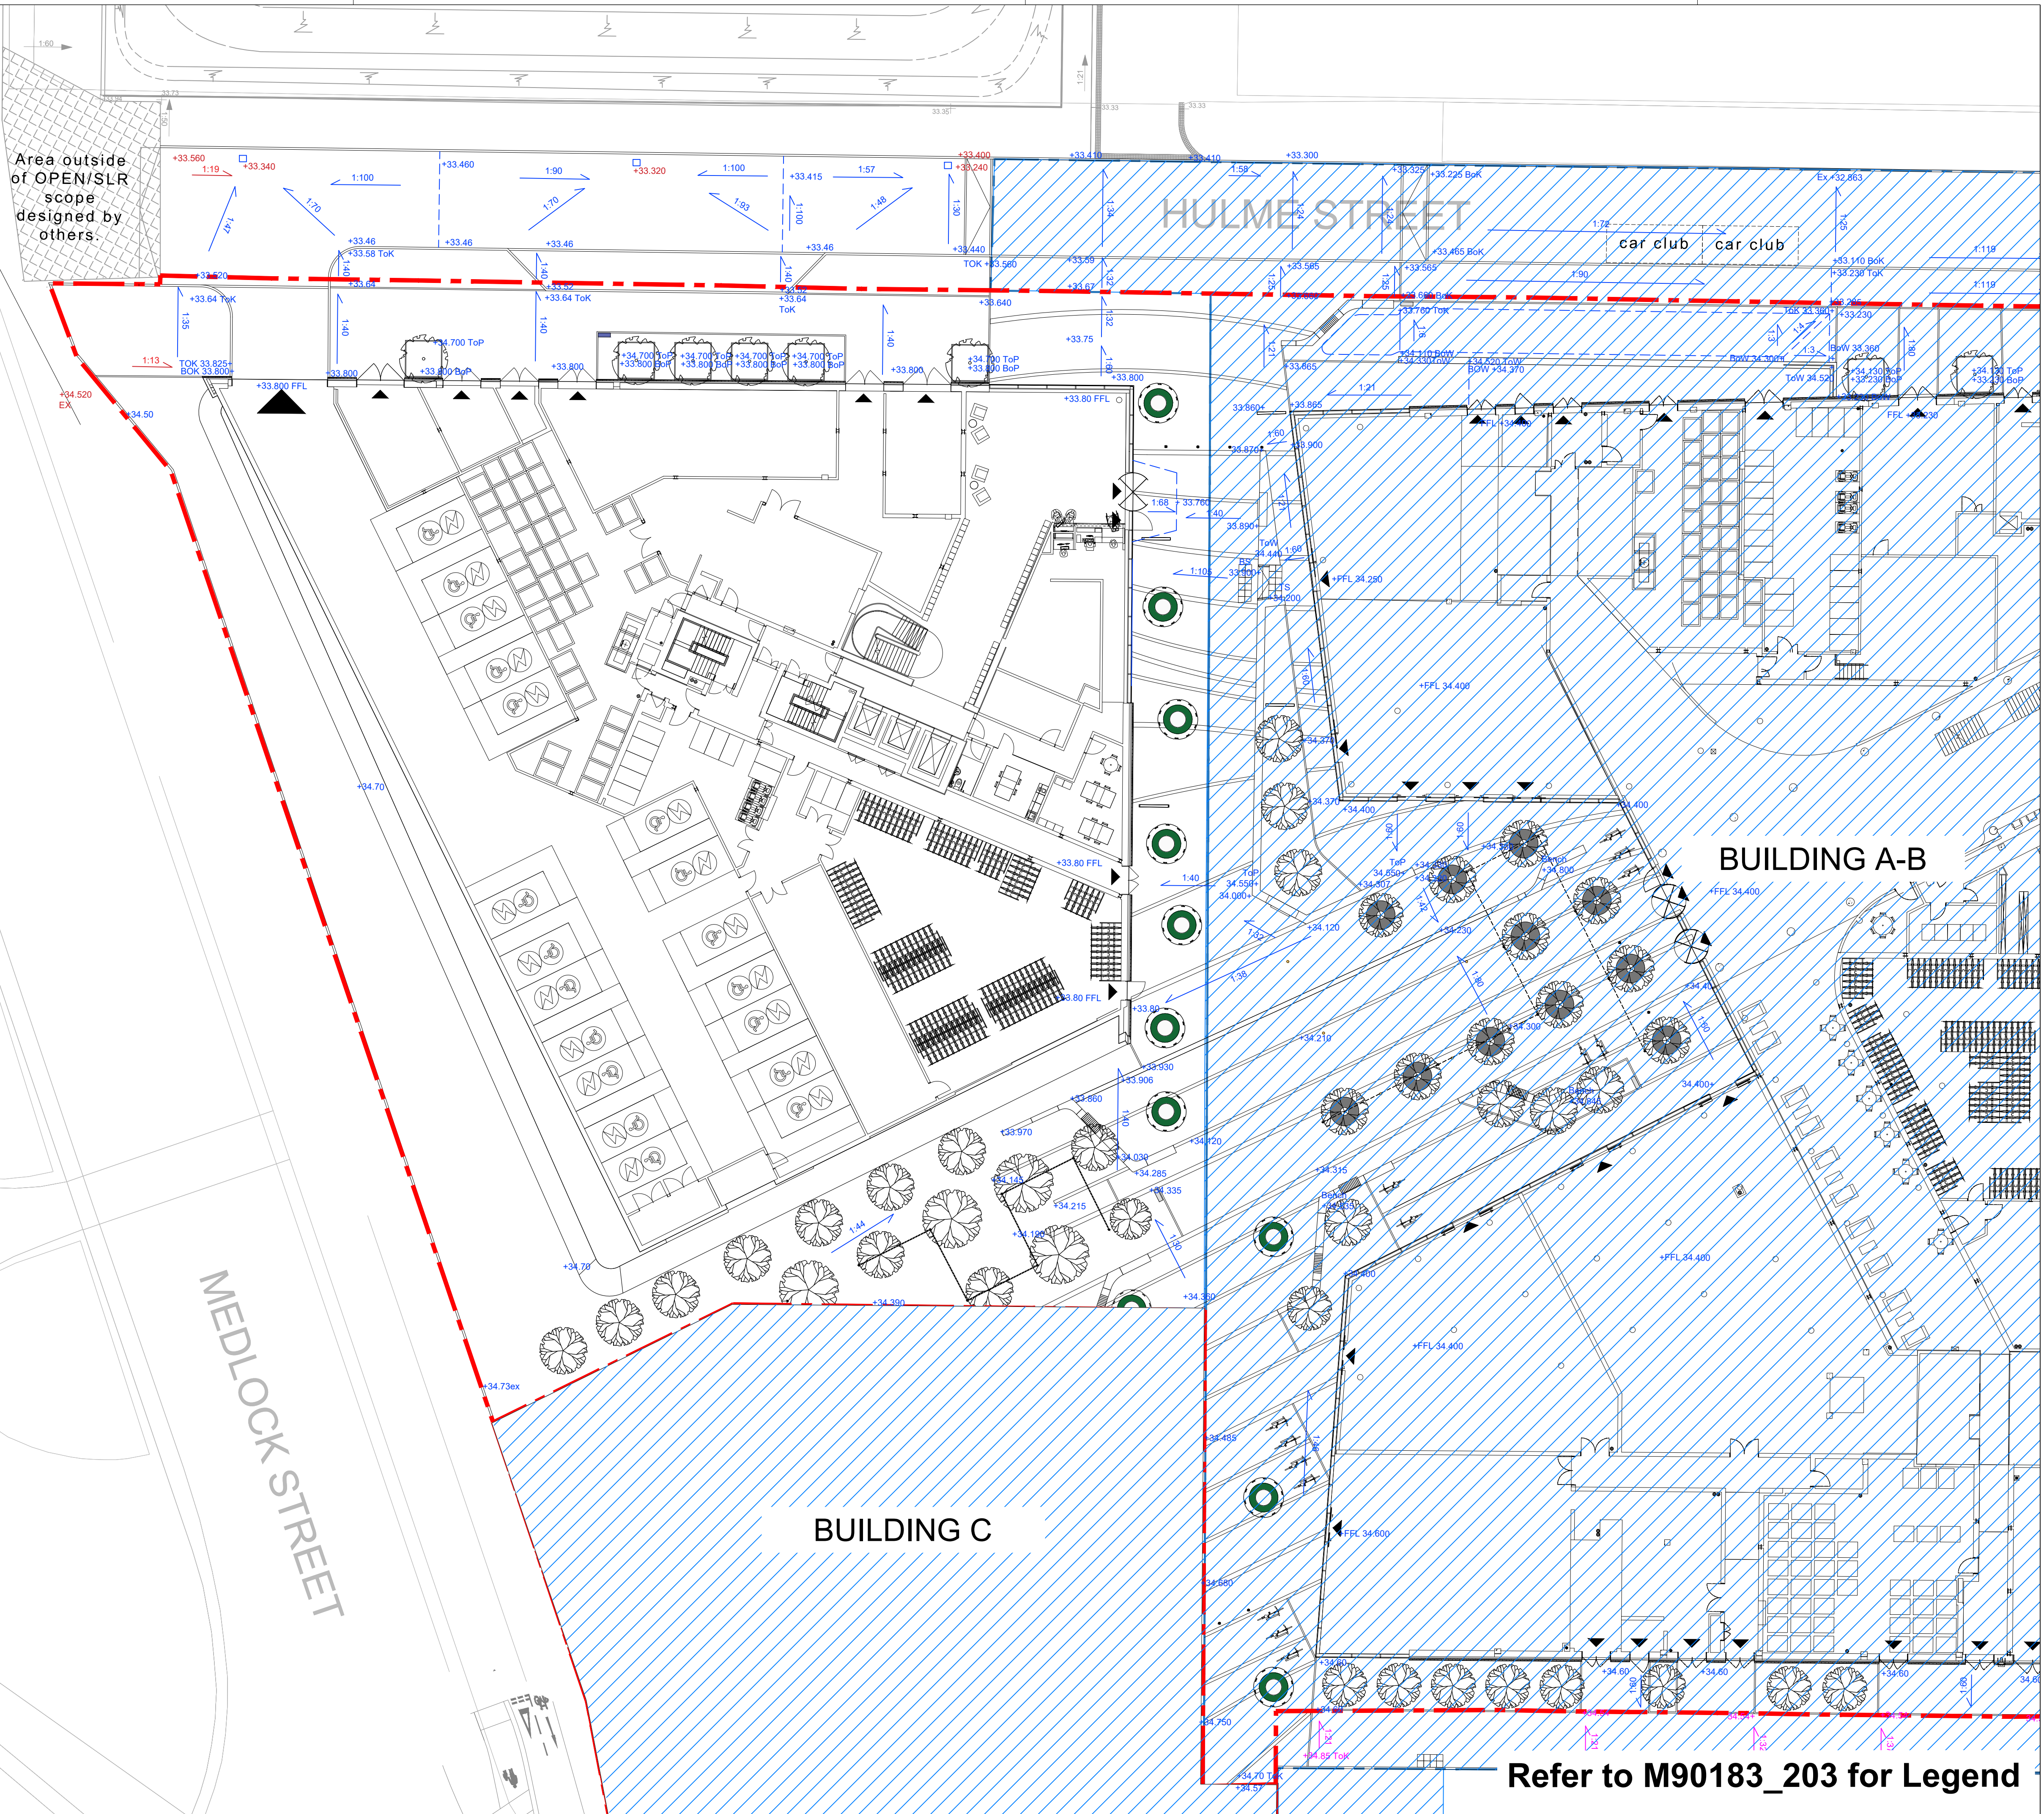

Area outside  
of OPEN/SLR  
scope  
designed by  
others.

HULME STREET

car club car club

BUILDING A-B

BUILDING C

MEDLOCK STREET

Refer to M90183\_203 for Legend

NOTES

- This drawing is to be read in conjunction with all other drawings and specifications.
- Do not scale off this drawing. Written dimensions to be taken only.
- Any discrepancies found between this drawing and other drawings and specifications in the construction documents must be referred to the Landscape Architect prior to work commencing.
- This drawing must not be copied in whole or in part without prior written consent of Optimised Environments Ltd.
- Survey information is based upon aspect surveyors Topographical as Survey.

CDM INFORMATION

KEY PLAN

|       |                              |         |          |
|-------|------------------------------|---------|----------|
| 17    | AS BUILT                     | CO      | 23.06.25 |
| 16    | Event of Green Slope reduced | CO      | 10.02.25 |
| 15    | HULME STREET LEVEL UPDATE    | CO      | 02.12.24 |
| 14    | VERB LEVELS UPDATED          | SB      | 20.11.24 |
| 13    | LEVELS UPDATED               | SB      | 18.11.24 |
| 12    | LEVELS UPDATED               | SB      | 18.11.24 |
| 11    | LINework UPDATED             | SB      | 15.11.24 |
| 10    | INDICATIVE GULLIES OMITTED   | CO      | 30.08.24 |
| 09    | OF UPDATES                   | AH      | 14.08.24 |
| 08    | BOLLARDS ADDED               | SB      | 17.05.24 |
| 07    | ADDITIONAL REQUESTED LEVELS  | AH      | 15.02.24 |
| 06    | REVISED TREES                | SB      | 19.09.23 |
| 05    | TREES REINSTATED             | SB      | 23.08.23 |
| 04    | Architectural Update         | CO      | 03.08.23 |
| 03    | Architectural Update         | CO      | 18.08.23 |
| 02    | Architectural Update         | CO      | 27.04.23 |
| A     | STAGE 4                      | CO      | 31.10.22 |
| Issue | Revision                     | Initial | Date     |

open  
optimised environments

optimised environments ltd  
2nd Floor | Quatermill Two | 2 Lister Square | Edinburgh | EH3 9GL  
t 0131 221 9830 | e optimisedenvironments.com

EDINBURGH

LONDON  
Warford Court | 29 Throgmorton Street | London | EC2N 2AT  
t 020 79474562 | e optimisedenvironments.com

MANCHESTER  
13 Swan Street | Manchester | M4 5JZ  
t 0161 696 7550 | e optimisedenvironments.com

Client  
**Downing Living (Manchester) Ltd**

Project  
**PLOT 11 FIRST STREET SOUTH**  
**Manchester**

Drawing Title  
**BUILDING D  
PUBLIC REALM LEVELS & GRADES**

Scale Bar  
2m 4m 6m 8m 10m  
North

Scale: 1:200@A1 Date: Jan 2022

By: CO Status: AS BUILT

Checked: AW Approved: AW

Drawing Number  
**M90183\_D\_L600**

Rev  
**17**

Computer File: R:\Projects\2019\M90183\_FirstStreet\AUTOCAD\SHEETS\PHASE D