

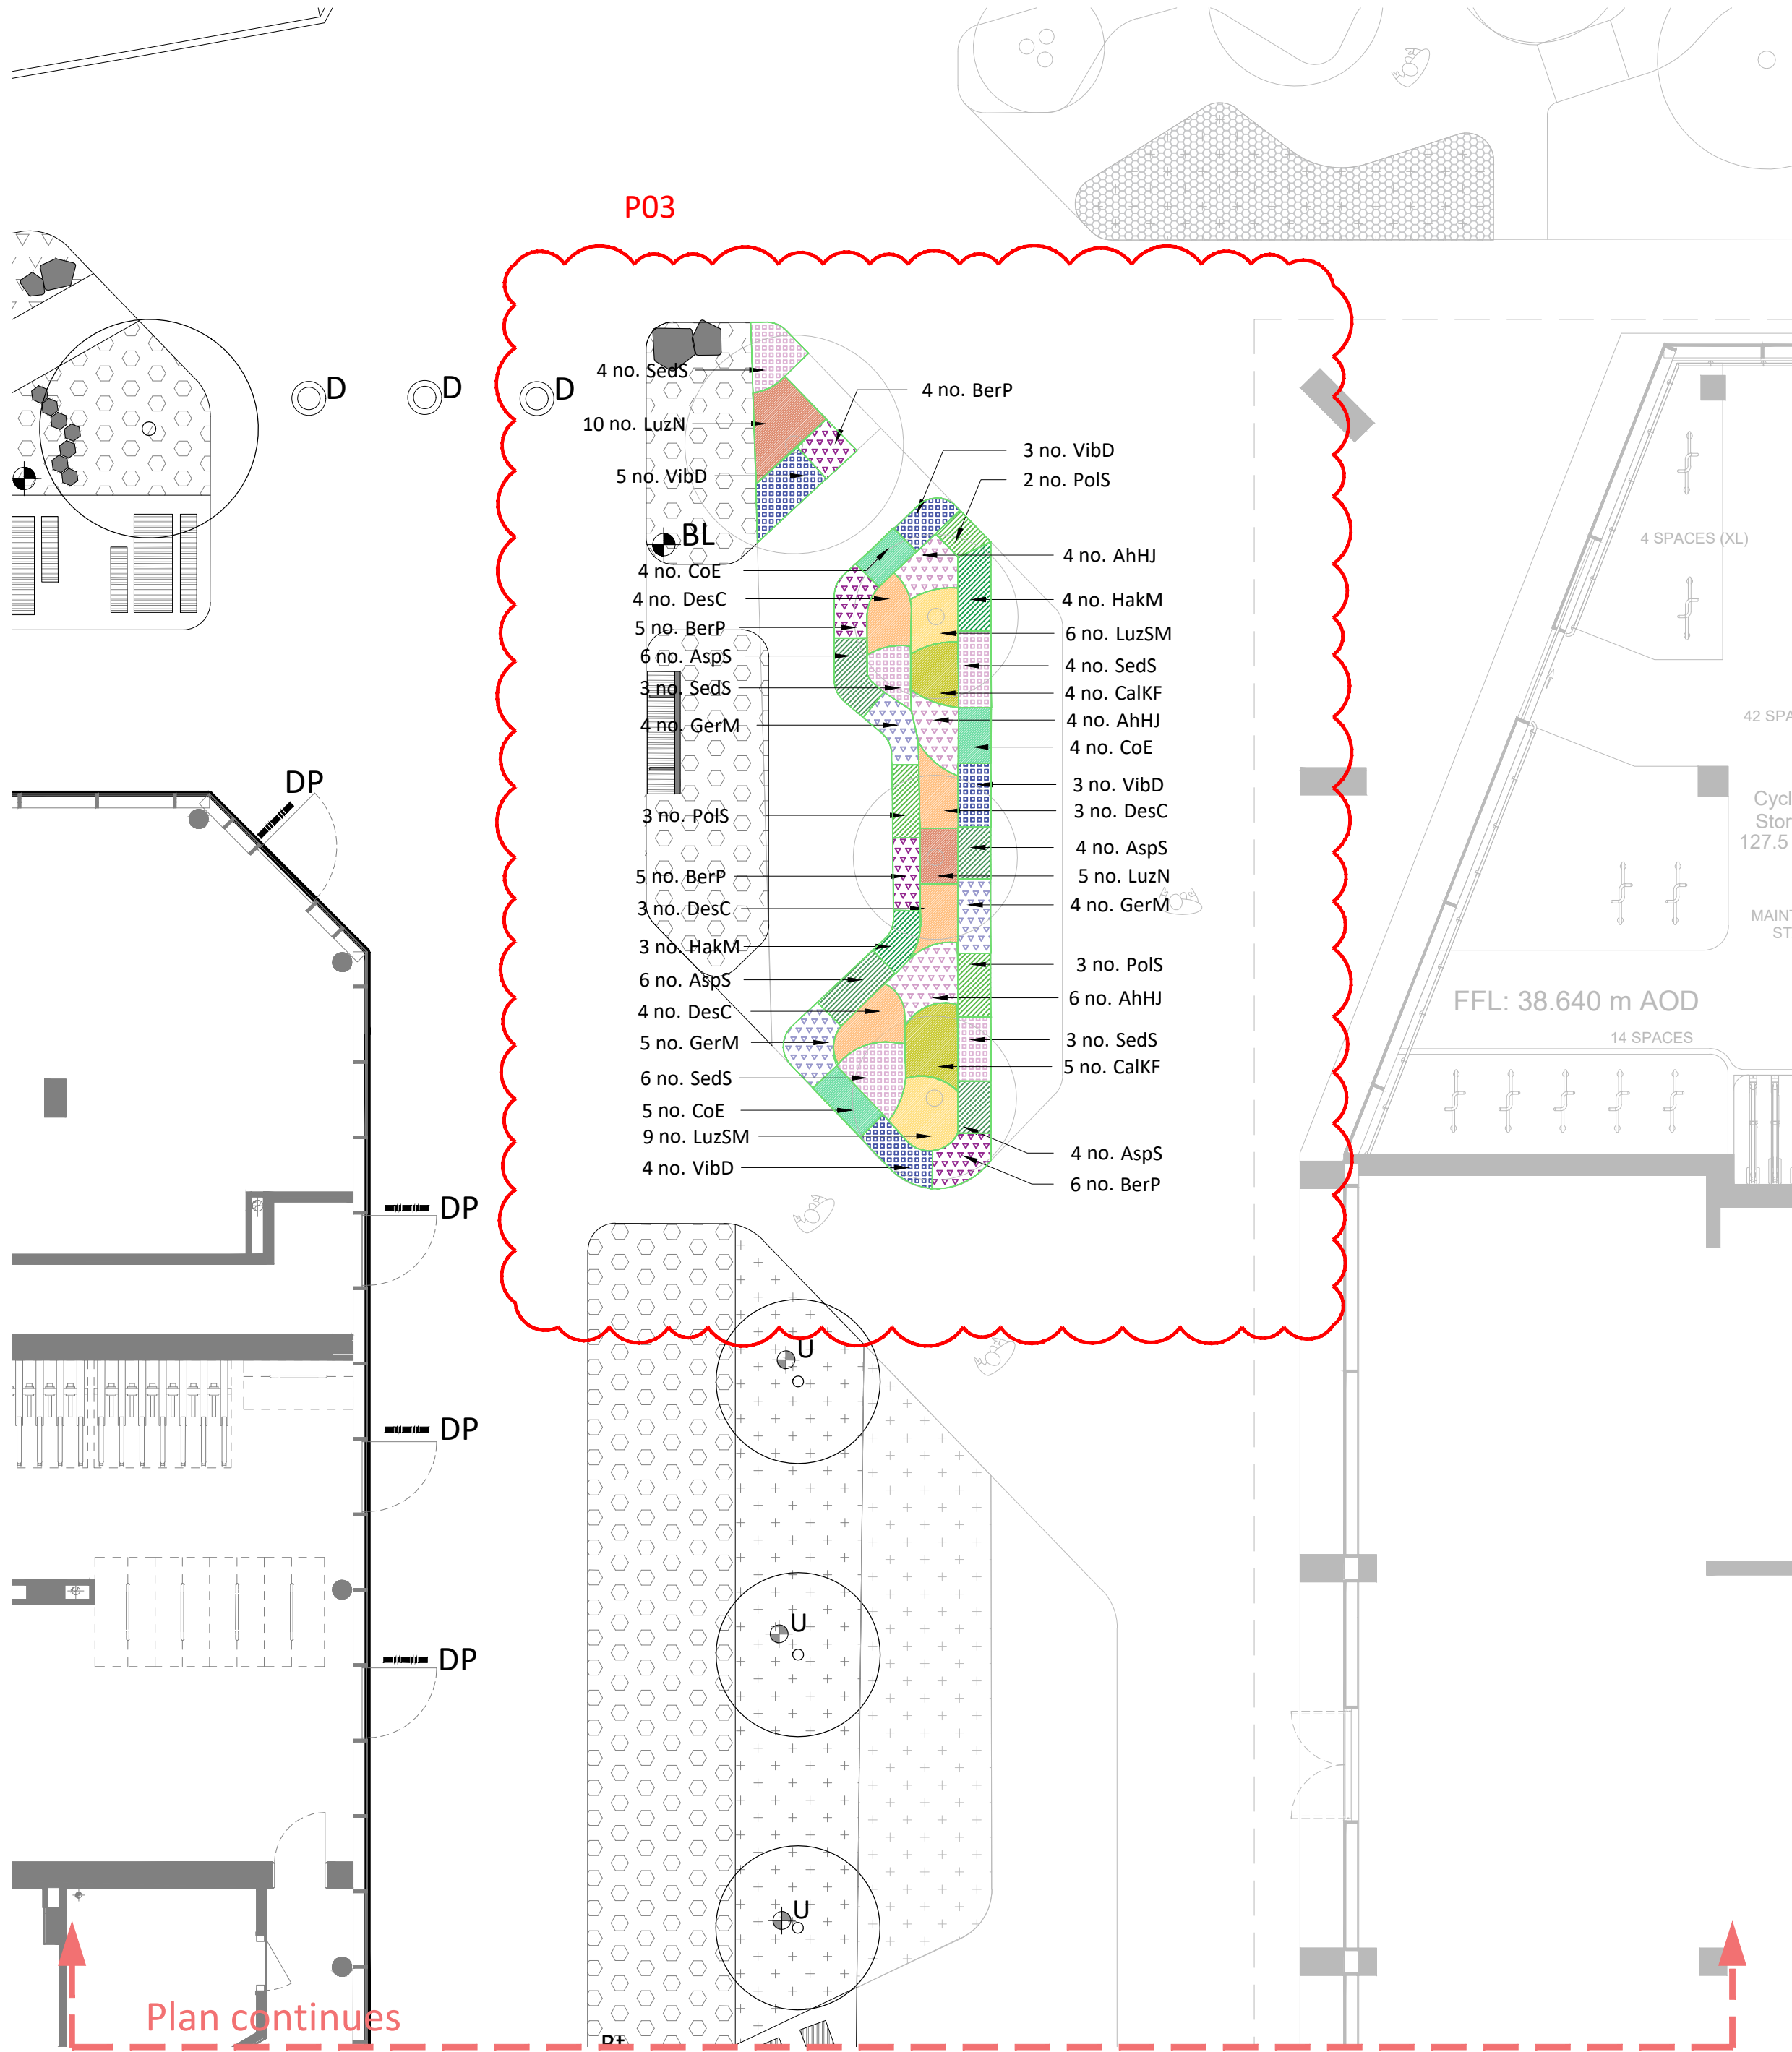


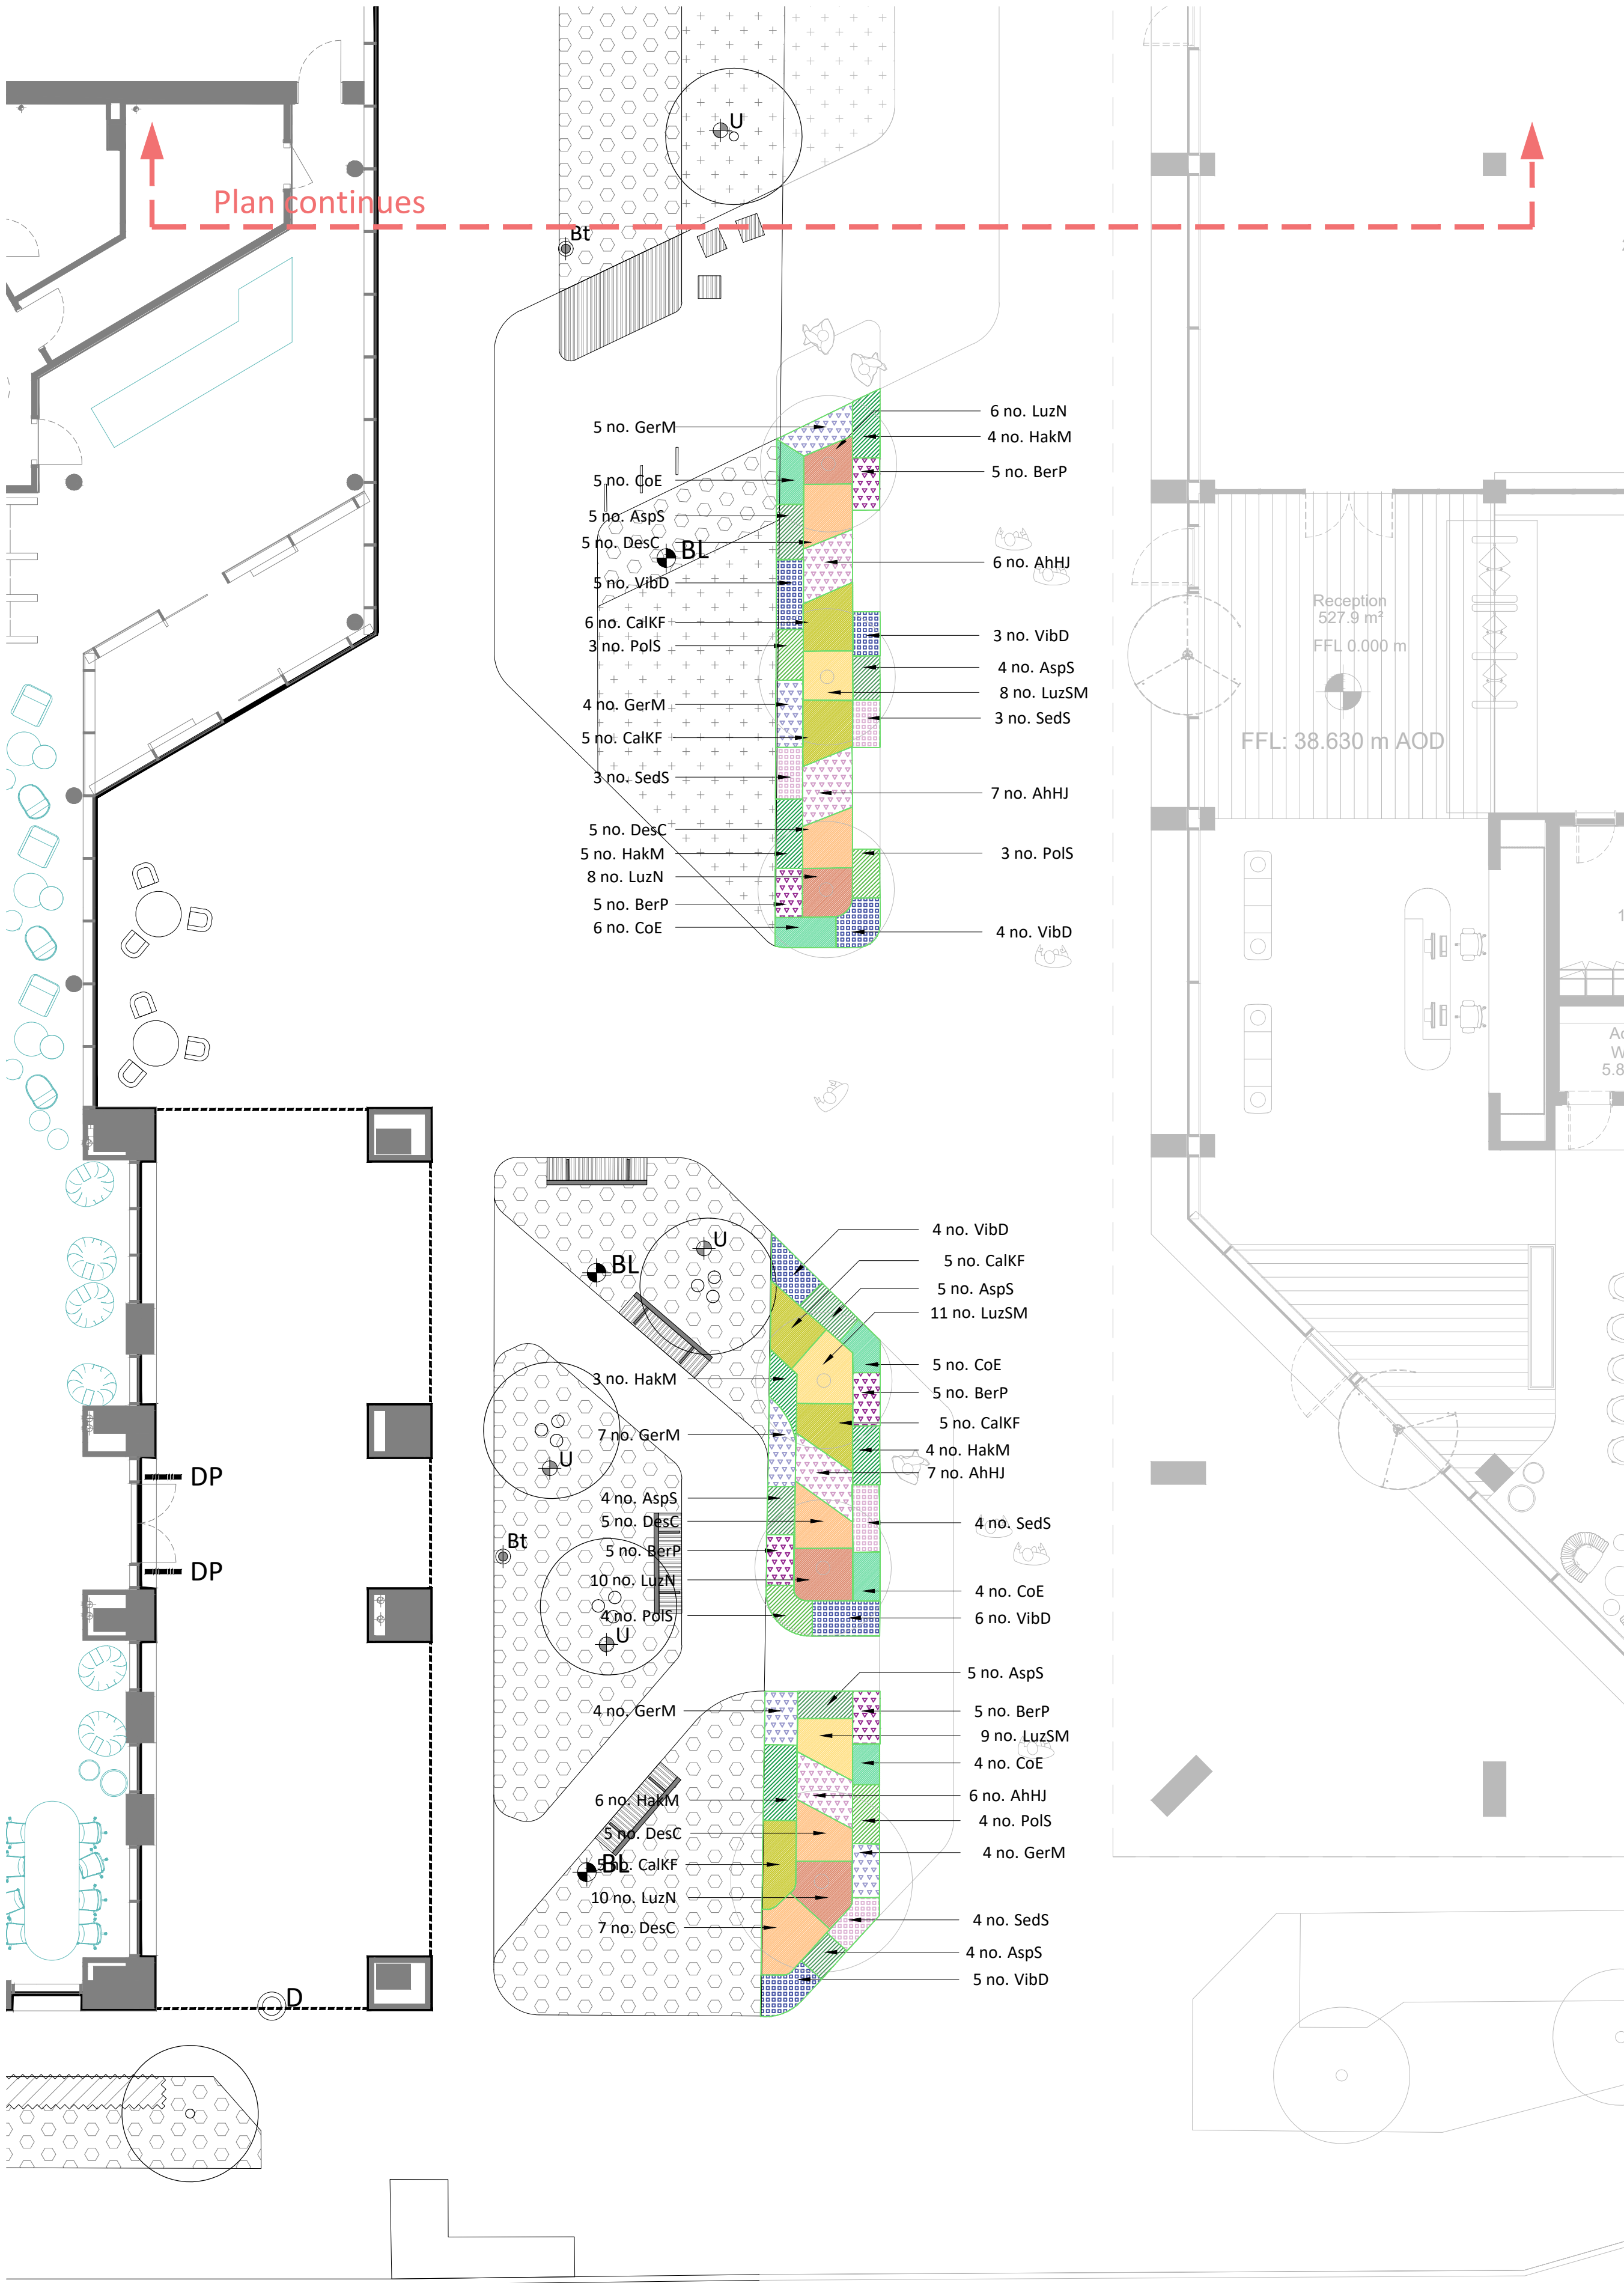

- Notes**
- All dimensions in mm, unless otherwise stated.
 - Scaling from drawing if printed incorrectly may lead to errors.
 - All information outside red line boundary shown for contextual purpose only.
 - All hatch patterns are indicative only unless stated otherwise.
 - This drawing is to be read in conjunction with the remaining re-form landscape architecture documentation AND all relevant documentation from the design team
 - Levels information on this drawing illustrates the design intent. The contractor is to check and verify all levels and dimensions against site survey information.
 - Any discrepancies in the design information are to be brought to the attention of re-form landscape architecture, in writing, prior to commencement of construction works.
 - All proprietary products shall be installed in strict accordance with manufacturers written instructions. Refer to other consultants' drawings and specifications for the following design information:
 - Foundation details
 - Base course and/or sub bases design & specification
 - Waterproofing of any element
 - Drainage design and infrastructure
 - Lighting and ducting
 - Existing & proposed utilities
 - Plant quantities are to suit site areas in accordance with scheduled plant densities.
 - Any proposed plant substitution shall be agreed with the landscape architect prior to ordering.

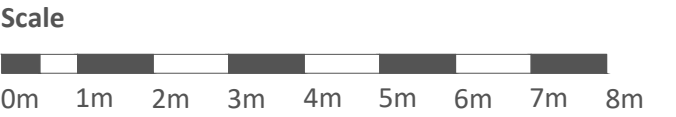

Planting Mix 2 - Thorburn Walk

Code	Name	Height (cm)	Min. container size (litre)	Density	Qty
AspS	Asplenium scolopendrium*	20-30	5L	7/m ²	47
BerP	Bergenia purpurascens	30-40	5L	7/m ²	45
CoE	Carex oshimensis 'Evergold'	20-30	5L	7/m ²	39
SedS	Sedum spectabile	10-20	5L	7/m ²	34
GerM	Geranium macrorrhizum	30-40	5L	5/m ²	37
HakM	Hakonechloa macra	30-40	5L	5/m ²	29
PolS	Polystichum setiferum*	40-50	5L	5/m ²	22
VibD	Viburnum davidii	30-40	5L	5/m ²	39
Feature Central Grass Drift Planting					
AhHJ	Anemone x hybrida 'Honorine Jobert	40-50	5L	5/m ²	33
CalKF	Calamagrostis Karl Foerster	80-90cm	5L	4/m ²	35
DesC	Deschampsia cespitosa	40-50	5L	4/m ²	41
LuzN	Luzula nivea*	30-40	5L	7/m ²	49
LuzSM	Luzula sylvatica Marginata*	30-40	5L	7/m ²	43
Bulb Planting (to be planted alongside the grass drift planting)					
	Hyacinthoides non-scripta*	bulb	6/8cm	3/m ²	57
	Galanthus nivalis*	bulb	4/5cm	3/m ²	57

19.06.25 Project code changed to UBS
Date Description of revision MSz Drawn MS Checked DL Approved P03 Revision by

re-form
landscape architecture

W: re-formlandscape.com
E: info@re-formlandscape.com
T: Edinburgh +44 (0)131 354 1876
Leeds +44 (0)113 245 4695
Manchester +44 (0)161 397 4953

Project
UPPER BROOK STREET, MANCHESTER
RF22-968

Client
KADANS

Document title
DETAILED PLANTING PLAN
SHEET 02 OF 03

Paper size
A1

Status
FOR STAGE APPROVAL

Drawing number
UBS-RFM-XX-00-DR-L-0108

© re-form landscape architecture

Scale
1:100

S4

Revision
P03