


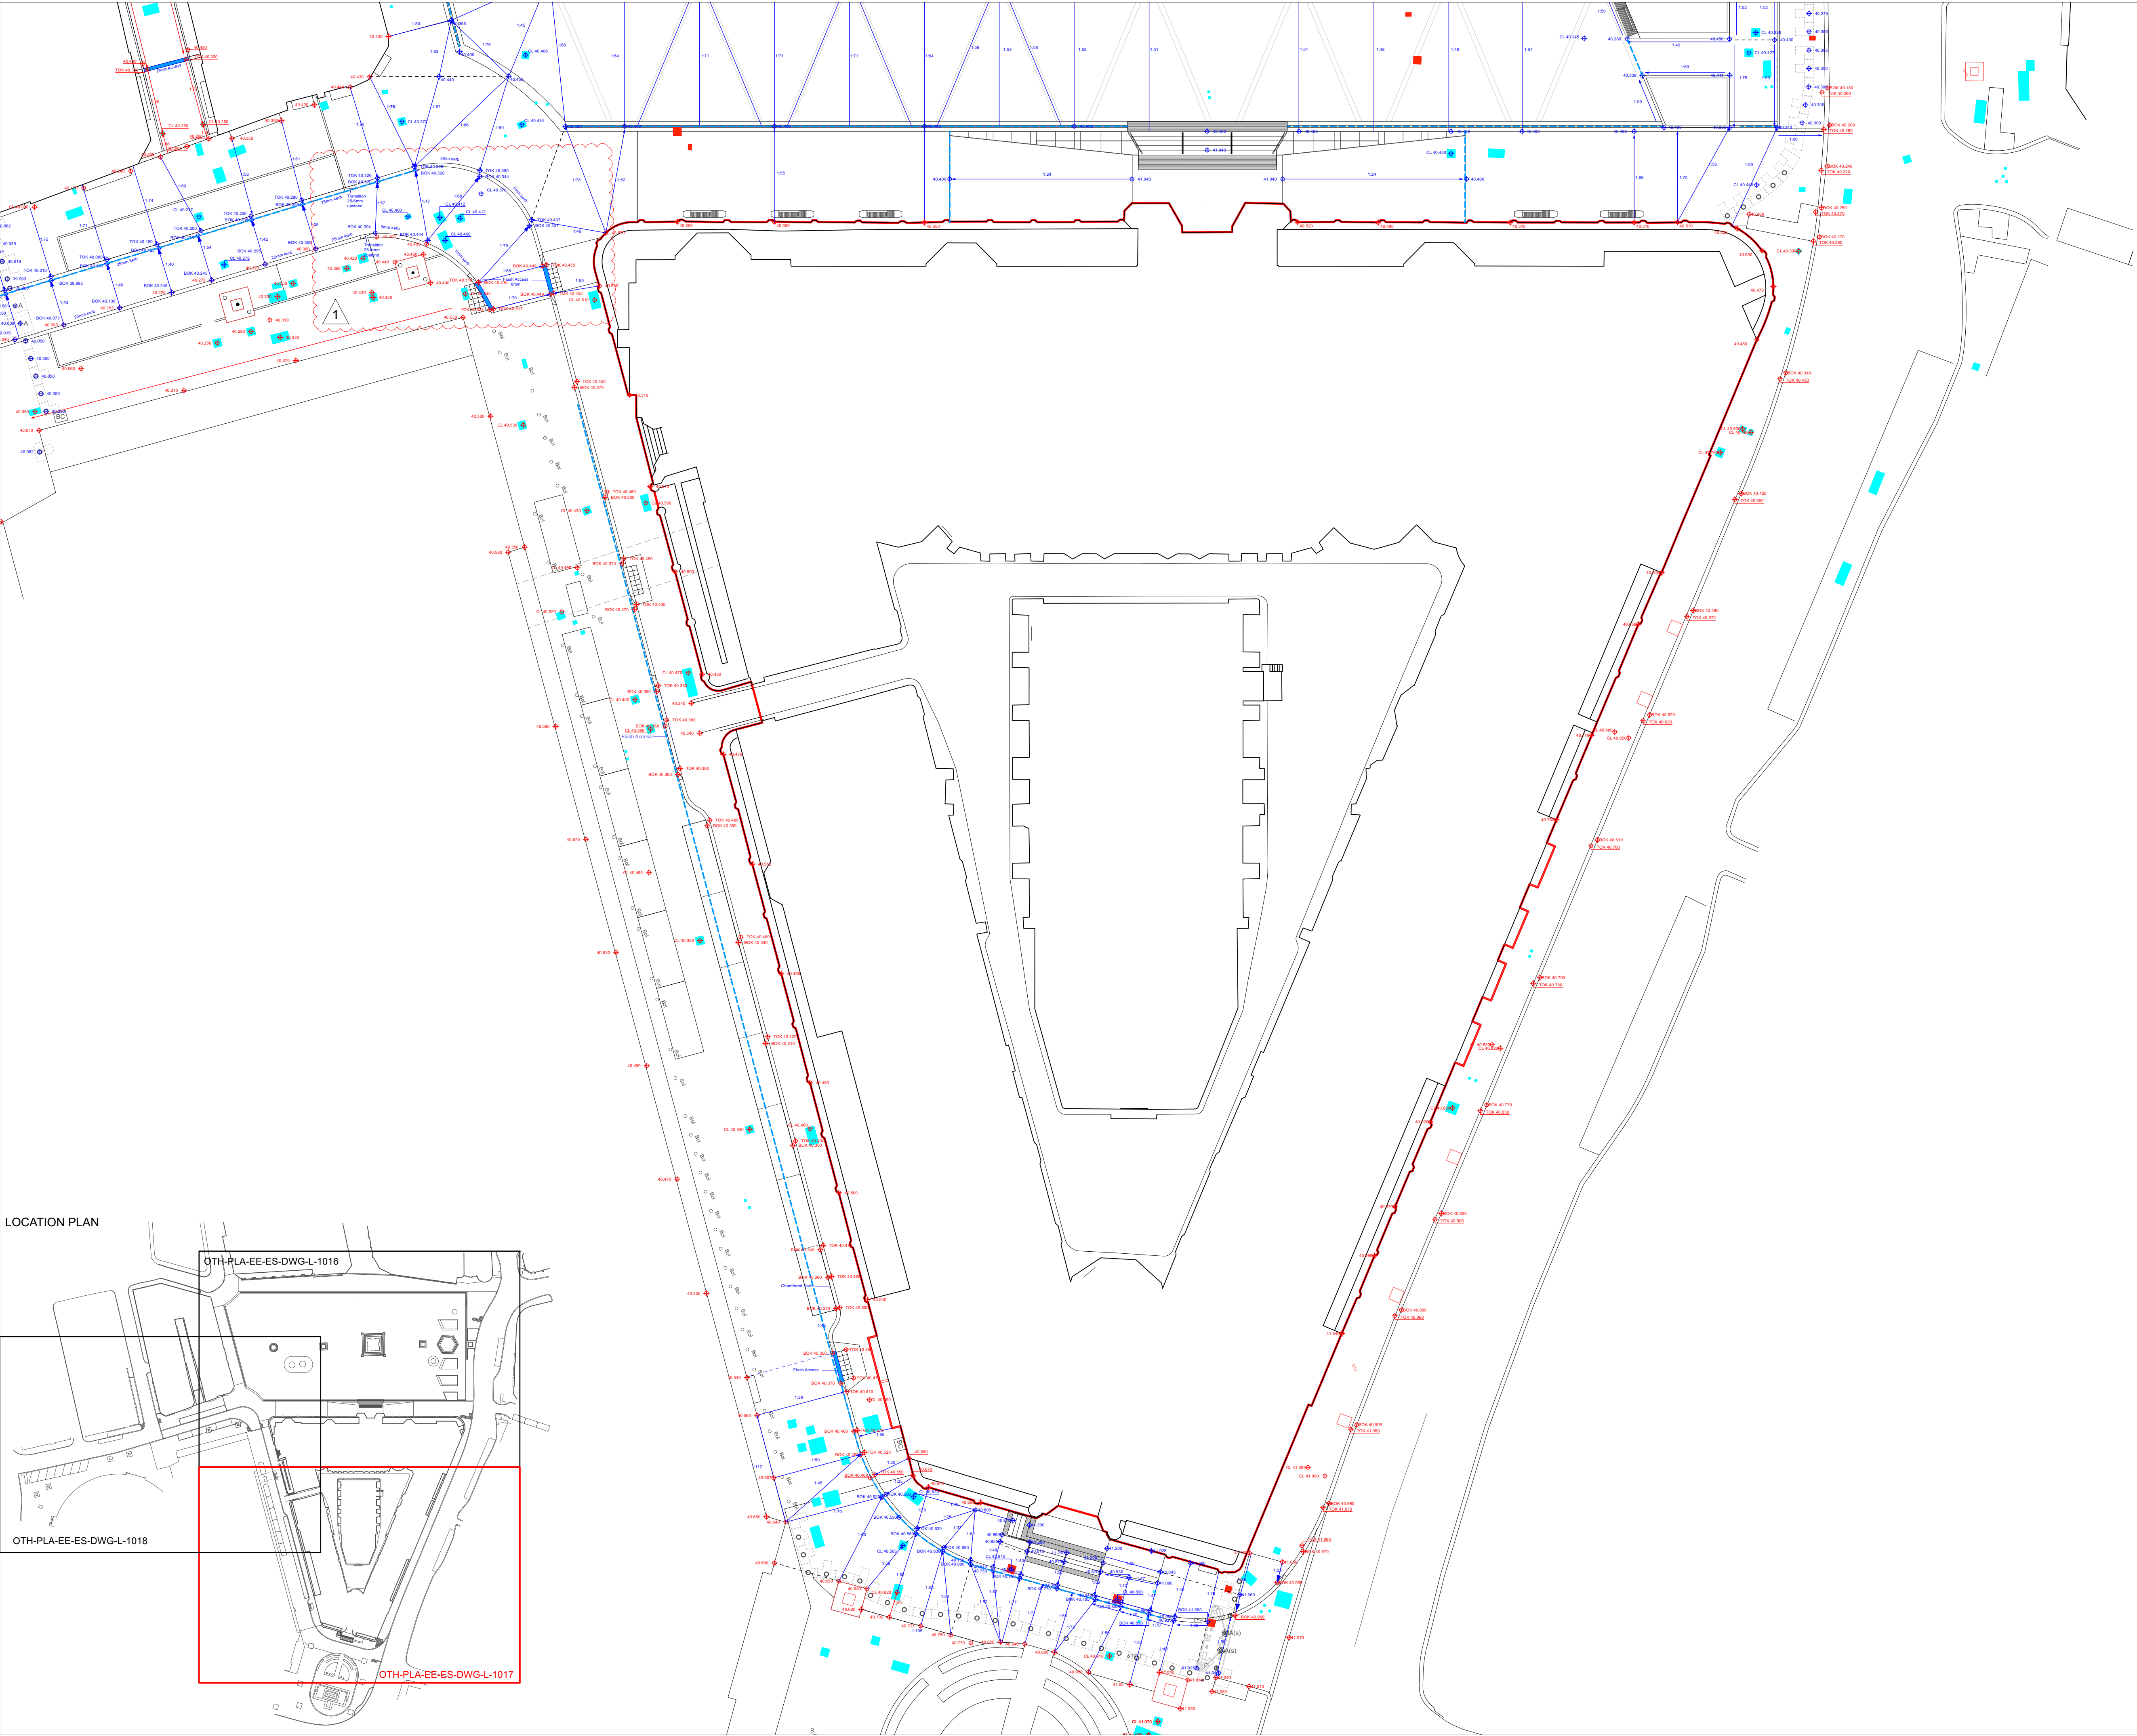

THIS DRAWING IS COPYRIGHT PROTECTED AND MAY NOT BE REPRODUCED IN WHOLE OR PART WITHOUT WRITTEN PERMISSION FROM THE CLIENT.

© Plantit I.E. Limited

NOTES

1. This drawing is for the proposed works.
2. All dimensions are in millimeters unless otherwise stated.
3. All dimensions are to the centerline of the proposed works.
4. The dimensions of all works shall be checked on site before being fixed.
5. The dimensions of all works shall be checked on site before being fixed.
6. The dimensions of all works shall be checked on site before being fixed.
7. The dimensions of all works shall be checked on site before being fixed.

KEY

BOUNDARIES

- Red Line Boundary
- Section 27B Works

LEVELS & DRAINAGE

- Proposed surface gradient
- Proposed spot level
- Existing spot level
- High point in surface
- Proposed drainage channel / slot drain
- Refer to Ramboll drawing for full details of proposed drainage: OTH-PLA-EE-ES-DWG-C-1100 - 1102
- Existing manholes & utility covers to be retained
- Existing manholes & utility covers to be removed
- Existing manholes & utility covers to be confirmed
- Existing cover level
- Proposed cover level

Refer to drawing OTH-PLA-EE-ES-DWG-L-1012 for detailed levels to the courtyard

Revision Notes:

1. Levels updated to show 6mm upstand to Mount St radius section as agreed with project access group.

Revision	Date	Description	Drawn	Appr.
C03	07/11/23	Refer to Revision Notes	SY	MS
C02	17/11/21	Draft Construction Issue	SR	MS/KR
C01	01/04/21	Construction Issue	SR	MS/KR
06	26/02/21	Stage 4 Issue (Re-Coordination)	SR	MS/KR
05	14/11/19	Refer to revision notes	SR	MS/KR
04	11/10/19	Stage 4 Issue - revisions as described	SR	MS/KR
03	06/09/19	Planning Issue	SR	MS/KR
02	26/07/19	Stage 4	SR	MS/KR
01	21/06/19	For information	SR	MS/KR

Client Manchester City Council

Project Our Town Hall

Drg Title Proposed Levels Detail Area 2 of 3
Lloyd Street & Princess Street

Created on 19.06.19
Created by SR
Approved by MS/KR

Scale 1:250
Size A1
Workstage Stage 5

Drg No. OTH-PLA-EE-ES-DWG-L-1017
Suitability S4
Revision C03

Plantit I.E. Limited

E: info@plantit-ie.com W: plantit-ie.com

MANCHESTER
2 Back Grafton St., Altrincham, WA14 1DY
T: 0161 928 9281

LONDON
Unit 6 Waterside, 44-48 Wharf Road, London, N1 7UX
T: 0207 253 5678

LIVERPOOL
No. 8 Princes Parade, Princes Dock, Liverpool, L3 1DL
T: 0151 705 6746