
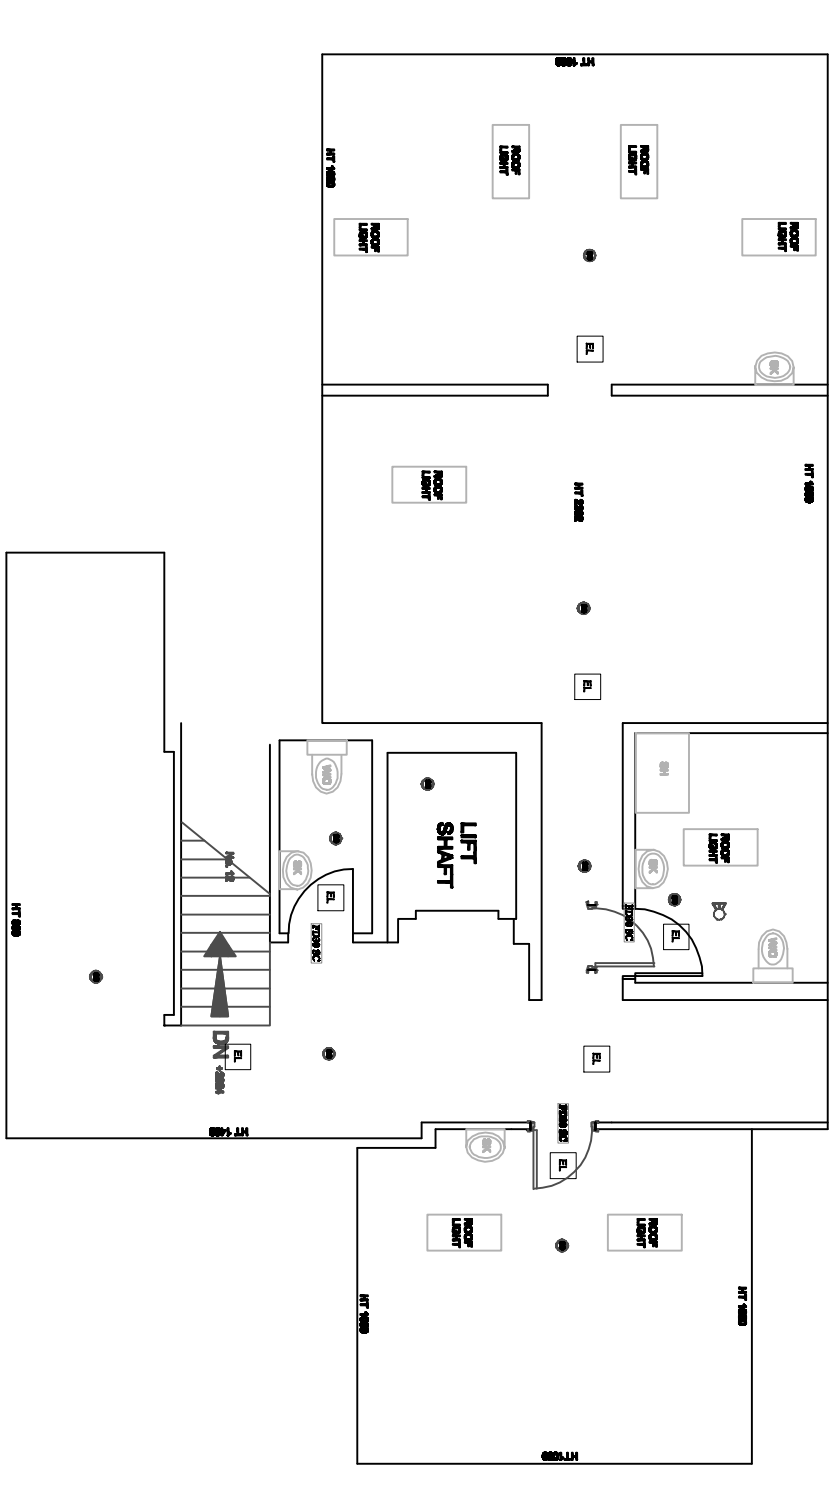
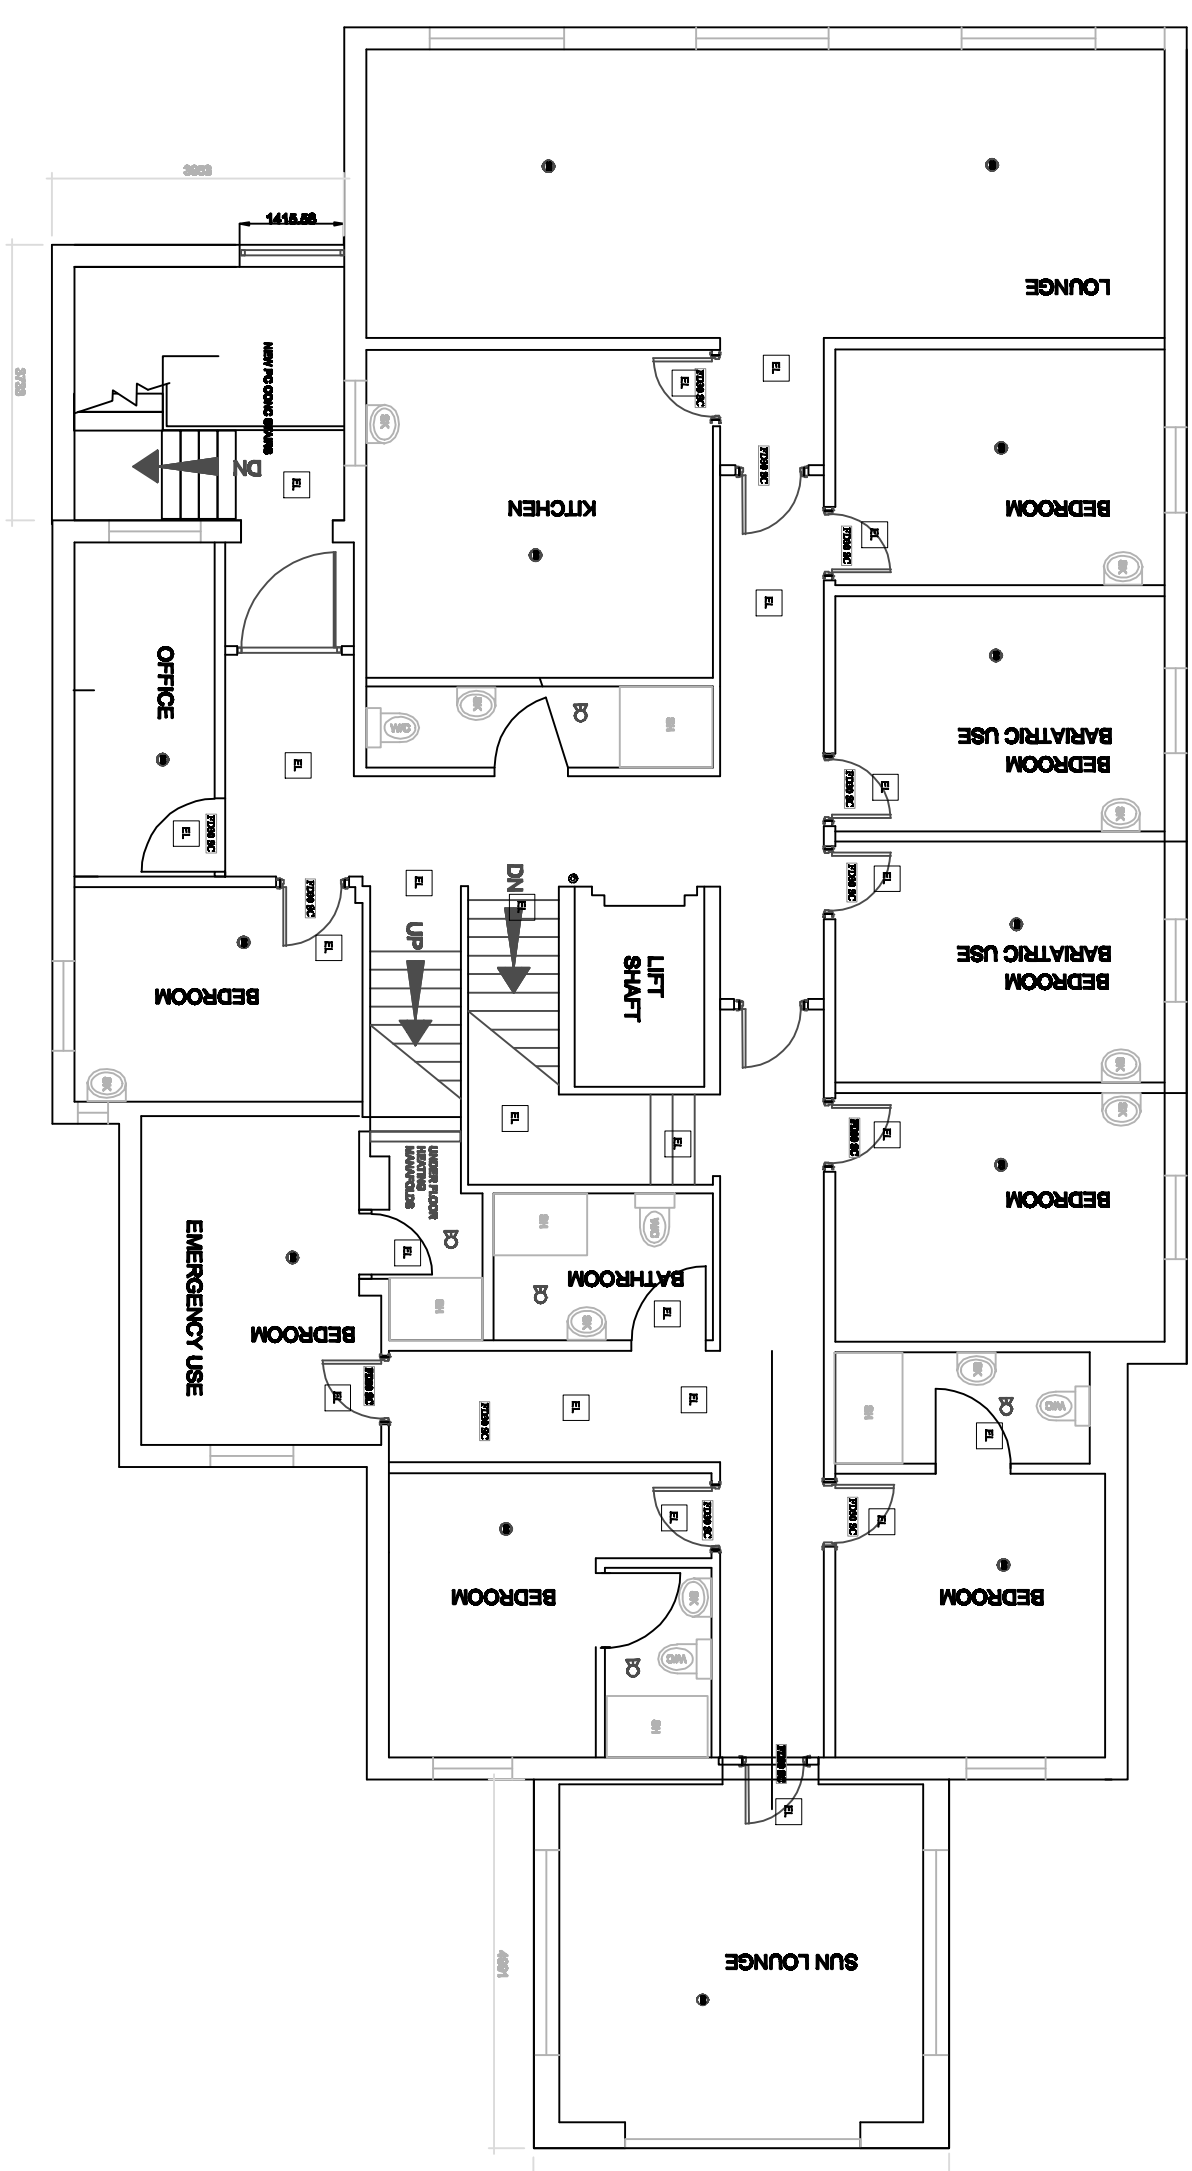


AMENDEDMENTS TO 60 VICTORIA AVE EAST
FLOOR PLANS 1/100

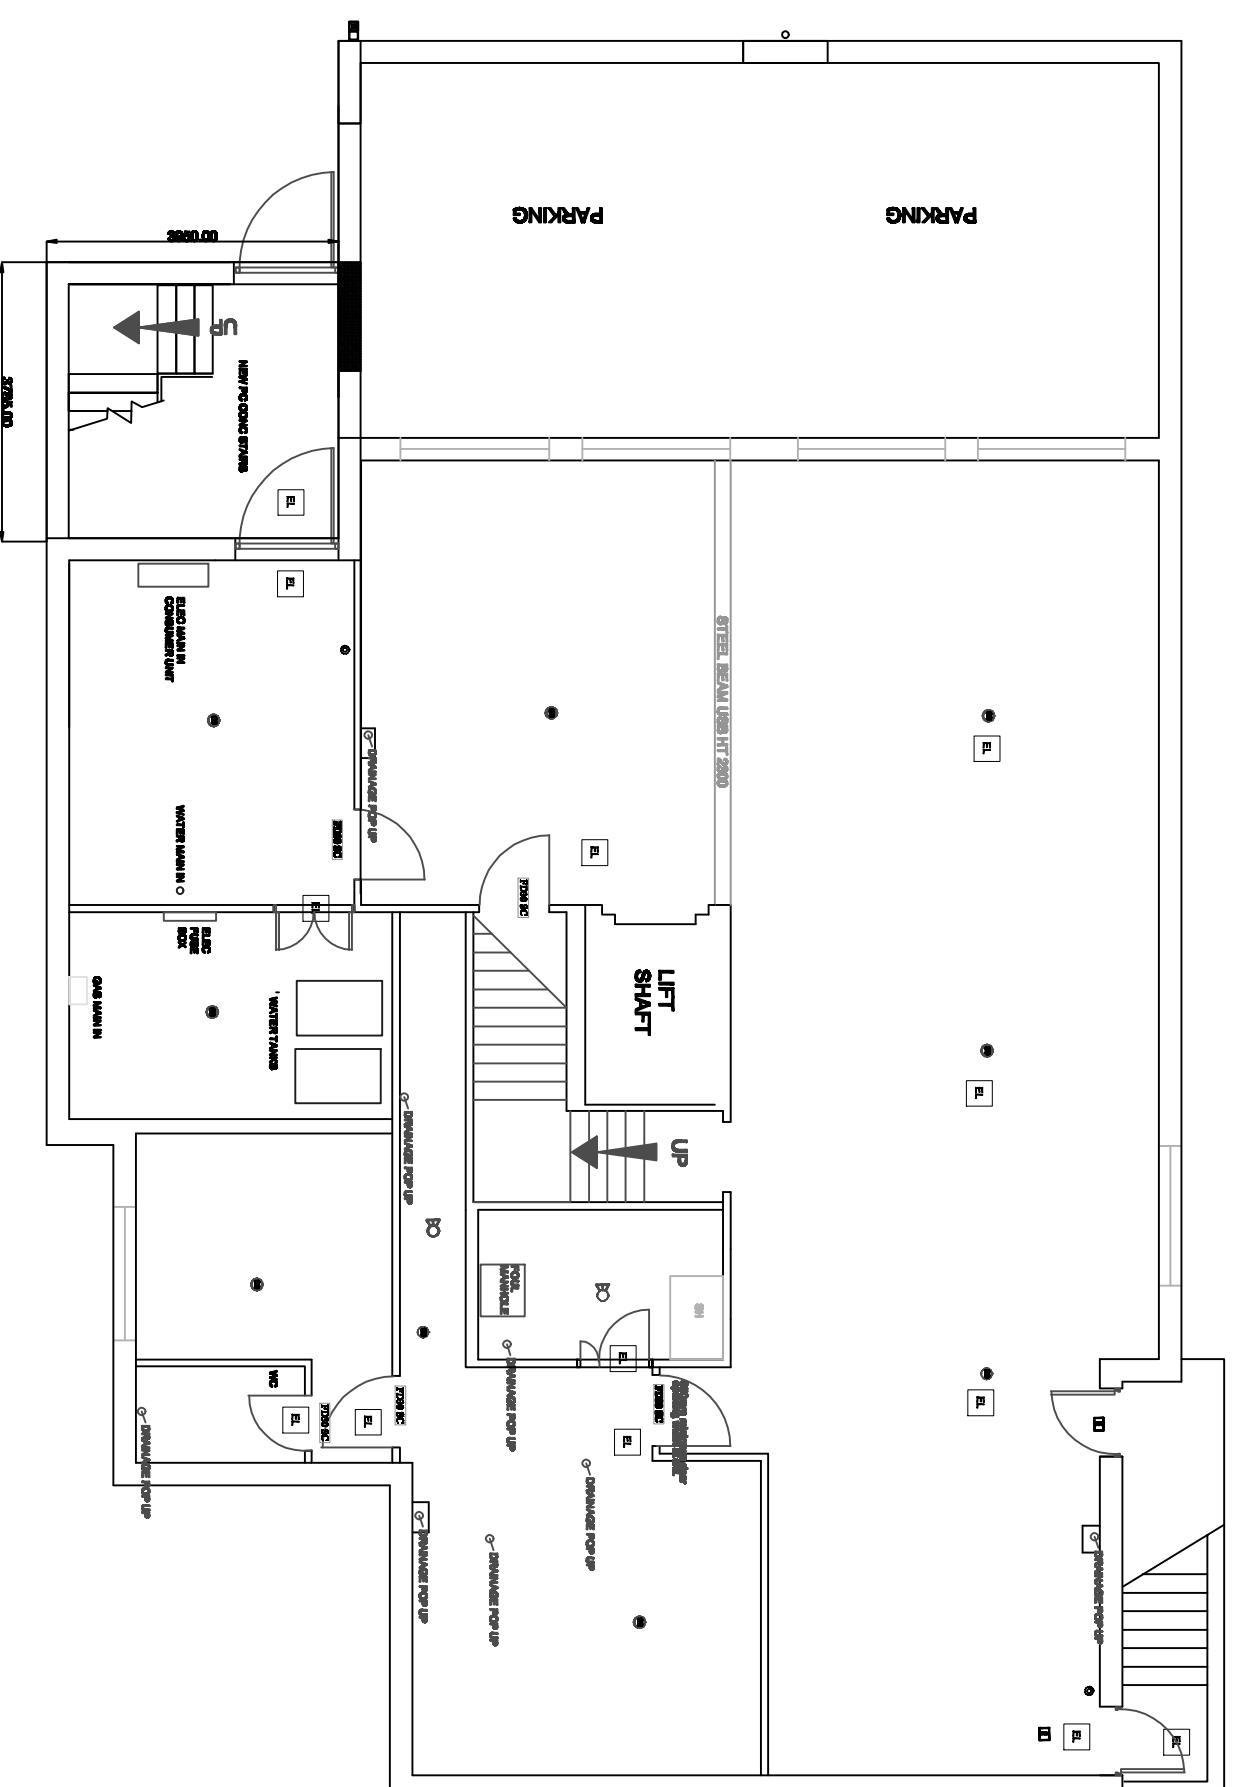



SECOND FLOOR

AMENDED SUNLOUNGER

GROUND FLOOR

FIRST FLOOR PLAN

ELEVATIONS 1/100

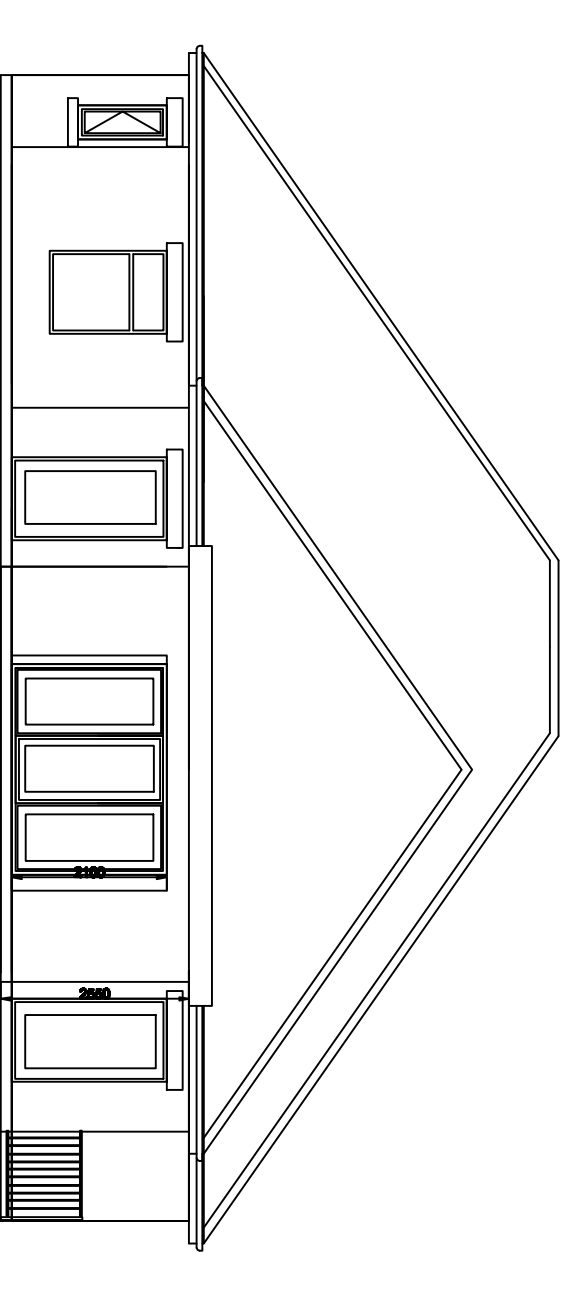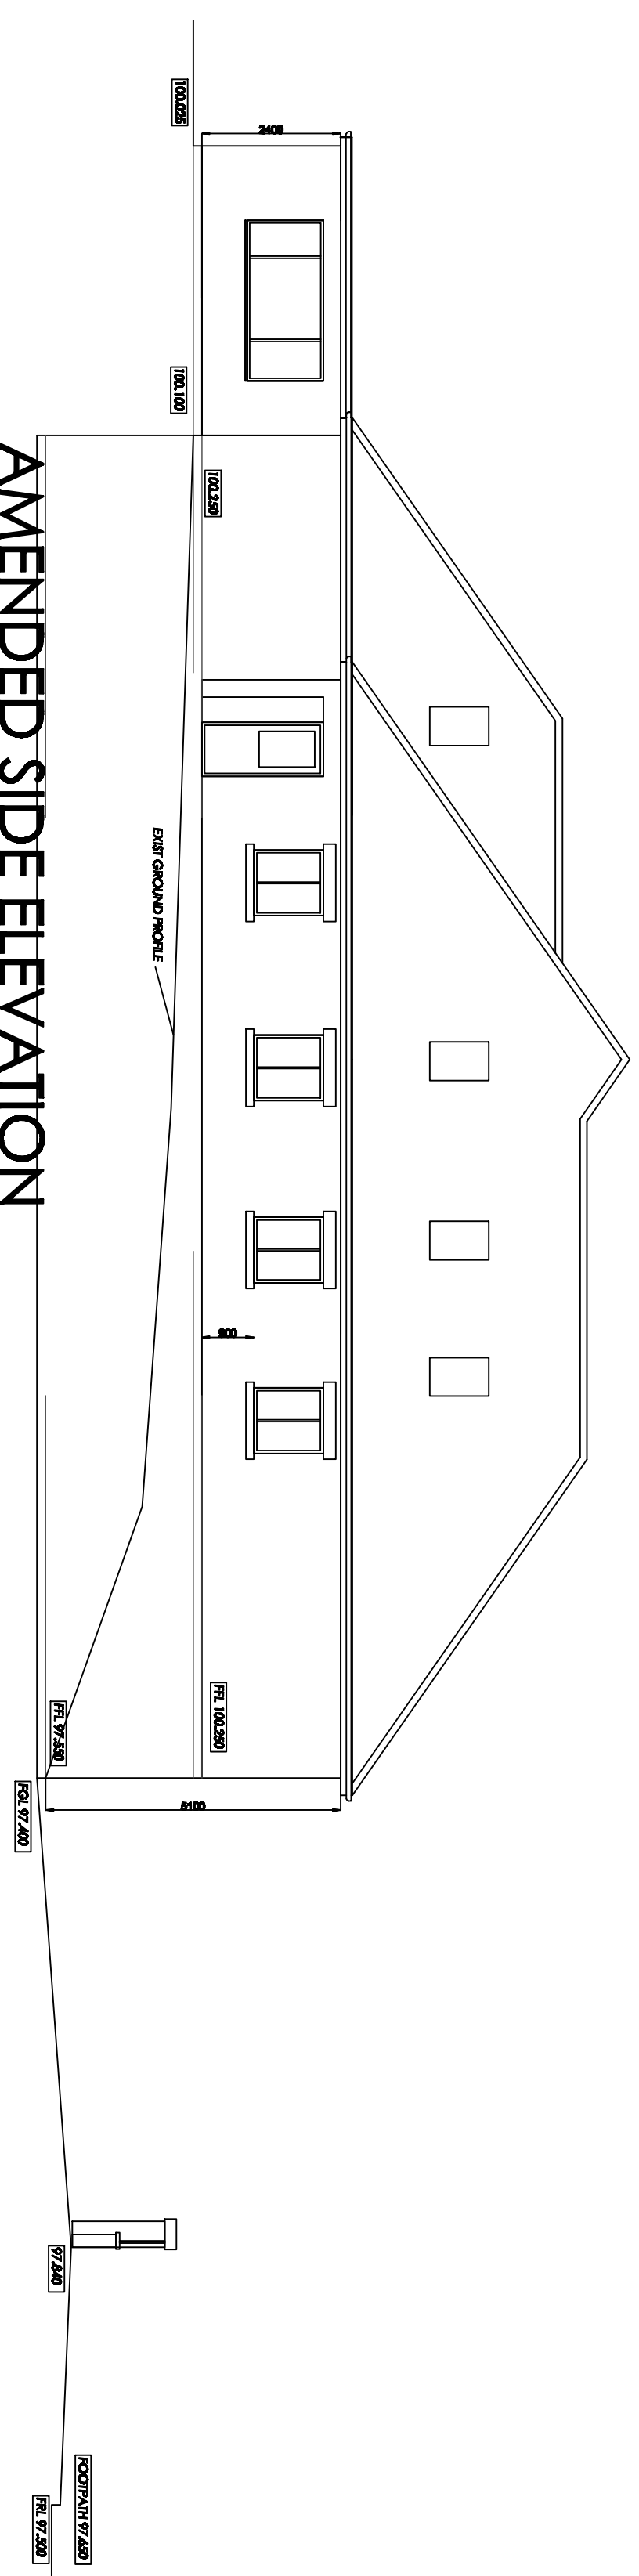



AMENDED REAR ELEVATION

REVISIONS			
SCALE	DATE	DRAWN	CHECKED
1/100	April 2025		
1/200			

CUSTOMER	PROJECT	DATE
CLIENT		

TITLE
PROPOSED RESTBITE / DAYCARE FACILITY
AS BUILT FLOORPLAN SURVEY
60 VICTORIA AVENUE EAST
BLACKLEY, MANCHESTER M9 6HB

Amended entrance stairs, amended rear sun lounge
to approval ref 094690/FO/2010/N1

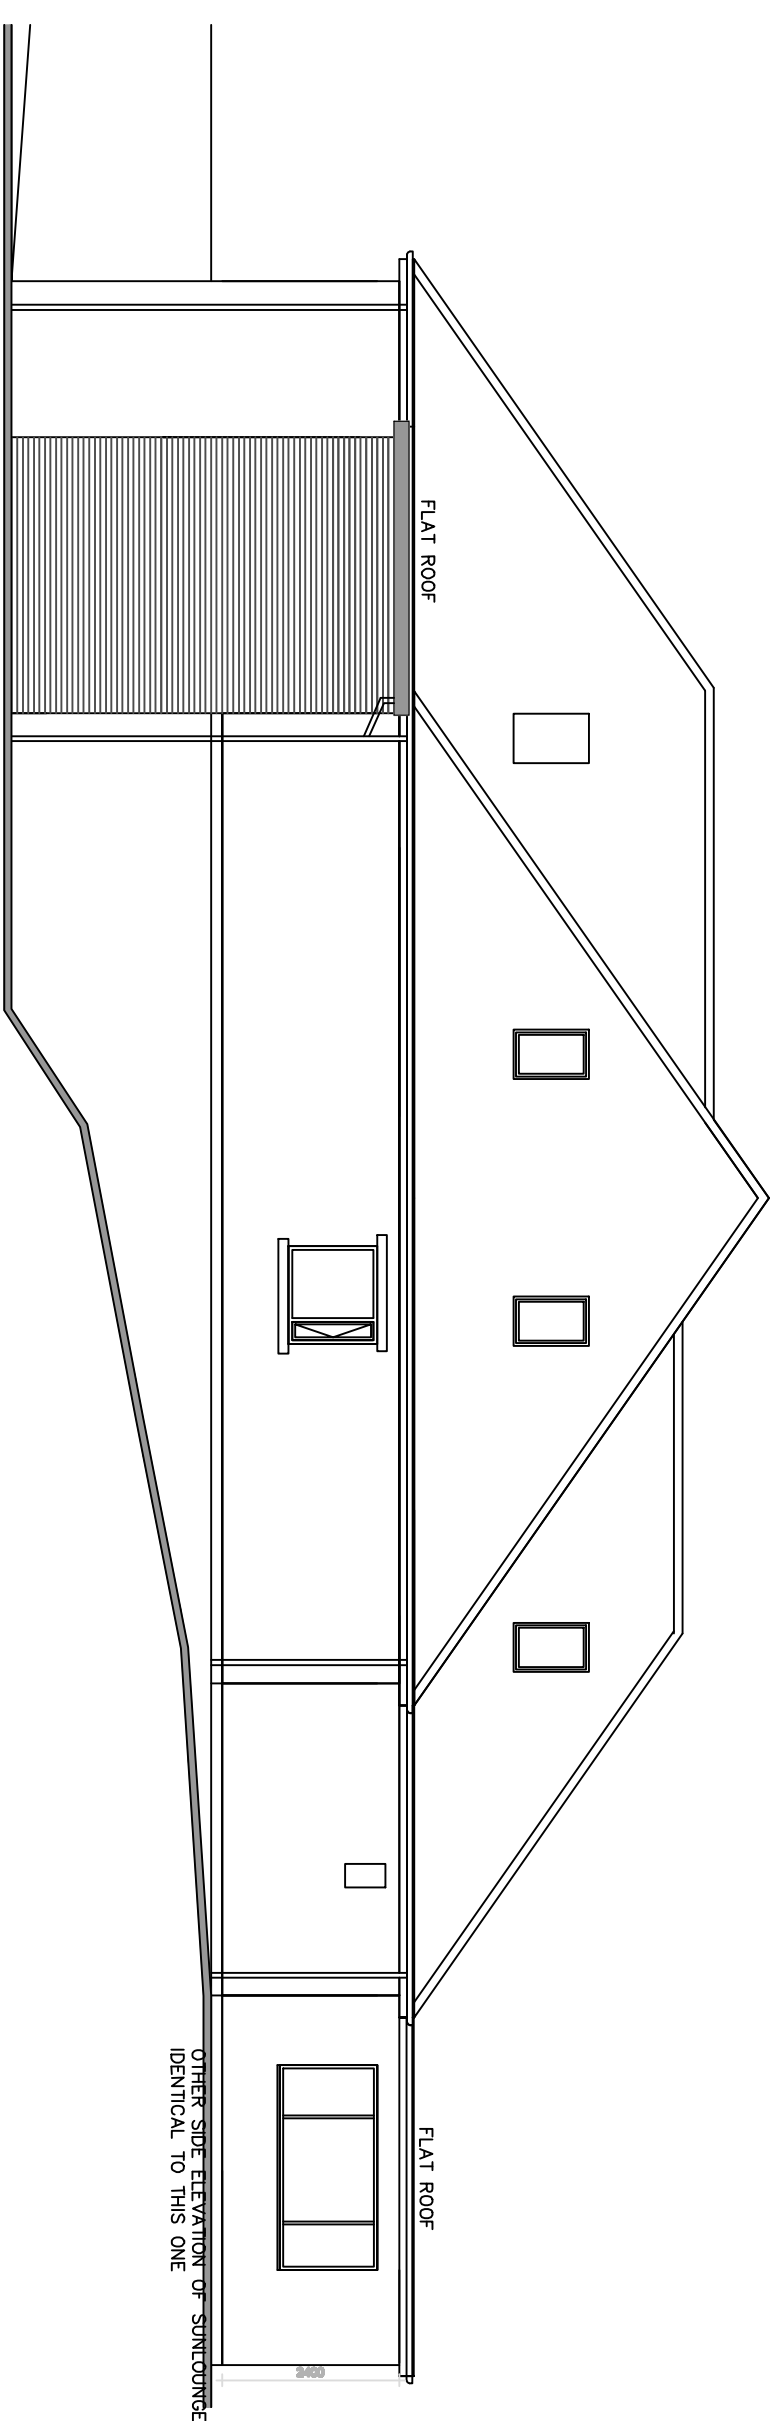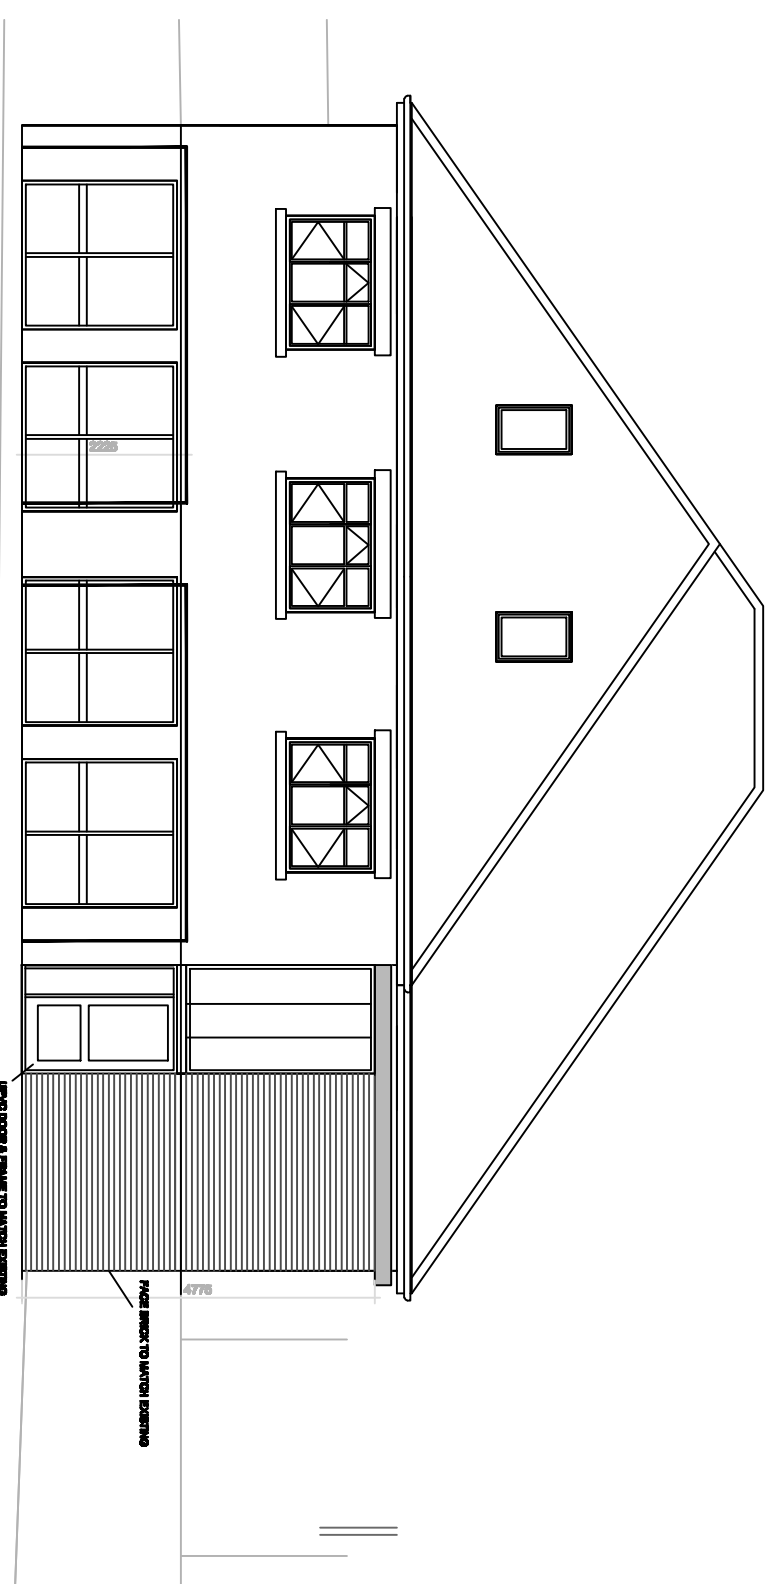

AMENDED ELEVATION
ELEVATION TO VICTORIA AVENUE EAST

AMENDED SIDE ELEVATION

