


This drawing is the copyright of LDM Design.
All dimensions to be checked on site.
All levels to be checked on site and refer to Ordnance Survey Datum Newlyn unless alternative datum given.
All errors and omissions to be reported to the Architect prior to commencement.
This drawing must be read in conjunction with the relevant specification clauses.
This drawing must not be used on site unless issued for construction.



Scale 1:1250
0 10 20 30 40 50 60 70 80 90 100

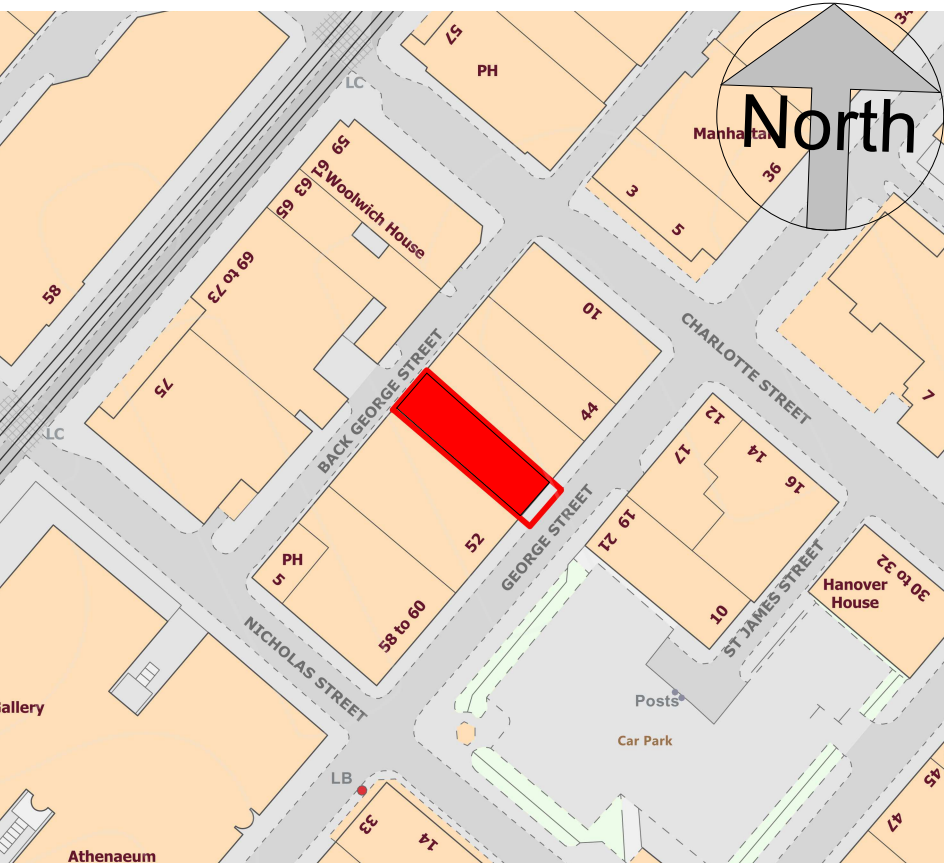

Location Plan
1:1250

IMPORTANT NOTICE:


THE BOUNDARY LINES DEPICTED IN OUR DRAWINGS ARE BASED ON THE ORDNANCE MAP AND ARE INTENDED FOR INDICATIVE PURPOSES ONLY. THESE LINES SHOULD NOT BE RELIED UPON FOR BOUNDARY DETERMINATION. THE ACTUAL BOUNDARY OF A PROPERTY MAY VARY, APPEARING EITHER CLEAR OR AMBIGUOUS, AND IT IS TYPICALLY ESTABLISHED THROUGH AGREEMENT WITH THE ADJOINING NEIGHBOUR.

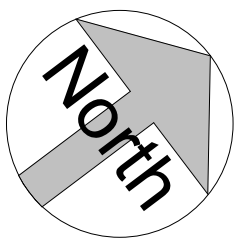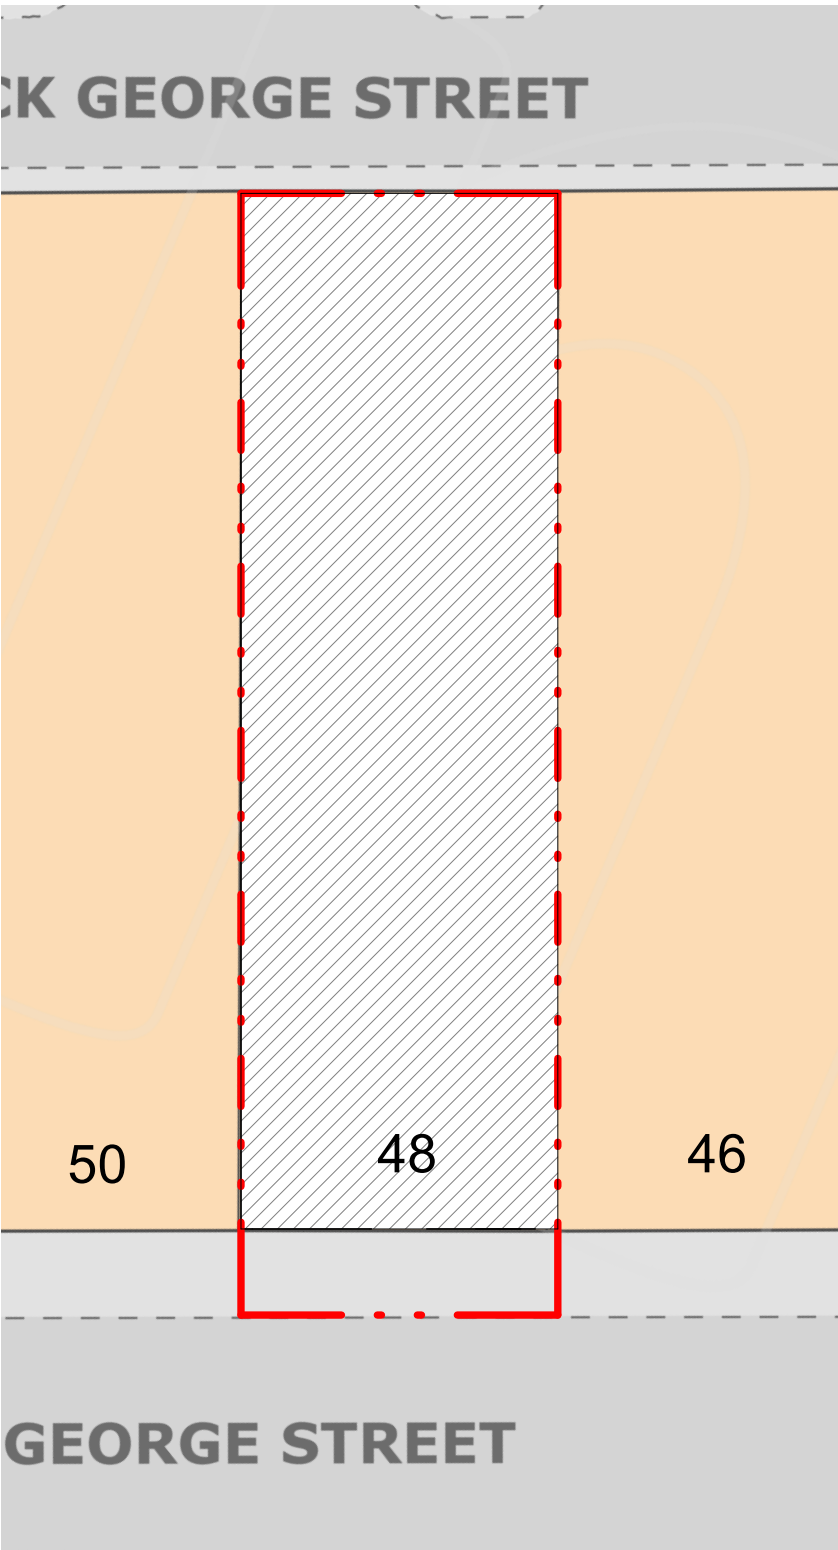

As-Built Site Plan
1:200

0 4 8 12 16 20
GRAPHIC SCALE: 1:200

Advertisement Consent

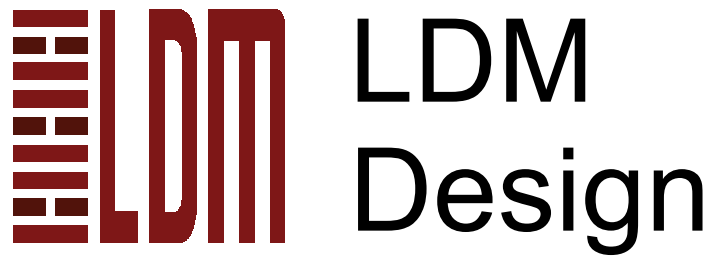

PROJECT: Basement 48 George St, Manchester M1 4HE

SHEET: Planning Drawings (As-Built)

CLIENT: Kung Fu Noodle MCR LTD

Scale (@ A1): As indicated

Drawn by:	BA	DRAWING NUMBER:	REV:
Checked by:	KK	A1-201a	D



As-Built Front Elevation
1:50



0 1 2 3 4 5
GRAPHIC SCALE: 1:50

GLASS LETTER WITH BLACK COLOUR ALUMINIUM FRAME (17MM THICK)
CHINESE BUSINESS NAME
(SURFACE FIXED WITH CONCEALED MOUNTING SYSTEMS.)

GLASS LETTER WITH BLACK COLOUR ALUMINIUM FRAME (17MM THICK)
ENGLISH BUSINESS NAME
(SURFACE FIXED WITH CONCEALED MOUNTING SYSTEMS.)

LUMINOUS LOGOS
70MM THICK METAL FRAME WITH FABRIC FRONT SIGNAGE
(SURFACE FIXED WITH CONCEALED MOUNTING SYSTEMS.)

WOODEN MENUE BOARD (30MM THICK)
(SURFACE FIXED WITH CONCEALED MOUNTING SYSTEMS.)

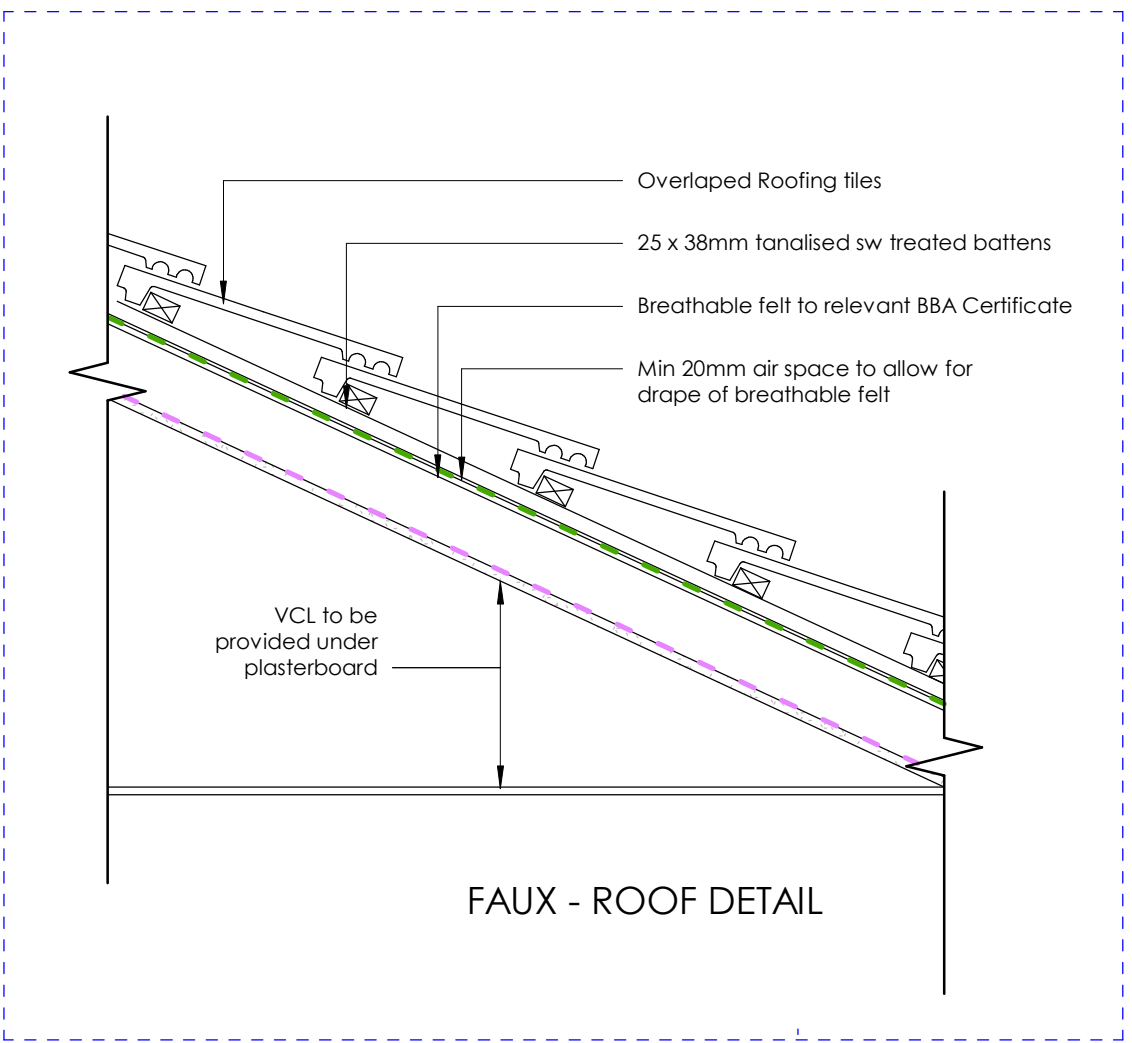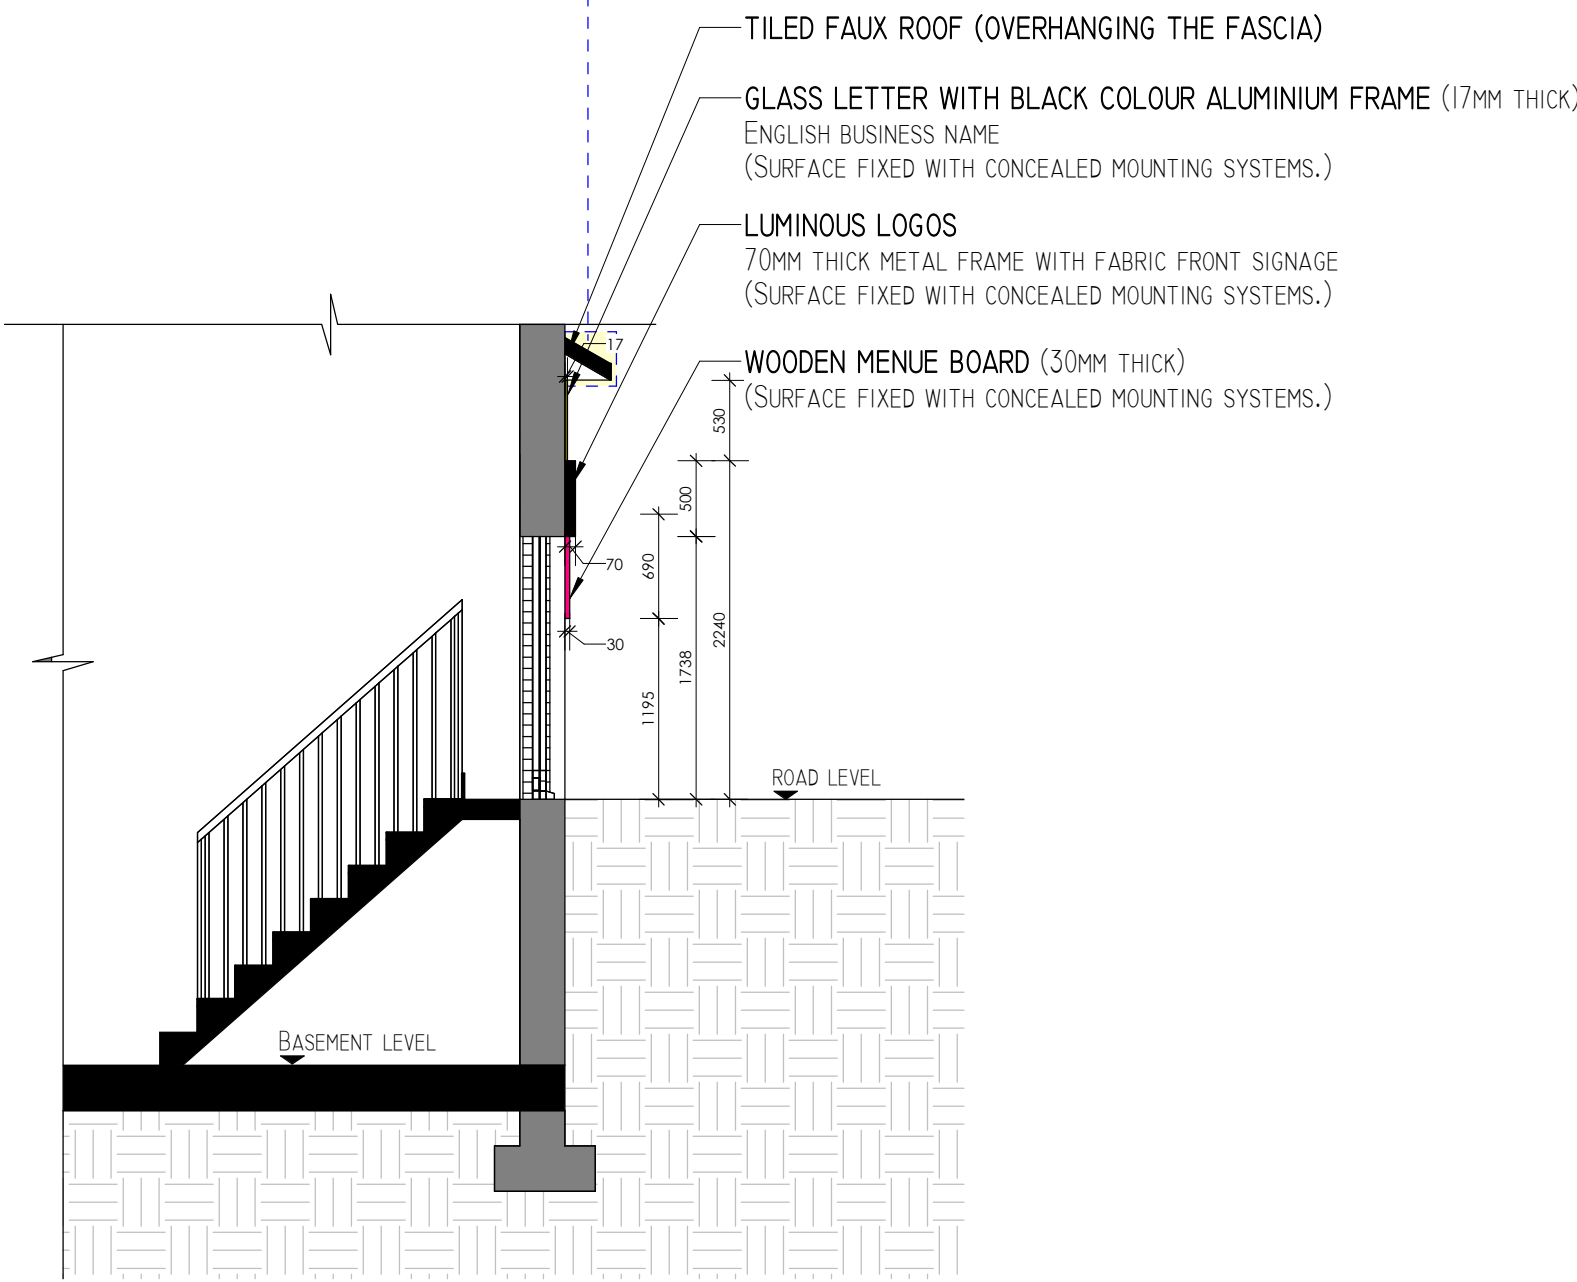

As-Built Section - 1
1:50

0 1 2 3 4 5
GRAPHIC SCALE: 1:50