
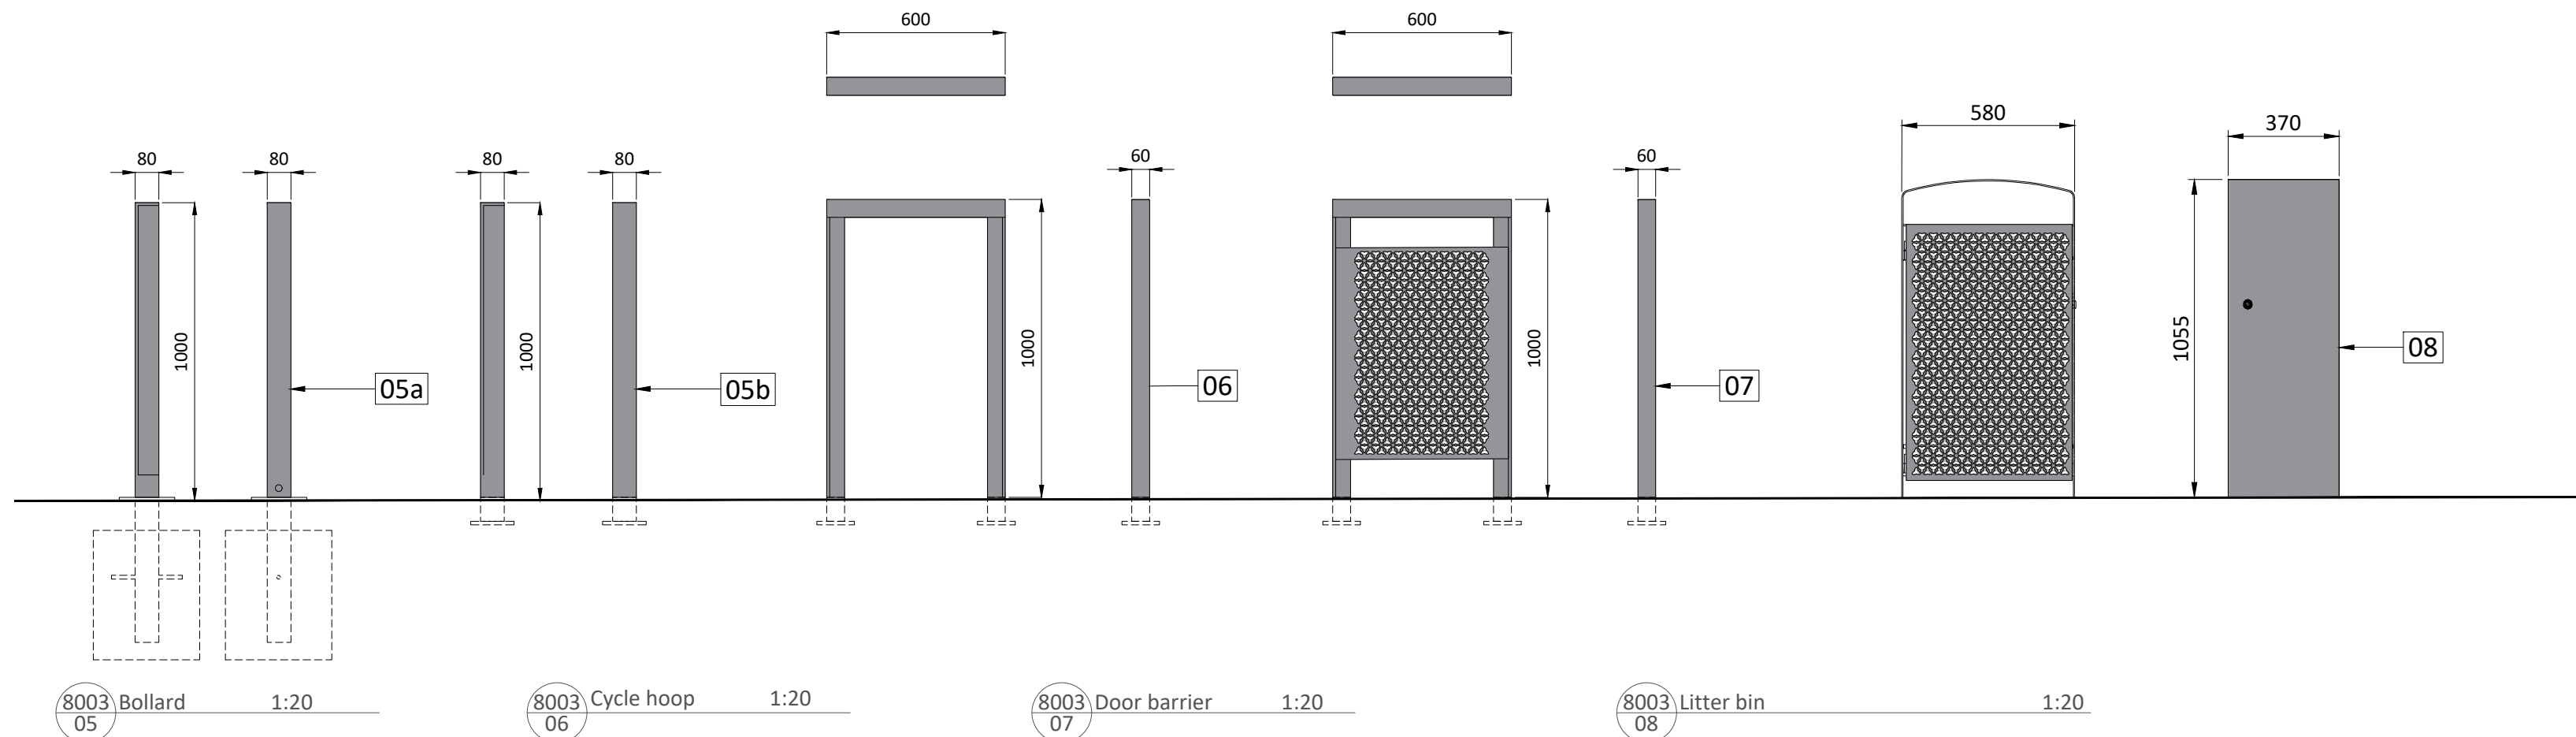
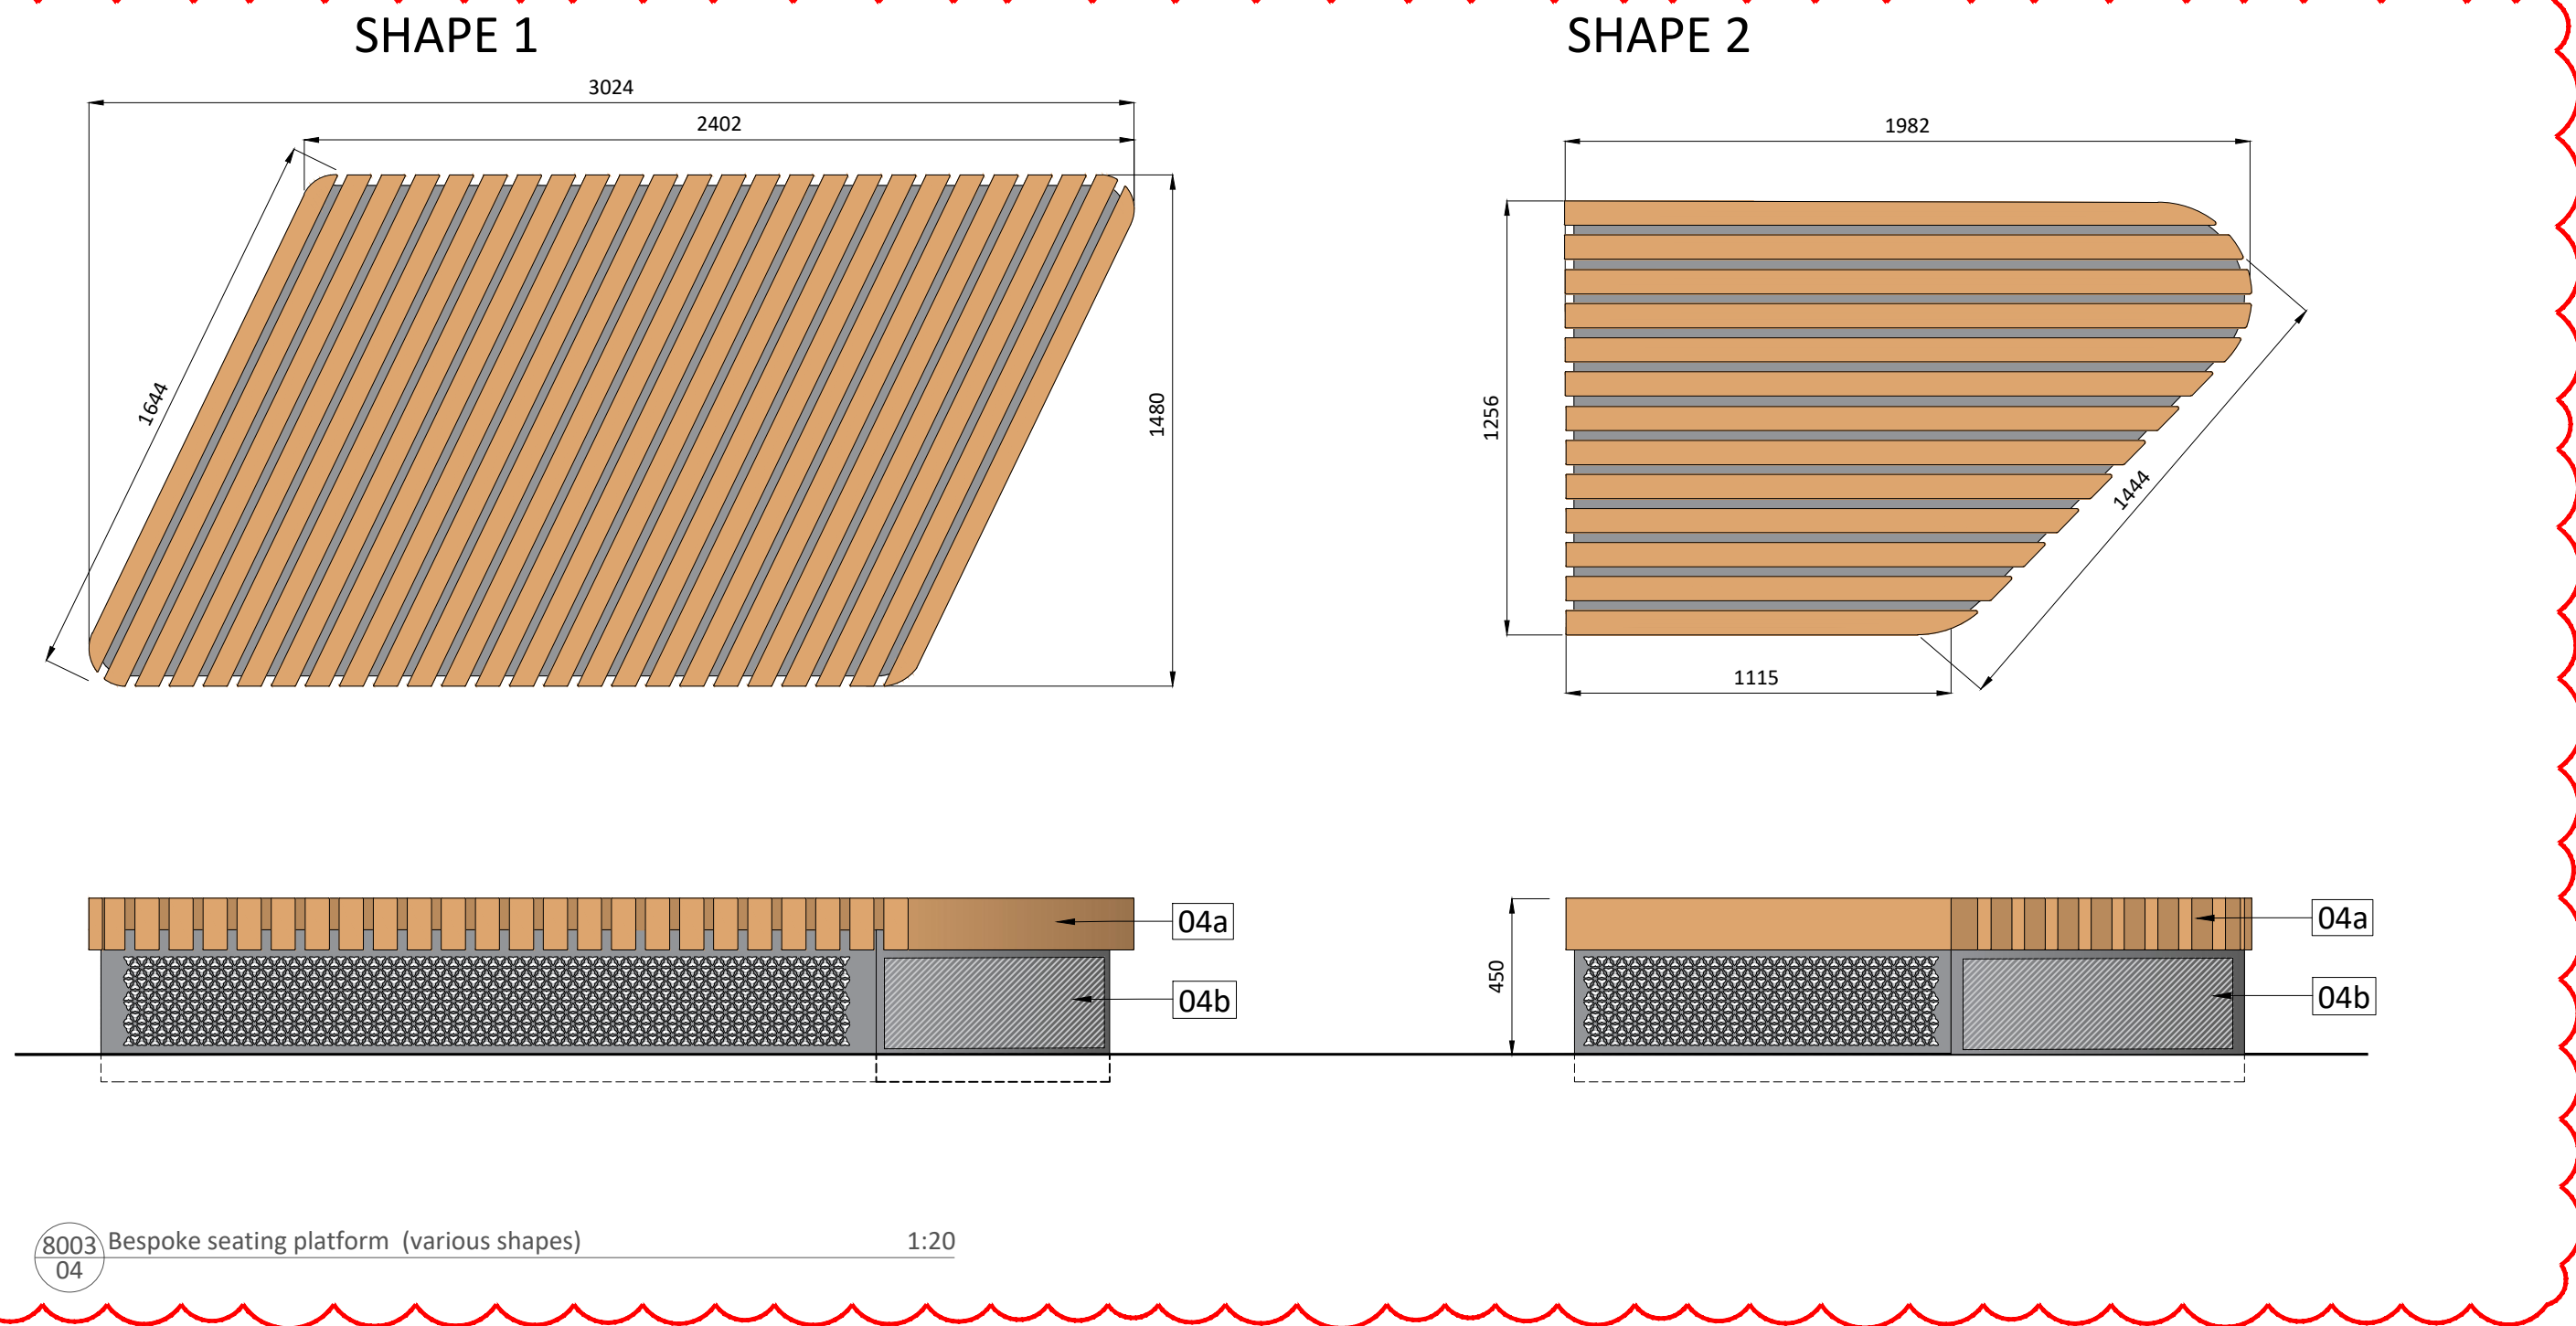
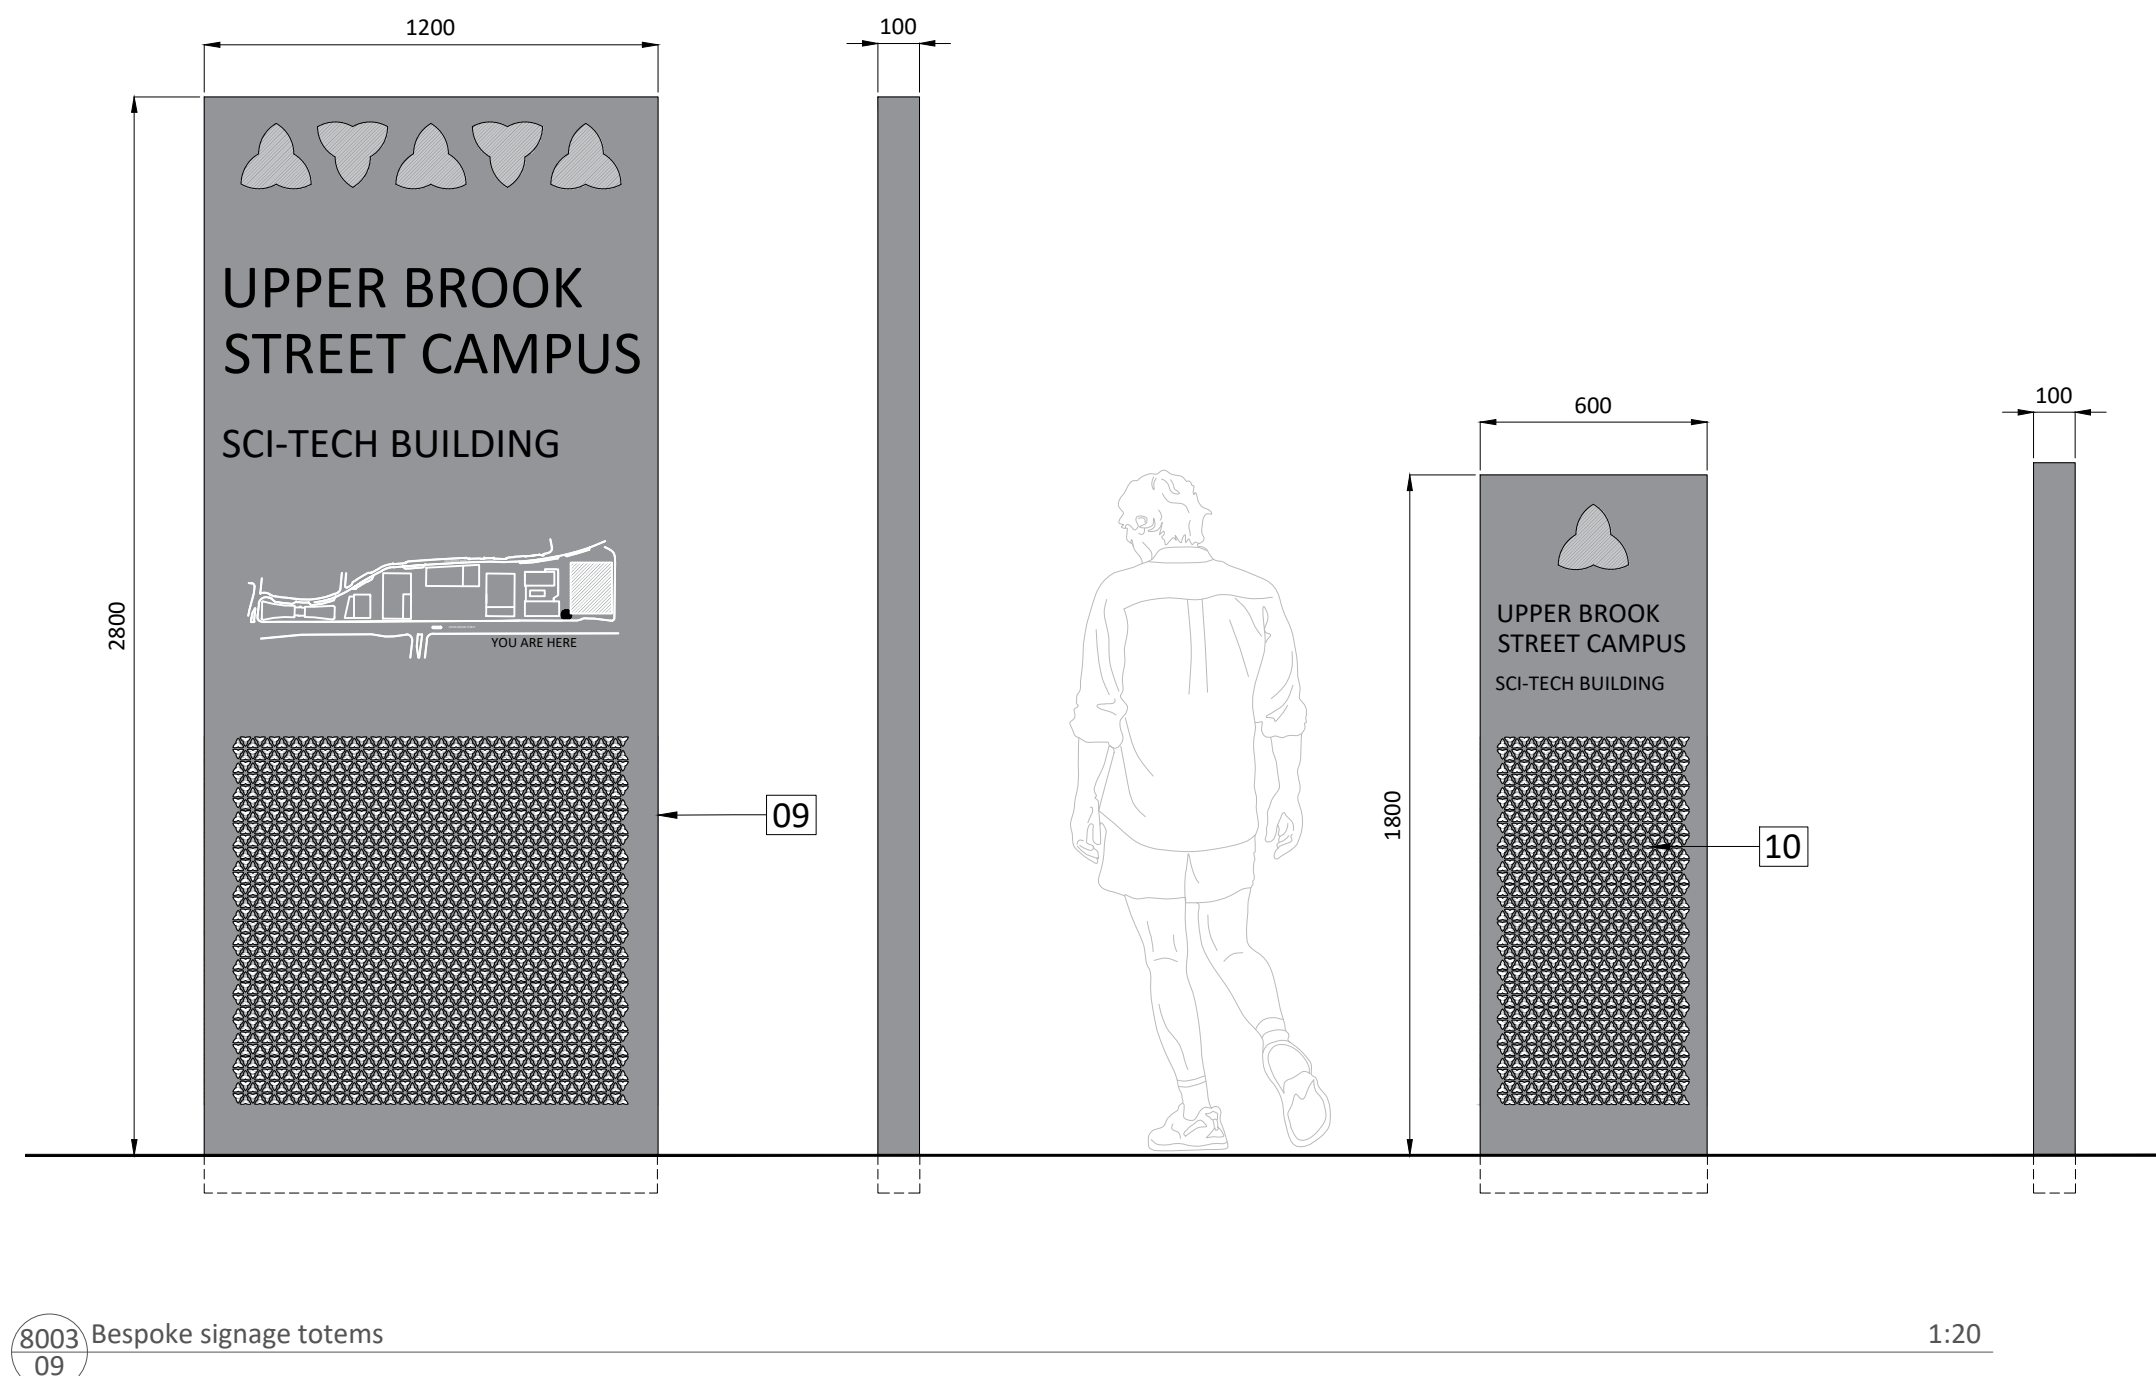
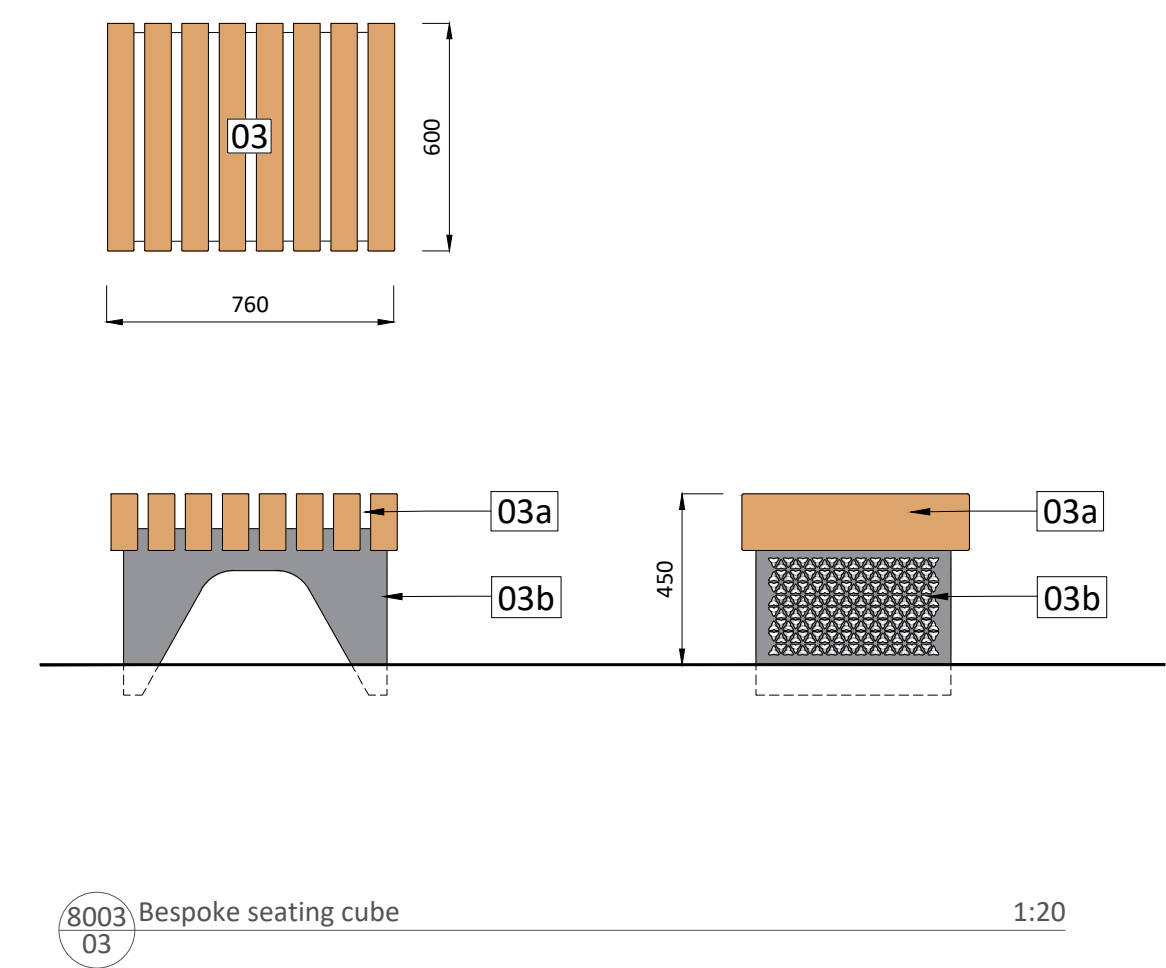
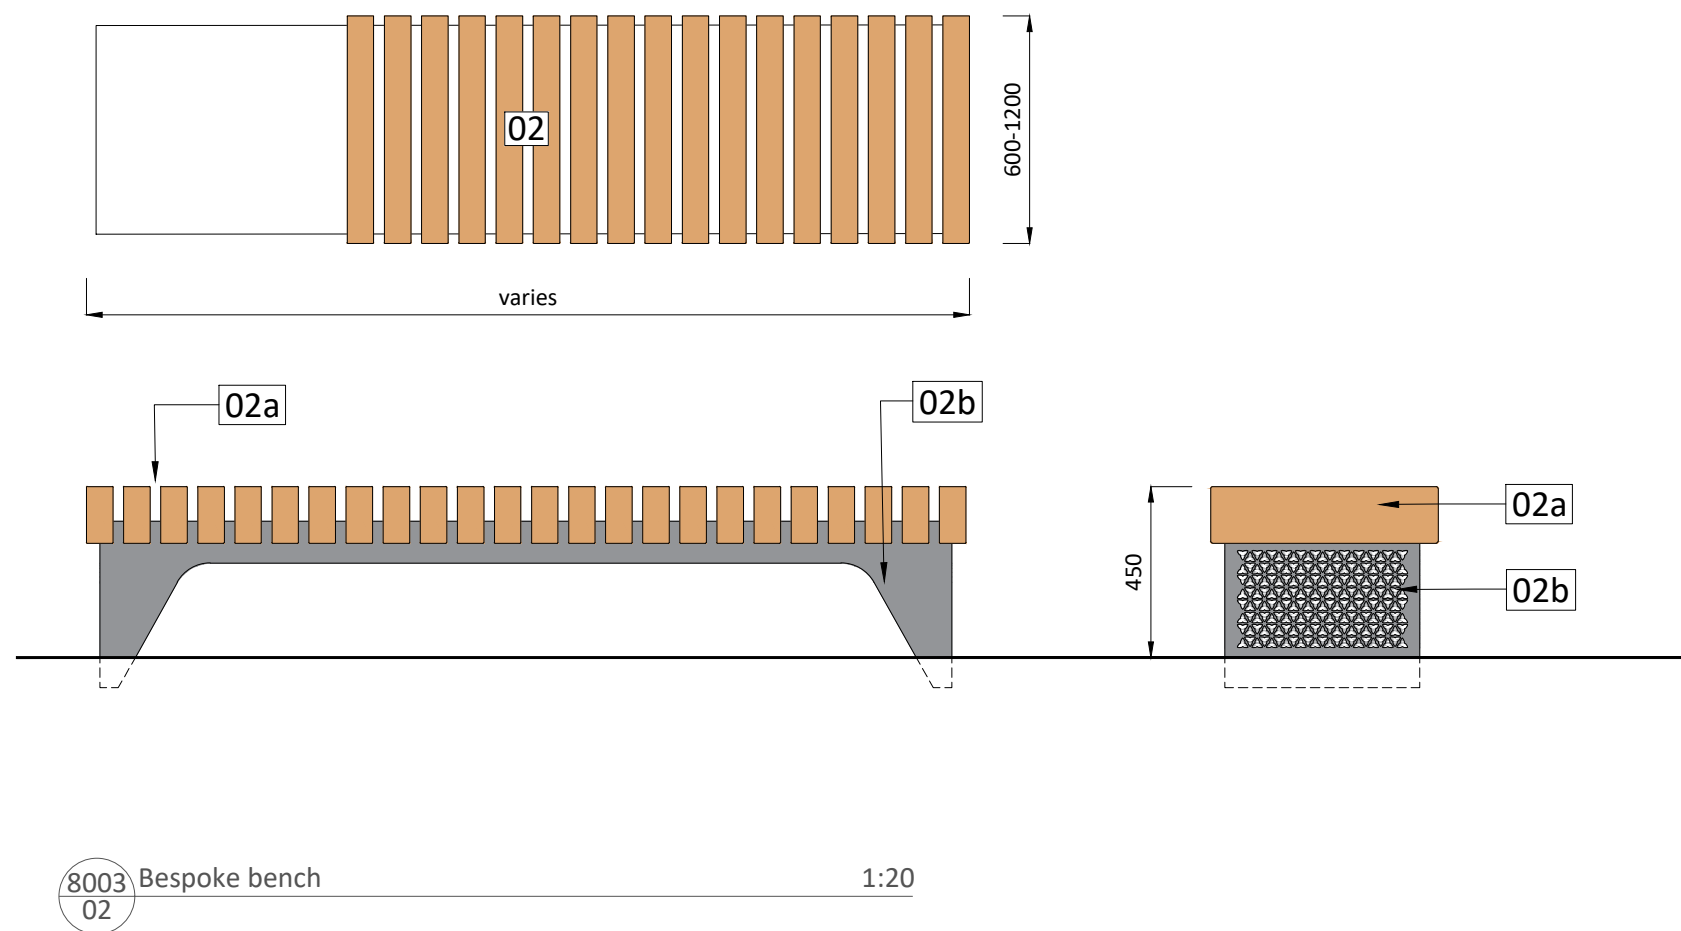


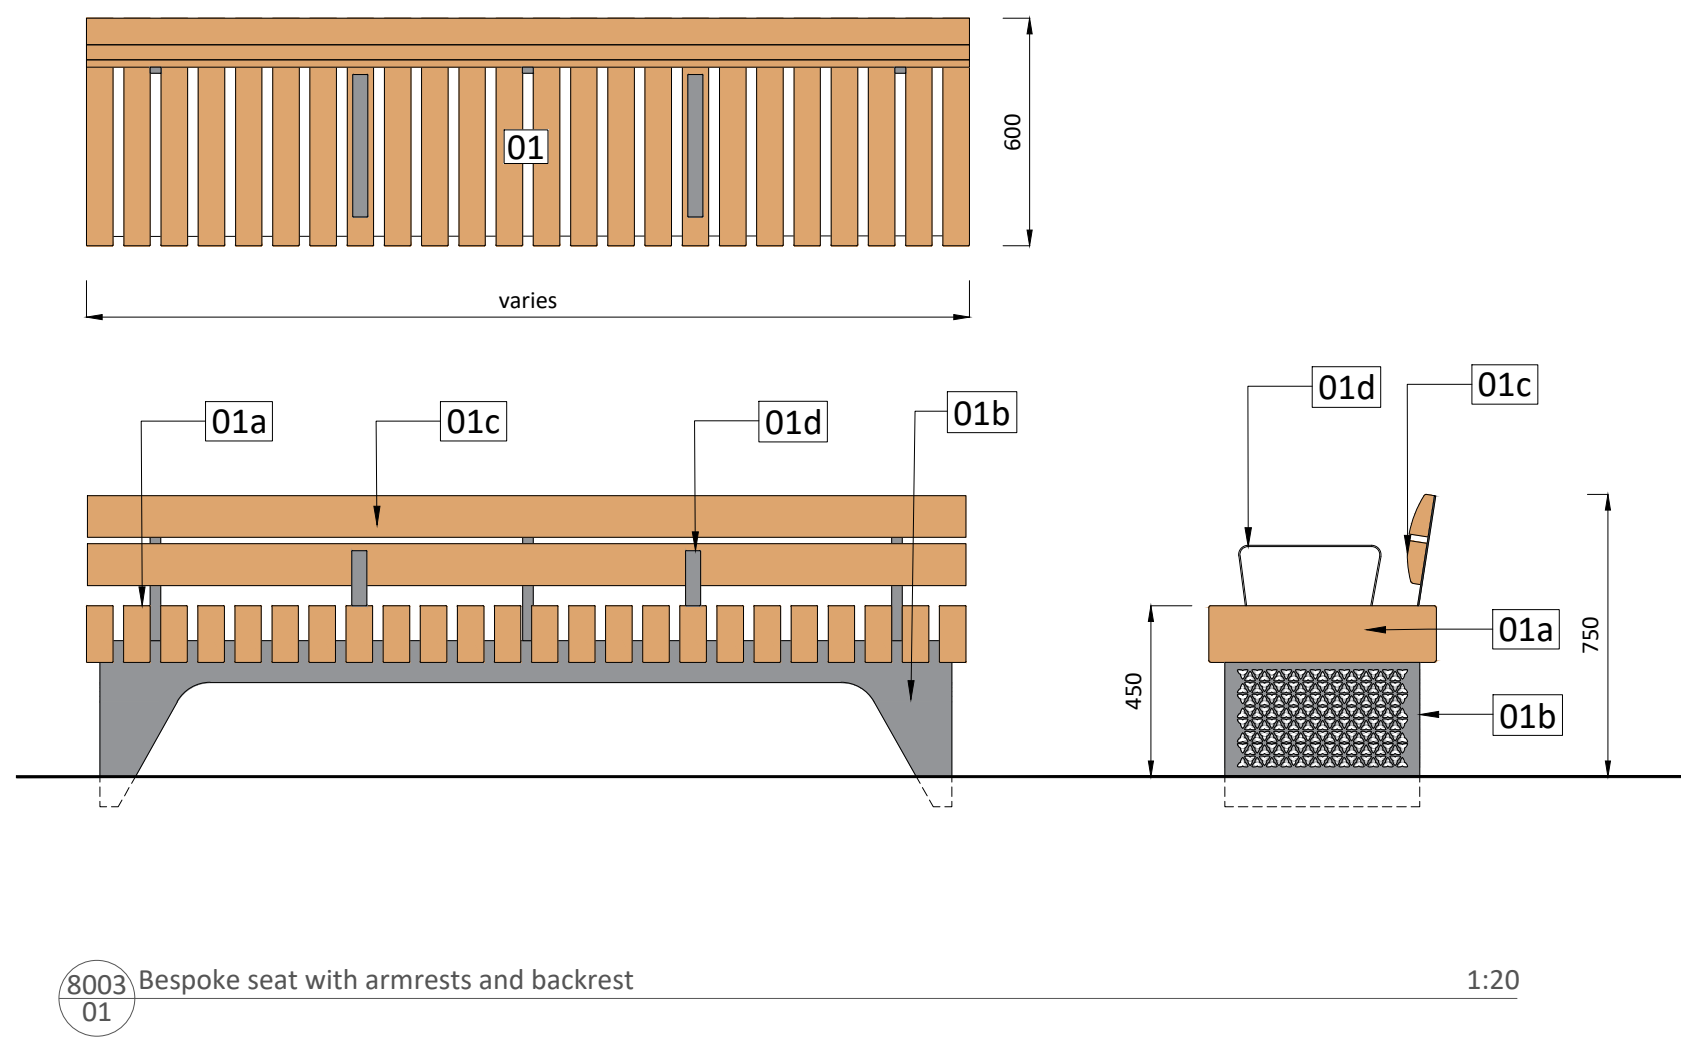

External Furniture

01 Bespoke seat Q50.225A
01a Timber Top *
FSC certified Europe-sourced hardwood timber with UV protective coating
70 x 150 mm slats with 25mm bullnose to the front spaced 28.5mm apart
01b Metal Base *
Steel with bespoke decorative perforated metal sheet panels to sides
Powder coated, RAL to match architecture
01c Timber Backrests *
FSC certified Europe-sourced hardwood timber with UV protective coating
2 no. timber rounded slats fixed to metal back frame
Powder coated metal, RAL to match architecture
01d Metal Armrests *
40mm wide metal armrests fixed directly to the top seat
Powder coated, RAL to match architecture

02 Bespoke bench Q50.220A
02a Timber Top *
FSC certified Europe-sourced hardwood timber with UV protective coating
70 x 150 mm slats with 25mm bullnose to the front spaced 28.5mm apart
02b Metal Base *
Steel with bespoke decorative perforated metal sheet panels to sides
Powder coated, RAL to match architecture

03 Bespoke seating cube Q50.220B
03a Timber Top *
FSC certified Europe-sourced hardwood timber with UV protective coating
70 x 150 mm slats with 25mm bullnose to the front spaced 28.5mm apart
03b Metal Base *
Steel with bespoke decorative perforated metal sheet panels to sides
Powder coated, RAL to match architecture

04 Bespoke seating platform Q50.220C
04a Timber Top *
FSC certified Europe-sourced hardwood timber with UV protective coating
70 x 150 mm slats with 25mm bullnose to the front spaced 28.5mm apart
04b Metal Base *
Steel with bespoke decorative perforated metal sheet panels to sides
Powder coated, RAL to match architecture

05a Removable Metal Bollard Q50.196A
LOT SL250 by mmcite or similar approved
Powder coated, RAL to match architecture

05b Metal Bollard Q50.190A
LOT SL200 by mmcite or similar approved
Powder coated, RAL to match architecture

06 Cycle Stand Q50.210A
Lotlimit SL505 by mmcite or similar approved
Powder coated, RAL to match architecture
Base plate bolted to concrete base

07 Door Barrier Q50.210B *
details to match cycle stands
Bespoke decorative perforated metal sheet panel
Powder coated, RAL to match architecture

08 Litter Bin Q50.240A
PRAX PRX345 120L by mmcite or similar approved
Bespoke decorative perforated metal sheet front access panel
Powder coated, RAL to match architecture

09 Feature Main Signage Totem (N91.520A) *
Bespoke design featuring decorative perforated metal panels, etched masterplan layout and lettering
final details to be confirmed

10 Feature Secondary Signage Totem (N91.520A) *
Bespoke design featuring decorative perforated metal panels and lettering
final details to be confirmed

***This item is design intent only. Final design to be developed at by a specialist designer / manufacturer in line with wider masterplan design intents and approved by landscape architect.**

- Notes**
1. All dimensions in mm, unless otherwise stated.
 2. Scaling from drawing if printed incorrectly may lead to errors.
 3. All information outside red line boundary shown for contextual purpose only.
 4. All hatch patterns are indicative only unless stated otherwise.
 5. This drawing is to be read in conjunction with all the remaining re-form landscape architecture documentation AND all relevant documentation from the design team.
 6. Levels information on this drawing illustrates the design intent. The contractor is to check and verify all levels and dimensions against site survey information.
 7. Any discrepancies in the design information are to be brought to the attention of re-form landscape architecture, in writing, prior to commencement of construction works.
 8. All proprietary products shall be installed in strict accordance with manufacturers written instructions.
 9. Refer to other consultants' drawings and specifications for the following design information:
 - Foundation details
 - Base course and/or sub bases design & specification
 - Waterproofing of any element
 - Drainage design and infrastructure
 - Lighting and ducting
 - Existing & proposed utilities



11.04.24	Project code changed to UBS	SS	MS	DL	P03
Date	Description of revision	Drawn by	Checked by	Approved by	Revision

re-form
landscape architecture

W: re-formlandscape.com
E: info@re-formlandscape.com
T: Edinburgh +44 (0)131 354 1876
Leeds +44 (0)113 245 4695
Manchester +44 (0)161 397 4953

Project
UPPER BROOK STREET, MANCHESTER
RF22-968

Client
KADANS

Document title
STREET FURNITURE TYPICAL DETAILS

Paper size
A1

Status
FOR STAGE APPROVAL

Drawing number
UBS-RFM-XX-XX-DR-L-8003

© re-form landscape architecture

Scale
1:50

Revision
P03