




Site Plan
Scale 1:200
Previously Consented - PC001

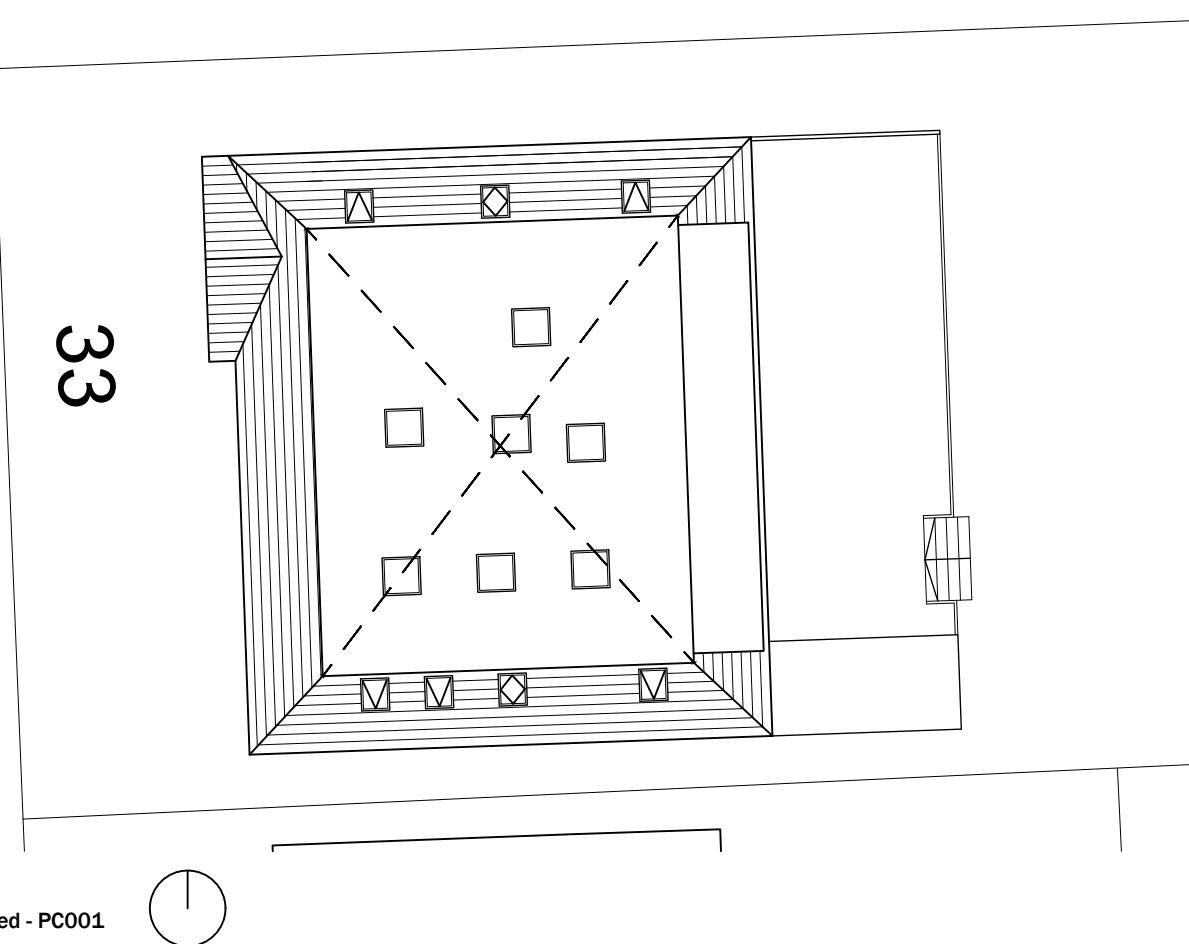



Location Plan
Scale 1:1250
Previously Consented - PC002

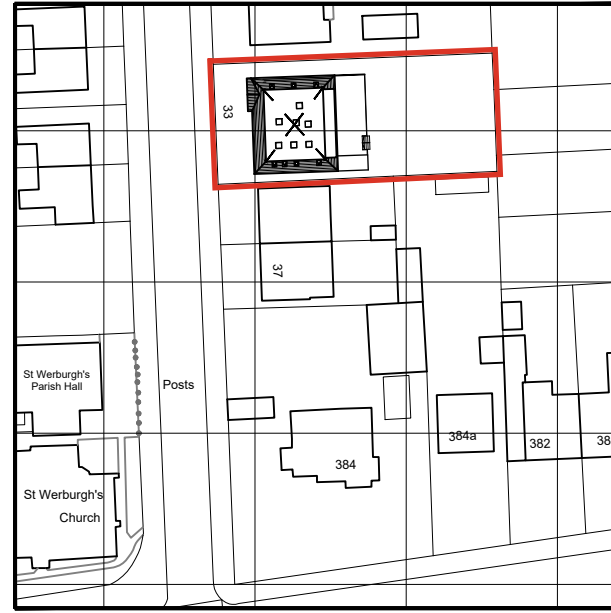


Site Plan
Scale 1:200
As Built - AB001

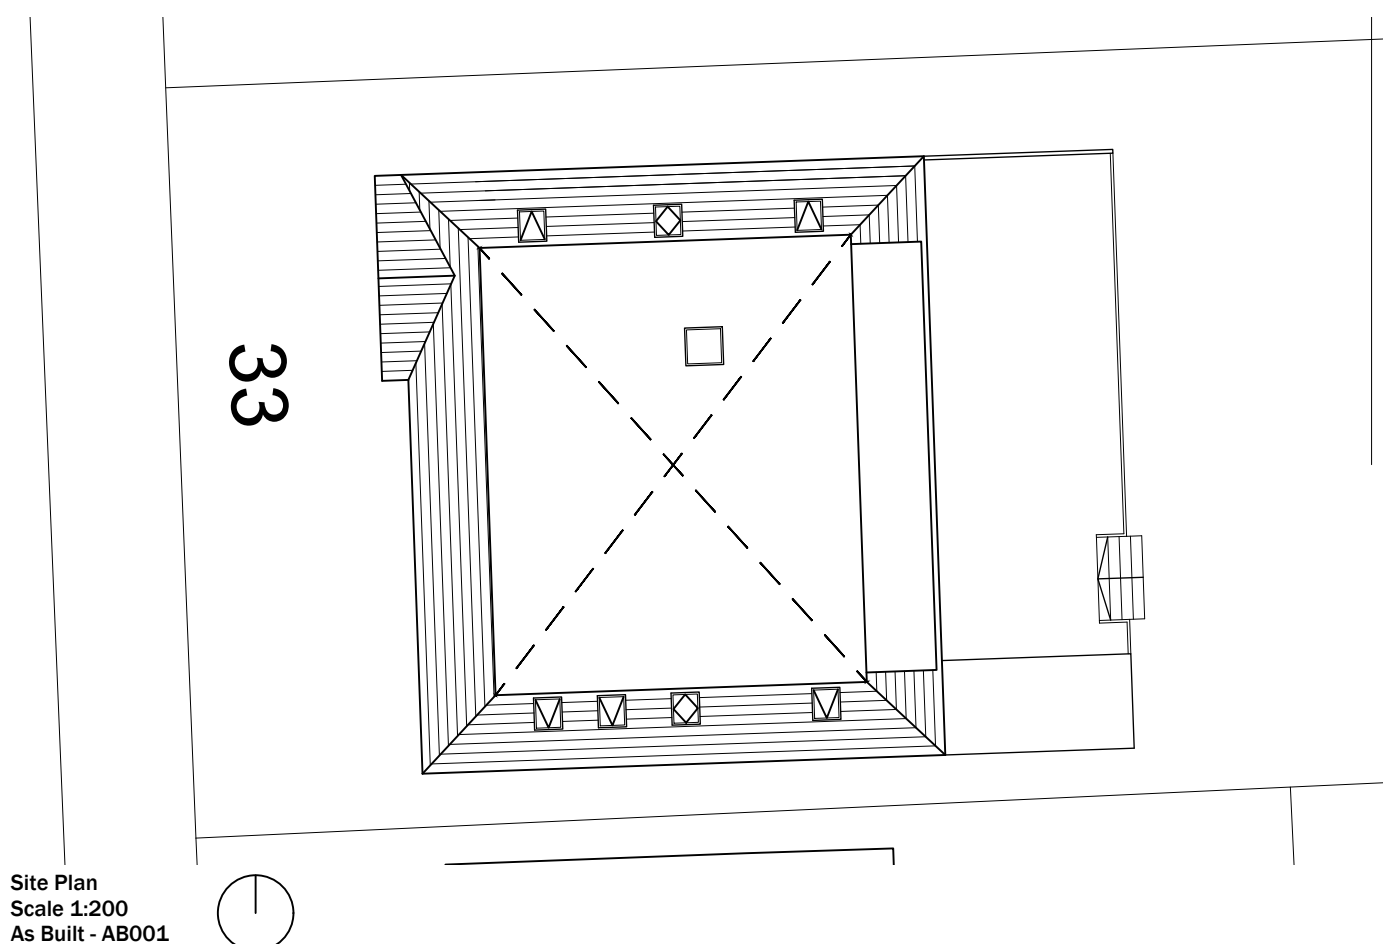


Location Plan
Scale 1:1250
As Built - AB002

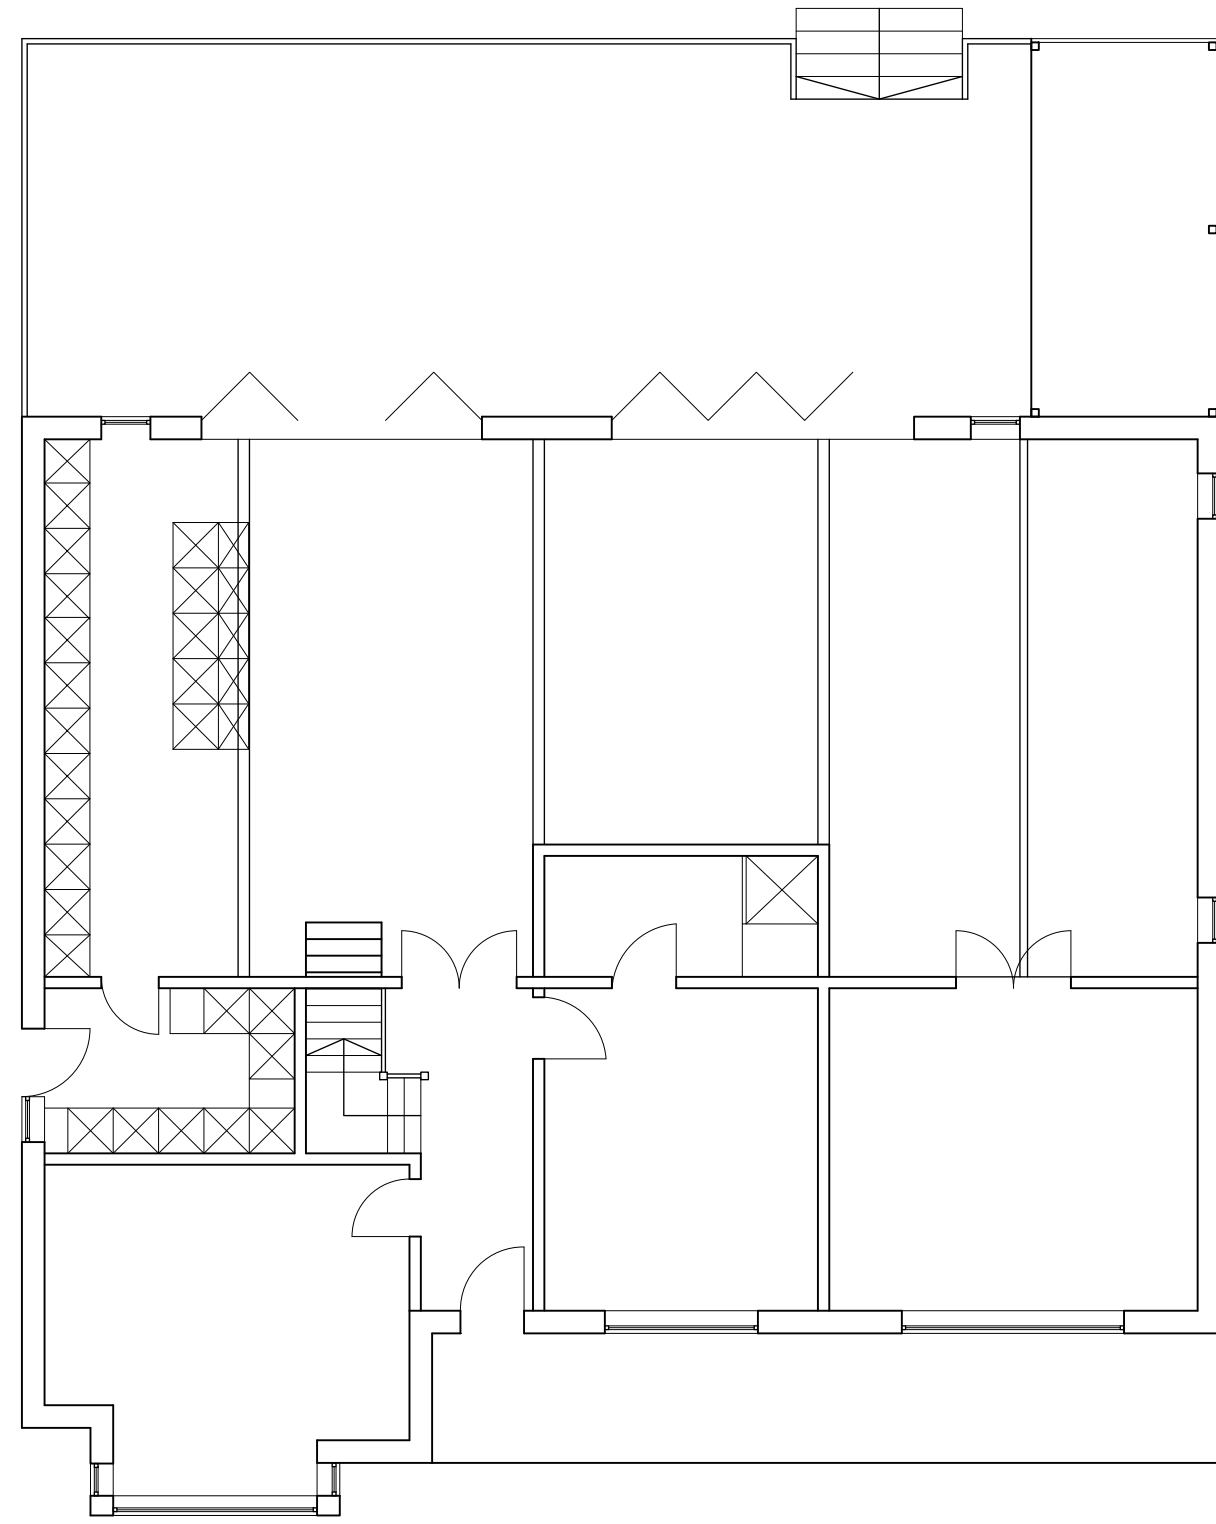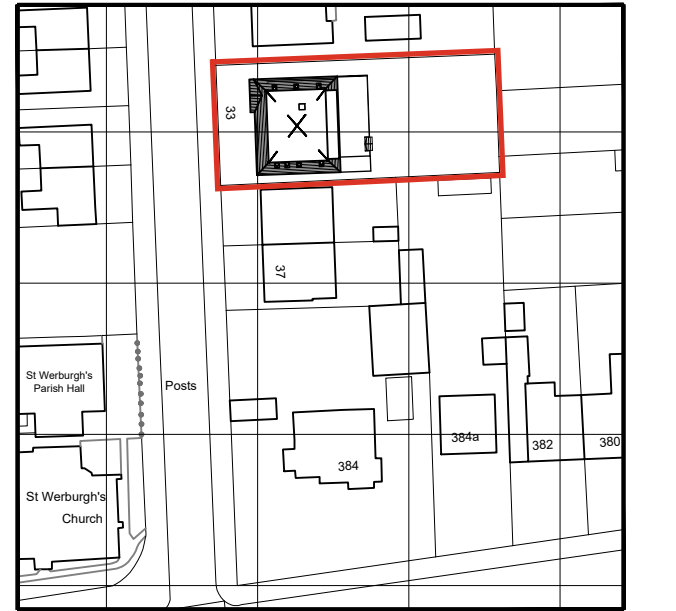


Ground Floor Plan
Scale 1:100
Previously Consented - PC003

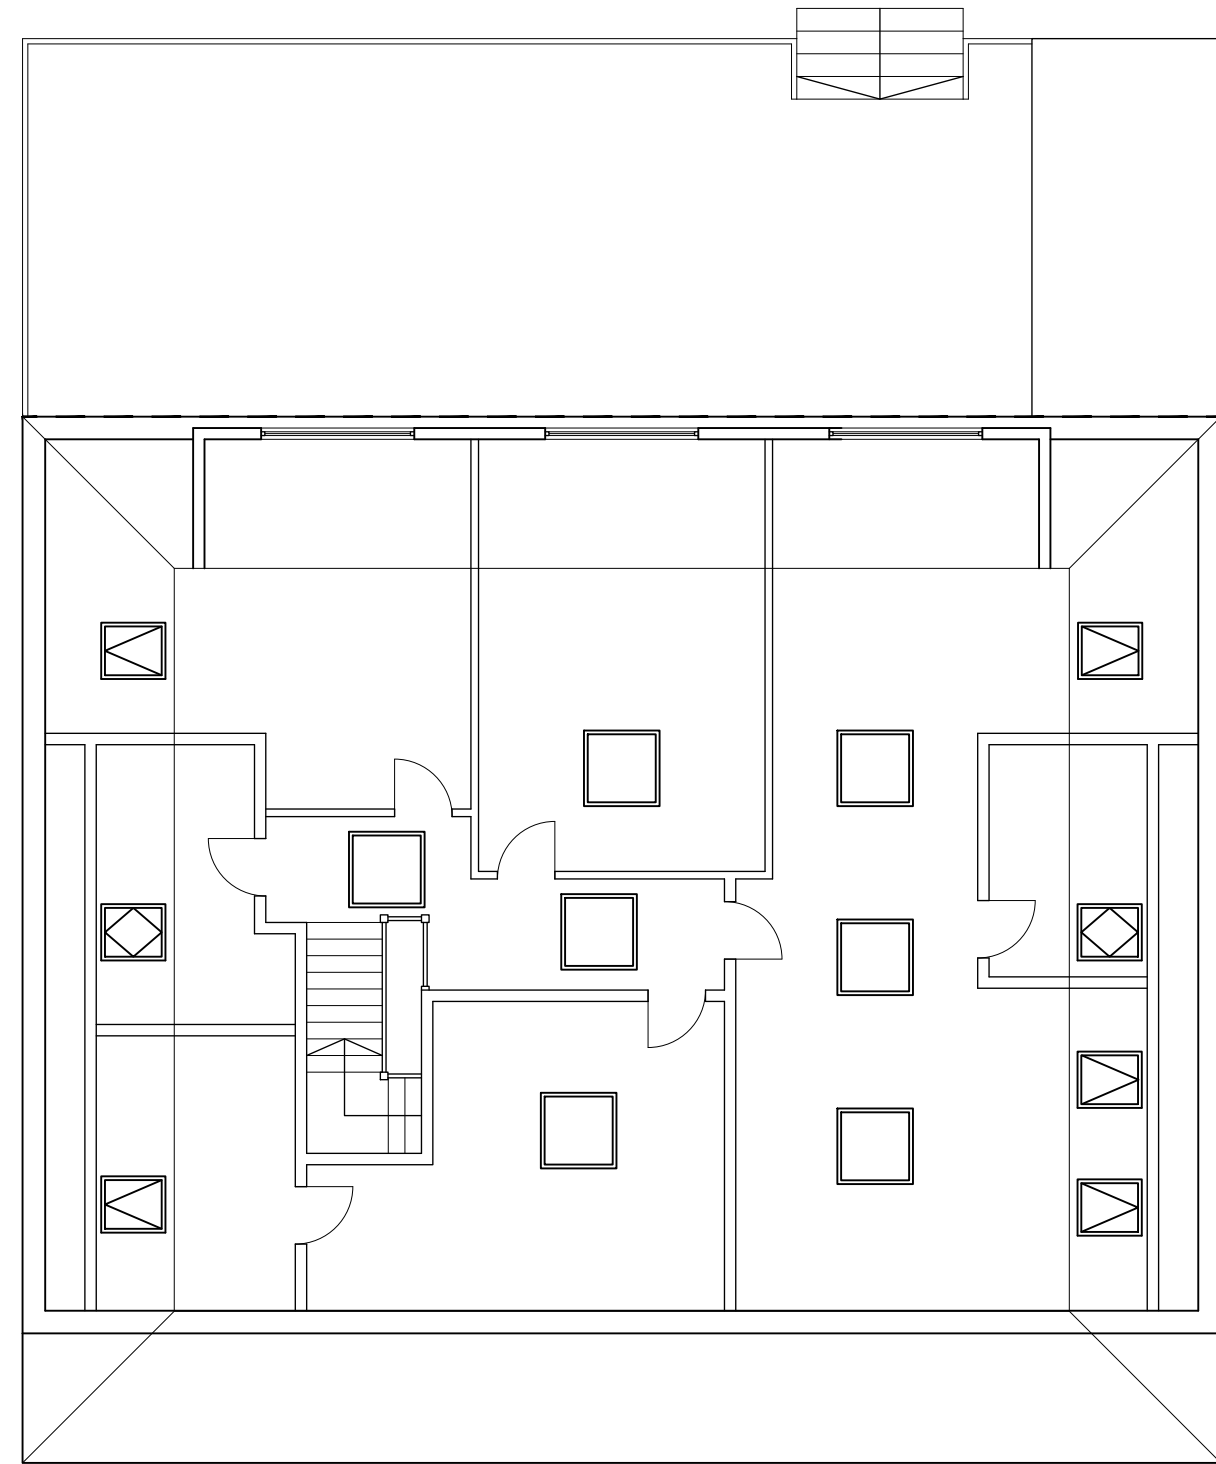


First Floor Plan
Scale 1:100
Previously Consented - PC004

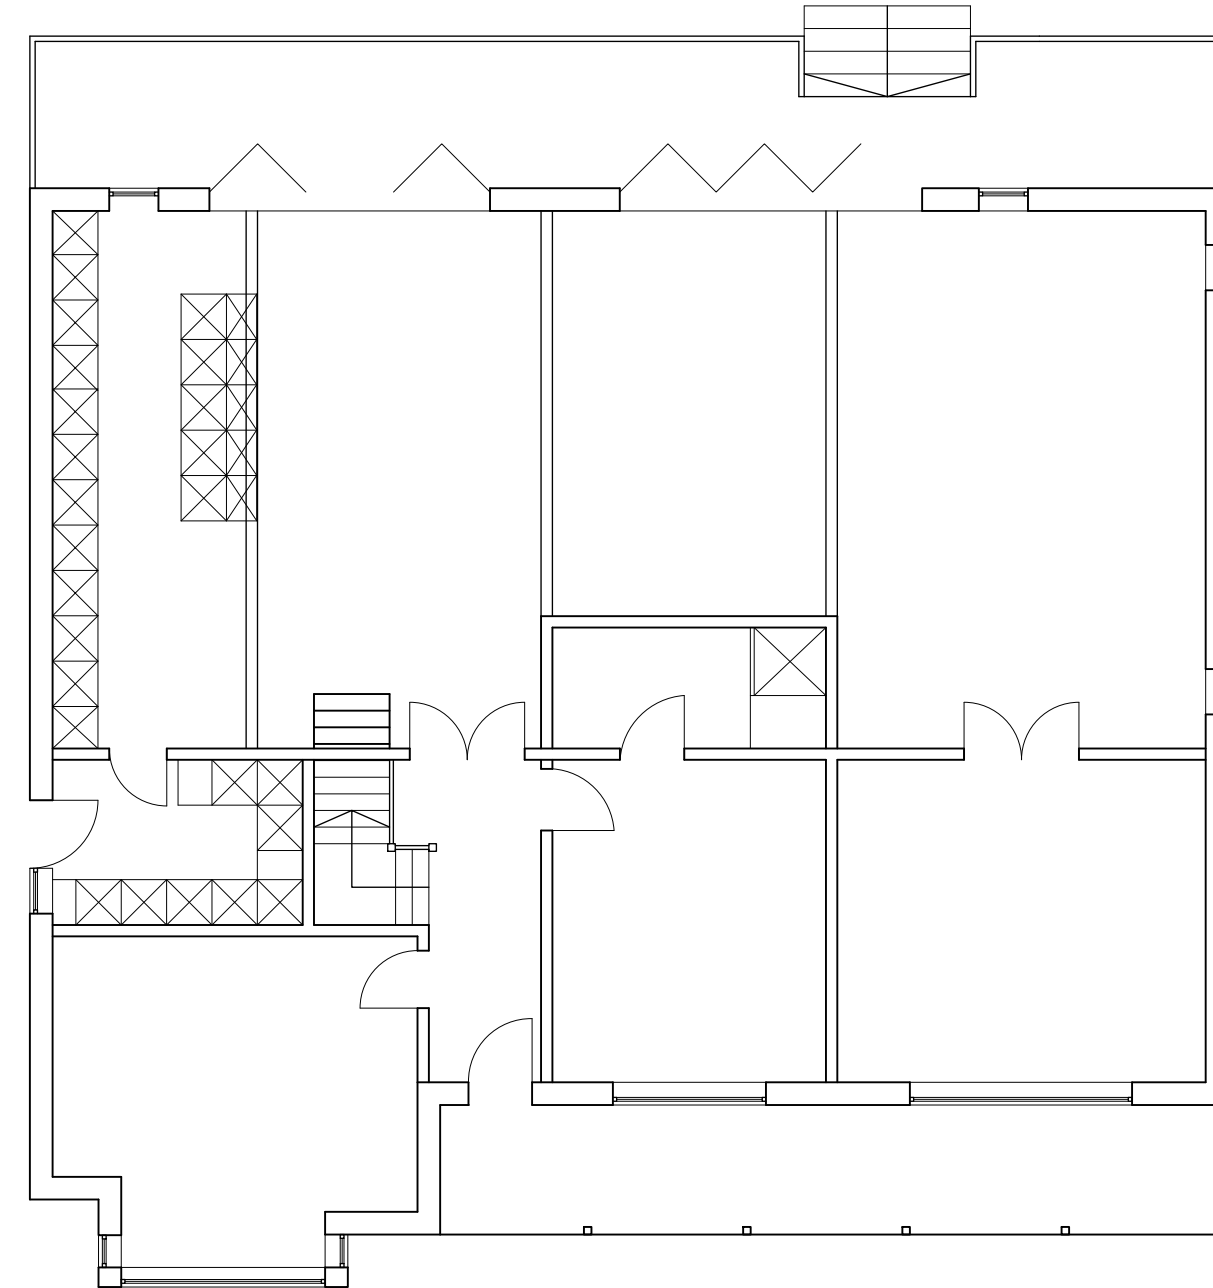


Ground Floor Plan
Scale 1:100
As Built - AB003

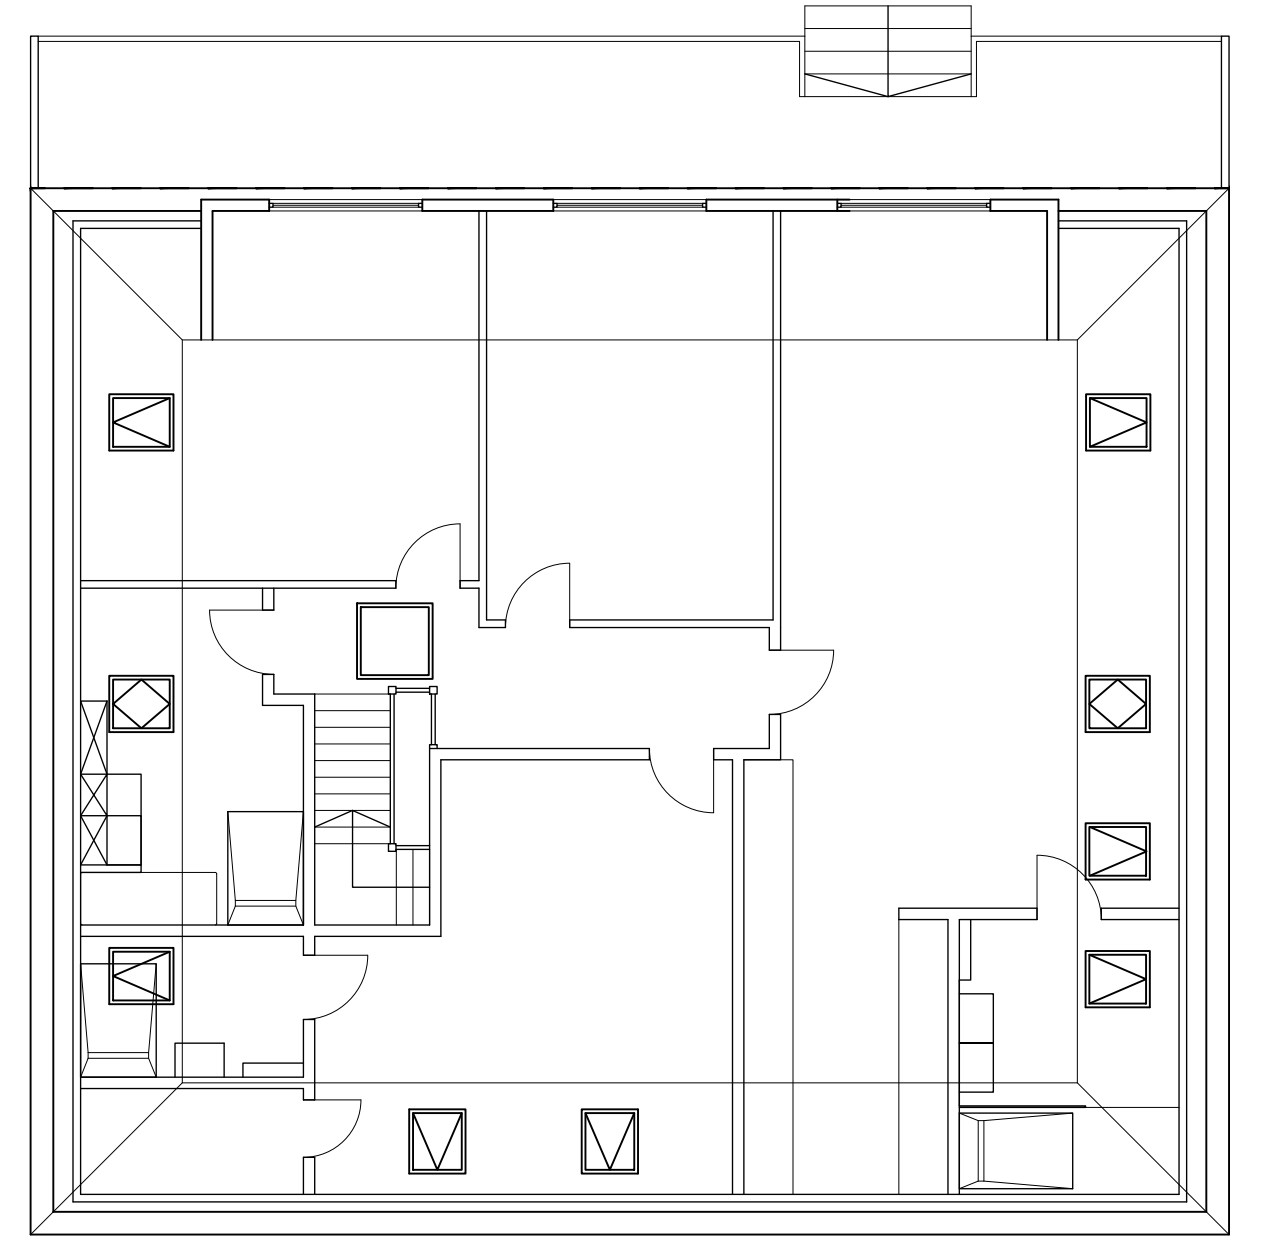


First Floor Plan
Scale 1:100
As Built - AB004

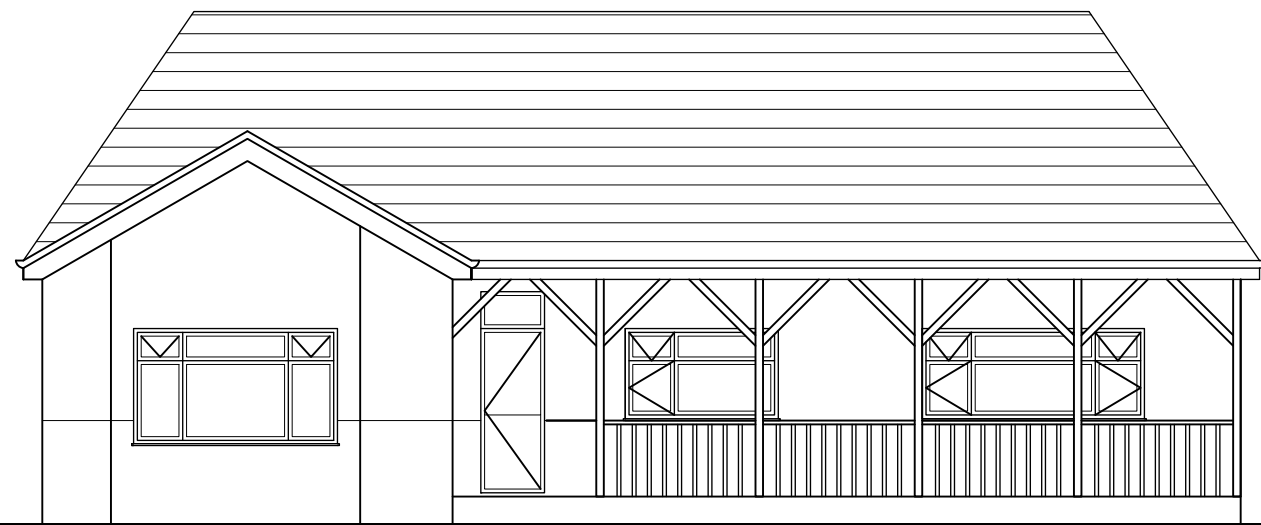


West Elevation
Scale 1:100
Previously Consented - PC005

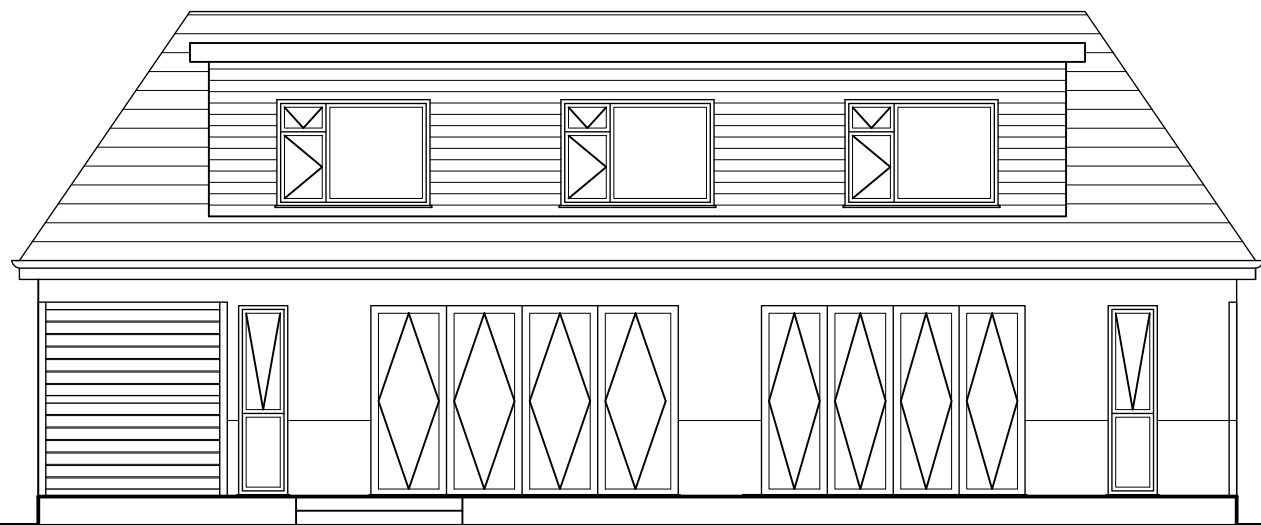


East Elevation
Scale 1:100
Previously Consented - PC006

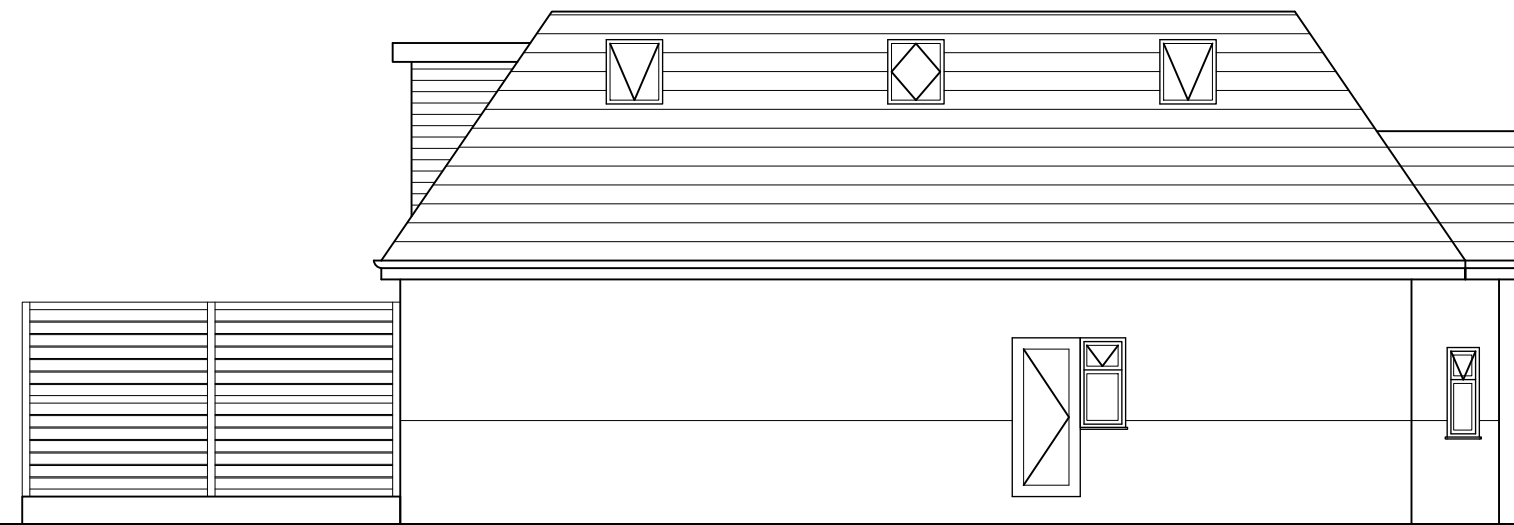


North Elevation
Scale 1:100
Previously Consented - PC007

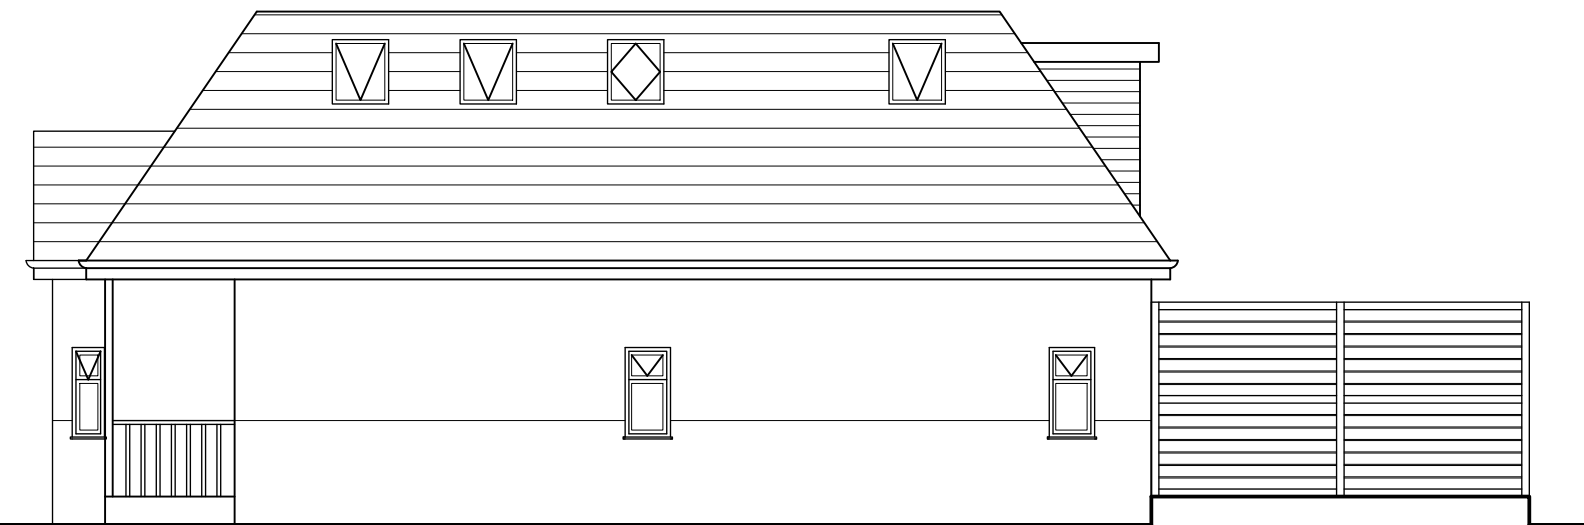


South Elevation
Scale 1:100
Previously Consented - PC008

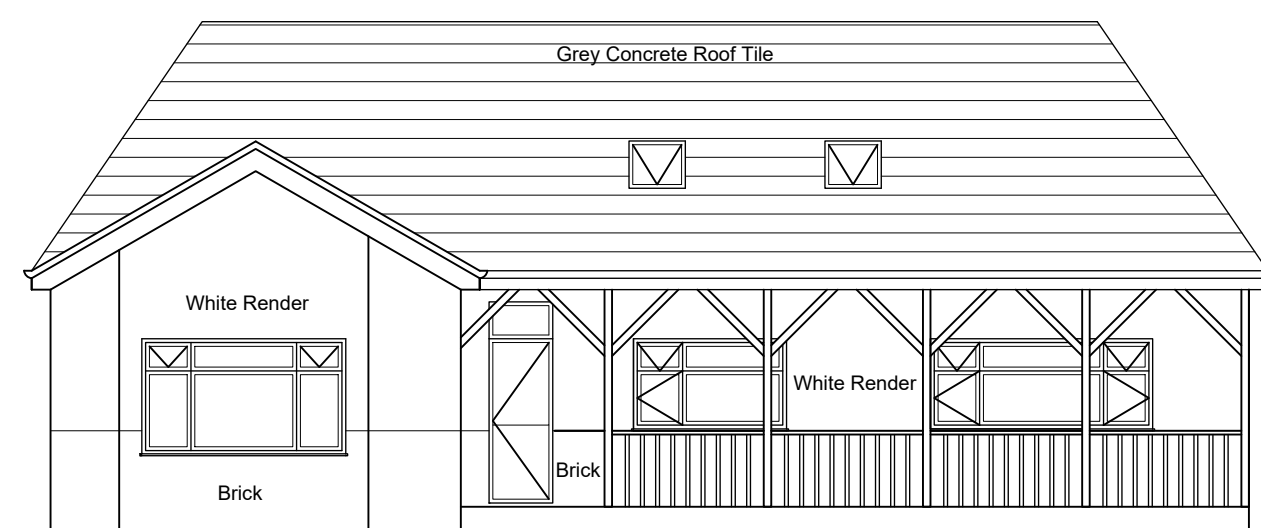


West Elevation
Scale 1:100
As Built - AB005

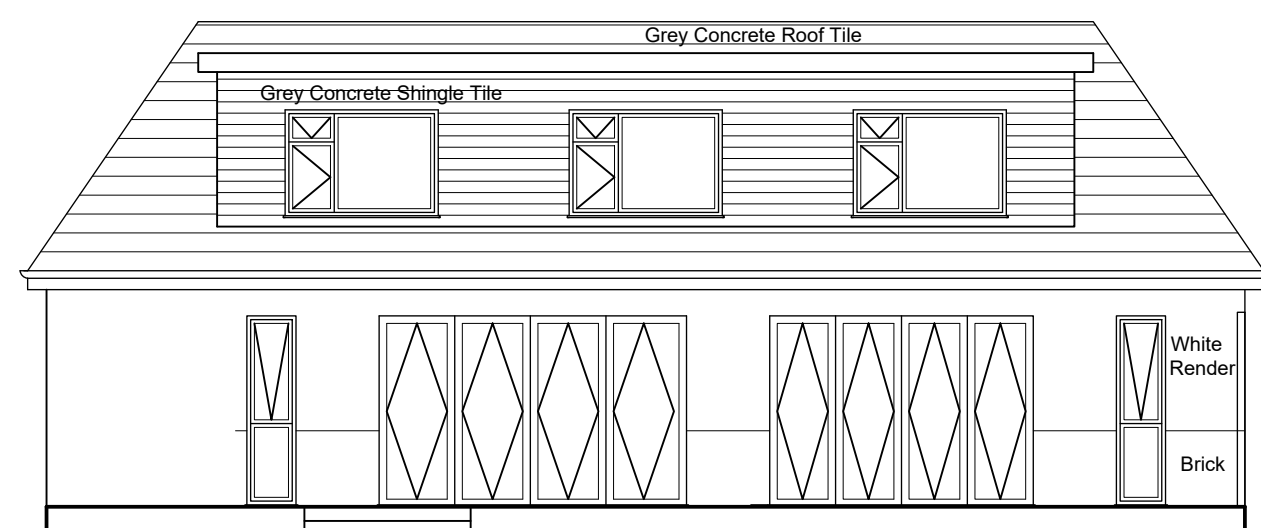

East Elevation
Scale 1:100
As Built - AB006

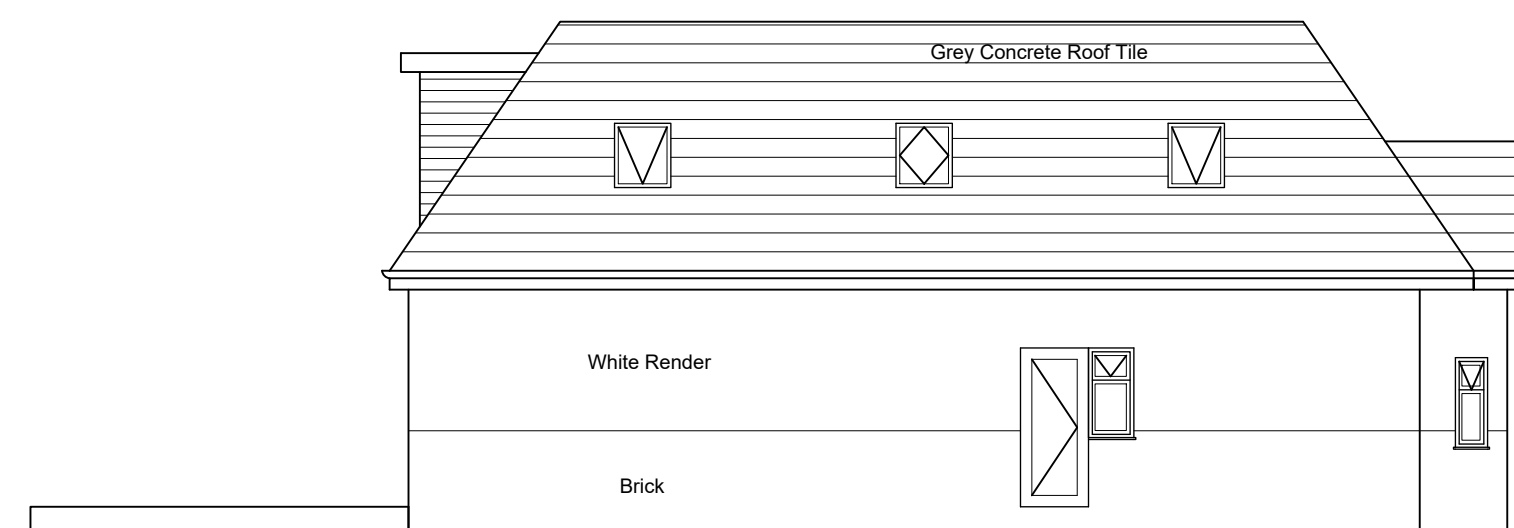

North Elevation
Scale 1:100
As Built - AB007

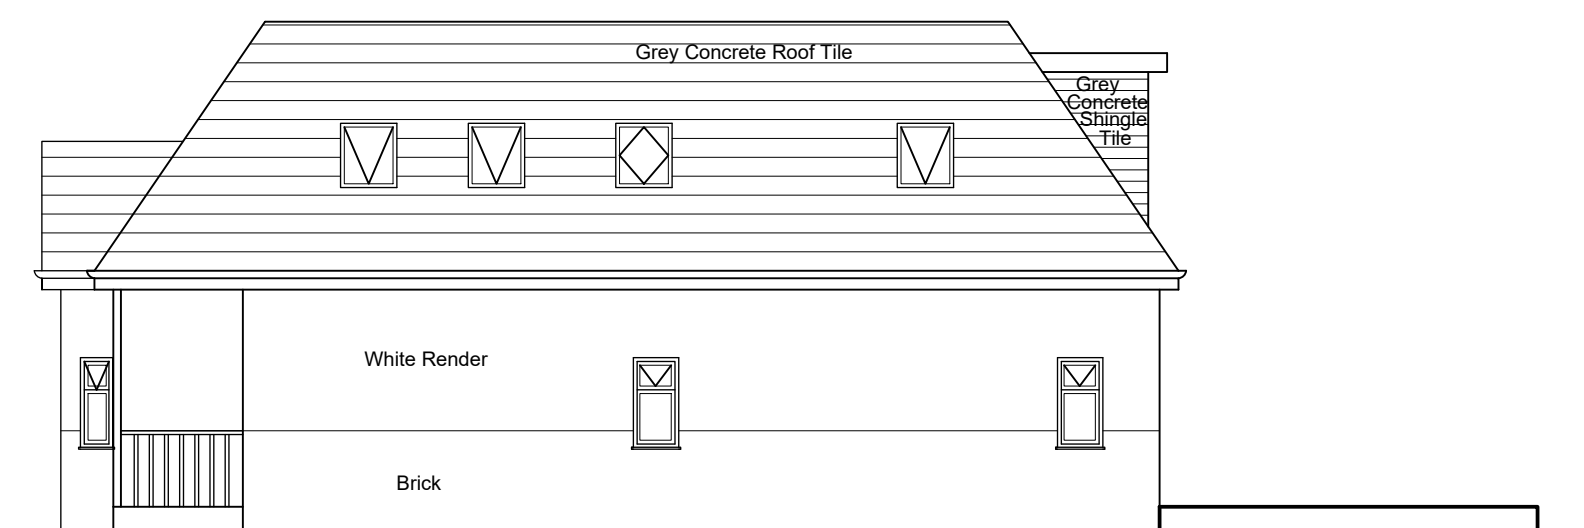

South Elevation
Scale 1:100
As Built - AB008