


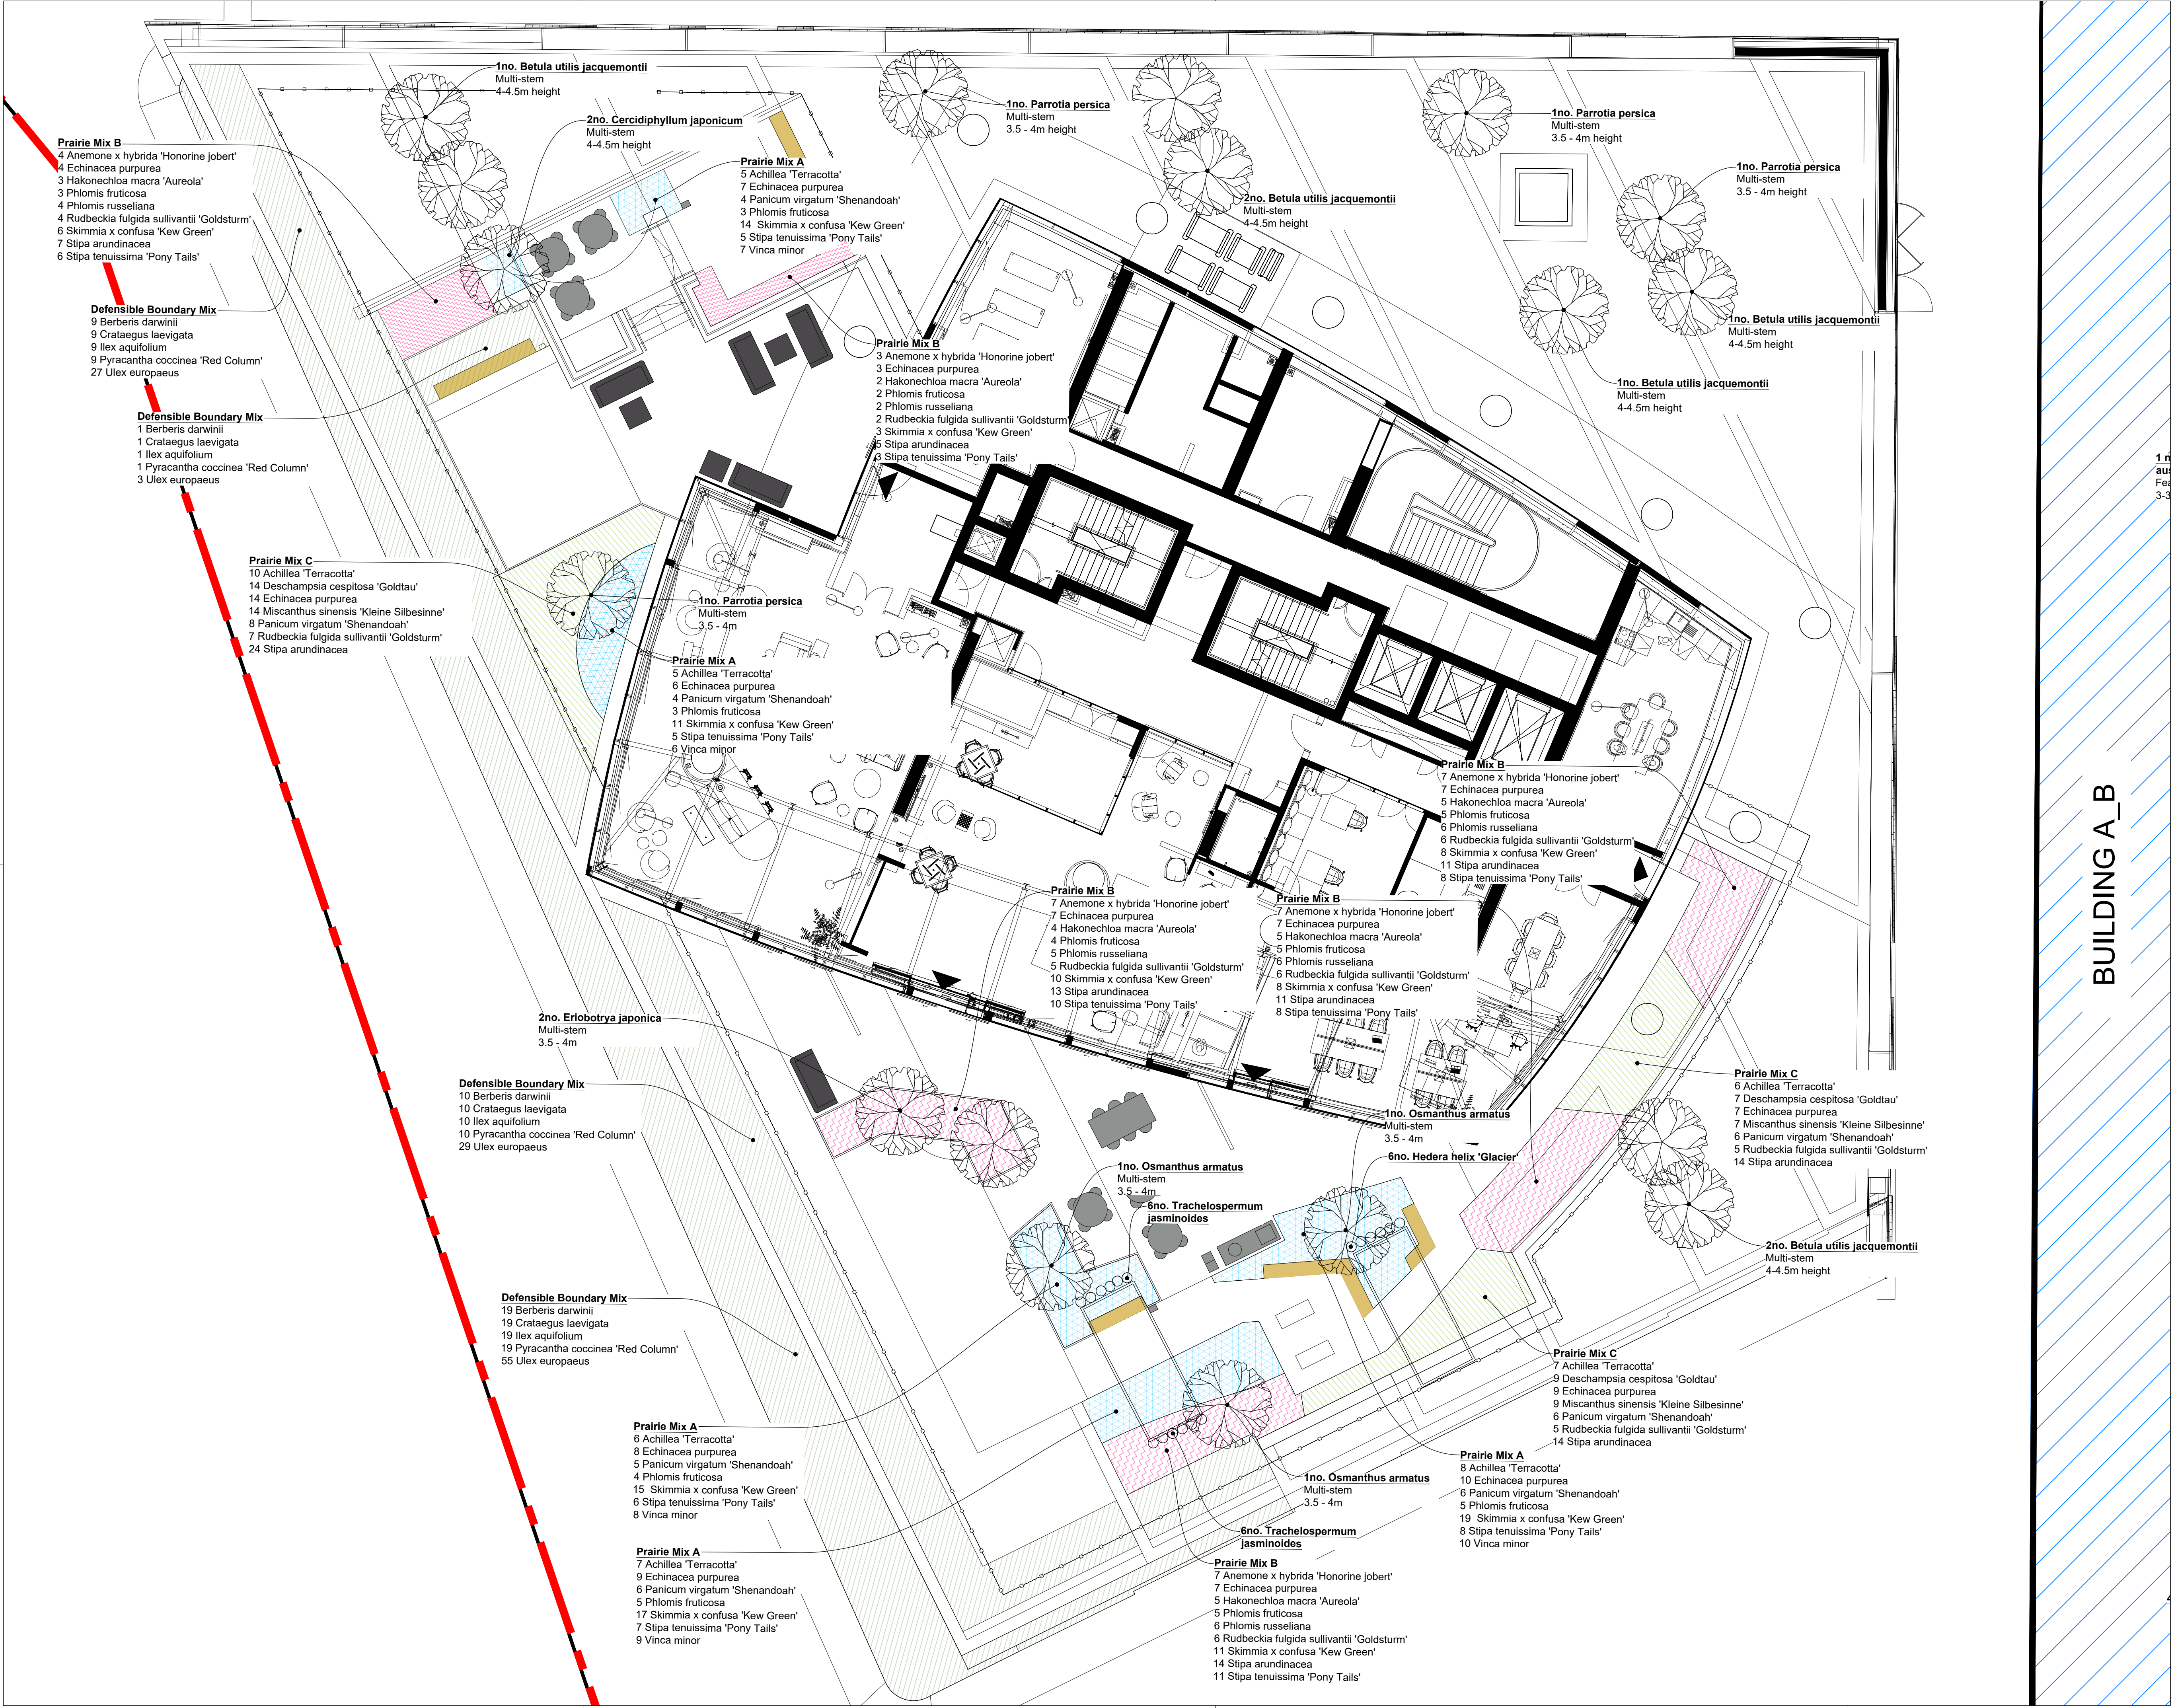

NOTES

- This drawing is to be read in conjunction with all other drawings and specifications.
- Do not scale off this drawing. Written dimensions to be taken only.
- Any discrepancies found between this drawing and other drawings and specifications in the construction documents must be referred to the Landscape Architect prior to work commencing.
- This drawing must not be copied in whole or in part without prior written consent of Optimised Environments Ltd.
- Survey information is based upon aspect surveys Topographical as Survey.

CDM INFORMATION

KEY PLAN

13	AS BUILT	CO	23.06.25
12	Line work and planting nos updated as per MEP info	CO	10.03.25
11	Tree relocated and step level updated	SR	11.02.25
10	Podium entrance relocated & wall moved	CO	16.09.24
09	Planting nos. Updated	SB	02.09.24
08	Planting nos. Updated	CO	14.08.24
07	Planting nos. Updated	SB	22.05.24
06	Planting nos. Updated	SB	05.03.24
05	Line work and planting nos. Updated	SB	11.12.23
04	Line work and planting nos. Updated	SB	19.09.23
03	REINSTATED TREES AND UPDATED PLANTING NOS.	CO	19.06.23
02	STAGE 4 UPDATE	CO	13.06.23
01	STAGE 4 UPDATE	Initial	Date

open
optimised environments

optimised environments ltd

EDINBURGH 2nd Floor | Quartermile Two | 2 Lister Square | Edinburgh | EH3 9GL
t: 0131 221 9820 | e: optimisedenvironments.com

LONDON Wanford Court | 29 Throgmorton Street | London | EC2N 2AT
t: 020 79474562 | e: optimisedenvironments.com

MANCHESTER 13 Swan Street | Manchester | M4 5JZ
t: 0161 696 7550 | e: optimisedenvironments.com

Client

Downing Living (Manchester) Ltd

Project

LOT 11 FIRST STREET SOUTH

Manchester

Drawing Title

**BUILDING D
PODIUM PLANTING PLAN
SHEET 1 OF 1**

Scale Bar

2m 4m 6m 8m 10m

North

Scale: 1:100@A1 Date: Apr 2023

By: AH Status: AS BUILT

Checked: AW Approved: AW

Drawing Number

M90183_D_L216

Rev

13

Computer File: R:\Projects\2019\M90183_FirstStreet\AUTOCAD\SHEETS\PHASE D