



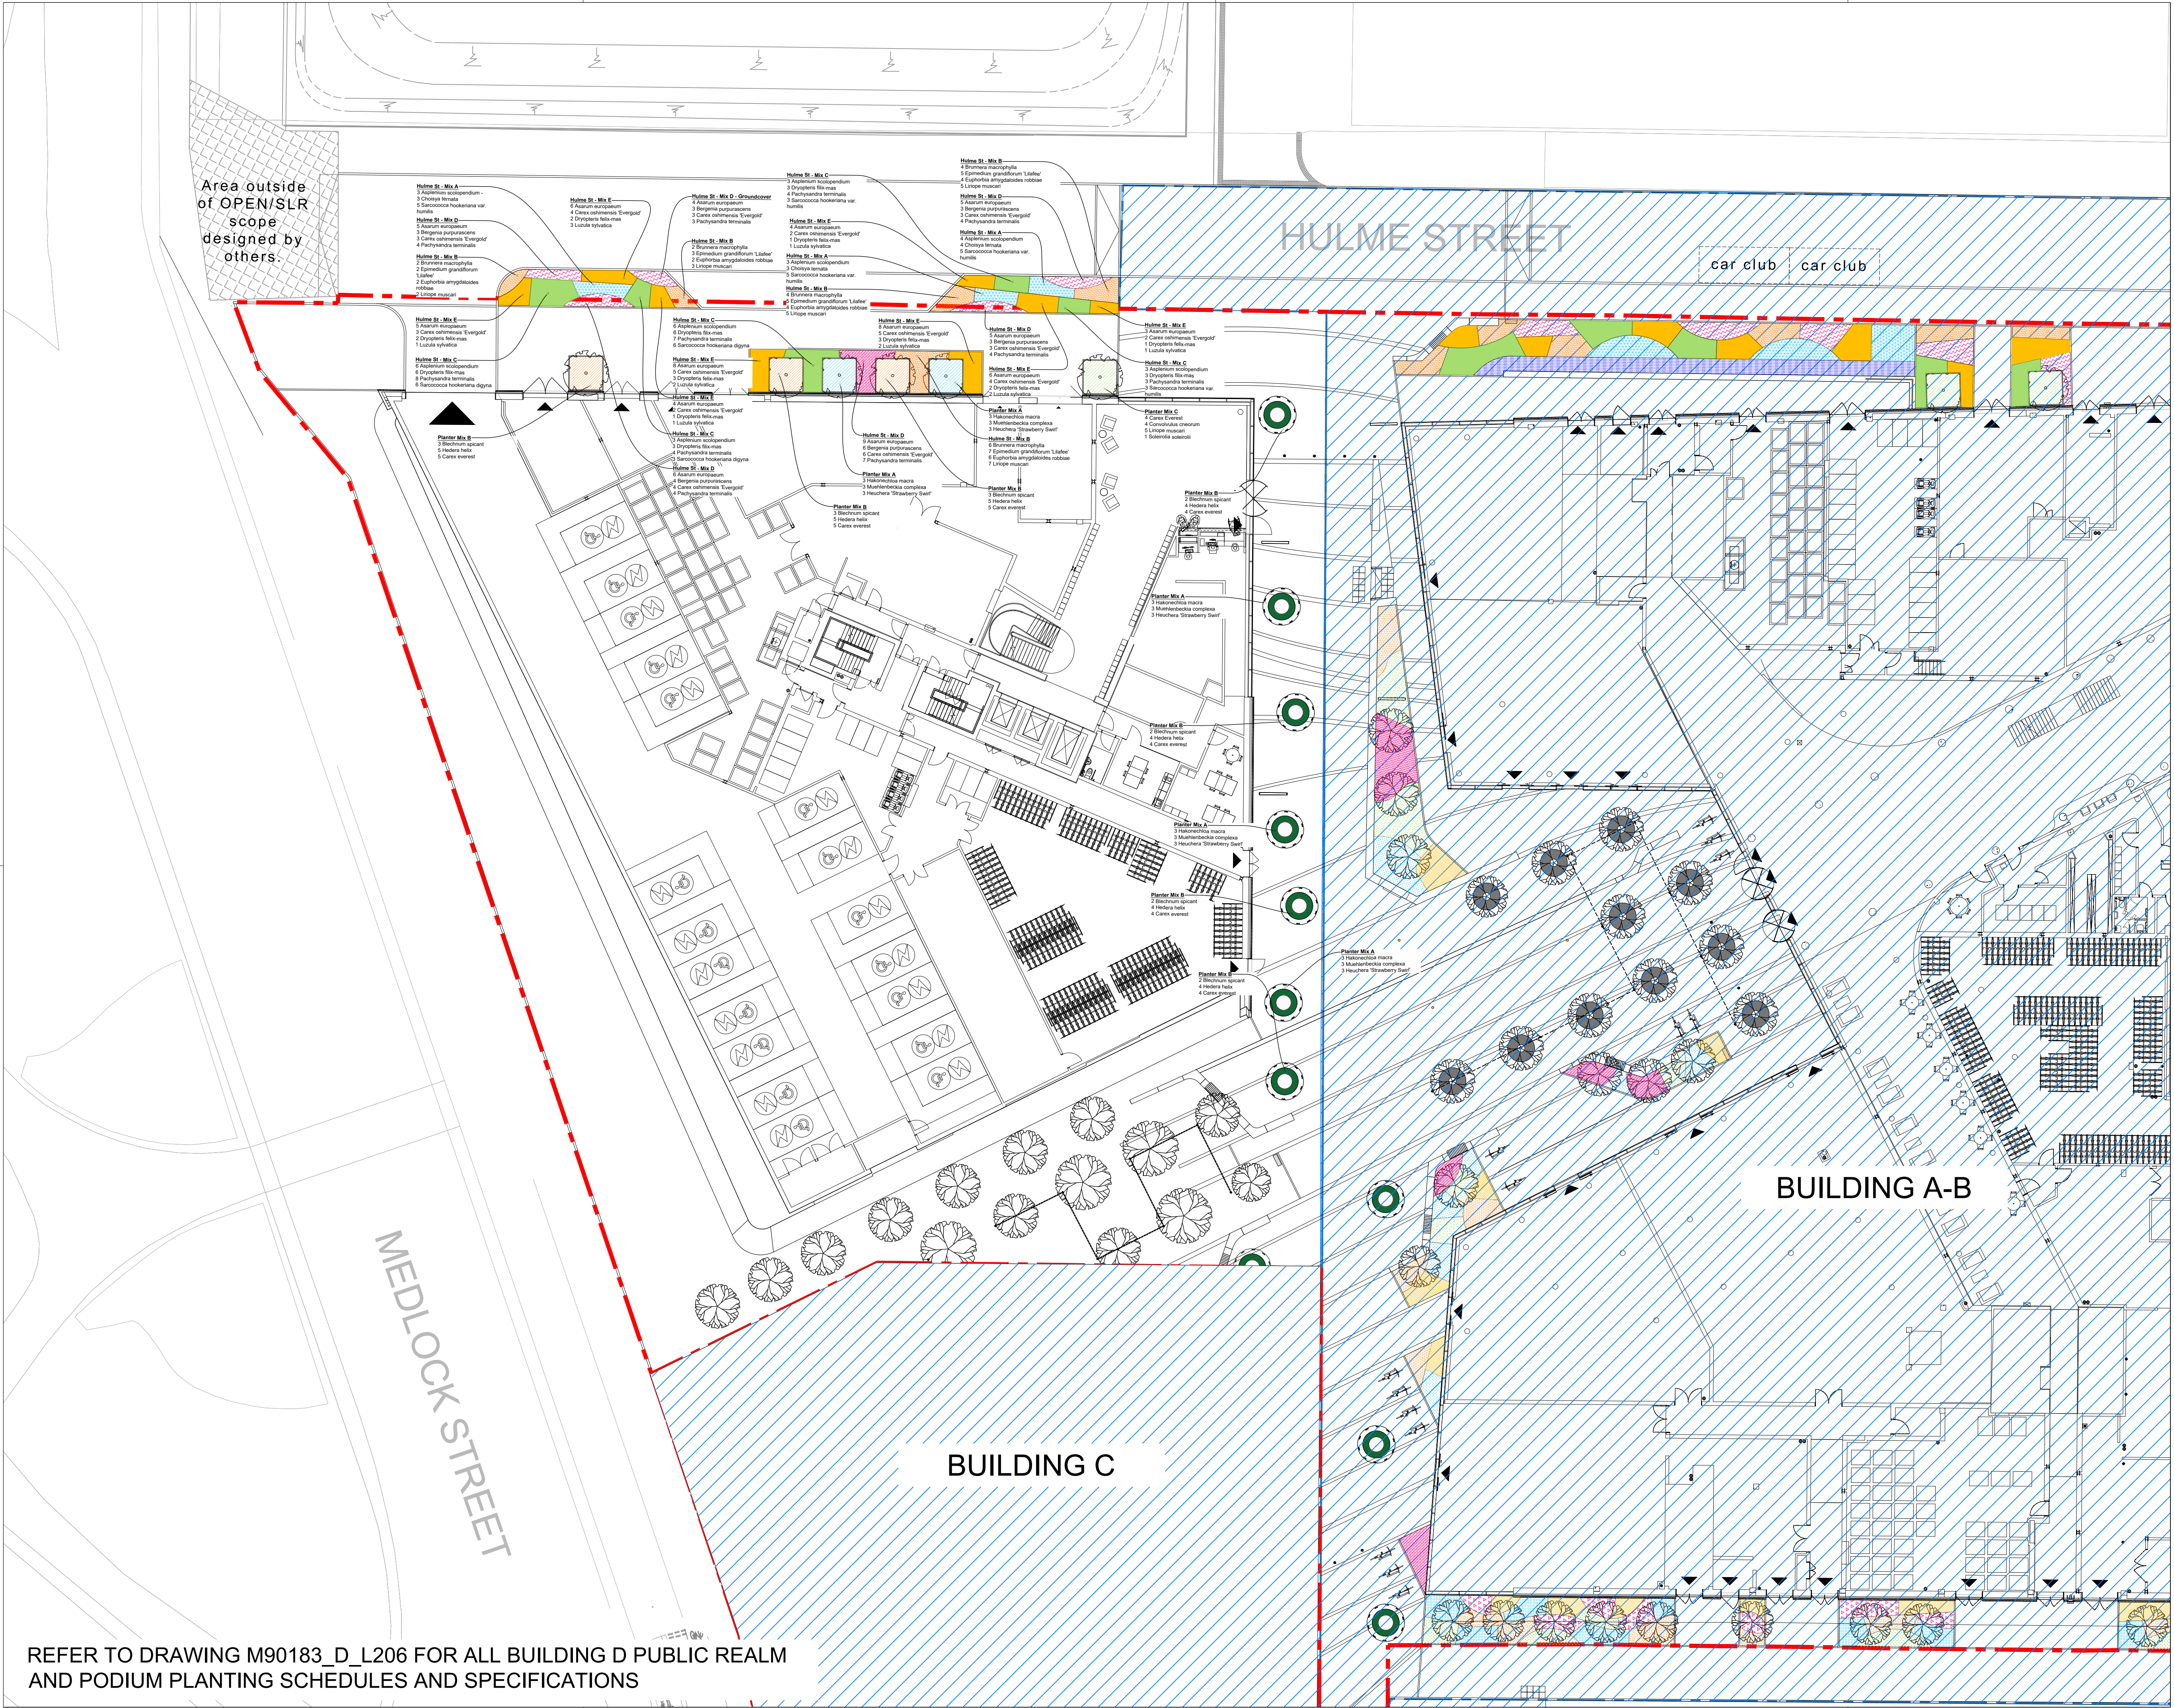

- NOTES
1. This drawing is to be read in conjunction with all other drawings and specifications.
 2. Do not scale off this drawing. Written dimensions to be taken only.
 3. Any discrepancies found between this drawing and other drawings and specifications in the construction documents must be referred to the Landscape Architect prior to work commencing.
 4. This drawing must not be copied in whole or in part without prior written consent of Optimised Environments Ltd.
 5. Survey information is based upon aspect surveys Topographical as Survey.

CDM INFORMATION

KEY PLAN

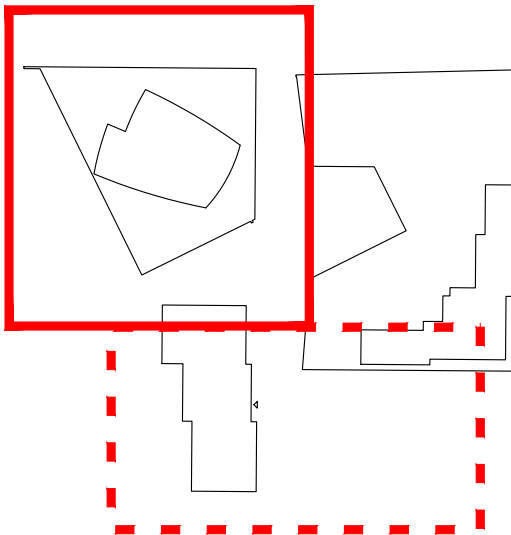


10	AS BUILT	CO	23.08.25
09	Extent of Green Space Reduce	CO	10.02.25
08	LINEWORK AND PLANTING UPDATED	SB	15.11.24
07	GF UPDATES	AH	14.08.24
06	RELANDSCAPING	CO	17.05.24
05	REVISED TREES	CO	19.09.23
04	REINSTATED TREES AND UPDATED PLANTING NOS.	SB	23.08.23
03	ARCHITECTURAL UPDATE	CO	03.08.23
02	ARCHITECTURAL UPDATE	CO	19.06.23
-	FIRST ISSUE	AH	13.06.23
Issue	Revision	Initial	Date

open
optimised environments
optimised environments ltd
2nd Floor | Quarterline Two | 2 Lister Square | Edinburgh | EH3 9GL
t: 0131 221 9820 | e: optimisedenvironments.com
LONDON
Warford Court | 23 Throgmorton Street | London | EC2N 2AT
t: 020 79474662 | e: optimisedenvironments.com
MANCHESTER
13 Swan Street | Manchester | M4 5JZ
t: 0161 696 7550 | e: optimisedenvironments.com

Client
Downing Living (Manchester) Ltd

Project
PLOT 11 FIRST STREET SOUTH
Manchester

Drawing Title
**BUILDING D
PUBLIC REALM PLANTING PLAN
SHEET 1 OF 1**

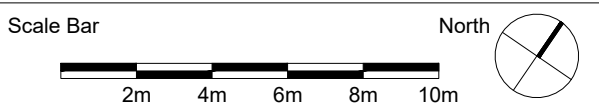

Scale: 1:100@A1 Date: Apr 2023

By: AH Status: AS BUILT

Checked: AW Approved: AW

Drawing Number
M90183_D_L204 Rev
10

REFER TO DRAWING M90183_D_L206 FOR ALL BUILDING D PUBLIC REALM AND PODIUM PLANTING SCHEDULES AND SPECIFICATIONS