



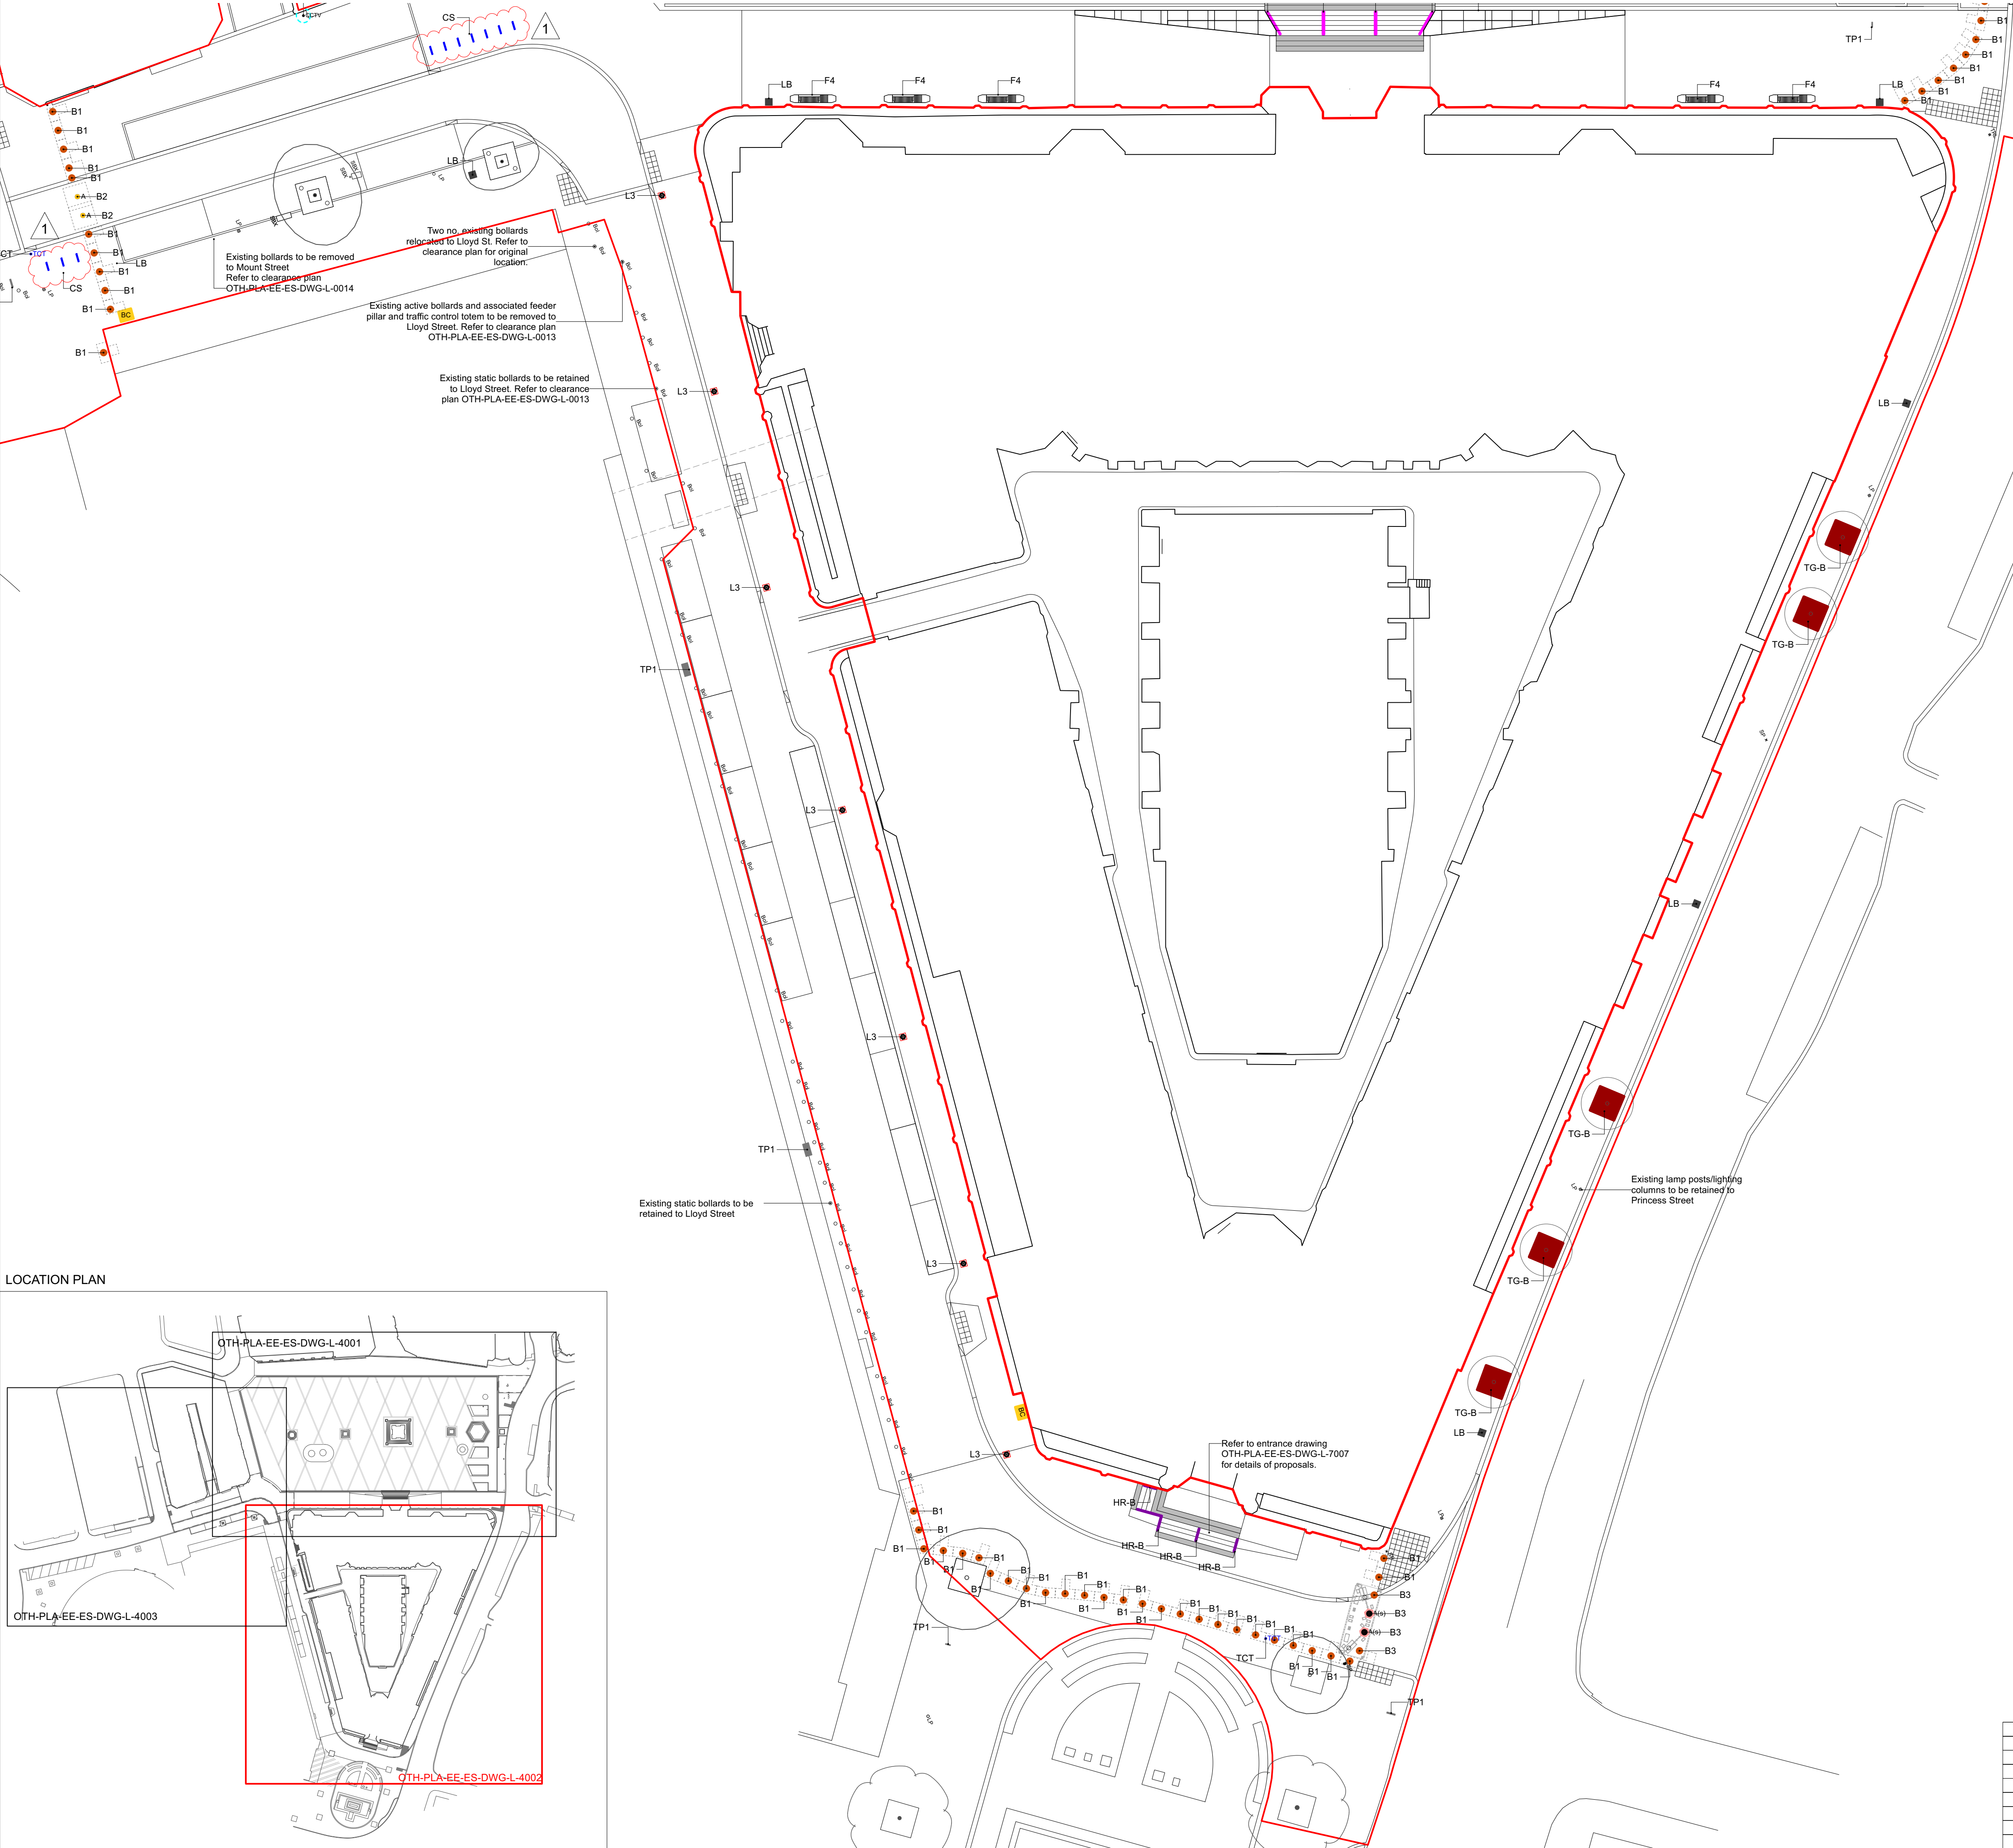

LOCATION PLAN

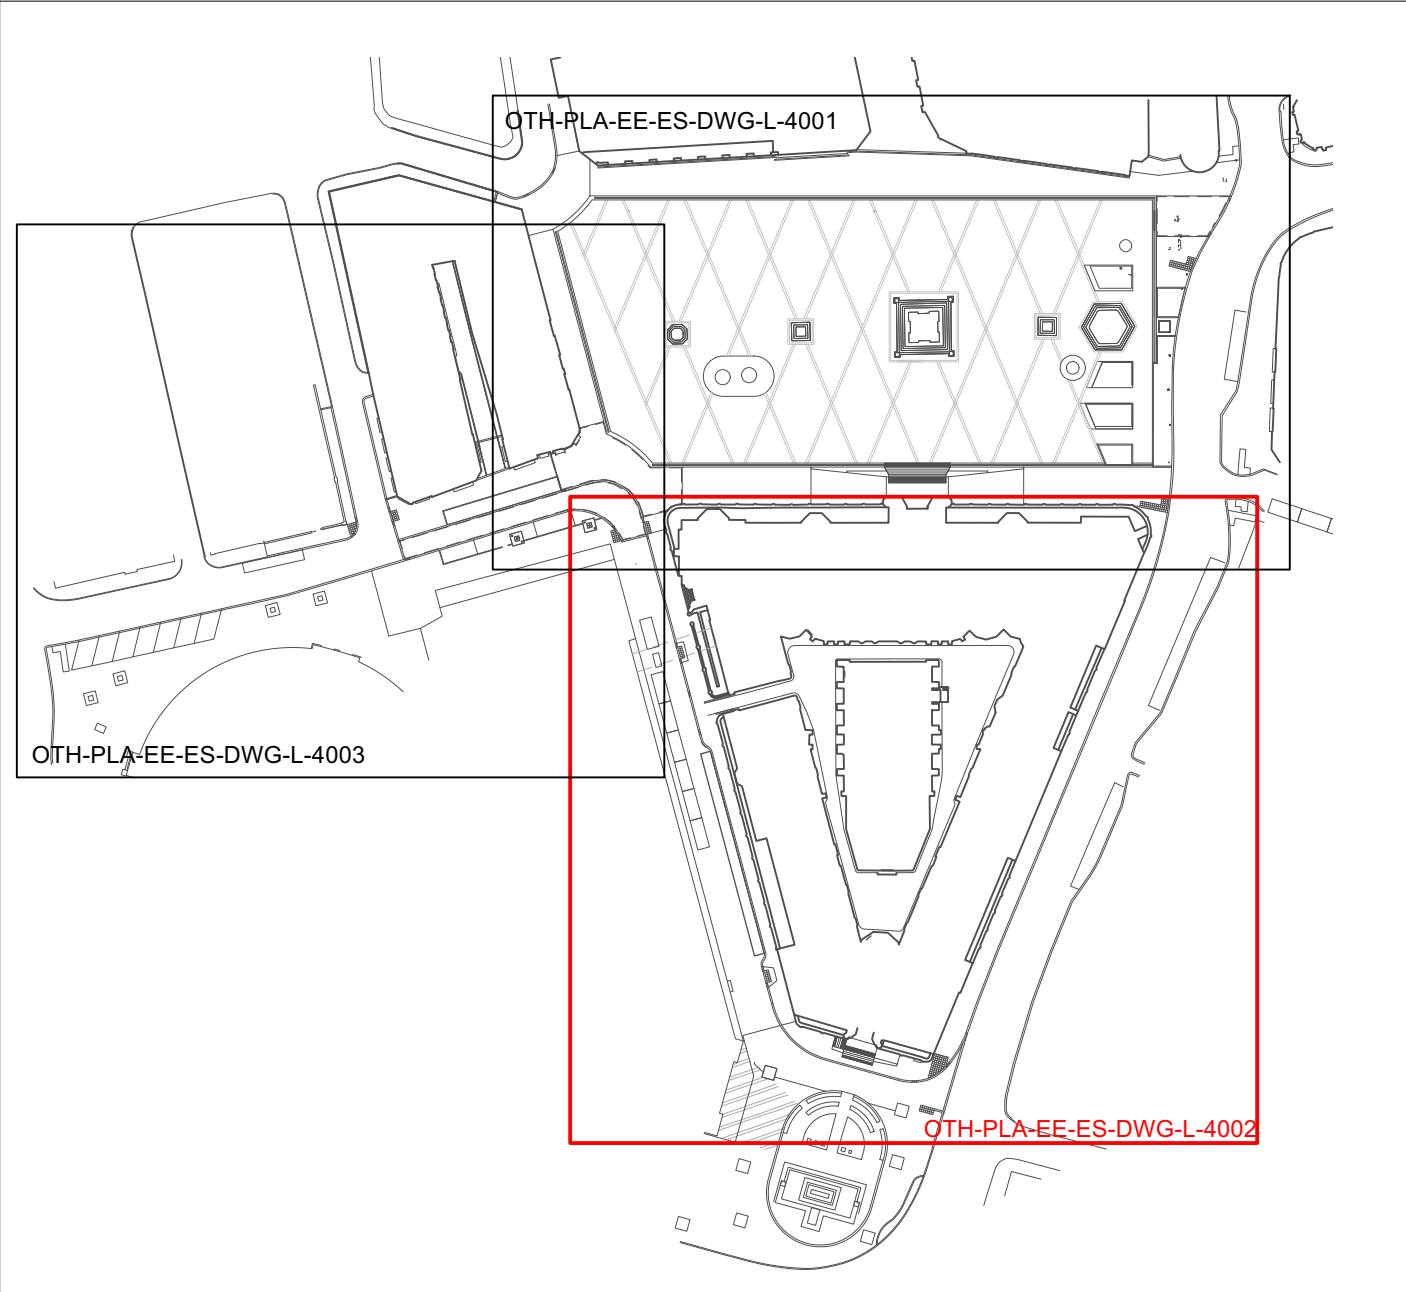

NOTES

1. Drawings are for information only.
2. All dimensions are in millimeters unless otherwise stated.
3. All dimensions are in millimeters unless otherwise stated.
4. The drawing is for information only and is not to be used for construction.
5. The drawing is for information only and is not to be used for construction.
6. The drawing is for information only and is not to be used for construction.
7. The drawing is for information only and is not to be used for construction.

KEY

BOUNDARIES

- Red Line Boundary
- Section 278 Works

LIGHTING & CCTV

Refer to final lighting drawing OTH-PLA-EE-ES-DWG-L-0001 for lighting general arrangement and any associated drawings and specifications.

- L1 Bespoke Lighting Column 14m height
- L2 Bespoke Lighting Column with CCTV 14m height
- L3 Heritage Lighting Column
- L4 CCTV column - 4m height

Existing lighting column to be retained/relocated to Mount St. & Princess St.

FURNITURE

For furniture foundation details refer to Ramboll drawings OTH-PLA-EE-ES-DWG-L-0001 & OTH-PLA-EE-ES-DWG-L-0002

- F1 Large Seating Plinths
To Albert Square. Bespoke design: natural stone plinth feet, steel structural frame and timber seating tops
Refer to detail drawing OTH-PLA-EE-ES-DWG-L-0001
For foundation details, refer to Ramboll drawings OTH-PLA-EE-ES-DWG-L-0001 & OTH-PLA-EE-ES-DWG-L-0002
- F2 Small Seating Plinths
To Albert Square. Bespoke design: natural stone plinth feet, steel structural frame and timber seating tops
Refer to detail drawing OTH-PLA-EE-ES-DWG-L-0001
For foundation details, refer to Ramboll drawings OTH-PLA-EE-ES-DWG-L-0001 & OTH-PLA-EE-ES-DWG-L-0002
- F3 Planter Edge Seating Plinth
To Albert Square. Bespoke design: natural stone base, steel structural frame and timber seating tops
Refer to detail drawing OTH-PLA-EE-ES-DWG-L-0001 to T012 for further details.
For foundation details, refer to Ramboll drawings OTH-PLA-EE-ES-DWG-L-0001 & OTH-PLA-EE-ES-DWG-L-0002
- F4 Freestanding benches
To planting areas. Steel structural frame with timber seating tops.
Refer to detail drawing OTH-PLA-EE-ES-DWG-L-0001
- F5 Railing benches
To planting areas. Steel frame with timber seating tops.
Refer to detail drawing OTH-PLA-EE-ES-DWG-L-0001
- F6 Natural stone plinth / seating edge to planter
To planting areas. Natural stone
Material: Scottish Green Schist, solid stone.
Refer to detail drawing OTH-PLA-EE-ES-DWG-L-0001
- CS Cycle stands
Refer to detail drawing OTH-PLA-EE-ES-DWG-L-0001 for further details.
For foundation details, refer to Ramboll drawings OTH-PLA-EE-ES-DWG-L-0001 & OTH-PLA-EE-ES-DWG-L-0002
- TG-A Tree grilles
Refer to detail drawing OTH-PLA-EE-ES-DWG-L-0001
- TG-B Tree grilles to Princess Street
Refer to detail drawing OTH-PLA-EE-ES-DWG-L-0001
- LB Litter bins
Refer to detail drawing OTH-PLA-EE-ES-DWG-L-0001
- HR-A Handrails to Albert Square Entrance
Refer to detail drawing OTH-PLA-EE-ES-DWG-L-0001
- HR-B Handrails to Cooper Street Entrance
Refer to detail drawing OTH-PLA-EE-ES-DWG-L-0001

VEHICLE SECURITY FEATURES

Refer to Arup security specification in conjunction with this drawing. For final positions of bollards and associated features refer to specialist suppliers layout and fabrication drawings.

- B1 Static Bollard
Refer to drawing OTH-PLA-EE-ES-DWG-L-0001 for further details.
For foundation details, refer to Arup Access Ltd drawings and specifications.
- B2 Active (Telescopic) Bollard
Refer to drawing OTH-PLA-EE-ES-DWG-L-0001 for further details.
For foundation details, refer to Arup Access Ltd drawings and specifications.
- B3 Active (Sliding) Bollard
4 bollards array including 3 active and 1 sliding bollards. For foundation details, refer to Head Ltd drawings and specifications.
- BCP Telescopic Bollard Control Panel
For foundation details, refer to Arup Access Ltd drawings and specifications.
- TCT Traffic Control Totem
For foundation details, refer to Arup Access Ltd drawings and specifications.
- Existing bollards to be retained on Mount St. & Lloyd St.

WAYFINDING

- TP1 Wayfinding Elements
Refer to corporate wayfinding drawing OTH-PLA-EE-ES-DWG-L-0001
- Existing post box relocated
- Existing Ocean Digital display board relocated

Additional Existing Features Retained

- Existing post retained
Related to tramline and/or existing crossings
- Existing traffic light retained
- Existing signpost retained
- Existing service box retained

Revision	Date	Description	Drawn	Appr.

Planit I.E. Limited

E: info@planit-ie.com W: planit-ie.com

MANCHESTER
2 Back Grafton St., Altrincham, WA14 1DY
T: 0161 928 9281

LONDON
Unit 6 Waterside, 44-48 Wharf Road, London, N1 7UX
T: 0207 253 5678

LIVERPOOL
No. 8 Princes Parade, Princes Dock, Liverpool, L3 1DL
T: 0151 705 6746

Client Manchester City Council

Project Our Town Hall

Drg Title Furniture General Arrangement 2 of 3

Created on	Created by	Approved by
19.09.18	SR	MS/KR

Scale	Size	Workstage
1:250	A1	Stage 5

Drg No.	Suitability	Revision
OTH-PLA-EE-ES-DWG-L-4001	S4	C02

1. Minor amendments to cycle stand positions / spacing.

C02	07/11/23	Refer to Revision Notes	SY	MS/KR	
C01	01/04/21	Construction Issue	SR	MS/KR	
O7	26/02/21	Stage 4 Issue (Re-Coordination)	SR	MS/KR	
O6	14/11/19	Refer to revision notes	SR	MS/KR	
O5	06/09/19	Planning Issue	SR	MS/KR	
O4	26/07/19	Stage 4 Issue	SR	MS/KR	
O3	31/05/19	Stage 3+ Issue	SR	MS/KR	
O2	21/01/19	Refer to revision notes	SR	MS/KR	
O1	30/11/18	Stage 3 Issue	SR	MS/KR	

© Planit I.E. Limited