


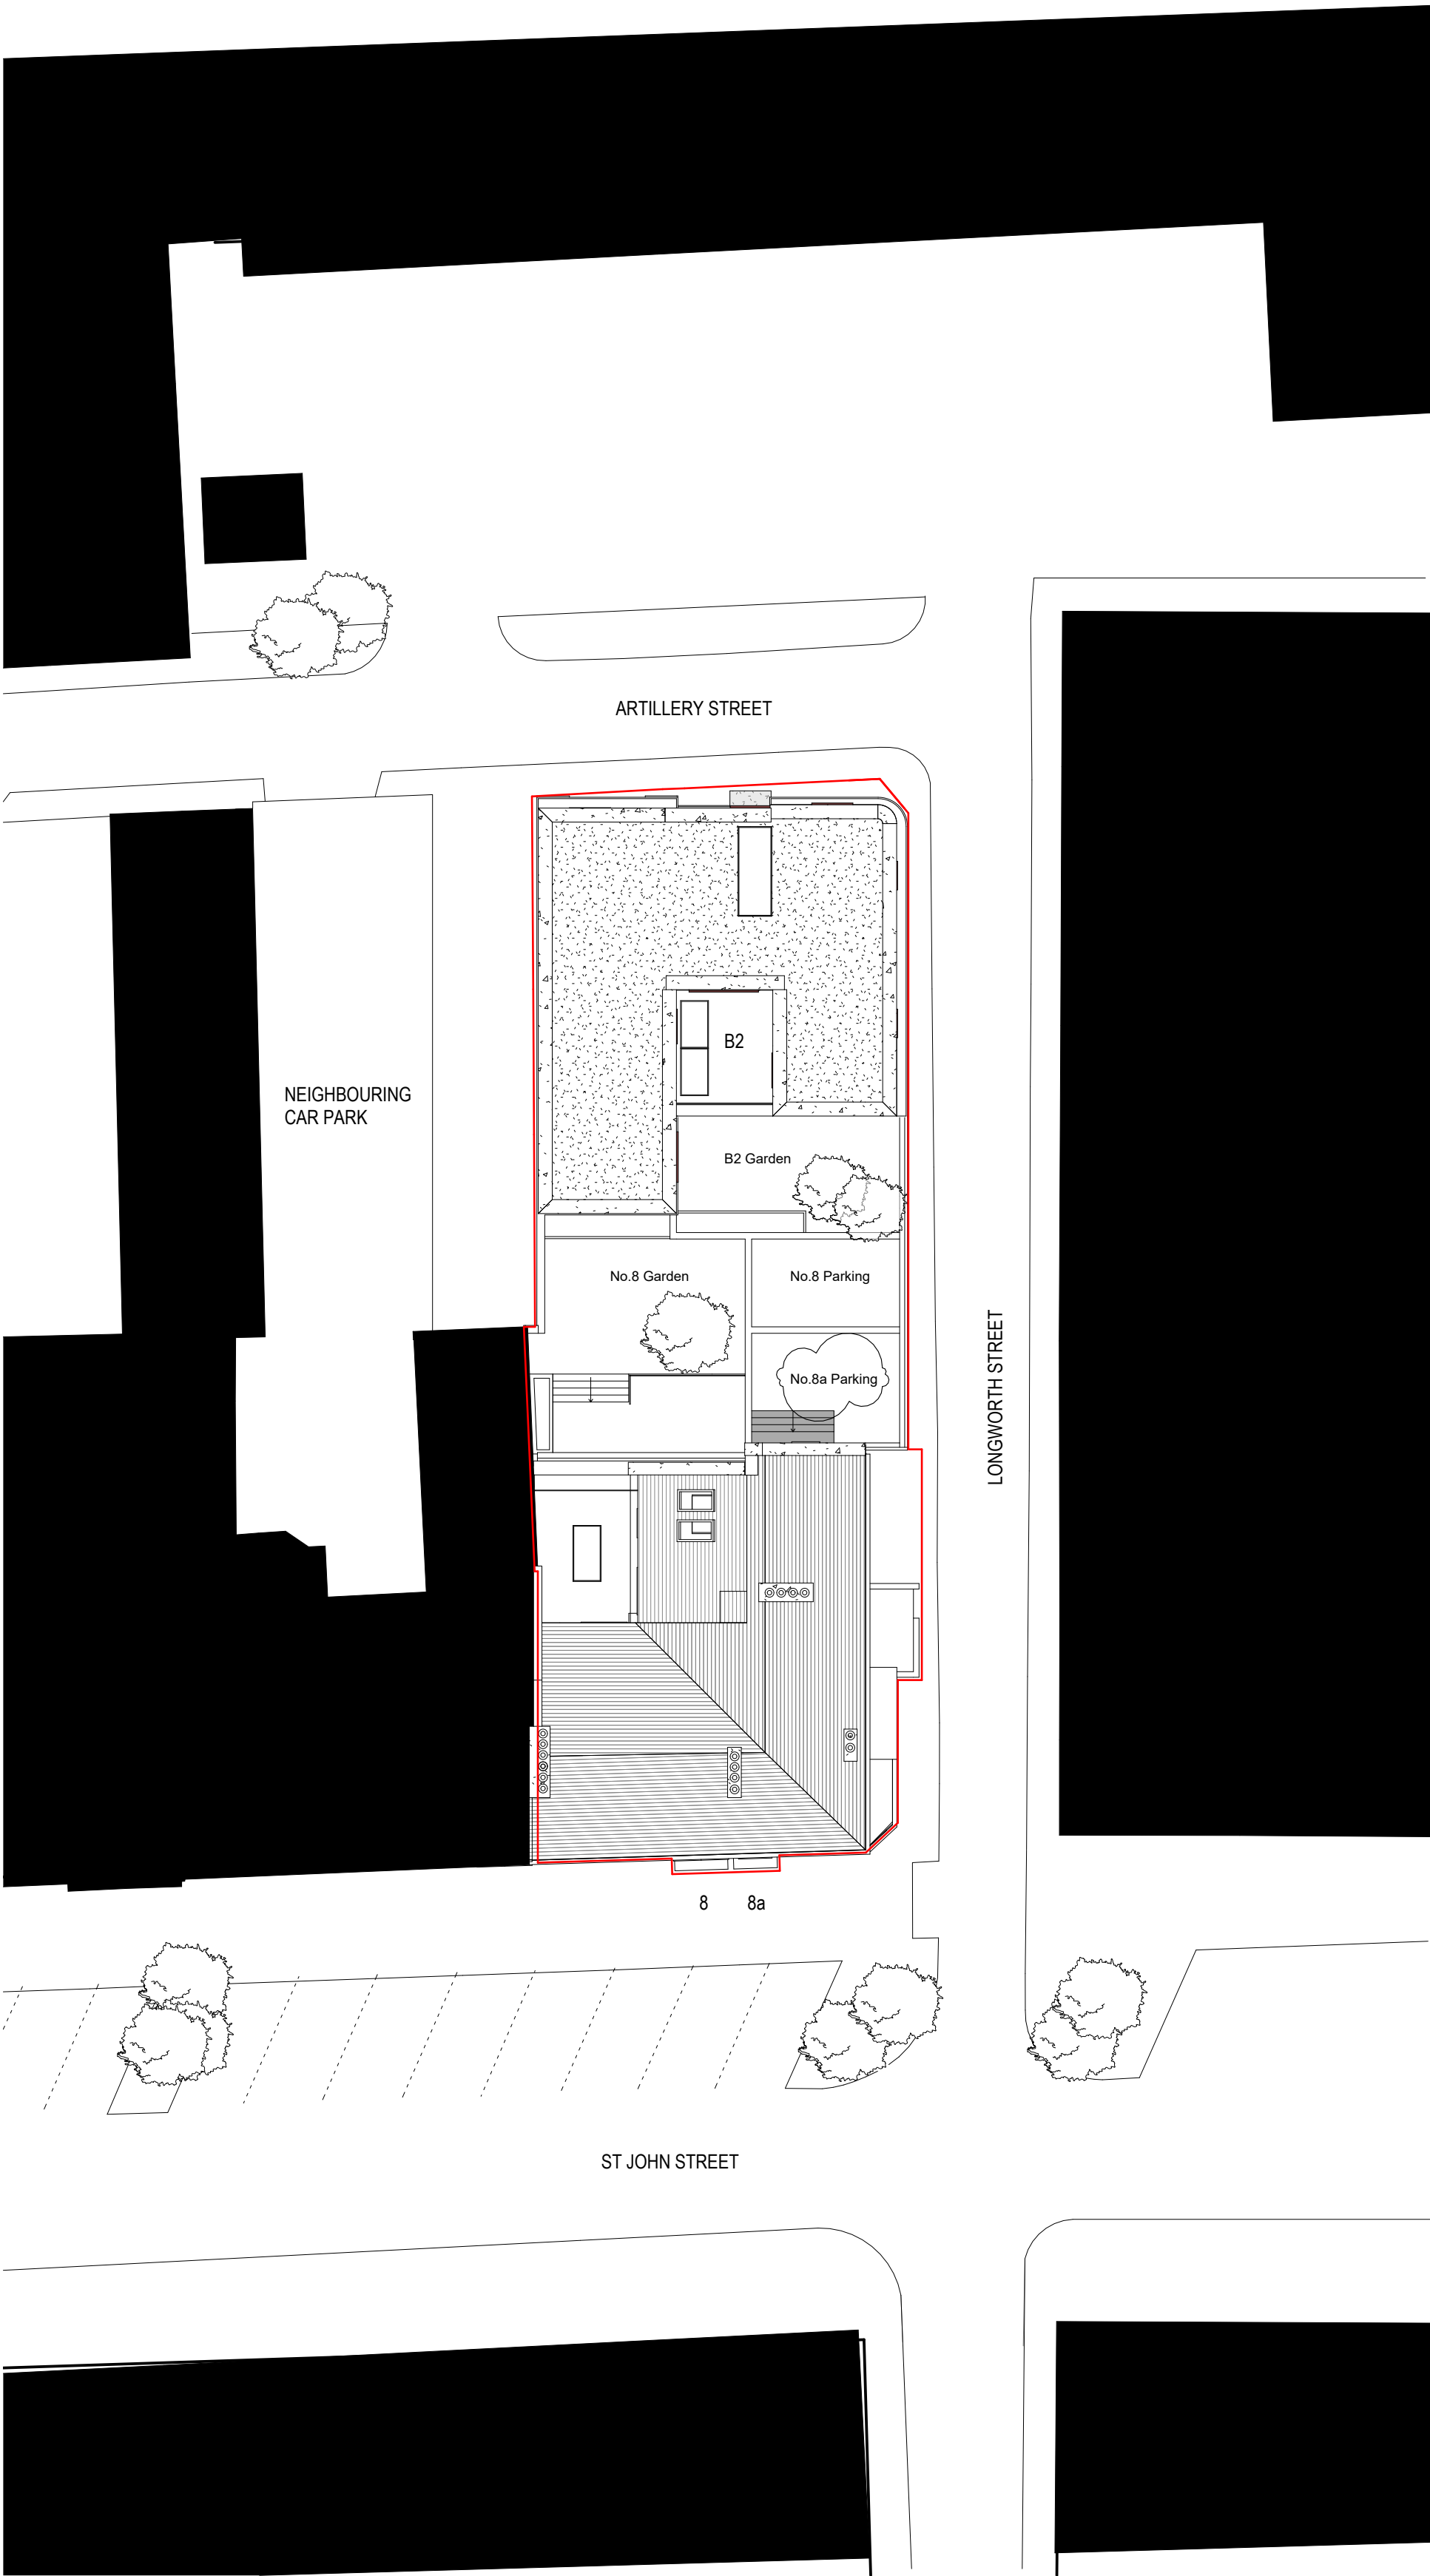

General Notes

Use figured dimensions only. Do not scale off this drawing. All dimensions must be set out and checked by the contractor on site prior to commencement of construction. Any variations between drawings and site must be reported to TGA before work proceeds.


Drawings to be read in conjunction with Architectural Specification, Structural Engineer's Drawings and Specifications, Mechanical & Electrical Engineer's Drawings and Specifications, all Supplemental Information, including but not limited to: Detailed Fire Strategy, Acoustic Report, Thermal Report & Overheating Report.

No portion of the Works to commence without acceptance of the required submittals by the Employer.

Main Contractor to submit relevant documents to building regulation and legislation approval authorities as required to comply with the Specification.

Red Line Boundary

Key Plan

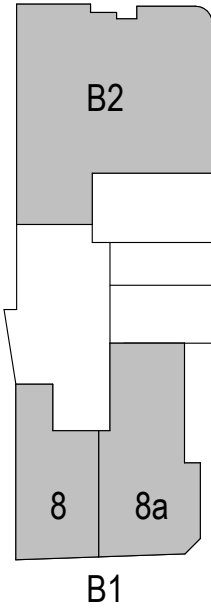

Rev	Description	Date	By
P01	Draft Planning Issue	12.11.24	SD
P02	Draft issue to Design Team	13.12.24	SD
P03	Issue to Design Team	06.01.25	SD
P04	Draft planning issue to DT	03.06.25	SD
P05	Issued for Planning	11.06.25	SD
P06	Parking note added to rear of No.8a as per ground floor plan. Reissued for planning.	07.07.25	SD

Title Proposed Site Plan	
Drawing No. 1084-TGA-ZZ-DR-A-95201	Revision P06
Status Planning	Scale 1 : 200@A1
Project St John Street	Client Mr. Ford

TIM GROOM ARCHITECTS

Eastgate, 2 Castle Street, Manchester, M3 4LZ

0161 870 1152

Copyright © Tim Groom Architects Ltd (TGA). All rights reserved. No part of these drawings or designs may be copied, reproduced or stored in any form without written consent. No works of construction relying on these drawings or designs are permitted without the express written consent of TGA.