

General Notes

The Architect shall have no responsibility for any use made of this document other than for that which it was prepared and issued.

All dimensions should be checked on site. Do not scale from this drawing

To be read in conjunction with all other Consultant's drawings.

The Architect to be immediately notified of any discrepancies.

Copyright on this drawing retained by the Architect.

LEGEND

Site Boundary

P11	01/05/25	AK	SH	Amended Forecourt	
P10	28/04/25	AK	SH	Amended Forecourt	
P9	24/04/25	AK	SH	Amended Forecourt	
P8	14/02/25	AK	SH	Amended Forecourt	
P7	18/10/24	SA	SH	Amended Materials	
P6	22/07/24	AK	SH	Amended Front Forecourt	
P5	05/12/23	AK	SH	Amended Window	
P4	01/12/23	AK	SH	Amended Proposal	
P3	02/10/23	SA	SH	Amended Proposal	
P2	27/09/23	SA	SH	Added Flue on Plans	
P1	07/09/23	AK	SH	Initial Issue	
No.	Date	Dwn	Chk	App	Revision or reason for issue

Client
360 Lounge

createitstudios
... leave an impression


Create It Studios (NW) Ltd
Universal Square
Devonshire Street North
Manchester
M12 6JH
info@createitstudios.co.uk

Project Title
360 Lounge, 54-56 Wilmslow Rd,
Manchester M14 5AL

Scale / North Point
1 : 200

Drawing Title
As-Built Site Plan and 3D View

Drawing Number	Revision
A1514(02)AP001	P11
Drawing Status	
Preliminary	

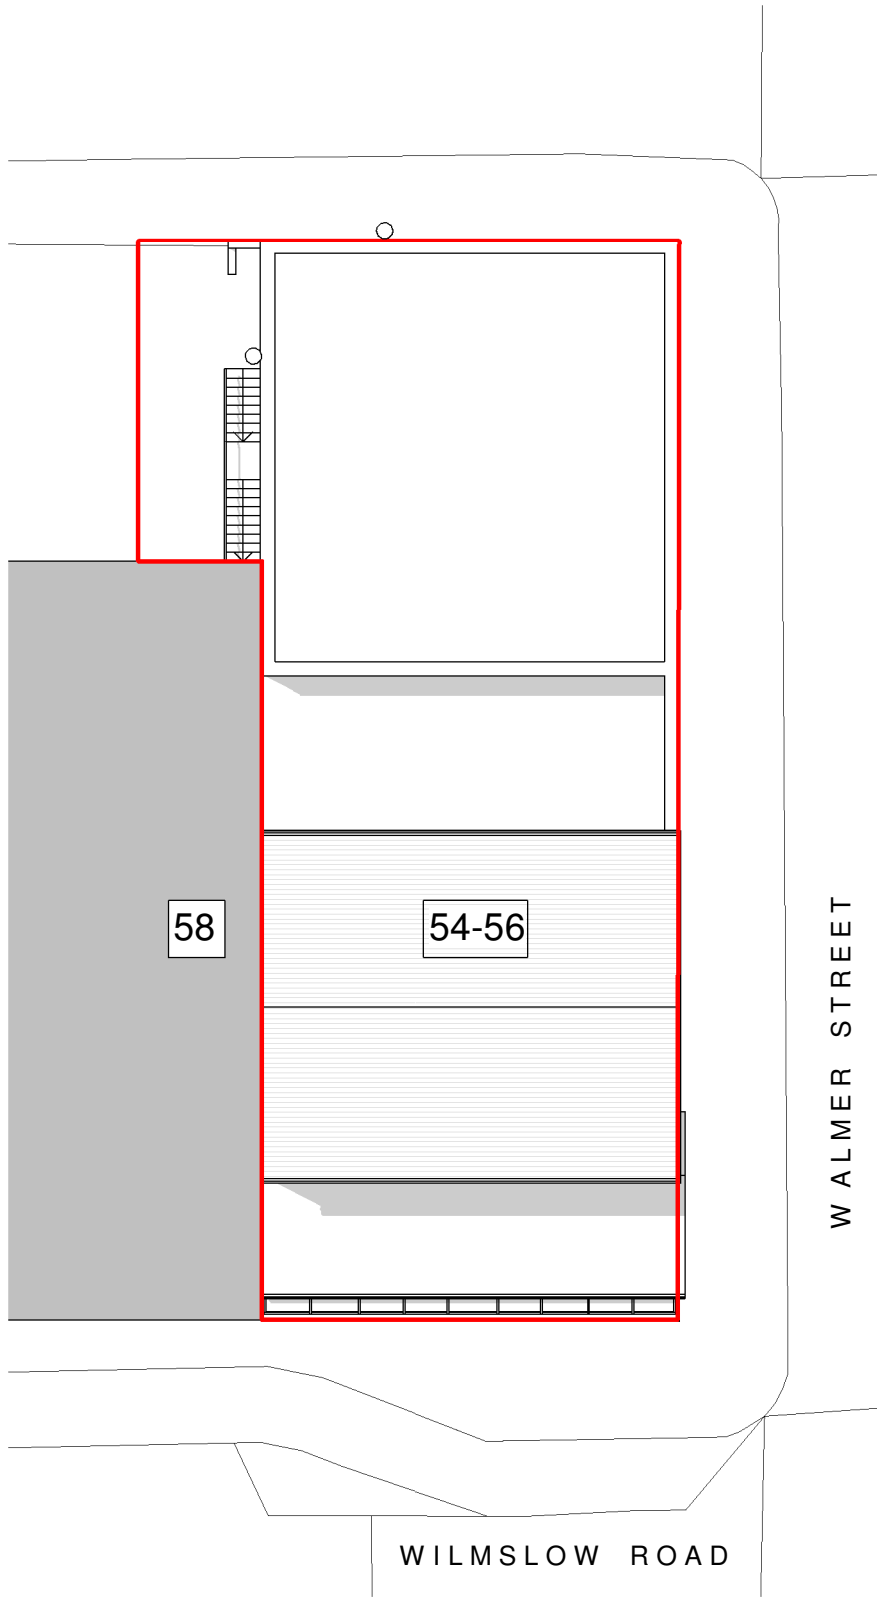

1

As-built Site Plan

1 : 200

2

Front View



3

Rear View

0 2 4 6 8m
1:200