


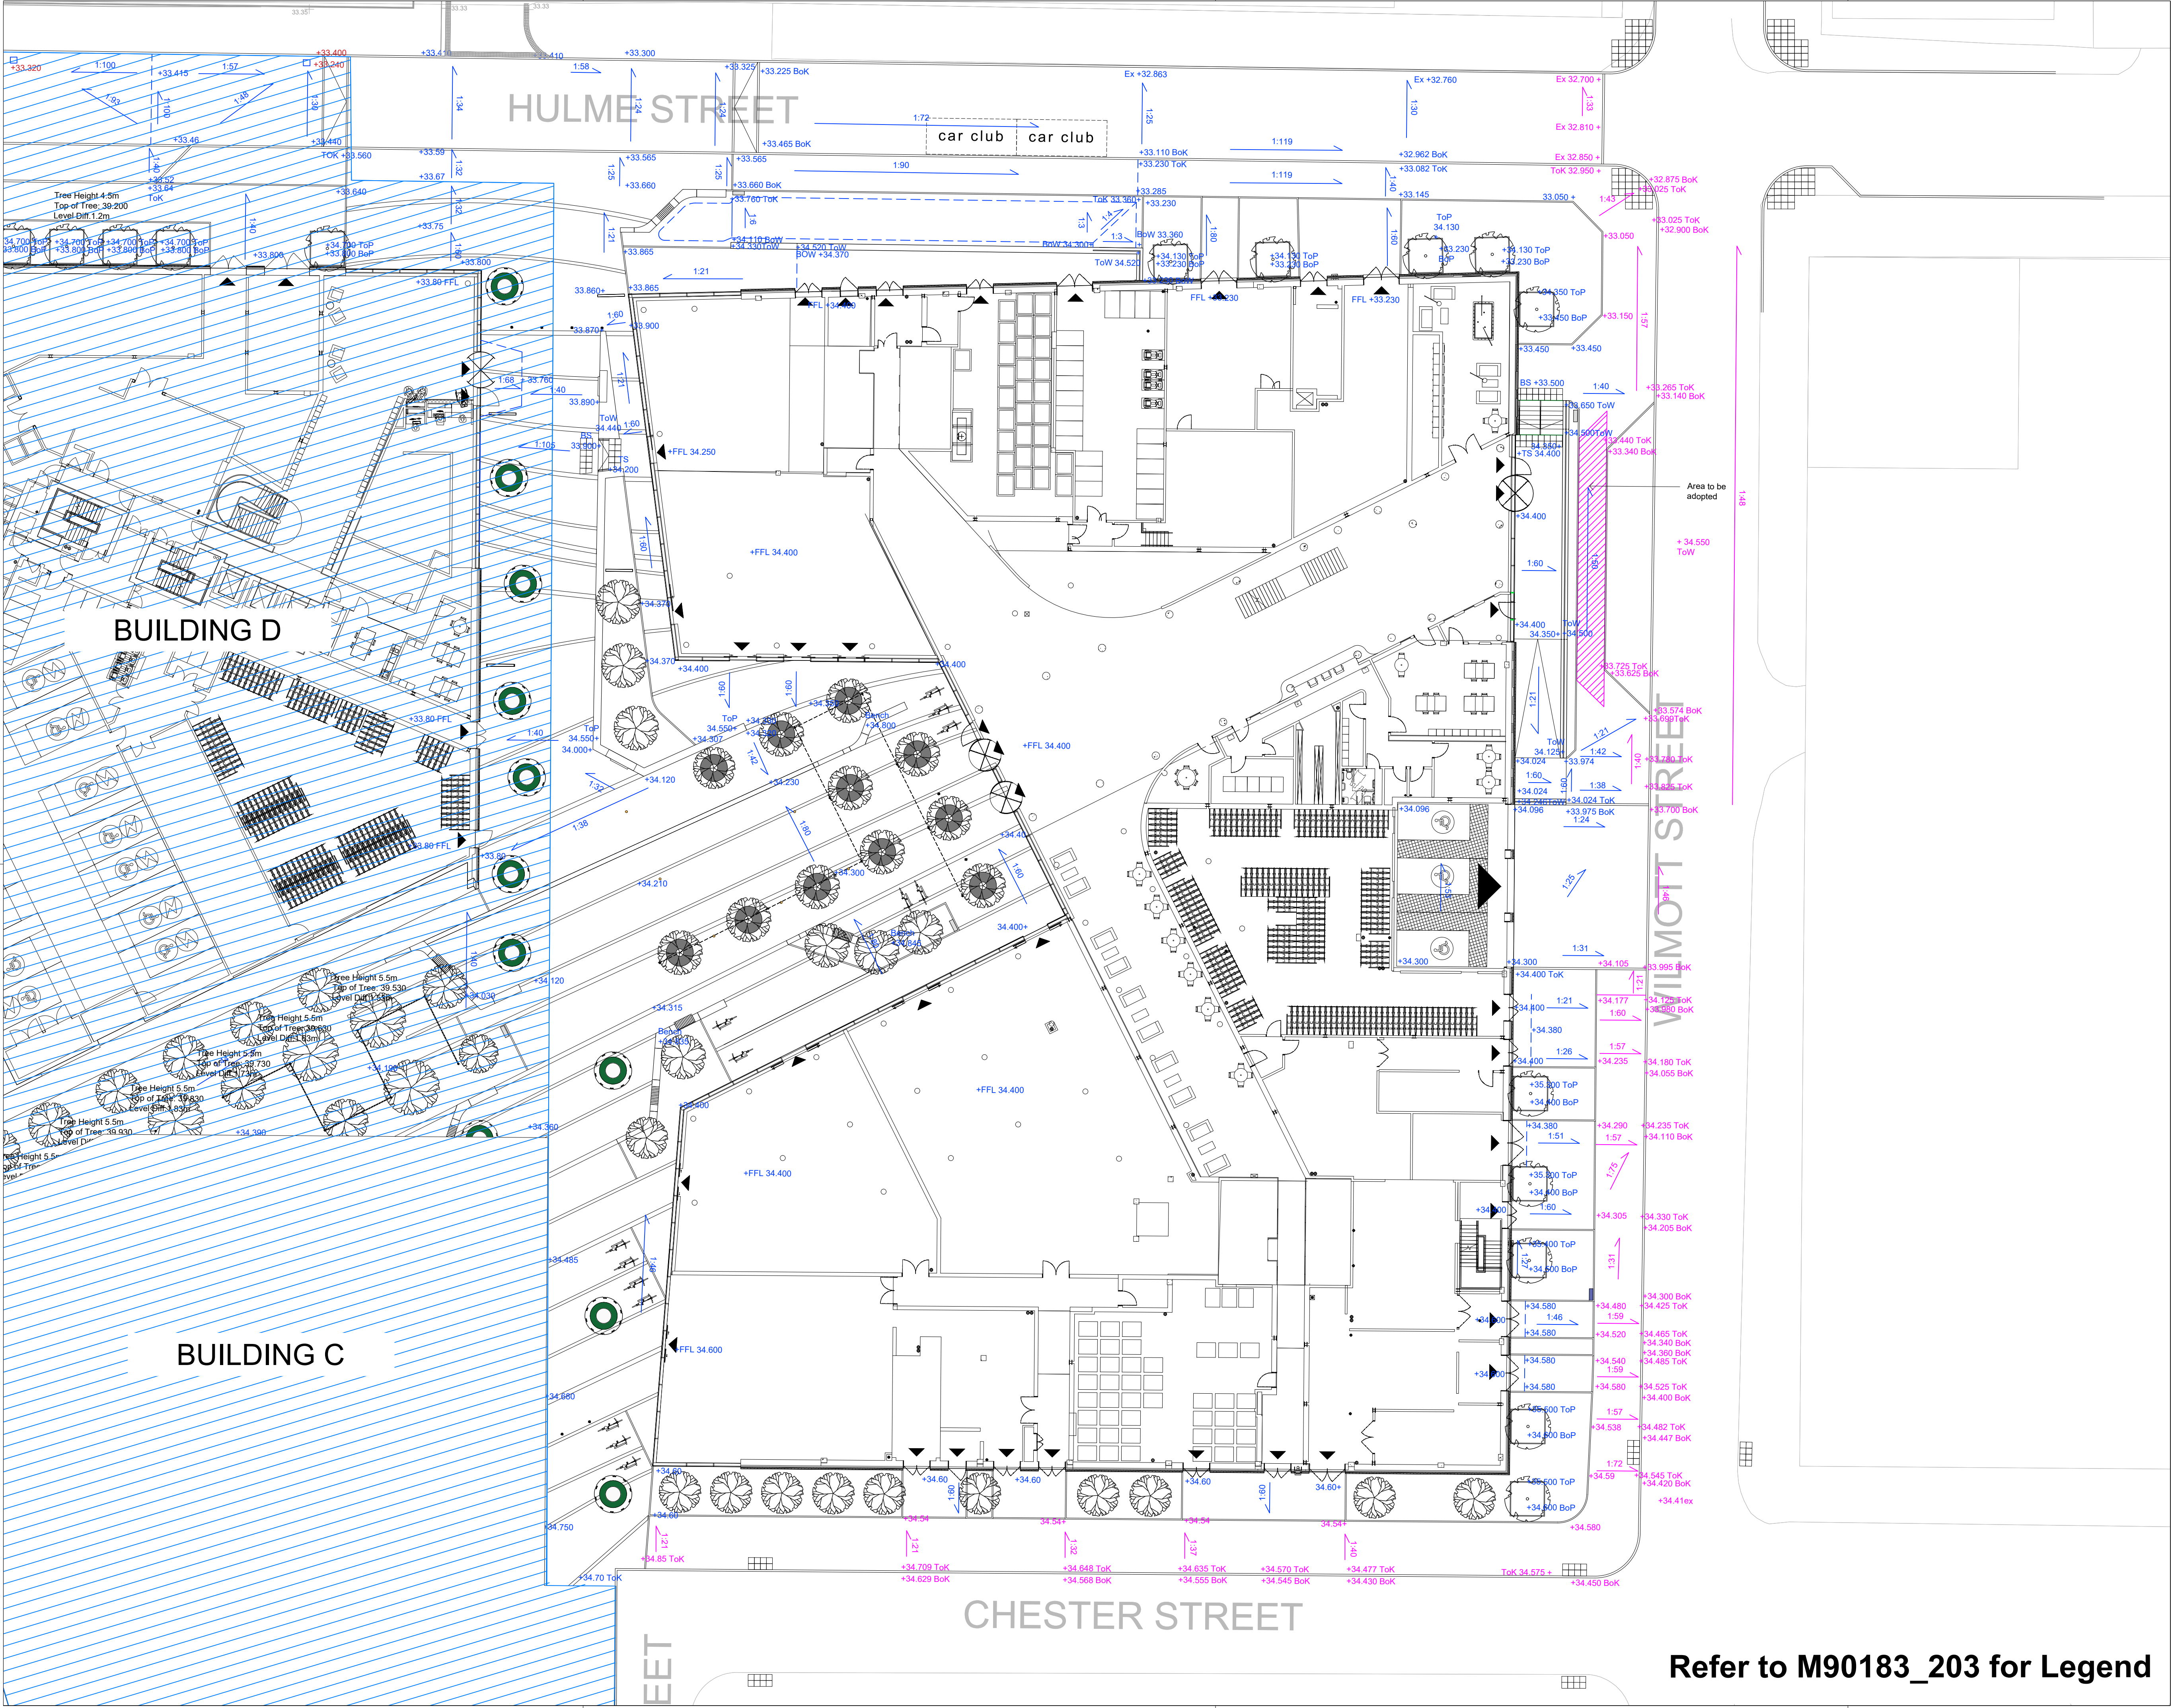

NOTES

- This drawing is to be read in conjunction with all other drawings and specifications.
- Do not scale off this drawing. Written dimensions to be taken only.
- Any discrepancies found between this drawing and other drawings and specifications in the construction documents must be referred to the Landscape Architect prior to work commencing.
- This drawing must not be copied in whole or in part without prior written consent of Optimised Environments Ltd.
- Survey information is based upon aspect surveys Topographical as Survey.

CDM INFORMATION

KEY PLAN

16	AS BUILT	CO	06.03.25
15	FINAL CONSTRUCTION	CO	28.02.25
14	INDICATIVE GULLIES OMITTED	CO	30.08.24
13	GF UPDATES	AH	14.08.24
12	BOLLARDS ADDED	SB	17.05.24
11	TOW REVISED	CO	03.04.24
10	FULL GF PACK ISSUE	AH	04.03.24
09	REVISED ADOPTED PAVING AND LEVEL	SB	26.02.24
08	ADDITIONAL REQUESTED LEVELS	AH	24.02.23
07	REINSTATED TREES	SB	23.08.23
06	REVISED LAYOUTS AND LEVELS	SB	03.08.23
05	REVISED LAYOUTS AND LEVELS	CO	19.08.23
04	REVISED ENTRANCES	CO	27.04.23
03	GF Architectural Update	CO	18.01.22
02	Hulme Street Levels	CO	31.10.22
A	STAGE 4		
Issue	Revision	Initial	Date

Client

Downing Living (Manchester) Ltd

Project

PLOT 11 FIRST STREET SOUTH

Manchester

Drawing Title

BUILDING A-B

PUBLIC REALM LEVELS & GRADES

Sheet 1 of 2

Scale Bar

2m 4m 6m 8m 10m

North

Scale: 1:200@A1 Date: Jan 2022

By: CO Status: AS BUILT

Checked: AW Approved: AW

Drawing Number

M90183_AB_L600

Rev

16

Computer File: R:\Projects\2019\M90183_First\SCAD\AUTOCAD\SHEETS\PHASE AB

Refer to M90183_203 for Legend