




NOTES

ORIGINAL A4

DO NOT SCALE FROM THIS DRAWING.
ALL DIMENSIONS TO BE CHECKED ON SITE.
97.8m

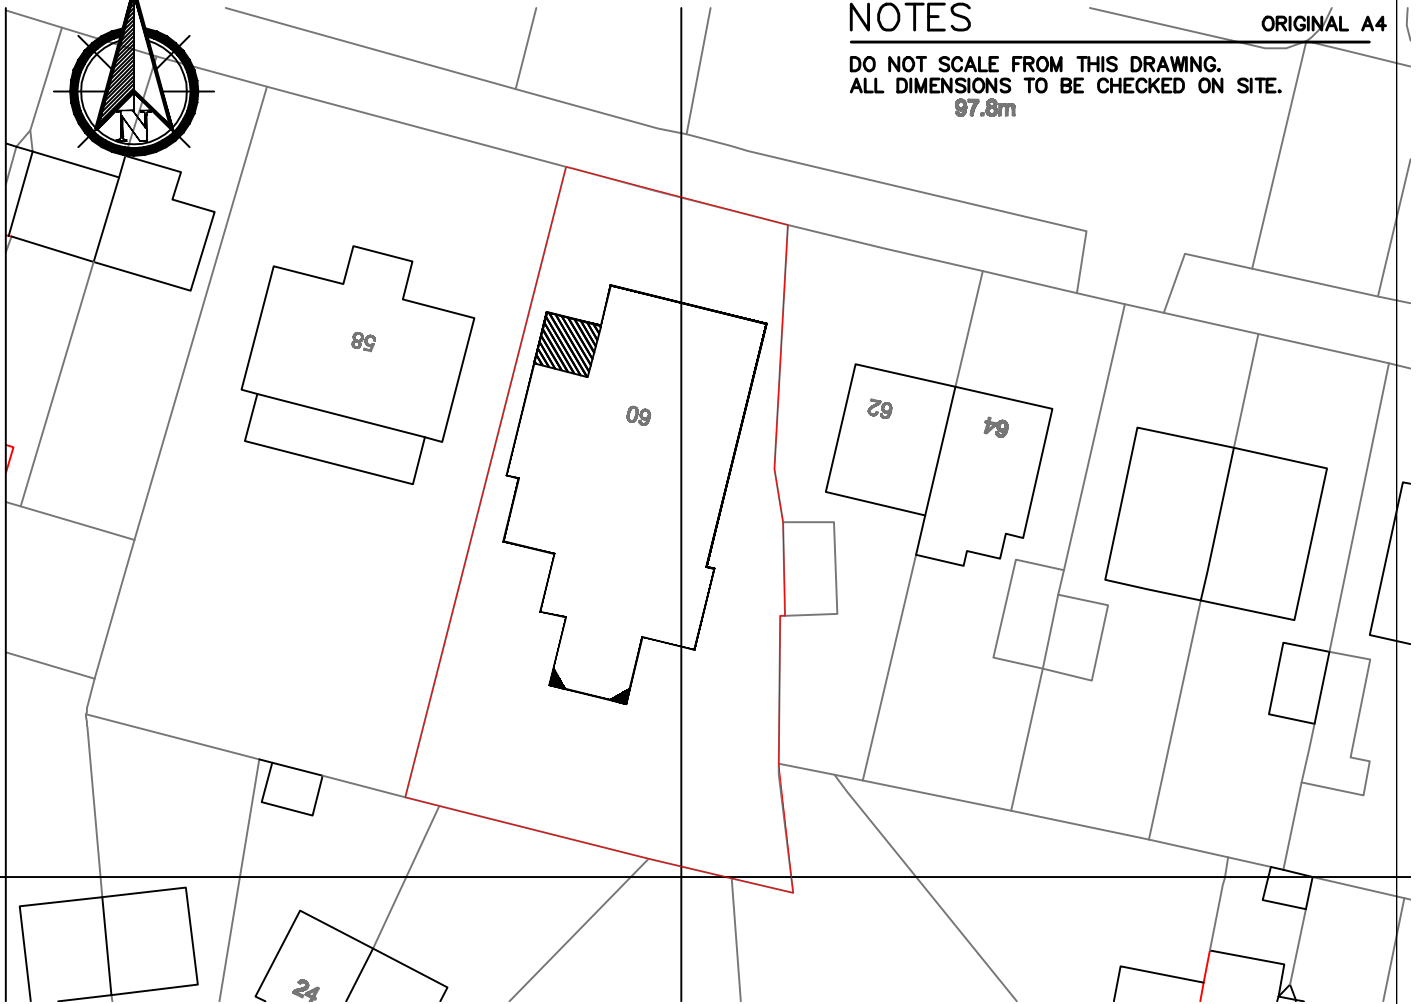


SITE PLAN 1:500



LOCATION PLAN 1:1250

SCALE BAR 1:1250

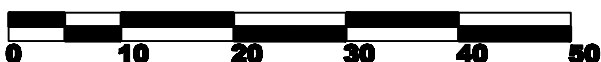

REVISIONS

SCALE	DATE	DRAWN	CHECKED
1/500	MAY 25		
1/1250			

CLIENT

VESTACARE

TITLE

60 VICTORIA AVENUE EAST
BLACKLEY, MANCHESTER

LOCATION PLAN
AS BUILT PLAN

M9 6HB

DRAWING No.

0.17