

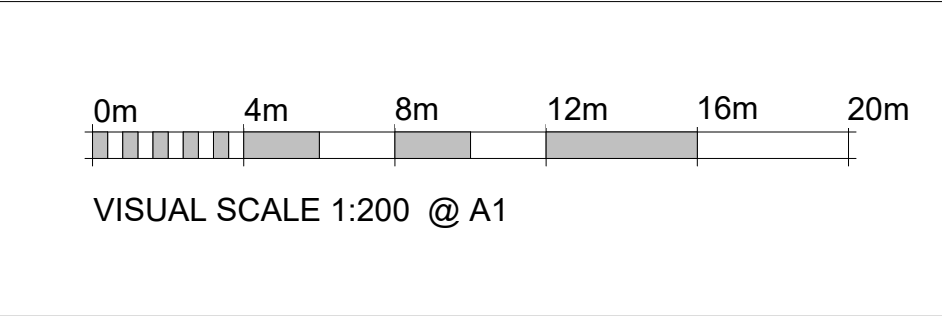


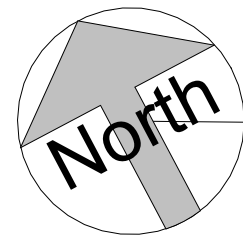

COPYRIGHT © ALL RIGHTS RESERVED BY VIKAS ALYAS LTD. DO NOT SCALE FROM DRAWING. DRAWING INDICATES DESIGN INTENT ONLY. REPORT ANY DISCREPANCIES TO CLIENT / VA LTD. NOT TO BE USED FOR CONSTRUCTION UNLESS STATED SO. TO BE READ IN CONJUNCTION WITH OTHER DRAWINGS OR SPECIFICATION WHERE PROVIDED.

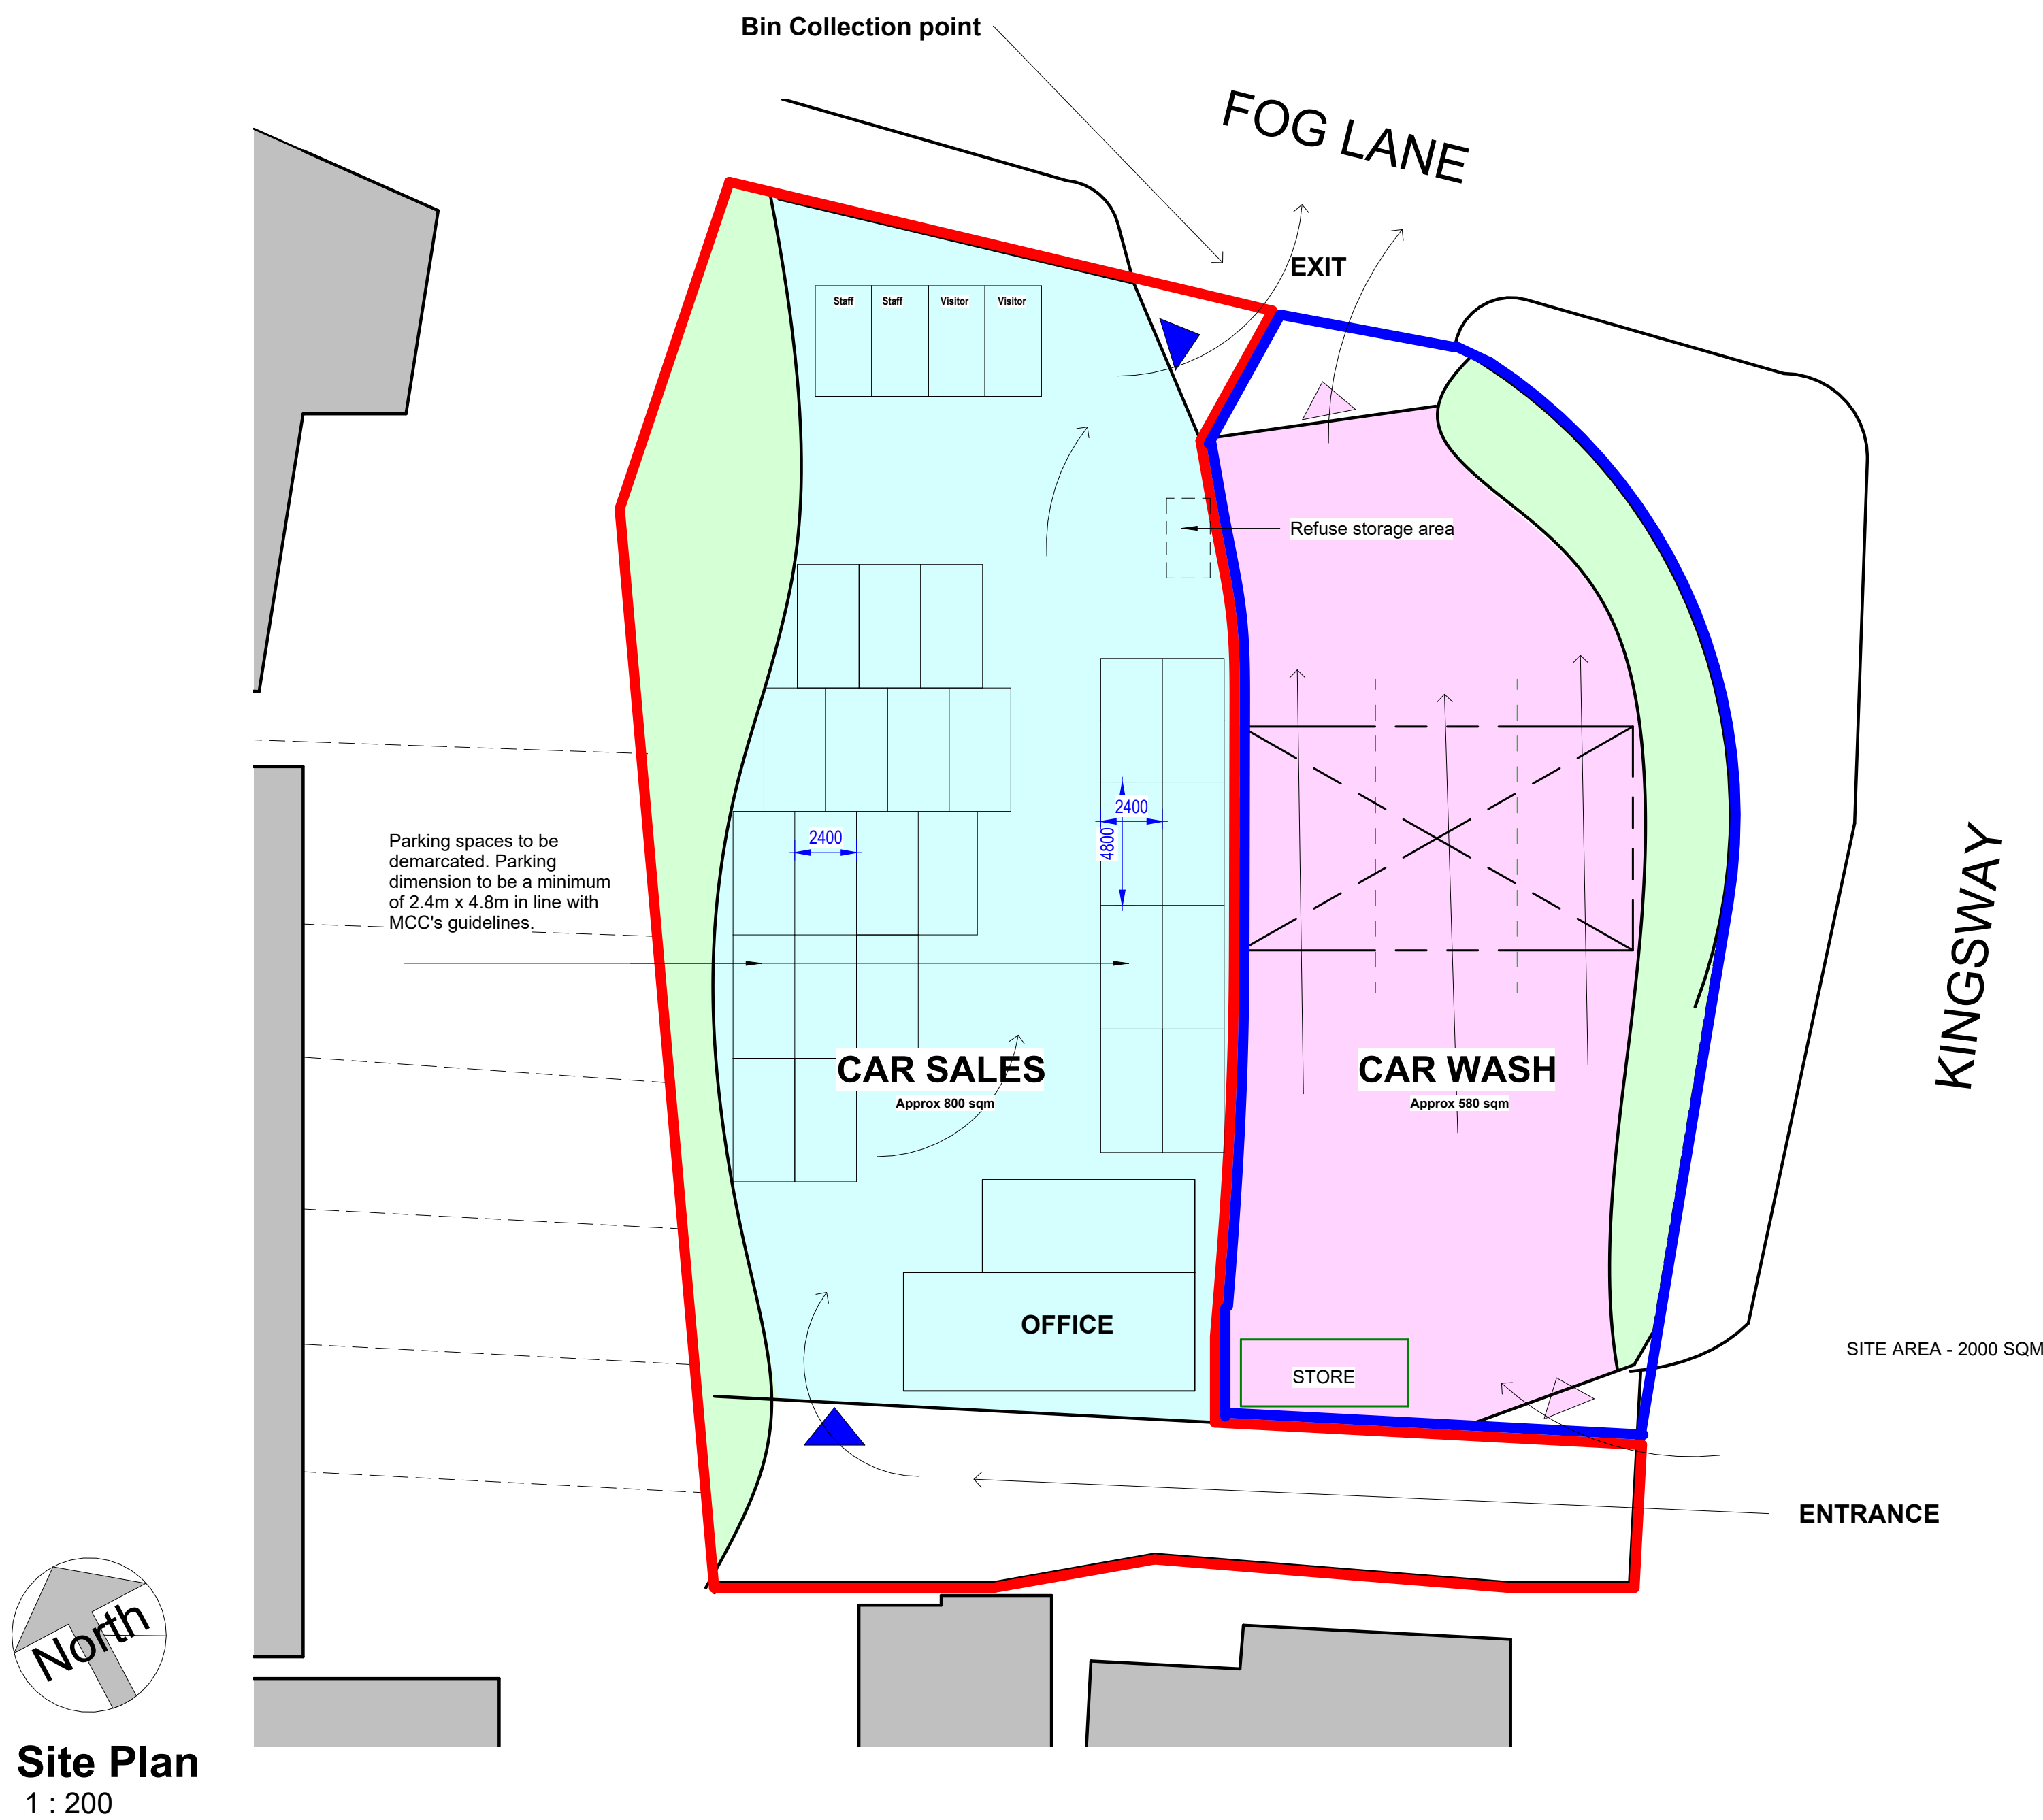

Site Plan
1 : 200

ARCHITEK
BUILDING DESIGN CONSULTANCY

0161 511 8479

vikas@architek.uk
916 Stockport Road, Levenshulme,
Manchester, M19 3AB

Rev	Description	Date
P1	Issue to Planning	06.03.2025
P2	Updates to planners/highways comments	09.06.2025

CLIENT
Shazaib Hussain

PURPOSE OF ISSUE
Planning

Manchester City Council

ADDRESS
370 Kingsway Manchester M19 1PL

PROJECT
Retrospective application to use part of the site for car sales.

TITLE
Asbuilt and Proposed Site Plan

DRAWN BY VA	CHECKED BY VA	DATE 29.05.2024
SCALE (@ A1) 1 : 200		PROJECT NUMBER Project Number
DRAWING NUMBER A101		REV P2