
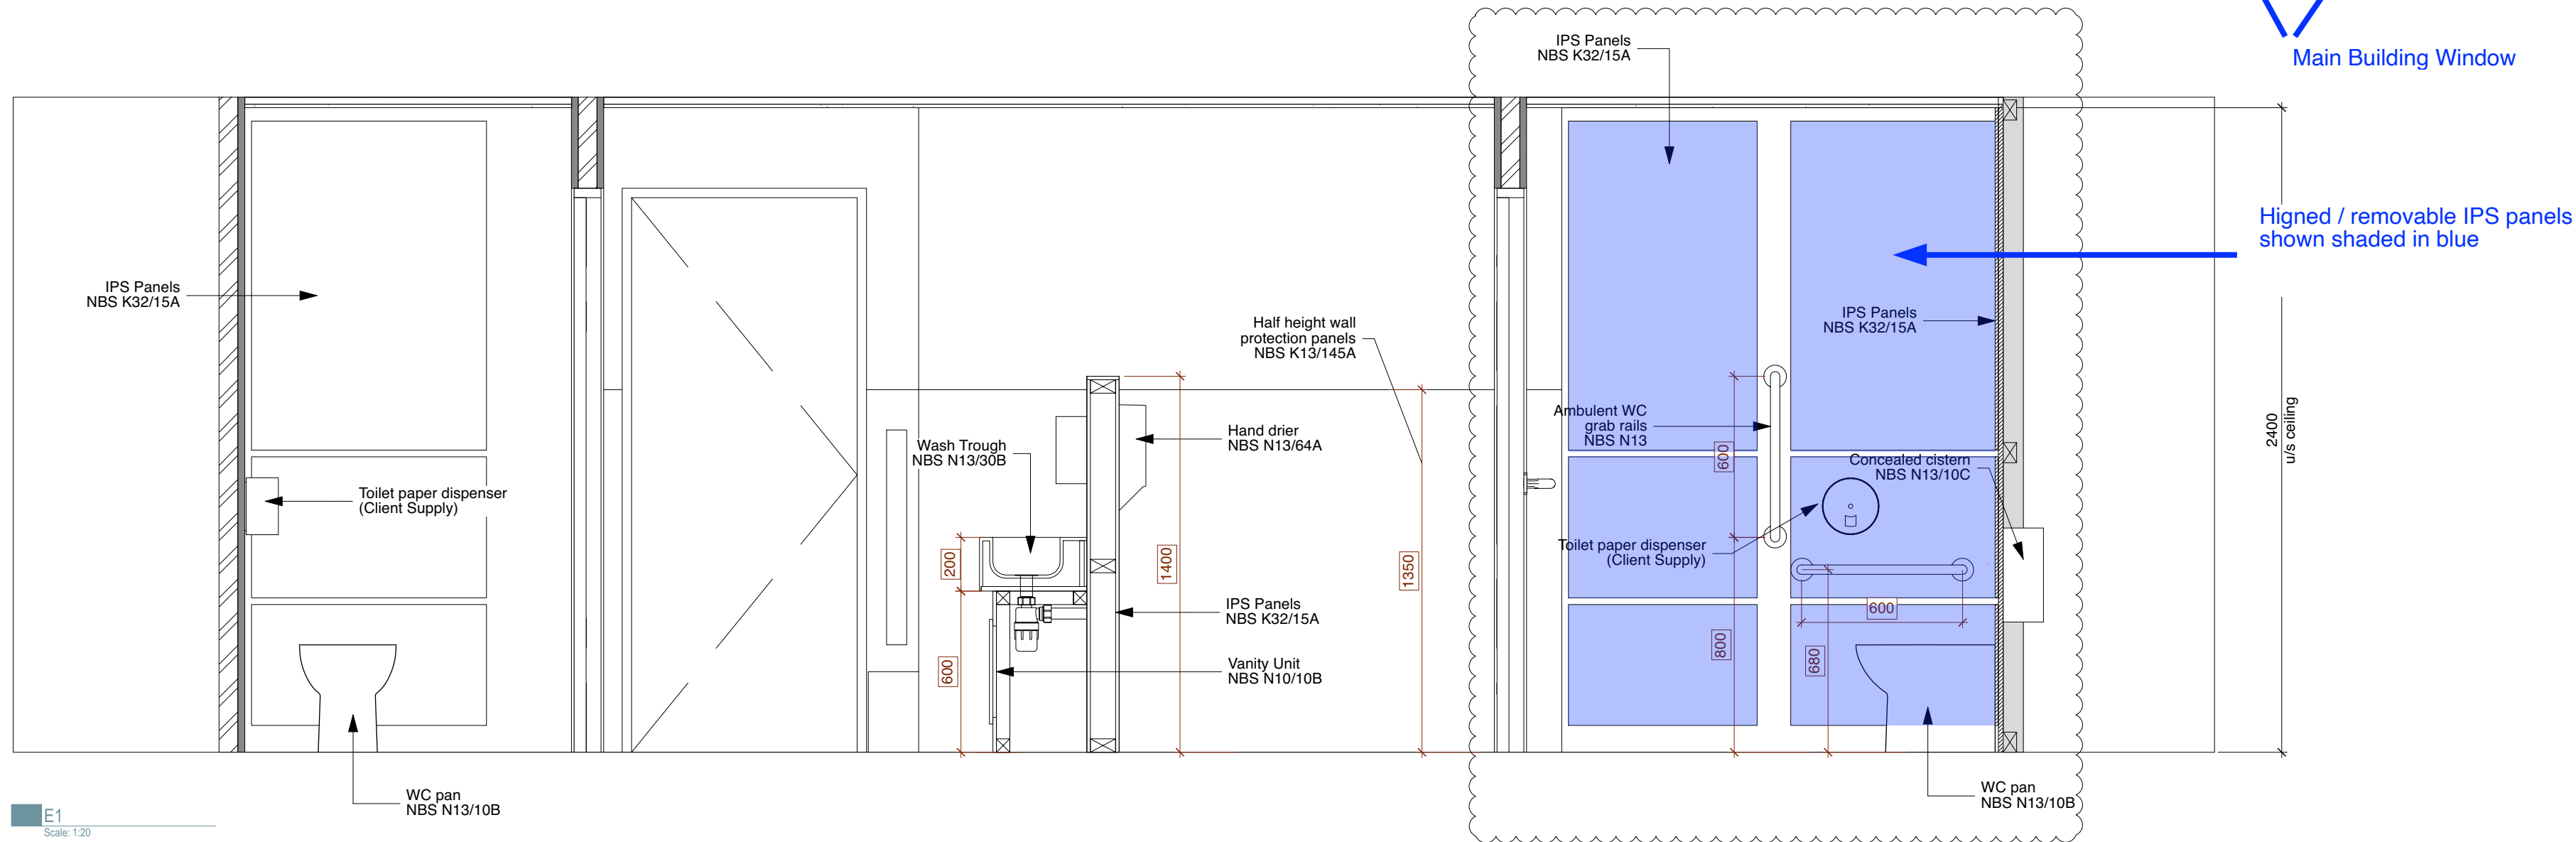


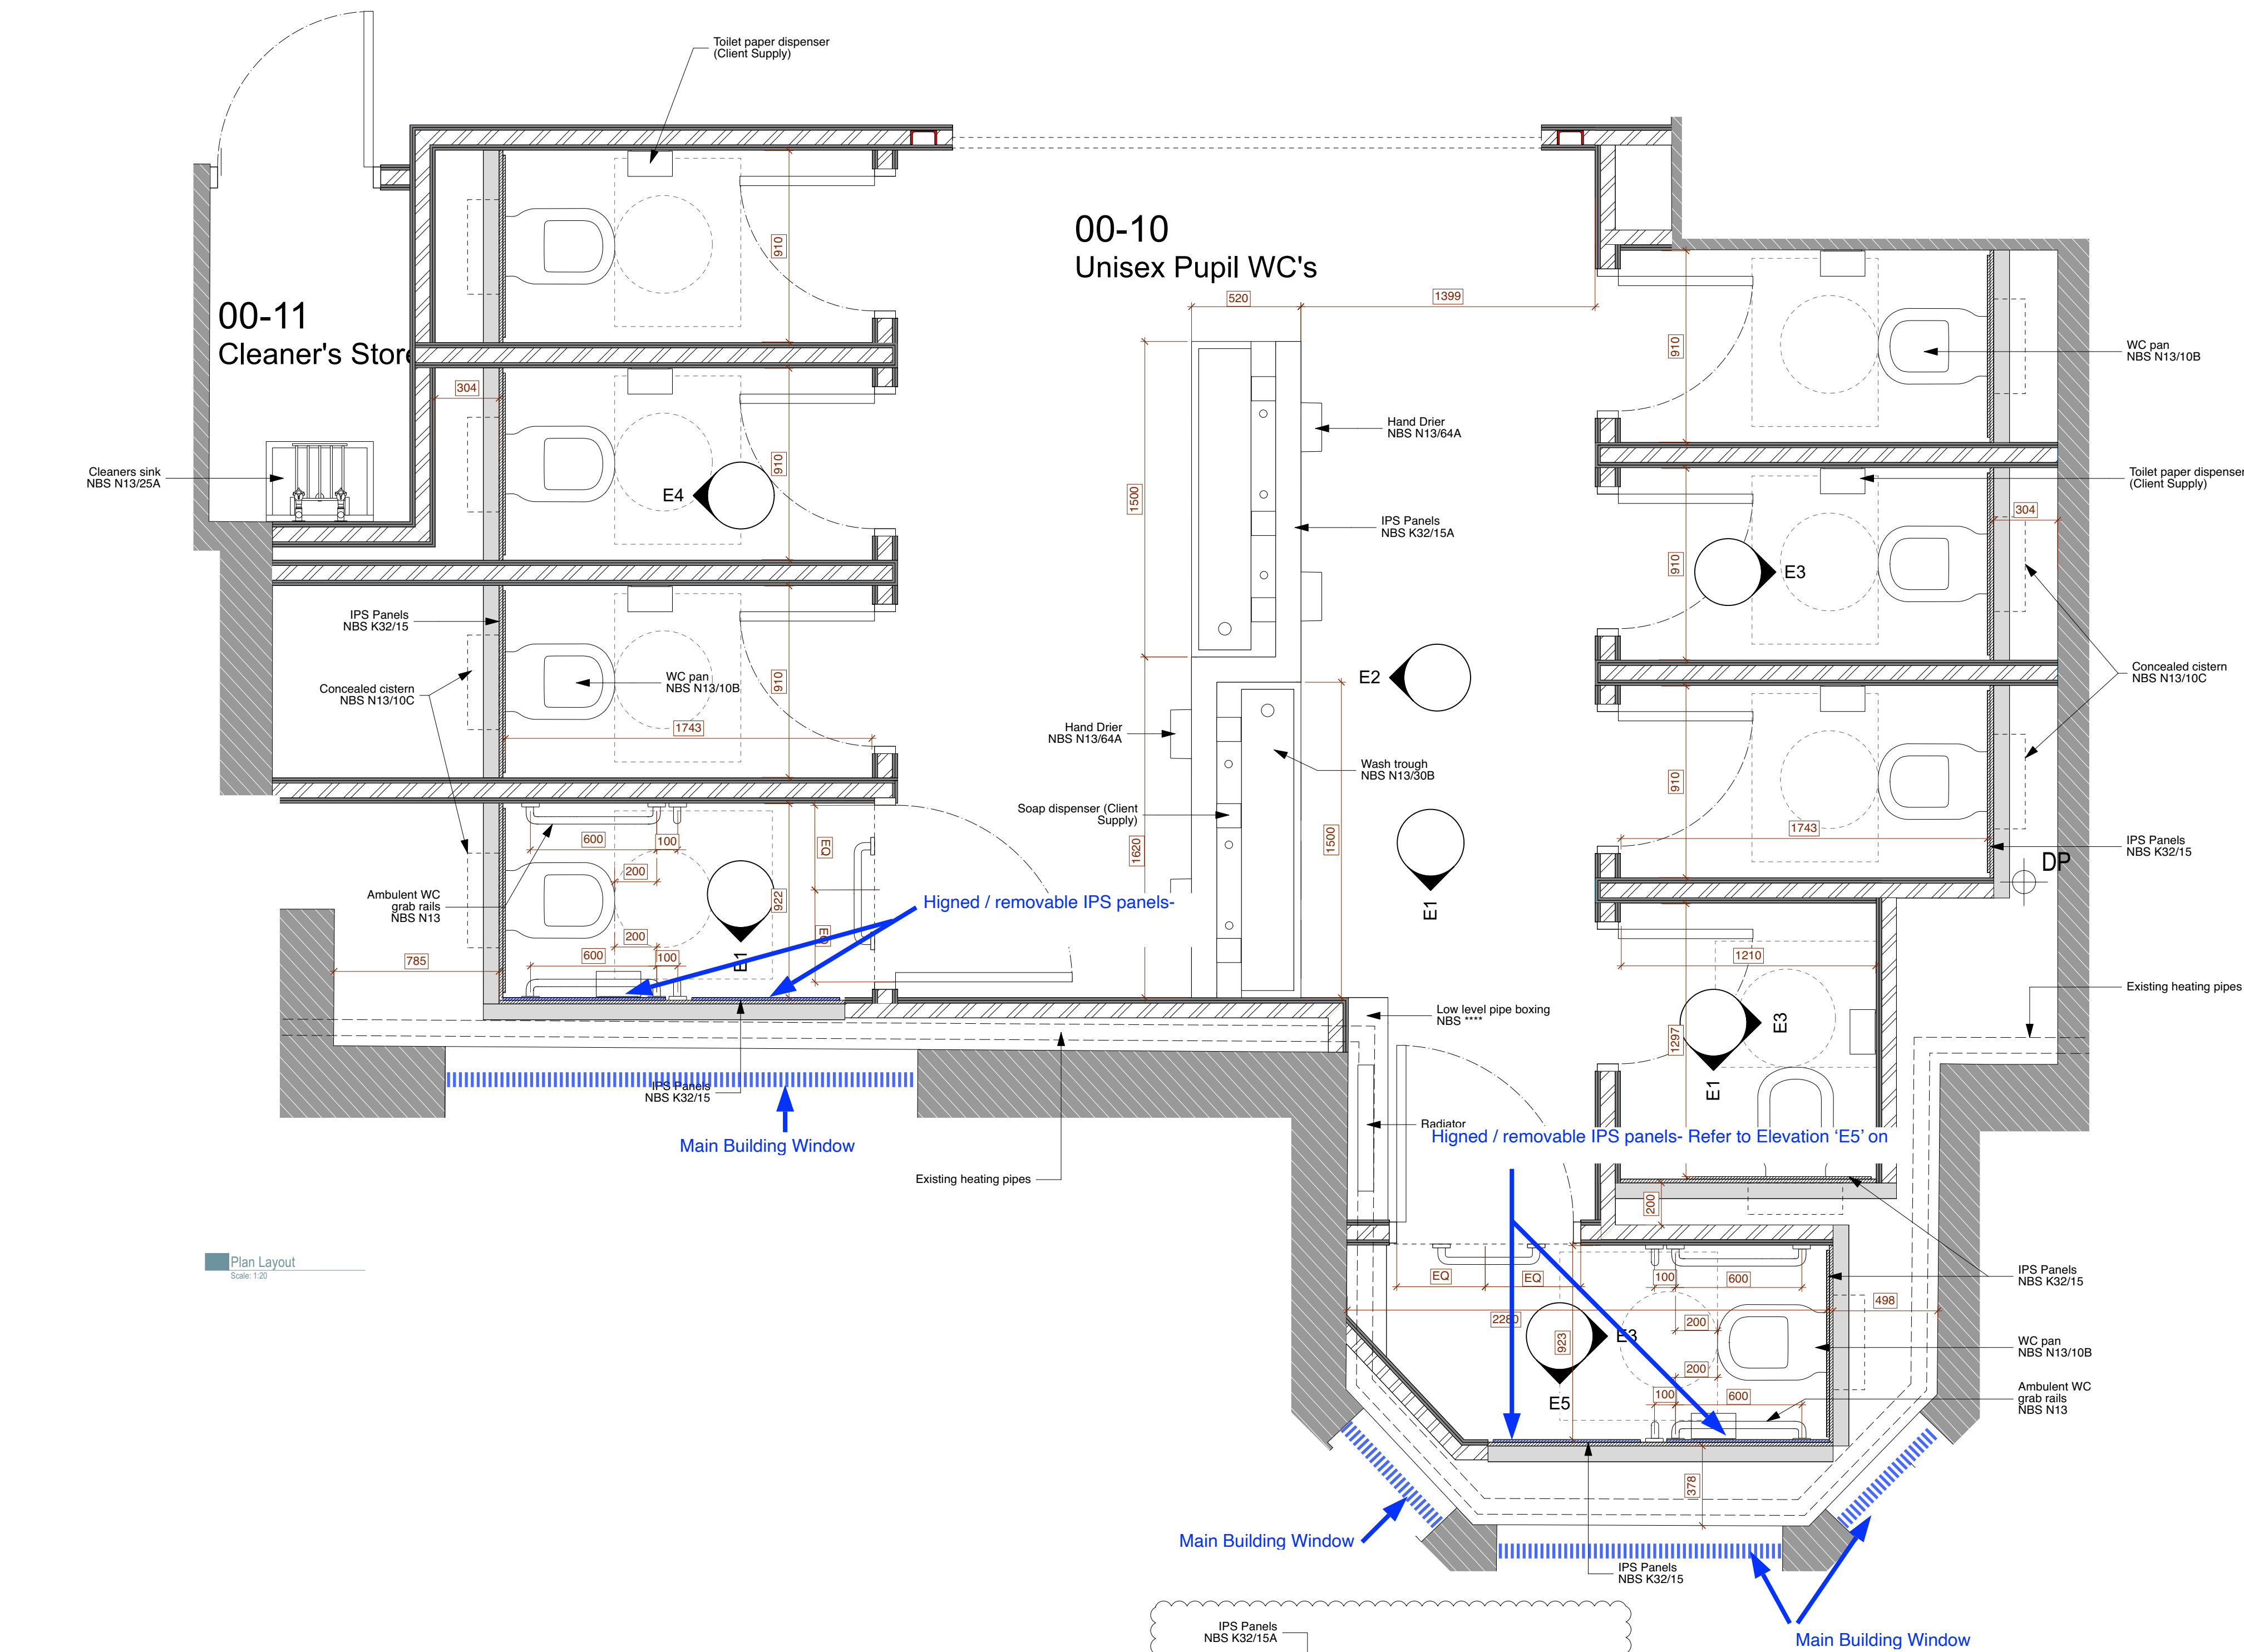

NOTES

 INDICATES A RESIDUAL RISK AS A WARNING.
REFER TO HIRP

TOILET FITTINGS & CUBICLES

SETTING-OUT

 DENOTES 'FINISHED' DIMENSION

ALL SETTING-OUT DIMENSIONS TO FITTINGS (WC / WHB / URINAL ETC)
ARE FROM FINISHED WALL FACE TO CENTRE OF FITTINGS, UNLESS
NOTED OTHERWISE. ALLOWANCE FOR 2.5mm NOMINAL WALL
PROTECTION PANELS WHERE NOTED.

ALL WC PANS SET-OUT CENTRAL TO CUBICLE WIDTH UNLESS NOTED
OTHERWISE.

CUBICLES INCL. DOOR SIZES & OPENING

MAX 5mm GAP TO TOP & BOTTOM OF DOORS TO PUPIL CUBICLES
CUBICLE DOOR CLEAR WIDTHS GENERALLY: 650mm WIDE
CUBICLE DOOR CLEAR WIDTHS AMBULANT: 750mm WIDE
STAFF WC'S CUBICLE DOORS (ROOMS 00-7, 00-8): DOORS FALL CLOSED
PUPIL WC'S CUBICLE DOORS (ROOMS 00-1, 00-10): DOORS FALL OPEN

PATTESSING

PATTESSING TO PARTITIONS TO ALL FITTINGS

PARTITIONS, FLOOR FINISHES & CEILINGS

REFER TO GA PLANS FOR PARTITION SYSTEMS AND UNICLASS Ss_25_12_65
REFER TO FLOOR COVERING & FINISHING SYSTEMS UNICLASS Ss_30_42
REFER TO CEILING & SOFFIT SYSTEMS UNICLASS Ss_30_25

WALL PROTECTION PANELS

REQUIRED TO THE FOLLOWING NON-IPS/CUBICLE WALLS:
STAFF WC'S (ROOMS 00-7, 00-8): NOT REQUIRED
PUPIL WC'S (ROOMS 00-1, 00-10): WITHIN CUBICLES TO BE FULL HEIGHT
COMMUNAL AREAS HALF-HEIGHT (1350MM)

ACCESSIBLE WC (ROOM 00-2): FULL HEIGHT
WALL PROTECTION PANELS K13/145A

CoARC Markup
7 Jul 2025

P02 12/04/2025 IPS updated. Dims added (not clouded).
P01 10/04/2025 First issue.

CoARC
COLLABORATIVE ARCHITECTURE

coarc.co.uk 0121 769 2414 studio@coarc.co.uk

project title
WC Provision

client
United Learning

project address
William Hulme's Grammar School WC Provision

drawing title
Toilet Layout Room 00-10 Pupil WC's and 00-11 Cleaners St

PRELIMINARY

scale
1:20 @A1

date
24/03/2025

drawing no.
WHGS1-COA-SL_35_80-ZZ-D-A-0904

revision
P02

drawing no. 001 (project)
PROJECT ORIGINATOR-FUNCTIONAL BREAKDOWN-SPATIAL BREAKDOWN-FORMA-DISCIPLINE-NUMBER

All dimensions to be checked & verified on site. Dimensions structural unless noted otherwise. Drawings to be read in conjunction with specification. Any bracketed dimensions are for checking and not for setting out purposes. Any discrepancies with other project information, existing building or site features are to be reported to the Architect before commencement. Do not scale from printed drawings without checking with the architect. © CoARC Ltd. The contents of this drawing may not be reproduced in whole or in part without express permission of CoARC Ltd.