



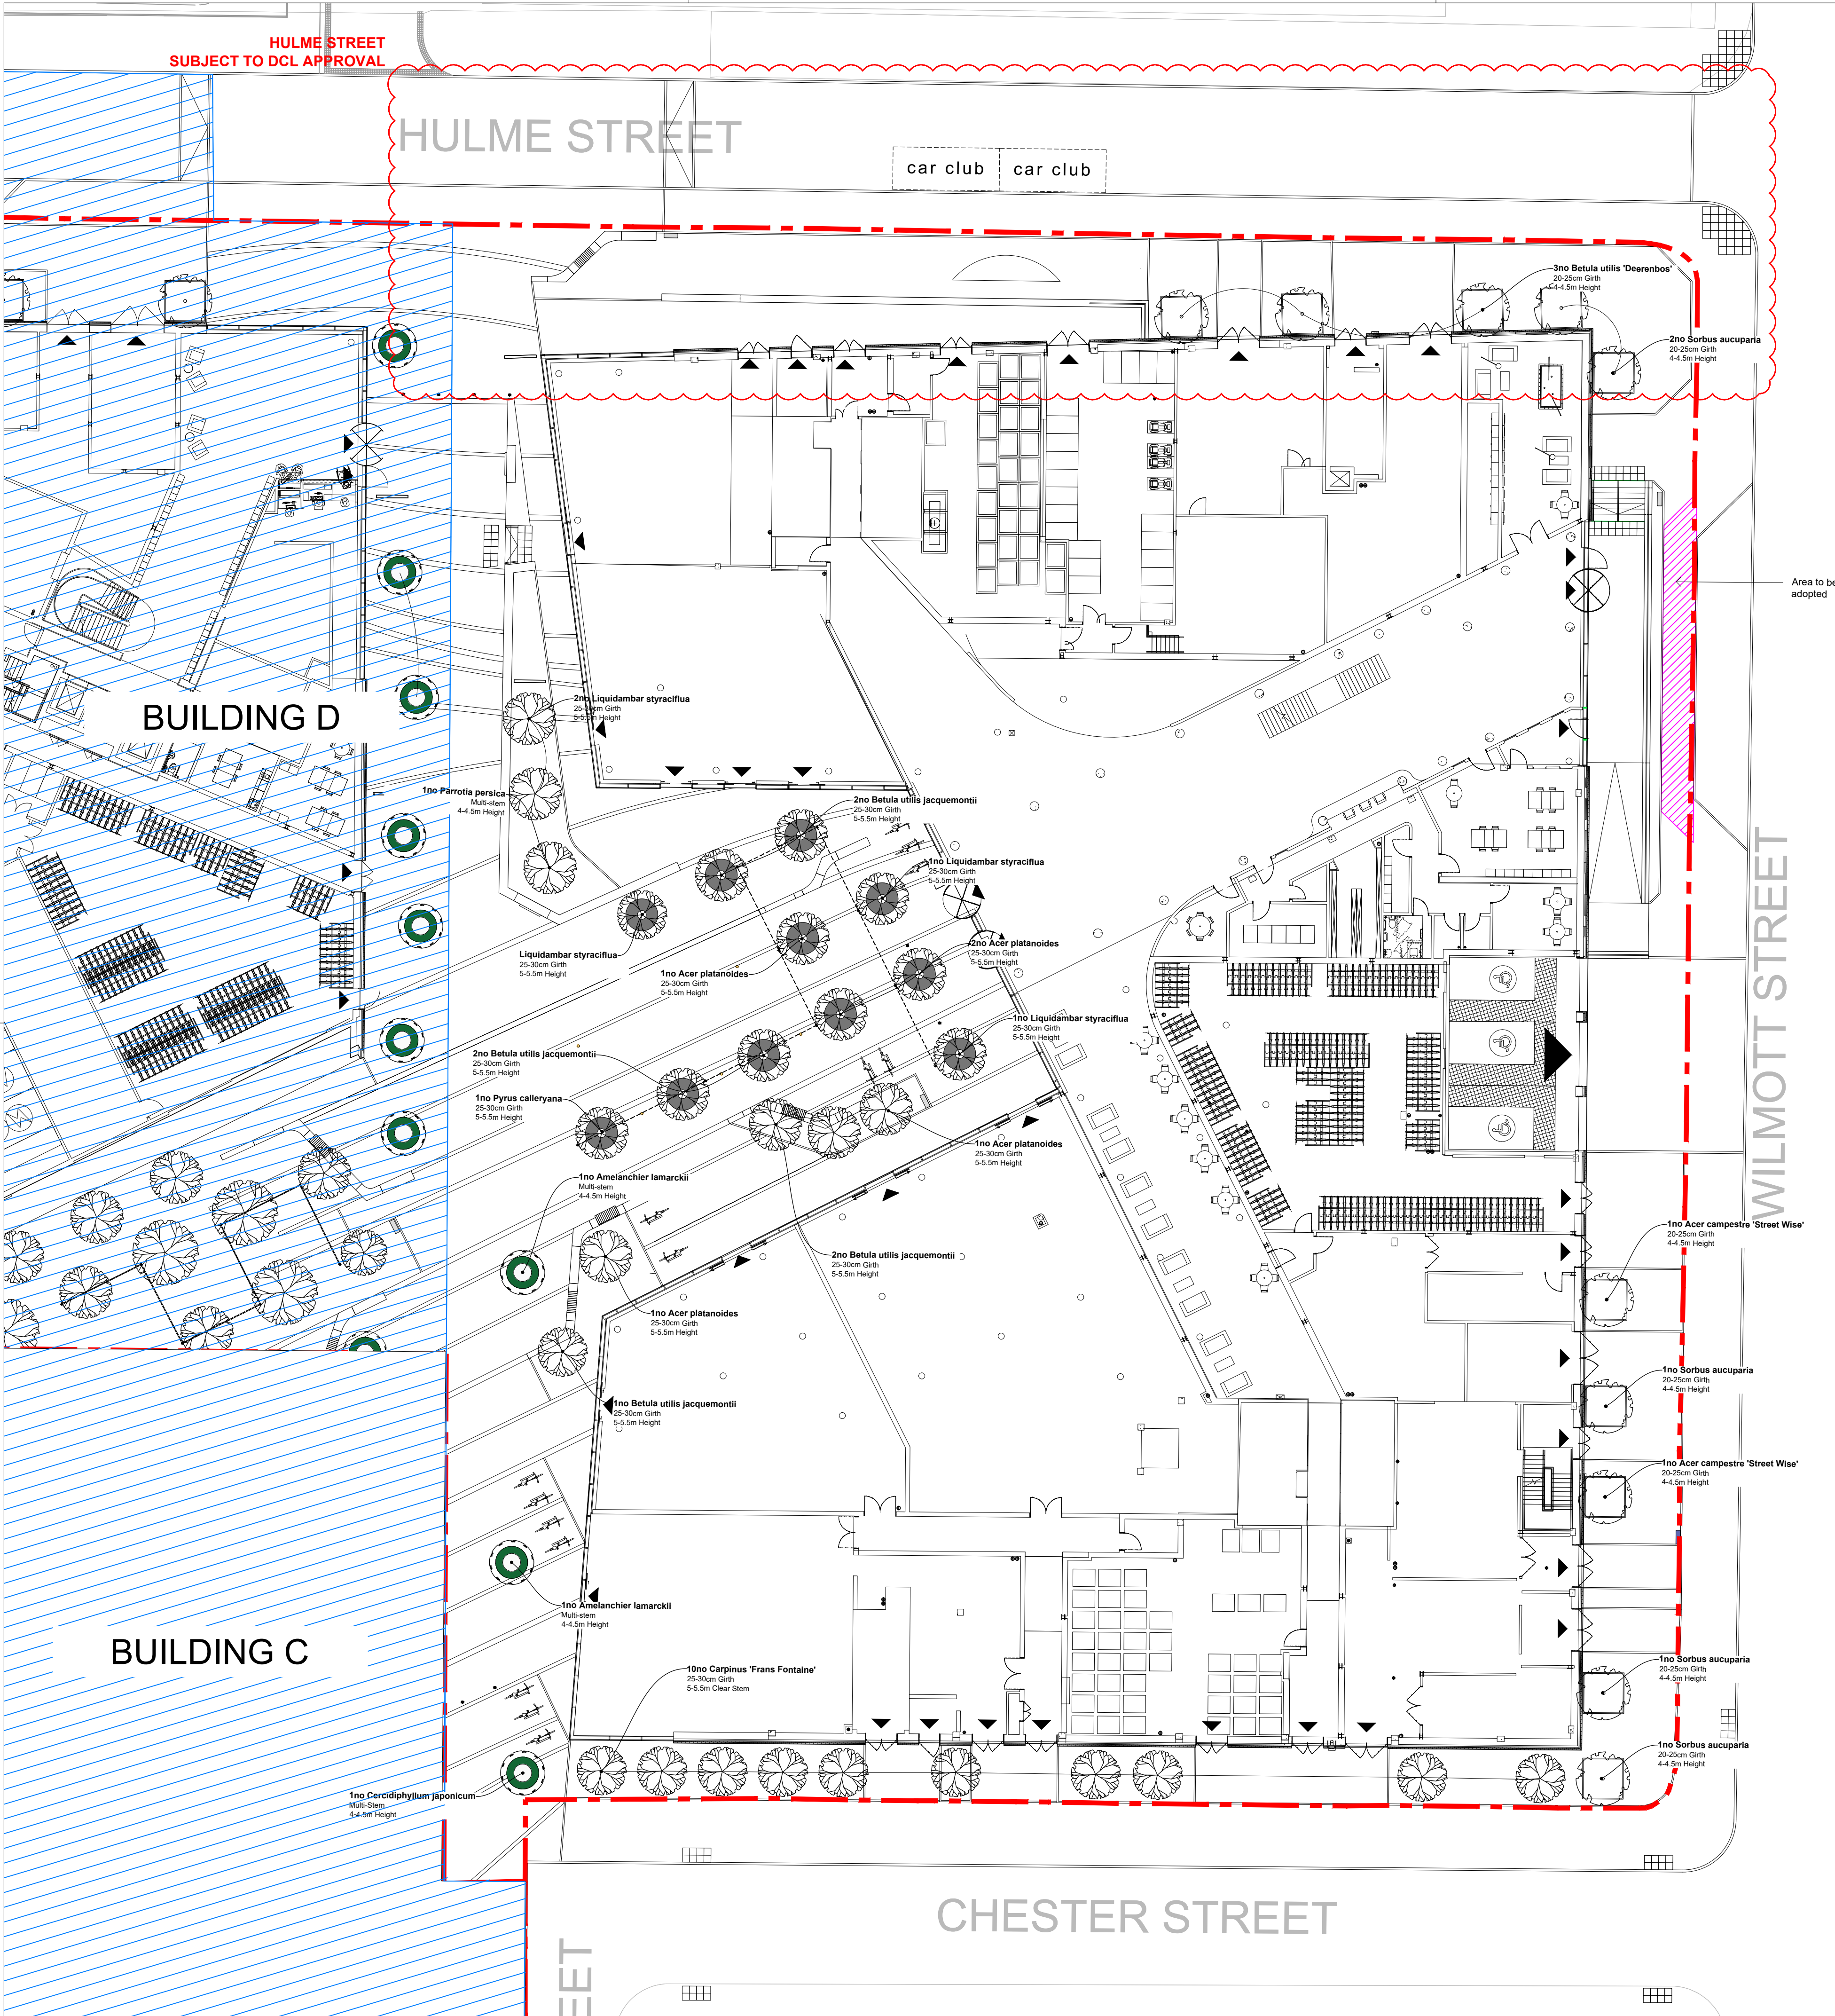

- NOTES
1. This drawing is to be read in conjunction with all other drawings and specifications.
 2. Do not scale off this drawing. Written dimensions to be taken only.
 3. Any discrepancies found between this drawing and other drawings and specifications in the construction documents must be referred to the Landscape Architect prior to work commencing.
 4. This drawing must not be copied in whole or in part without prior written consent of Optimised Environments Ltd.
 5. Survey information is based upon aspect surveyors Topographical as Survey.

CDM INFORMATION

KEY PLAN

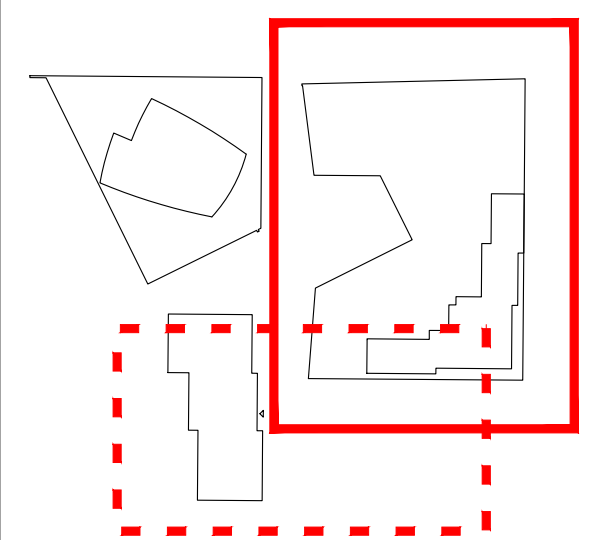

Issue	Revision	Initial	Date
11	AS BUILT	CO	06.03.25
10	FINAL CONSTRUCTION	CO	28.02.25
09	GP UPDATES	AH	14.08.24
08	BOLLARDS ADDED	SB	17.05.24
07	FULL OF PACK ISSUE	AH	04.03.24
06	REVISED ADOPTED PAVING	SB	28.02.24
05	REINSTATED TREES AND UPDATED	SB	23.08.23
04	PLANTING NOS.	SB	08.08.23
03	REVISED LAYOUT AND PLANTING NOS.	SB	03.08.23
02	REVISED ENTRANCES	CO	19.06.23
01	FIRST ISSUE	AH	13.06.23

open
optimised environments

optimised environments ltd

EDINBURGH 2nd Floor | Quartermile Two | 2 Lister Square | Edinburgh | EH3 9GL
t: 0131 221 9820 | e: optimisedenvironments.com


LONDON Wanford Court | 28 Theognorton Street | London | EC2N 2AT
t: 020 79474662 | e: optimisedenvironments.com

MANCHESTER 13 Swan Street | Manchester | M4 5JZ
t: 0161 696 7550 | e: optimisedenvironments.com

Client
Downing Living (Manchester) Ltd

Project
PLOT 11 FIRST STREET SOUTH
Manchester

Drawing Title
BUILDING A / B
PUBLIC REALM TREE PLANTING
Sheet 1 of 1

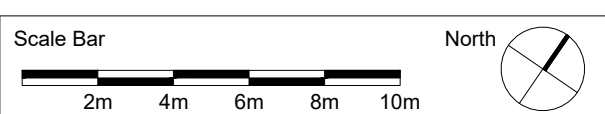

Scale: **1:200@A1** Date: **Apr 2023**
By: **AH** Status: **AS BUILT**
Checked: **AW** Approved: **AW**

Drawing Number
M90183_AB_L207 Rev
11