


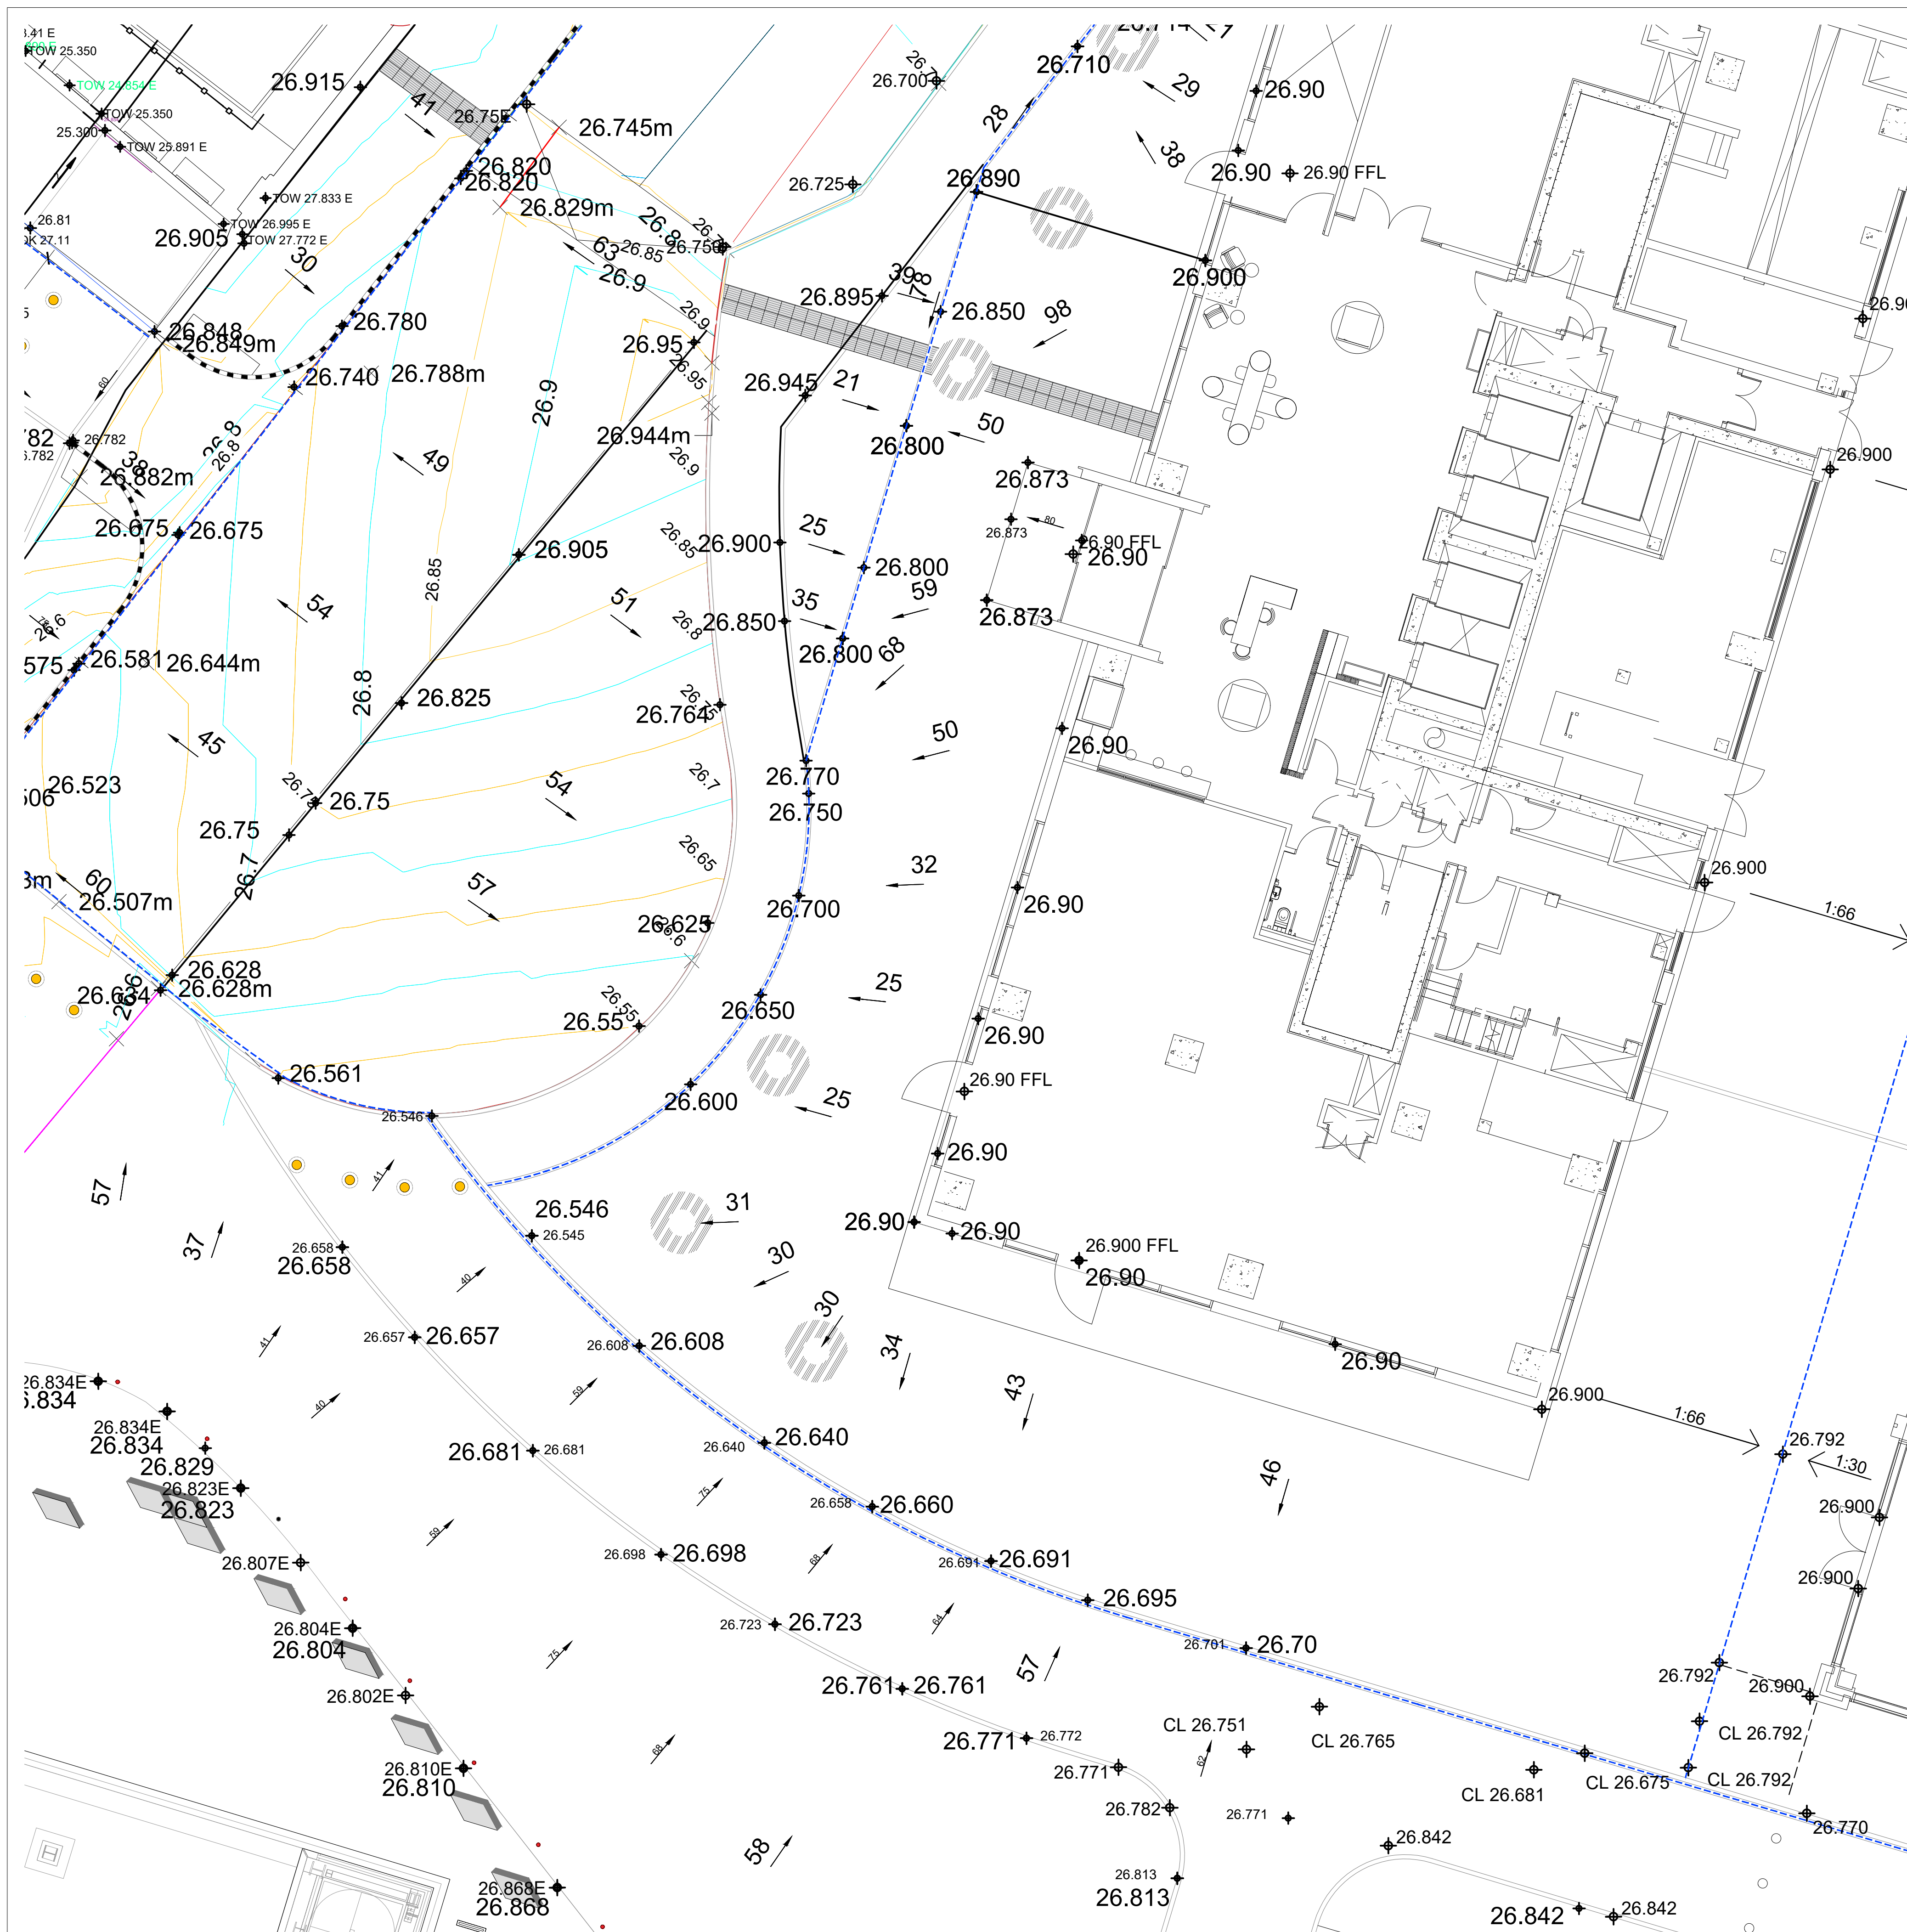

## LEVELS

28.34E

EXISTING

28.43 FFL

EXISTING DOORWAY

CL28.50

EXISTING COVER

28.34

PROPOSED

60

FALL

[illegible]

No dimensions are to be scaled from this drawing.  
All dimensions are to be checked on site.  
Area measurements for indicative purposes only.

This drawing is the property of Exterior Architecture Ltd.  
No part of the drawing may be reproduced in any manner  
without permission from Exterior Architecture Ltd.

Client  
VITA

| Rev | Description           | Date       |
|-----|-----------------------|------------|
| C05 | AS BUILT COORDINATION | 12.12.2023 |
| C04 | COORDINATION          | 30.10.2023 |
| C03 | UPDATED ISSUE         | 09.10.2023 |
| C02 | CURTAINS COORDINATION | 01.06.2023 |
| C01 | INITIAL ISSUE         | 04.05.2023 |

**EXTERIOR  
ARCHITECTURE**

**LONDON**  
Unit 17.1, The Leather Market, 11-13 Weston Street, London, SE1 3ER

**MANCHESTER**  
Studio 537, The Royal Exchange, St Anns Square, Manchester, M2 7DH

**E-MAIL** [office@exteriorarchitecture.com](mailto:office@exteriorarchitecture.com)  
**WEB** [www.exteriorarchitecture.com](http://www.exteriorarchitecture.com)

Project title  
ST JOHNS T1 PUBLIC REALM

Drawing title

T1 PUBLIC REALM LEVELS  
PLANSHEET 2

|           |            |                  |
|-----------|------------|------------------|
| Issued By | Manchester | T: 0161 850 8101 |
| Scale     | 1:100 @ A1 | Drawn EXA        |
| Status    | STAGE 5    | Checked SPL      |
| Date      | 12.12.2023 | Approved JM      |

Drawing number                      Revision  
T1-EXA-G710-PL-GRD-302        C05

