




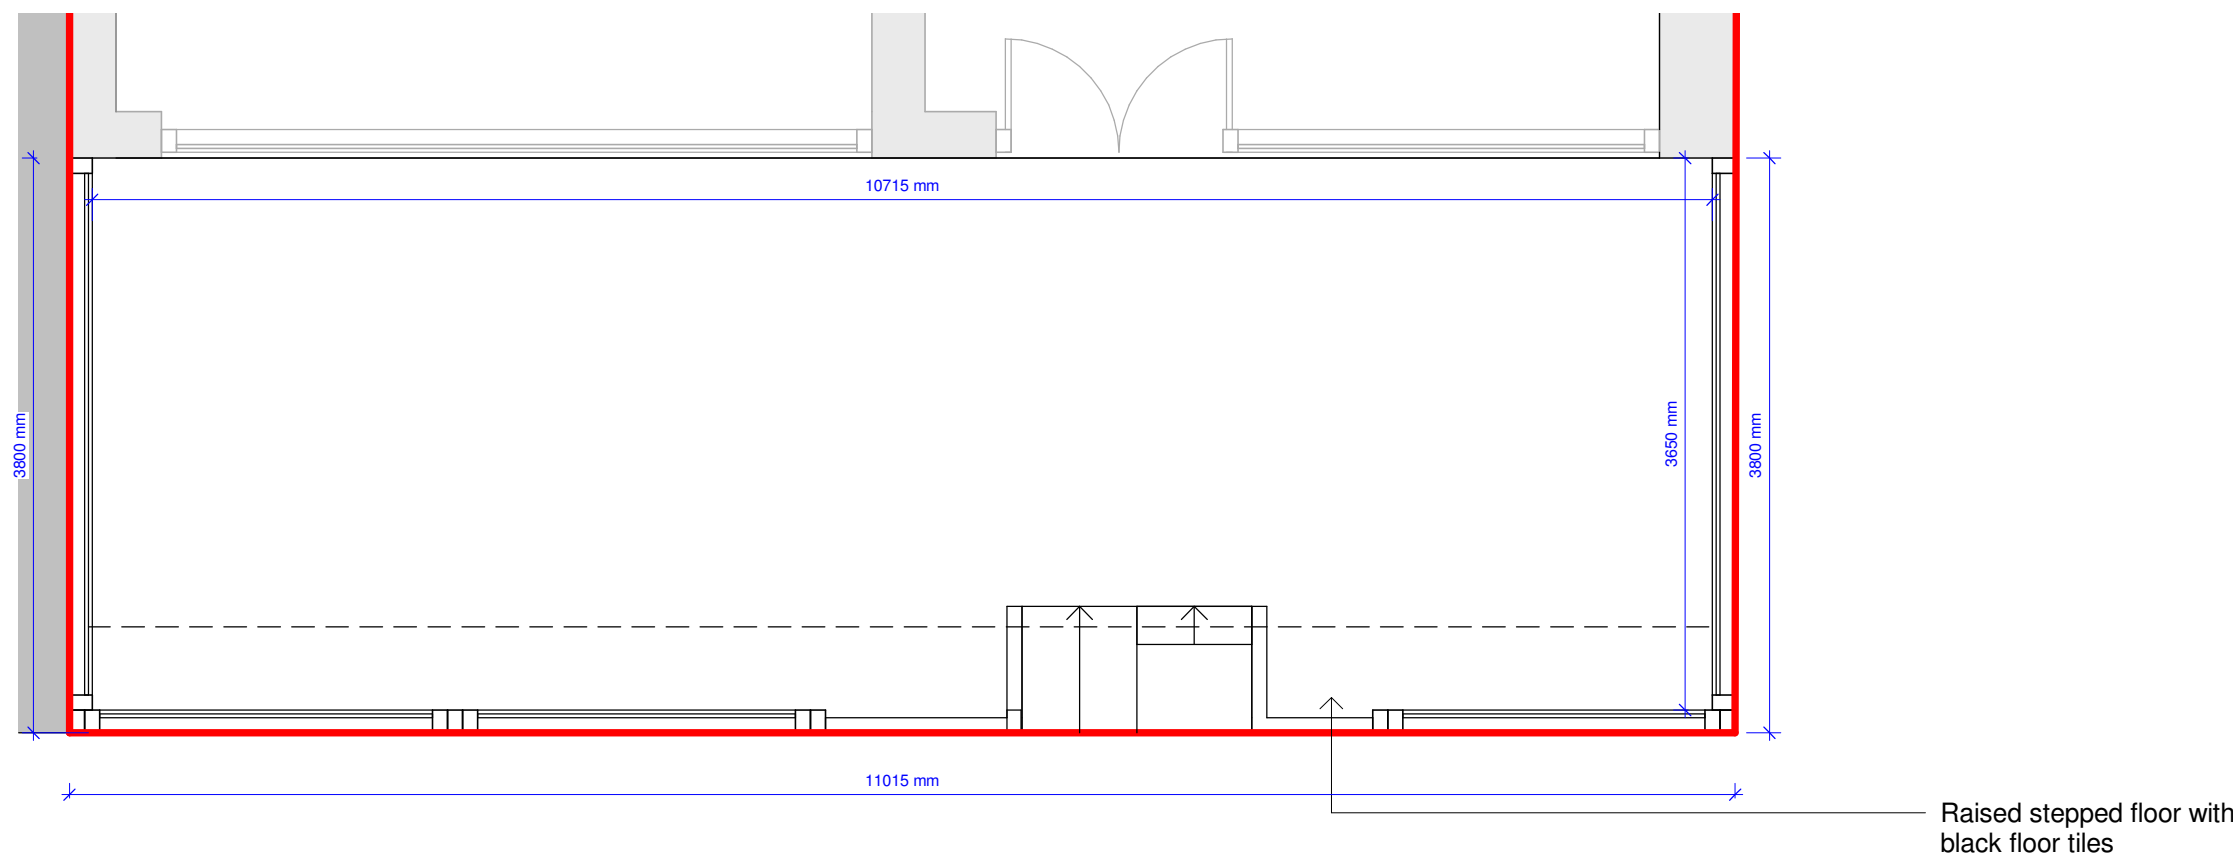

1 As-built Front Forecourt_Floor Plan
1 : 50

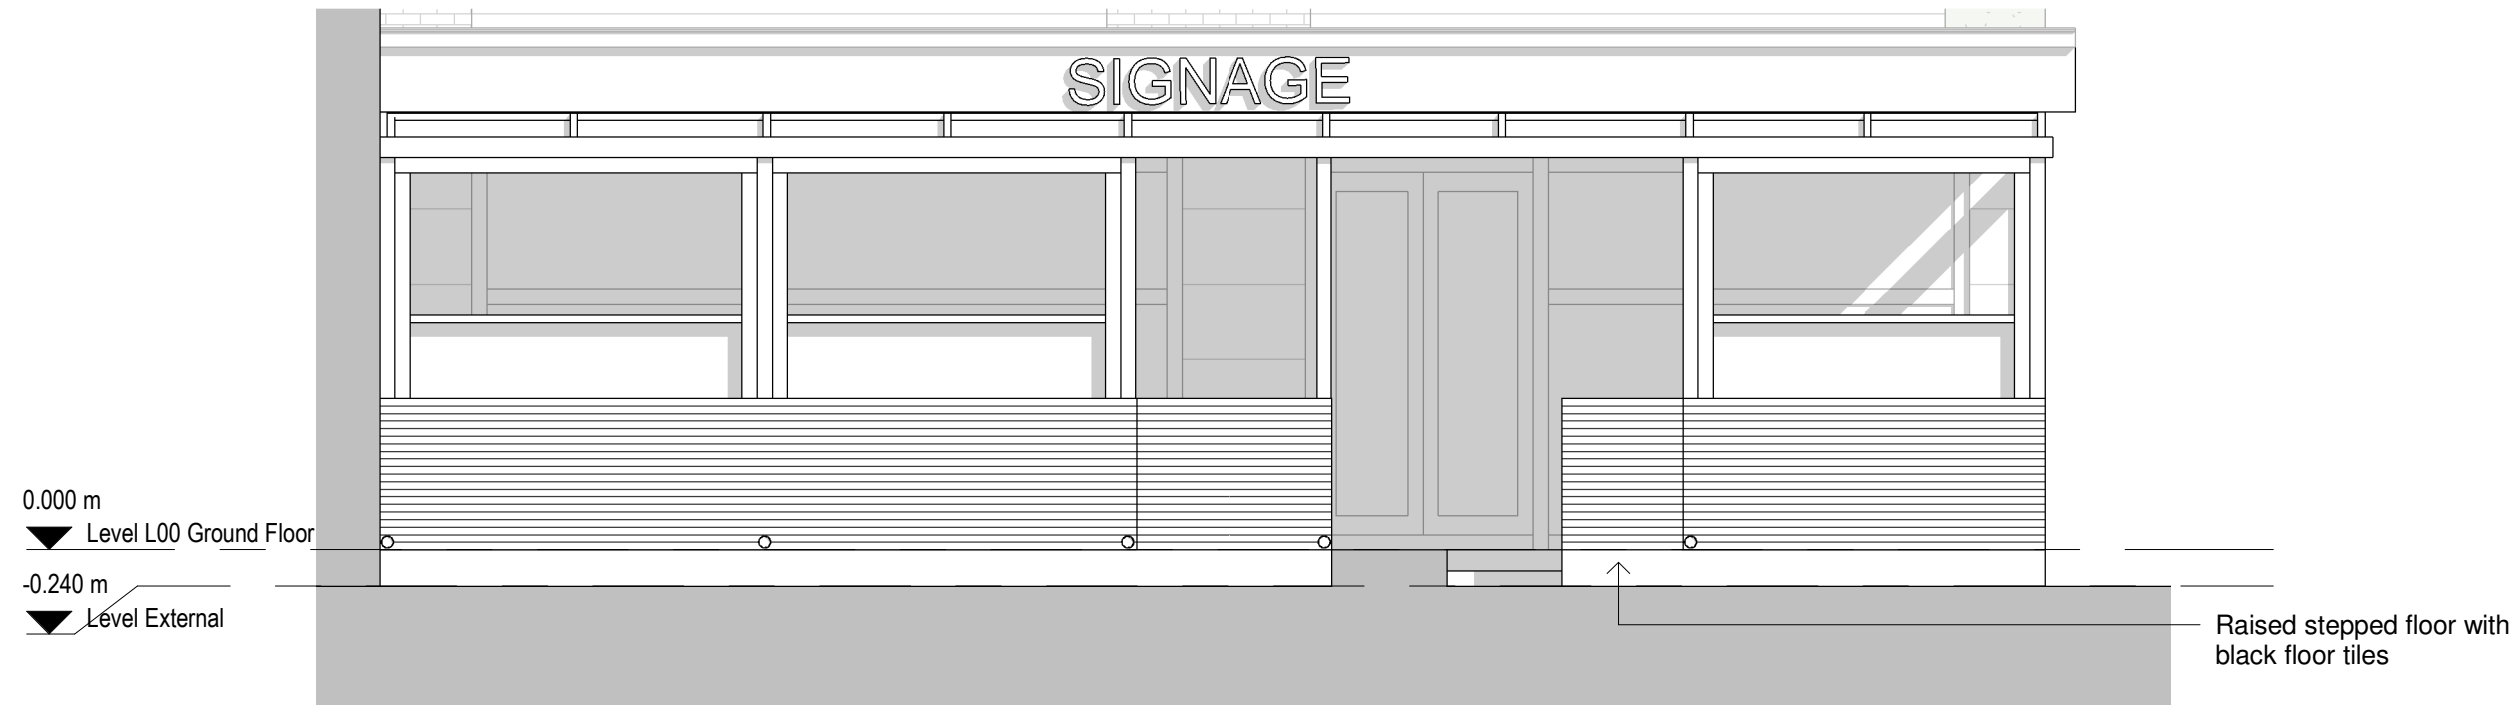


3 As-built Front Forecourt_East Elevation
1 : 50

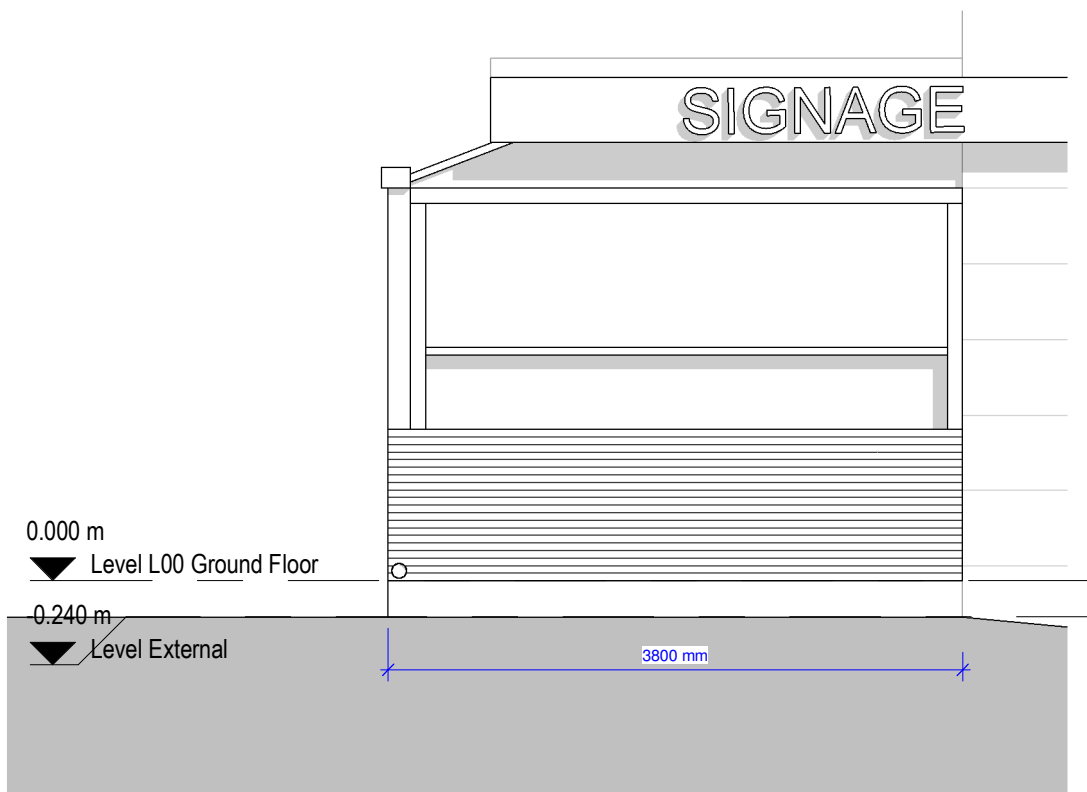

4 As-built Front Forecourt_North Elevation
1 : 50



2 As-built Front Forecourt_3D View

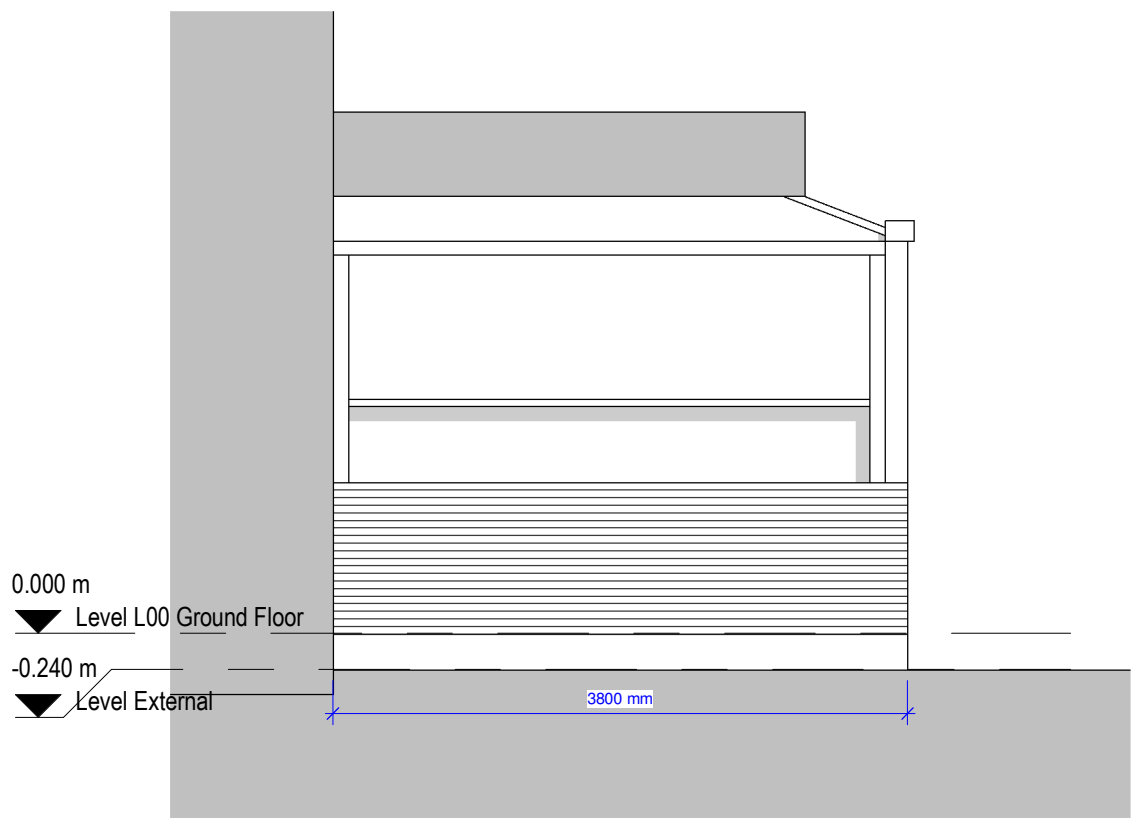

5 As-built Front Forecourt_South Elevation
1 : 50

P7	01/05/25	AK	SH	Amended Forecourt
P6	28/04/25	AK	SH	Amended Forecourt
P5	24/04/25	AK	SH	Amended Forecourt
P4	14/02/25	AK	SH	Amended Forecourt
P3	18/10/24	SA	SH	Amended Materials
P2	19/08/24	AK	SH	Amended Forecourt
P1	22/07/24	AK	SH	Initial Issue

No. Date Dwn Chk App Revision or reason for issue

Client

360 Lounge

createitstudios
... leave an impression

Create It Studios (NW) Ltd
Universal Square
Devonshire Street North
Manchester
M12 5JH
info@createitstudios.co.uk

Project Title
360 Lounge, 54-56 Wilmslow Rd,
Manchester M14 5AL

Scale / North Point
1 : 50

Drawing Title
As-built Front Forecourt

Drawing Number
A1514(02)AP003

Drawing Status
Preliminary

Revision
P7