


VISUAL SCALE 1:100 @ A3

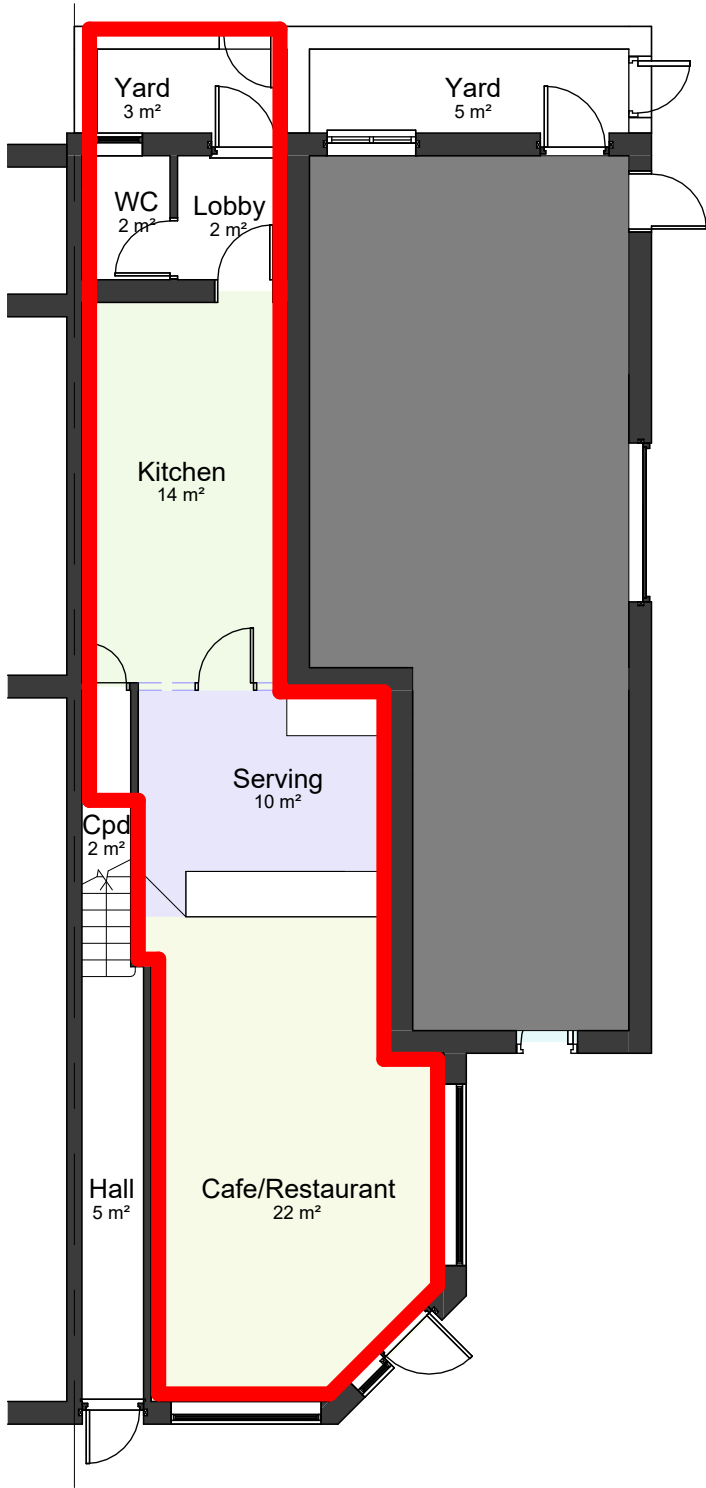

00-AB-Ground Floor  
1 : 100

COPYRIGHT © ALL RIGHTS RESERVED BY VIKAS ALYAS LTD. DO NOT SCALE FROM DRAWING. DRAWING INDICATES DESIGN INTENT ONLY. REPORT ANY DISCREPANCIES TO CLIENT / VA LTD. NOT TO BE USED FOR CONSTRUCTION UNLESS STATED SO. TO BE READ IN CONJUNCTION WITH OTHER DRAWINGS OR SPECIFICATION WHERE PROVIDED.



0161 511 8479  
vikas@architek.uk  
916 Stockport Road, Levenshulme, Manchester, M19 3AB

| No. | Description        | Date       |
|-----|--------------------|------------|
| P1  | Issue to Planning  | 25.02.2025 |
| P2  | Use outline update | 15.05.2025 |
|     |                    |            |
|     |                    |            |
|     |                    |            |
|     |                    |            |

|                               |  |                                             |  |                    |                        |                         |
|-------------------------------|--|---------------------------------------------|--|--------------------|------------------------|-------------------------|
| PROJECT                       |  | ADDRESS                                     |  | CLIENT             |                        |                         |
| LDC - Class E Restaurant/Cafe |  | 352 Great Western St,<br>Manchester M14 4BY |  | Mr Abid Miah       |                        |                         |
|                               |  | SHEET                                       |  | Date<br>16.01.2025 | Project number<br>1309 | Scale (@ A3)<br>1 : 100 |
| Manchester City Council       |  | PURPOSE OF ISSUE                            |  | Drawn by<br>NA     | DRAWING NUMBER<br>A104 | REV                     |
| Planning                      |  | Asbuilt Floor Plans                         |  | Checked by<br>VA   |                        | P2                      |