



General Notes
The Architect shall have no responsibility for any use made of this document other than for that which it was prepared and issued.
All dimensions should be checked on site. Do not scale from this drawing.
To be read in conjunction with all other Consultant's drawings.
The Architect to be immediately notified of any discrepancies.
Copyright on this drawing retained by the Architect.

LEGEND

Site Boundary

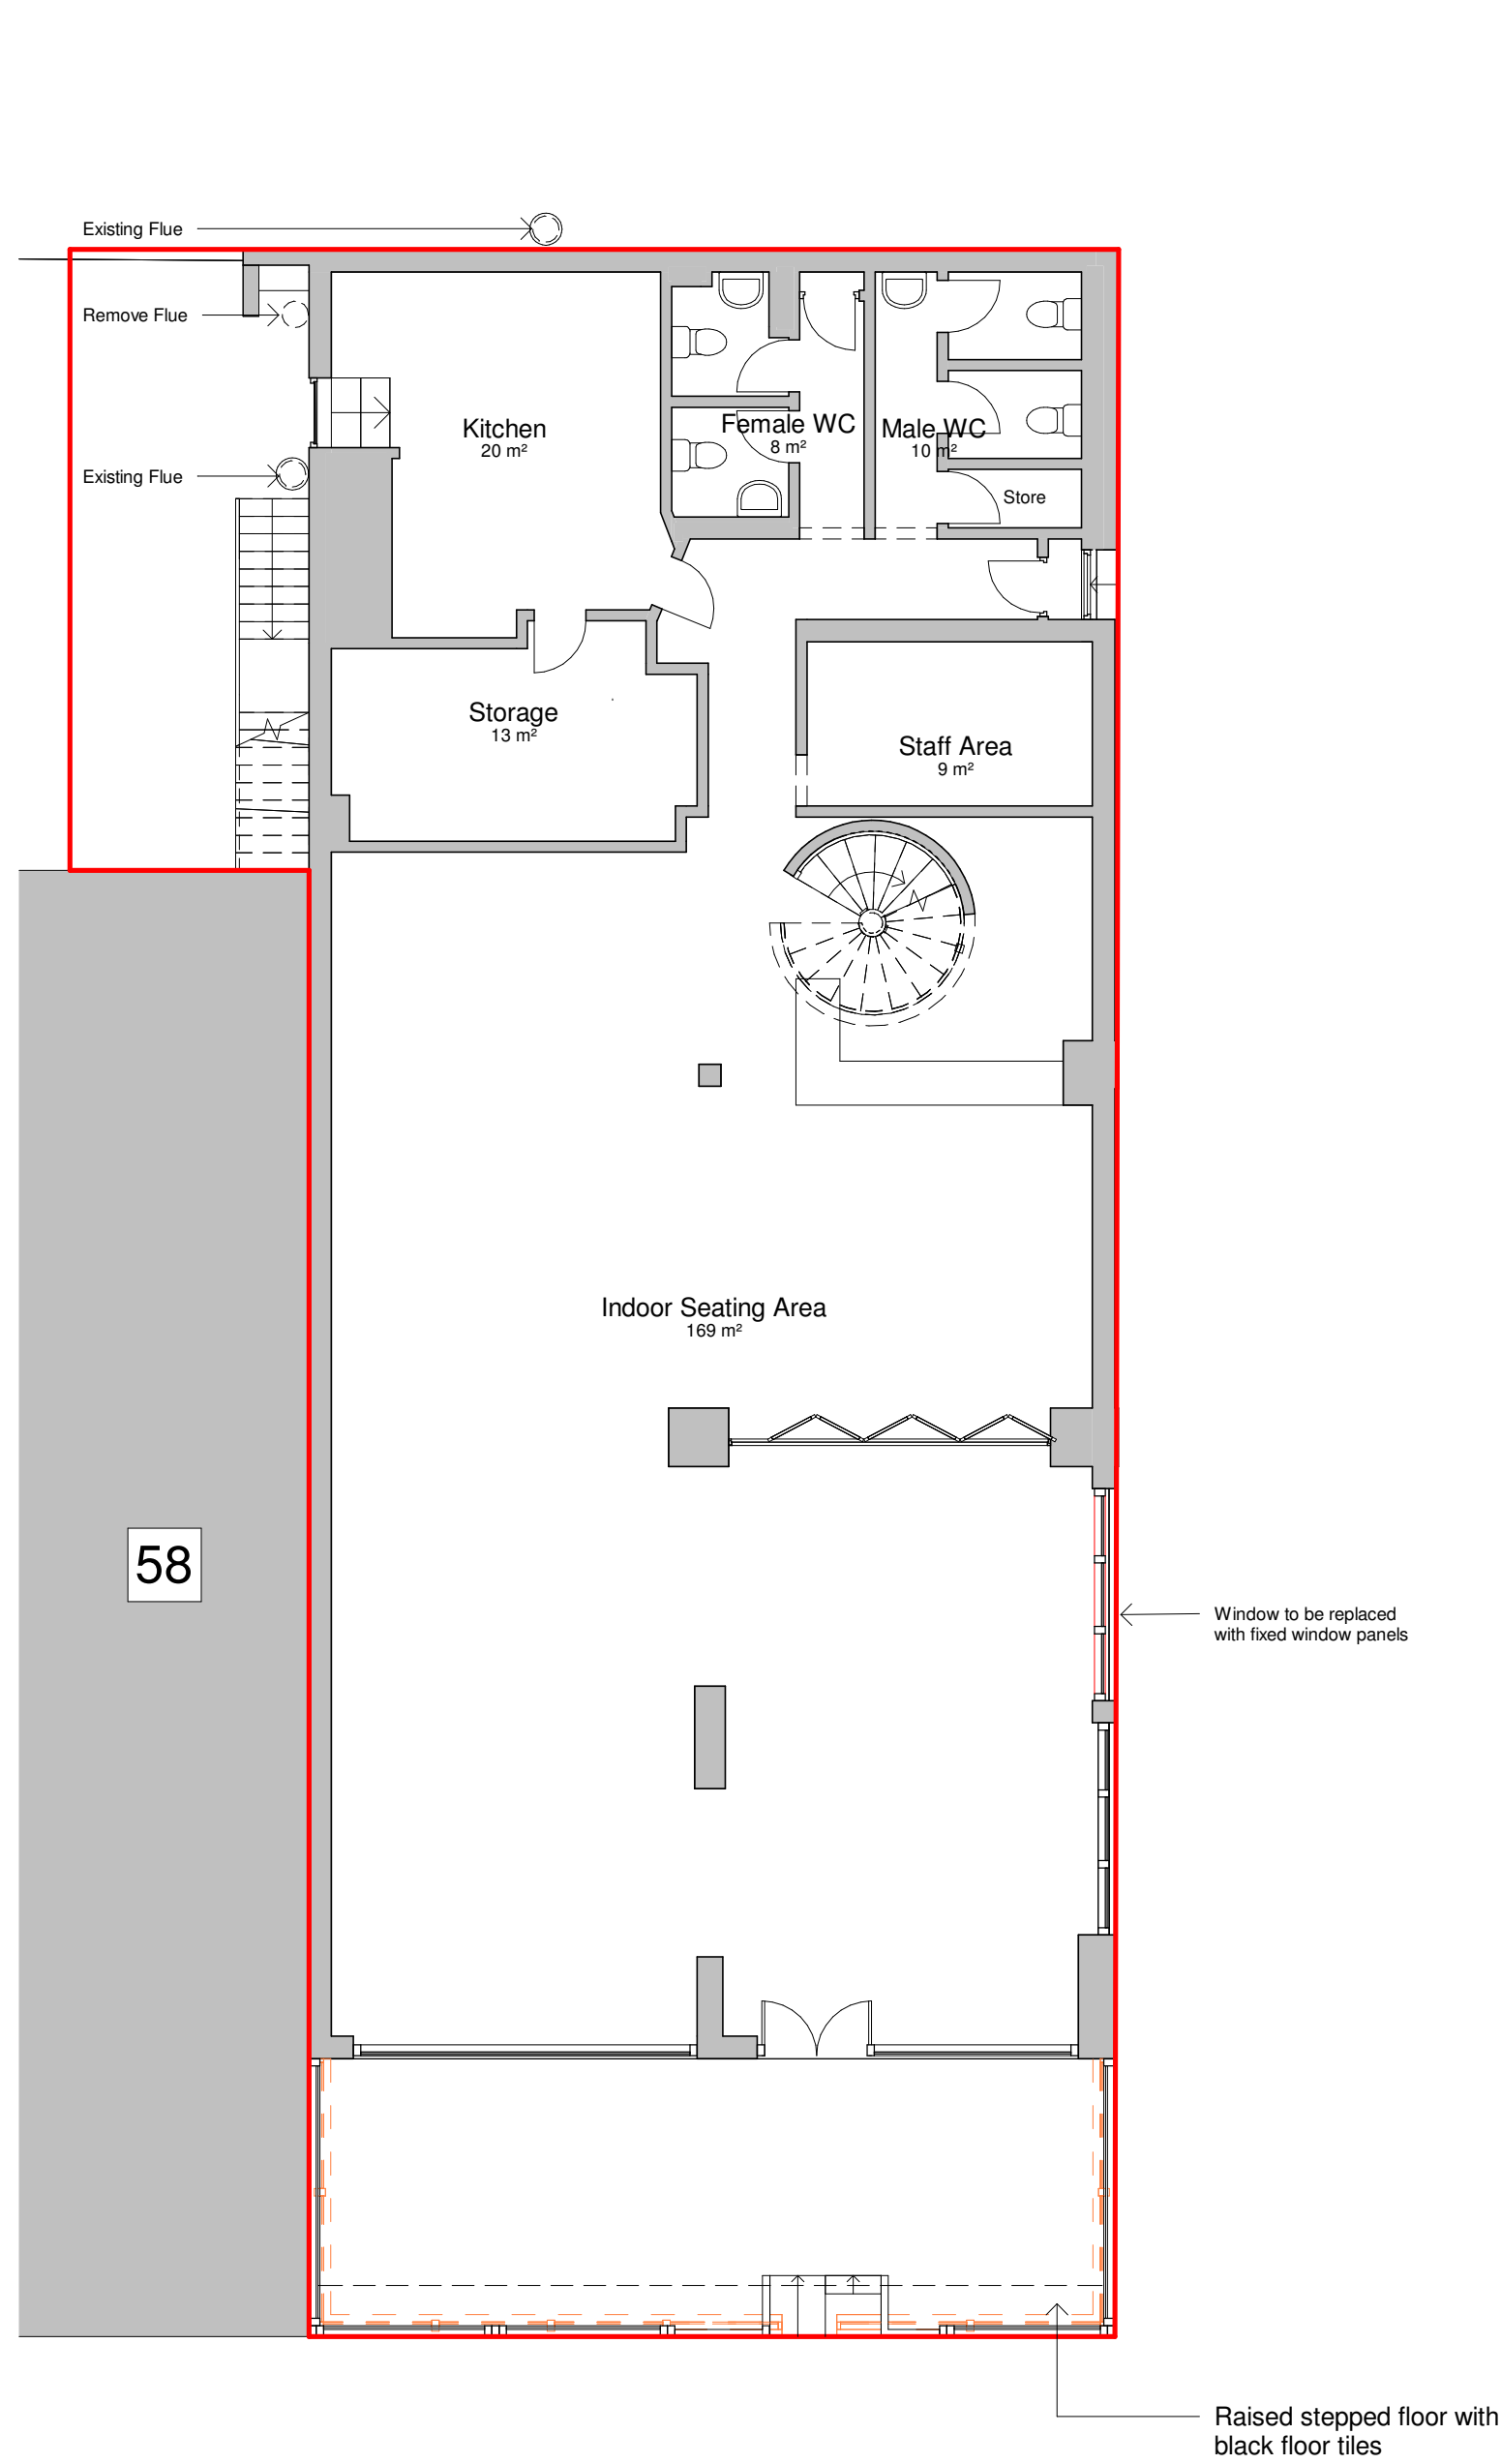


1 As-built Ground Floor Plan
1 : 100

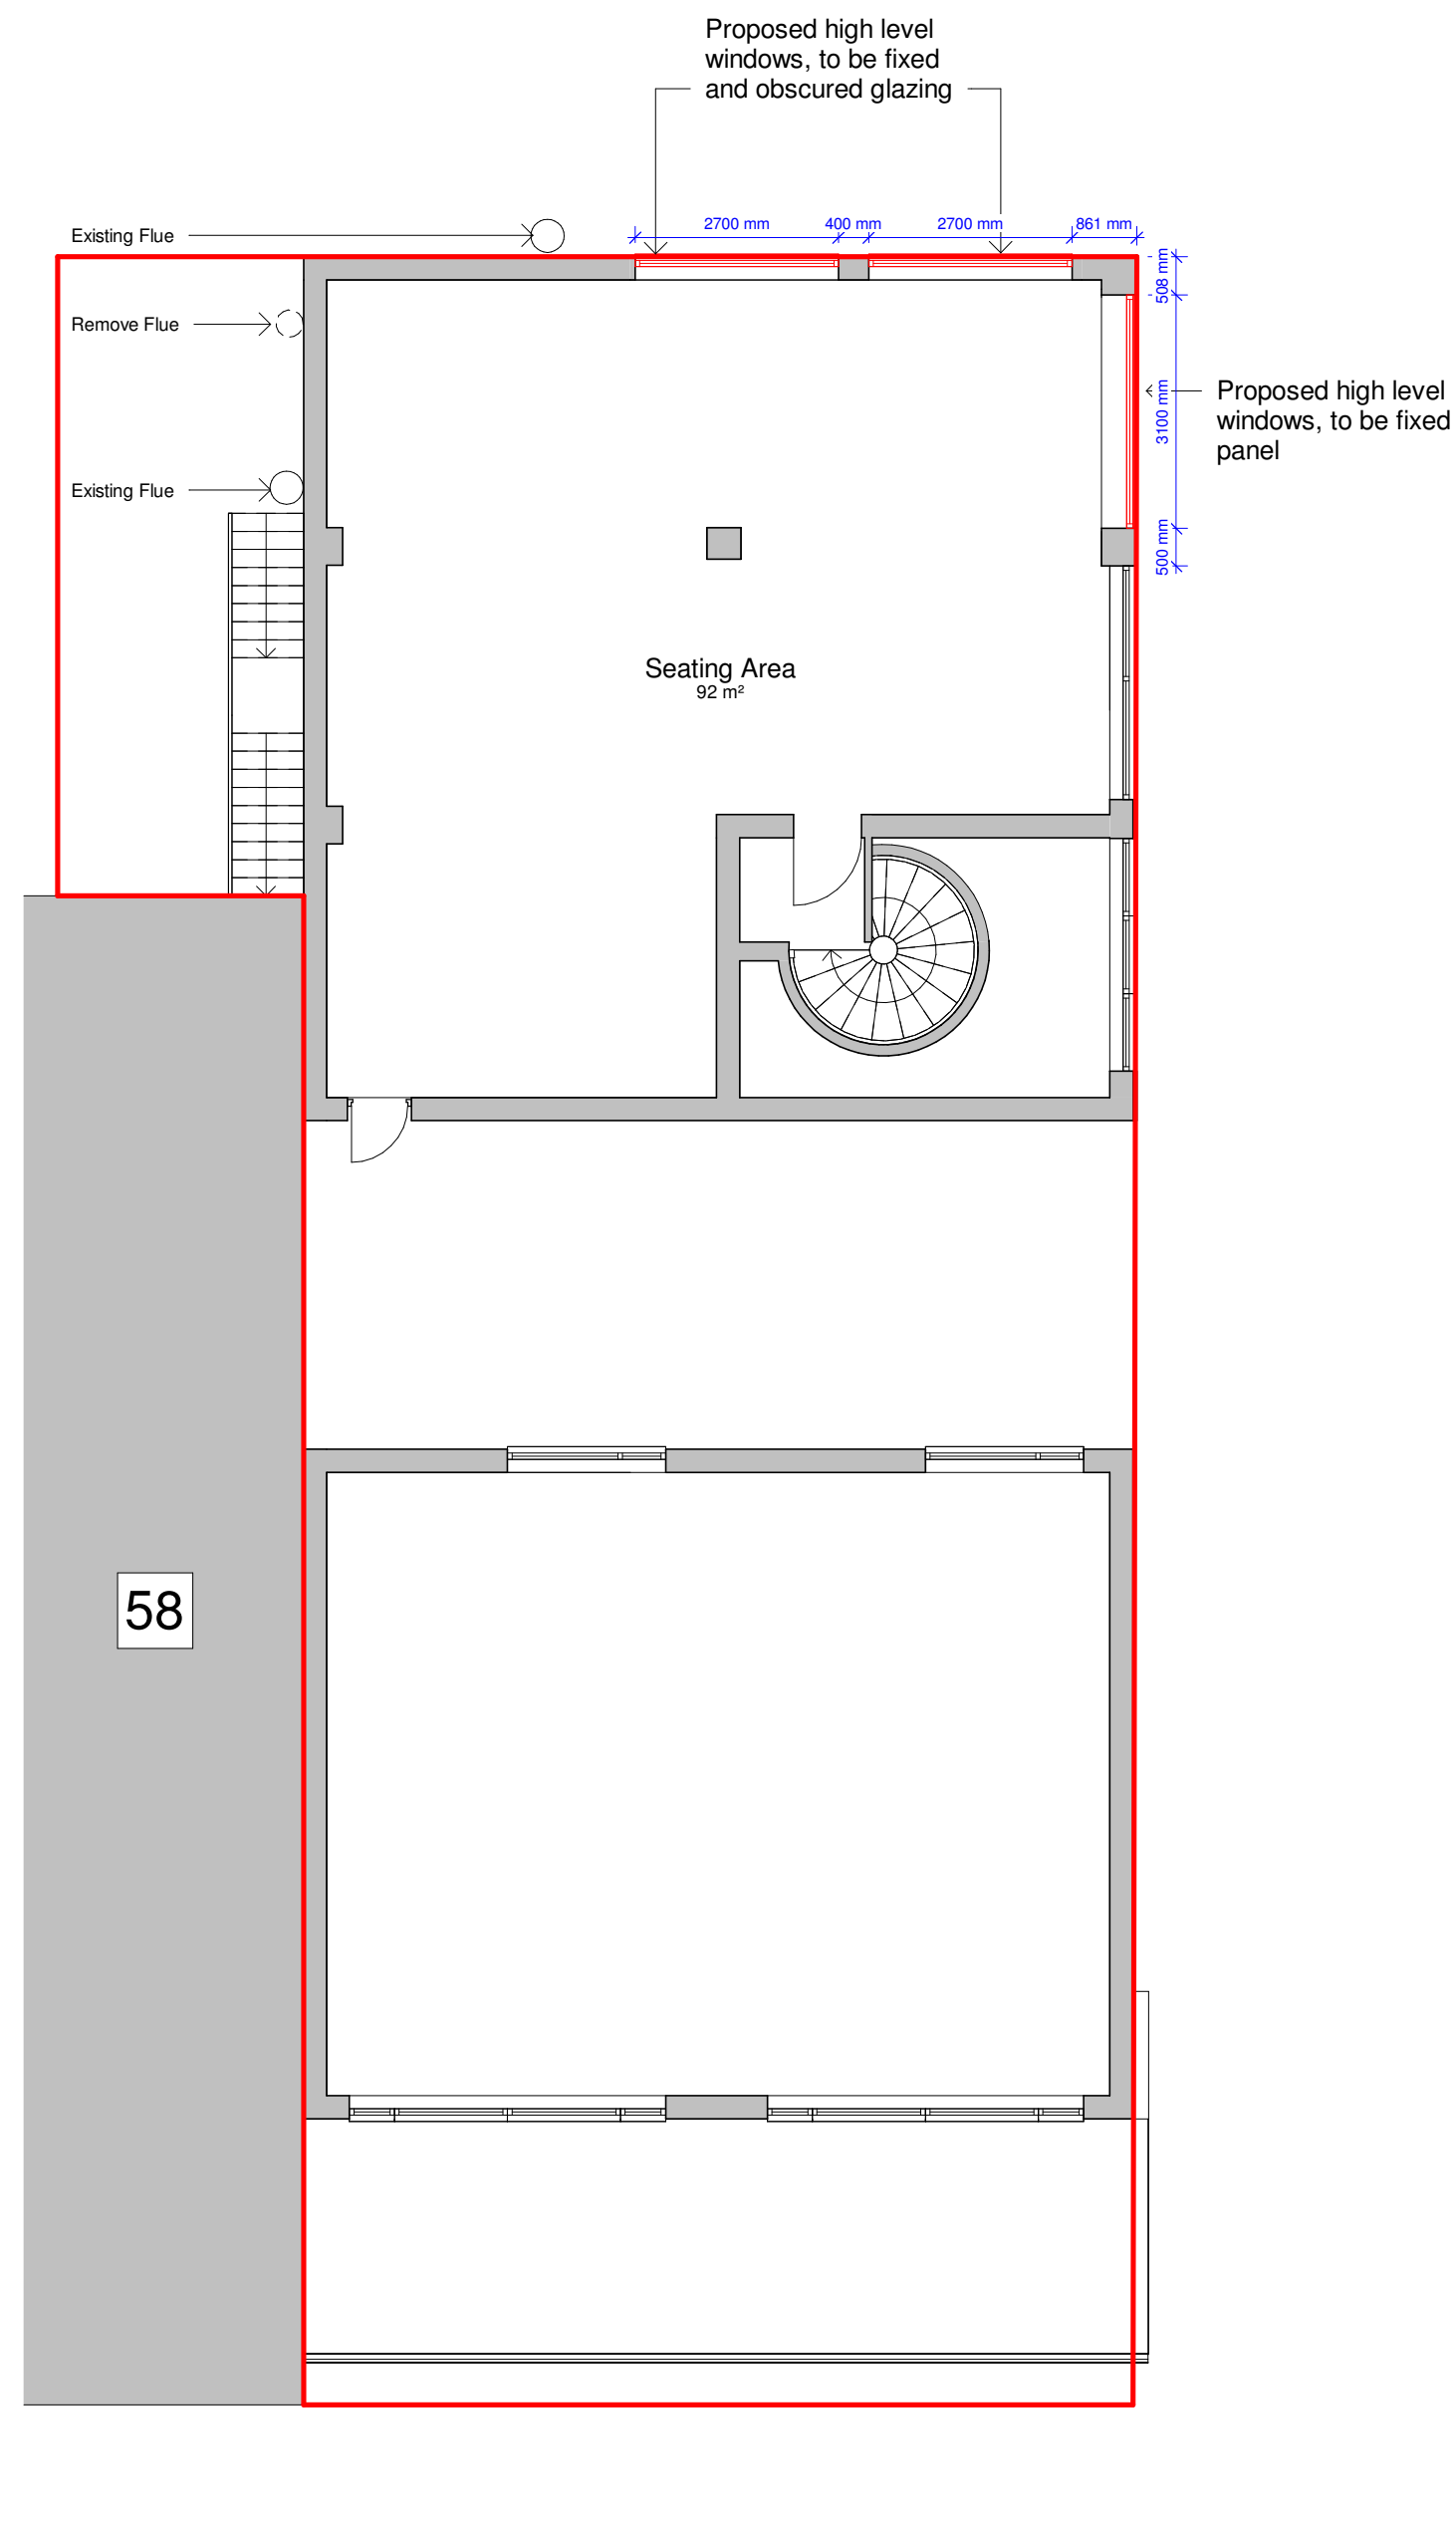


2 As-built First Floor Plan
1 : 100



3 As-built East Elevation
1 : 100

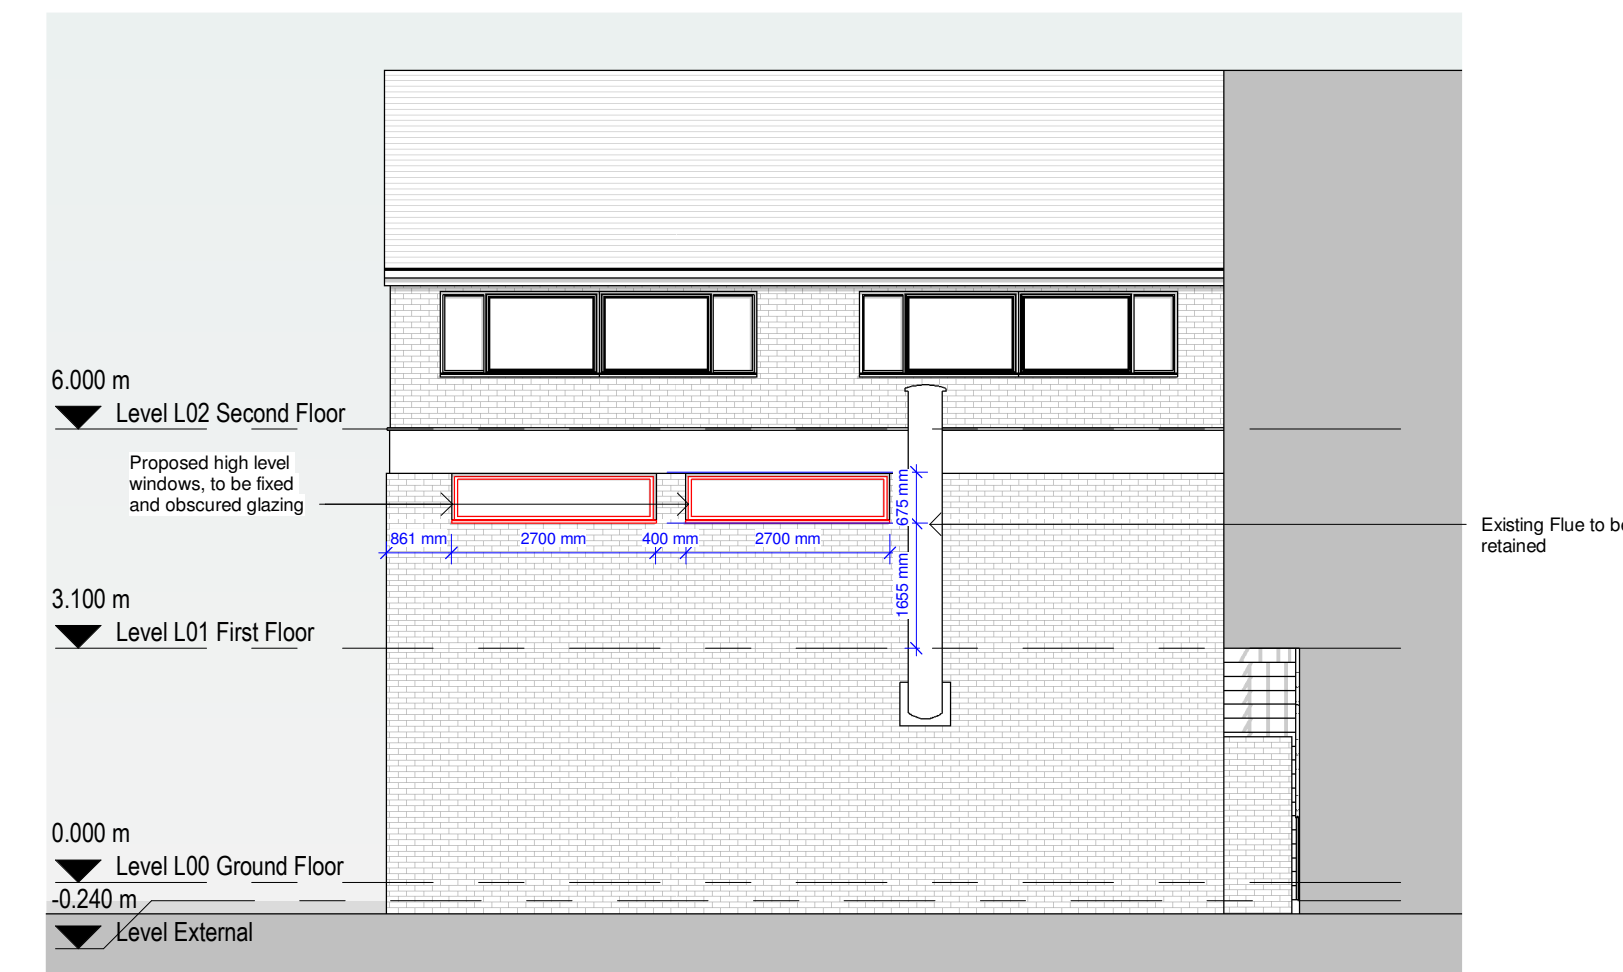

4 As-built West Elevation
1 : 100

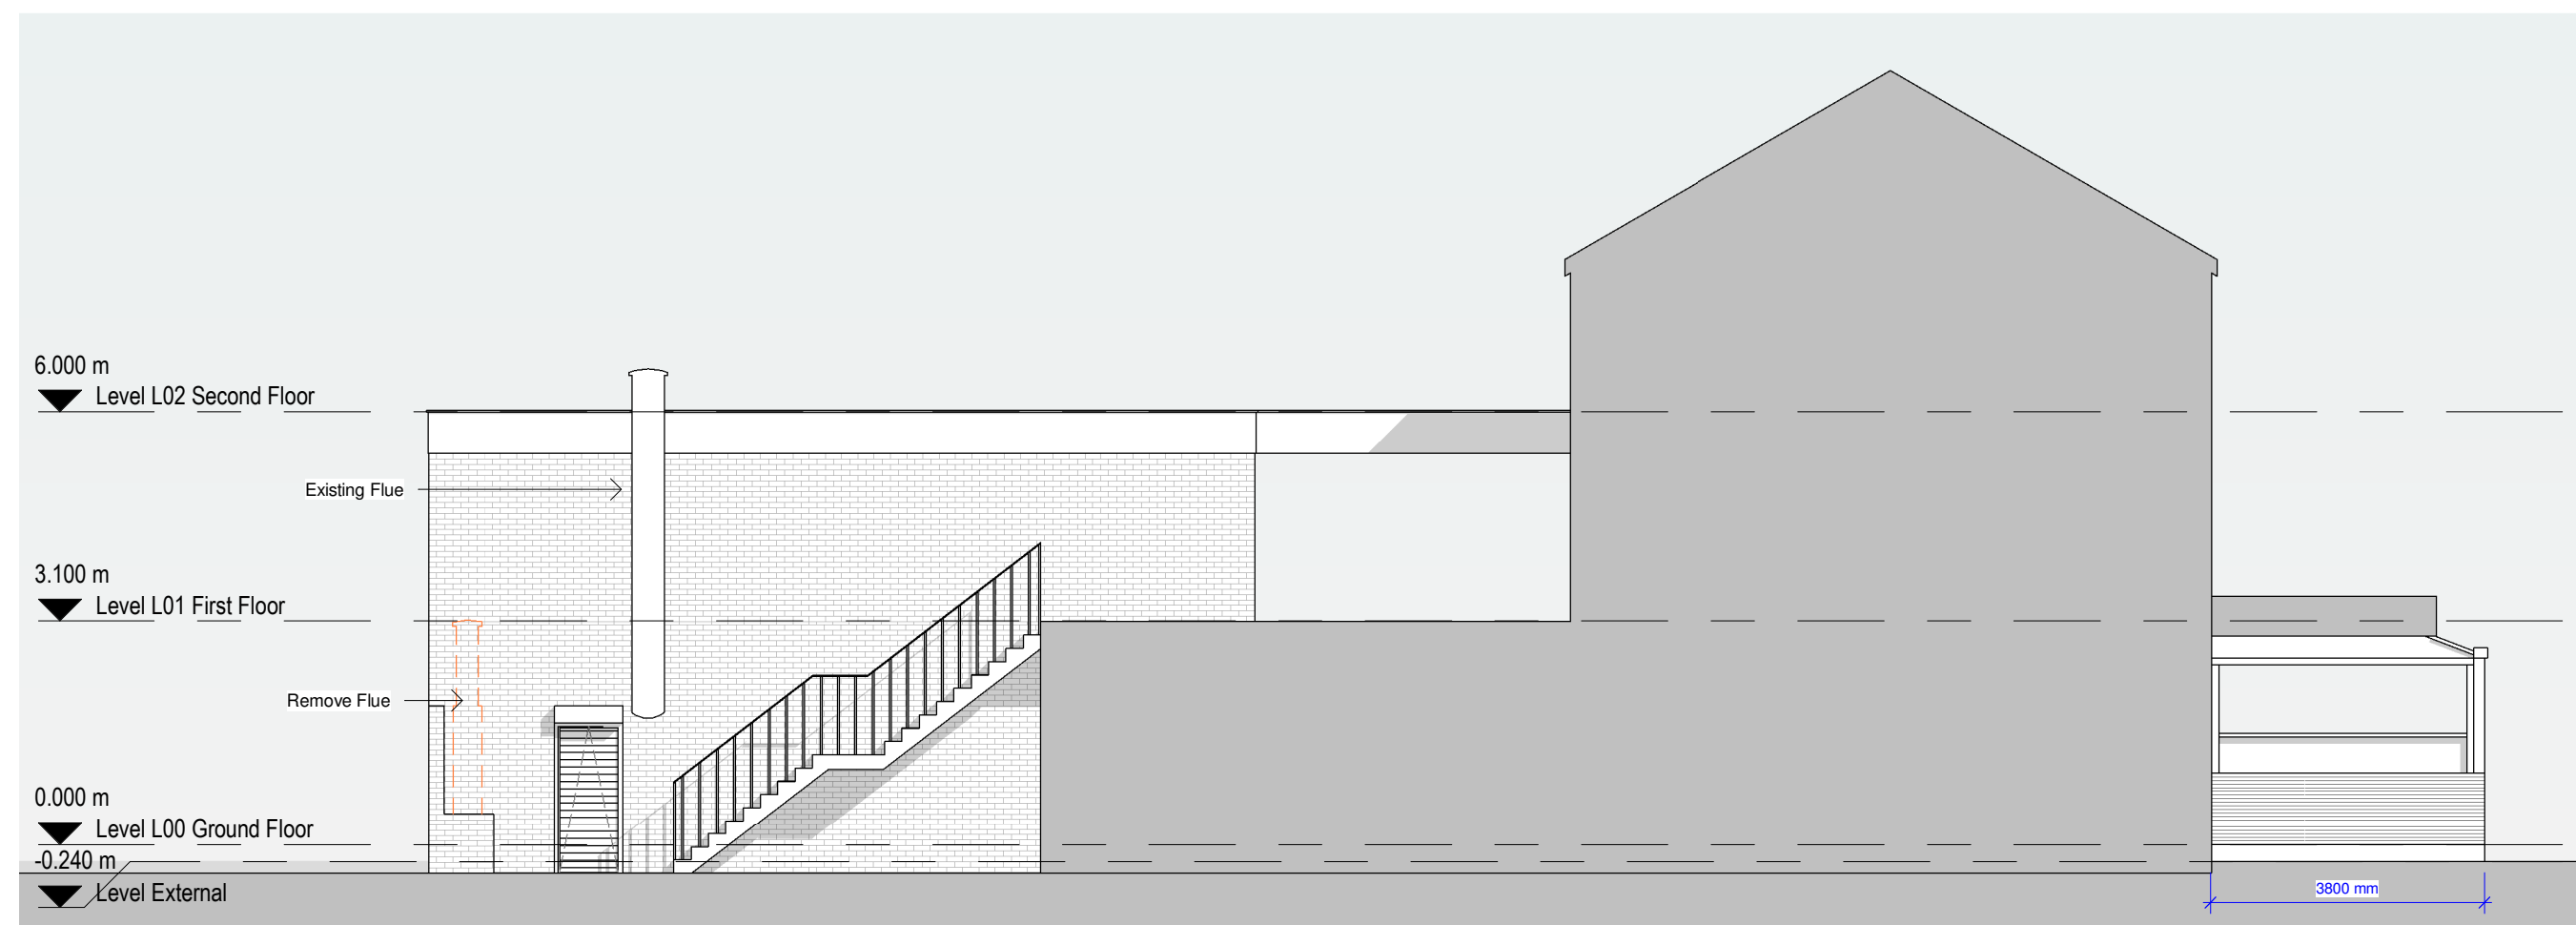

5 As-built South Elevation
1 : 100



6 As-built North Elevation
1 : 100

P12	01/05/25	AK	SH	Amended Forecourt
P11	28/04/25	AK	SH	Amended Forecourt
P10	24/04/25	AK	SH	Amended Forecourt
P9	14/02/25	AK	SH	Amended Forecourt
P8	18/10/24	SA	SH	Amended Materials
P7	22/07/24	AK	SH	Amended Front Forecourt
P6	16/12/23	SH	SH	Amended Barrier Height
P5	05/12/23	AK	SH	Amended Window
P4	01/12/23	AK	SH	Amended Proposal
P3	02/10/23	SA	SH	Amended Proposal
P2	27/09/23	SA	SH	Added Flue on Plans
P1	07/09/23	AK	SH	Initial Issue

No. Date Dwn Ck App Revision or reason for issue

Client
360 Lounge

createit studios
leave an impression

Create It Studios (NW) Ltd
Universal Square
Devonshire Street North
Manchester
M12 5JH
info@createitstudios.co.uk

Project Title
360 Lounge, 54-56 Wilmslow Rd,
Manchester M14 5AL

Scale / North Point
1 : 100

Drawing Title
As-built Floor Plans and Elevations

Drawing Number
A1514(02)AP002
Drawing Status
Preliminary
Revision
P12

