




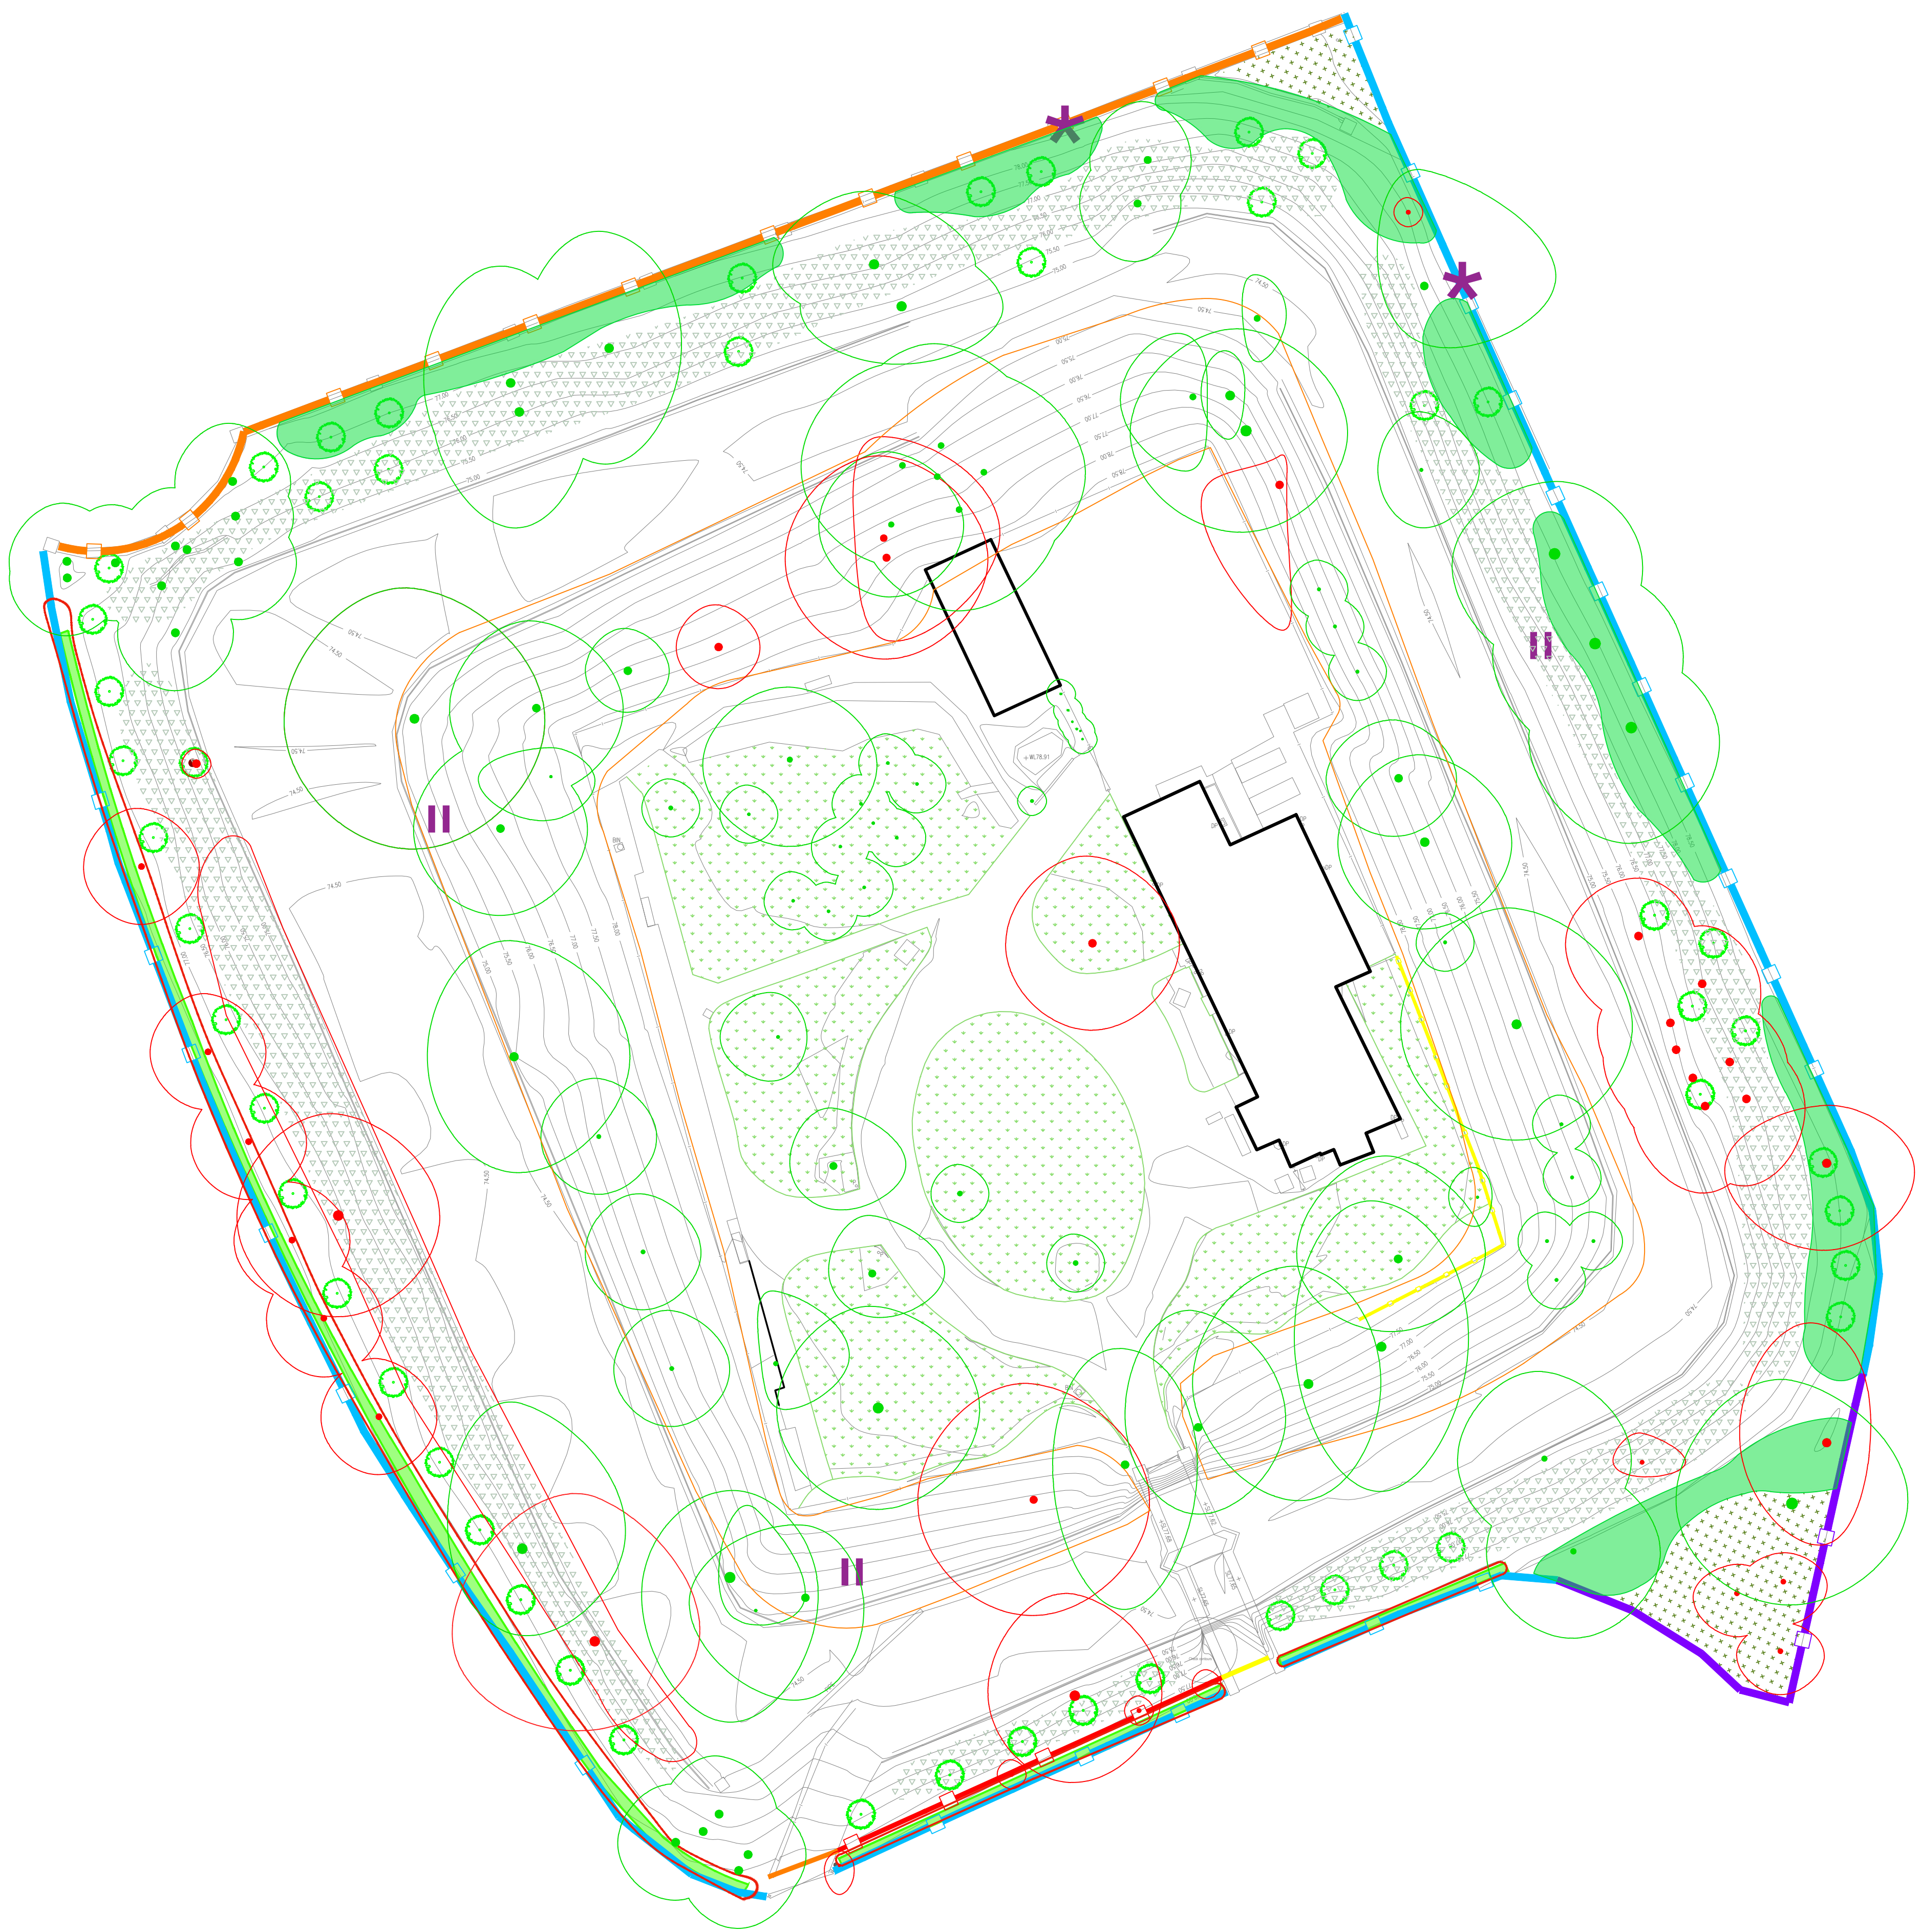


Existing trees to be retained and protected
BS5837: 2012 Trees in Relation to Design,
Demolition and Construction - Recommendations.

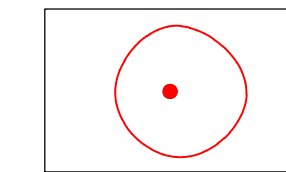

Existing trees to be removed to British Standard for Tree Work BS 3998:2010

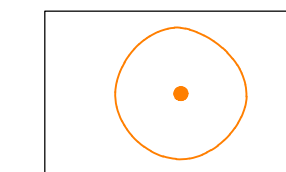

Selective thinning of dense mixed species understorey

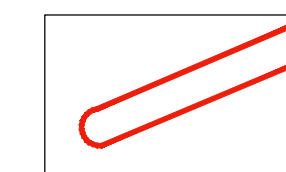


Existing Hedge to be Removed

Updates to tree strategy requested by Arboricultural Officer at MCC - reasons for updates marked on plan.

Refer to the Morton Partnership 16076 Boundary Fence Footings Markup and 16076 Boundary Fence Footings Rev A


Mix of native species, standard, feathered and multistem trees.
55no.

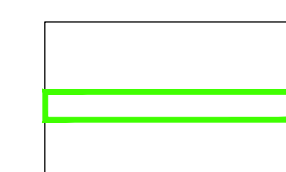

Native species hedge planting. Planted in 2 staggered rows, 350mm apart with 5 no. plants per m.
146 lin m



Seasonal native bulbs planted in swathes on
moat embankment.
1200 m²

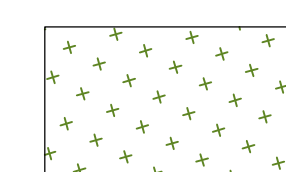


Mix of shrub, perennials and bulb planting to key corners visible to park users.
165 m²




Mix of native species - shrubs and climbers with thorns to act as defensive planting.
515 m²


Helix screw piles and RC ground beam.
Overall height 1220mm as existing fencing.

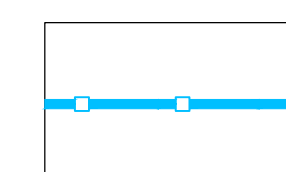

Basic screw piles with steel ground beam.
Overall height 1220mm as existing fencing.

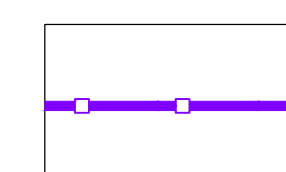

Pad Footings.
Overall height 1220mm as existing fencing.

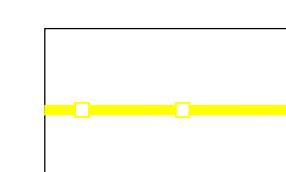

Screw Piles dependant on archaeologist input.
Overall height 750mm as existing fencing

Location of proposed Badger access.



Location of proposed hedgehog house.
Product to be chosen by Project Ecologist.

JIP	P04	Updates to tree removal strategy
JIP	P03	Additional scrub planting
AL	P02	Updated Tree Removals
AL	P01	Planning Condition Issue

WORK STAGE	ISSUED FOR	DRAWN BY
REVISION	DATE	CHECKED BY
Stage 4	Comment	JP

DRAWING NAME
Landscape Proposals Plan

DRAWING NUMBER
2407-CWS-XX-GF-DR-L-100

DRAWING SCALE

CLIENT
Manchester City Council

PROJECT NAME
Clayton Hall

CW Studio
Studio Nine
9 Stevenson Square
Manchester, M1 1DB
0161 464 3895
info@cwstudio.co.uk

