



The builder must check the site and the approved drawings before commencing the works and must take any working measurements as necessary. Any discrepancy in the drawing must be reported to the client .

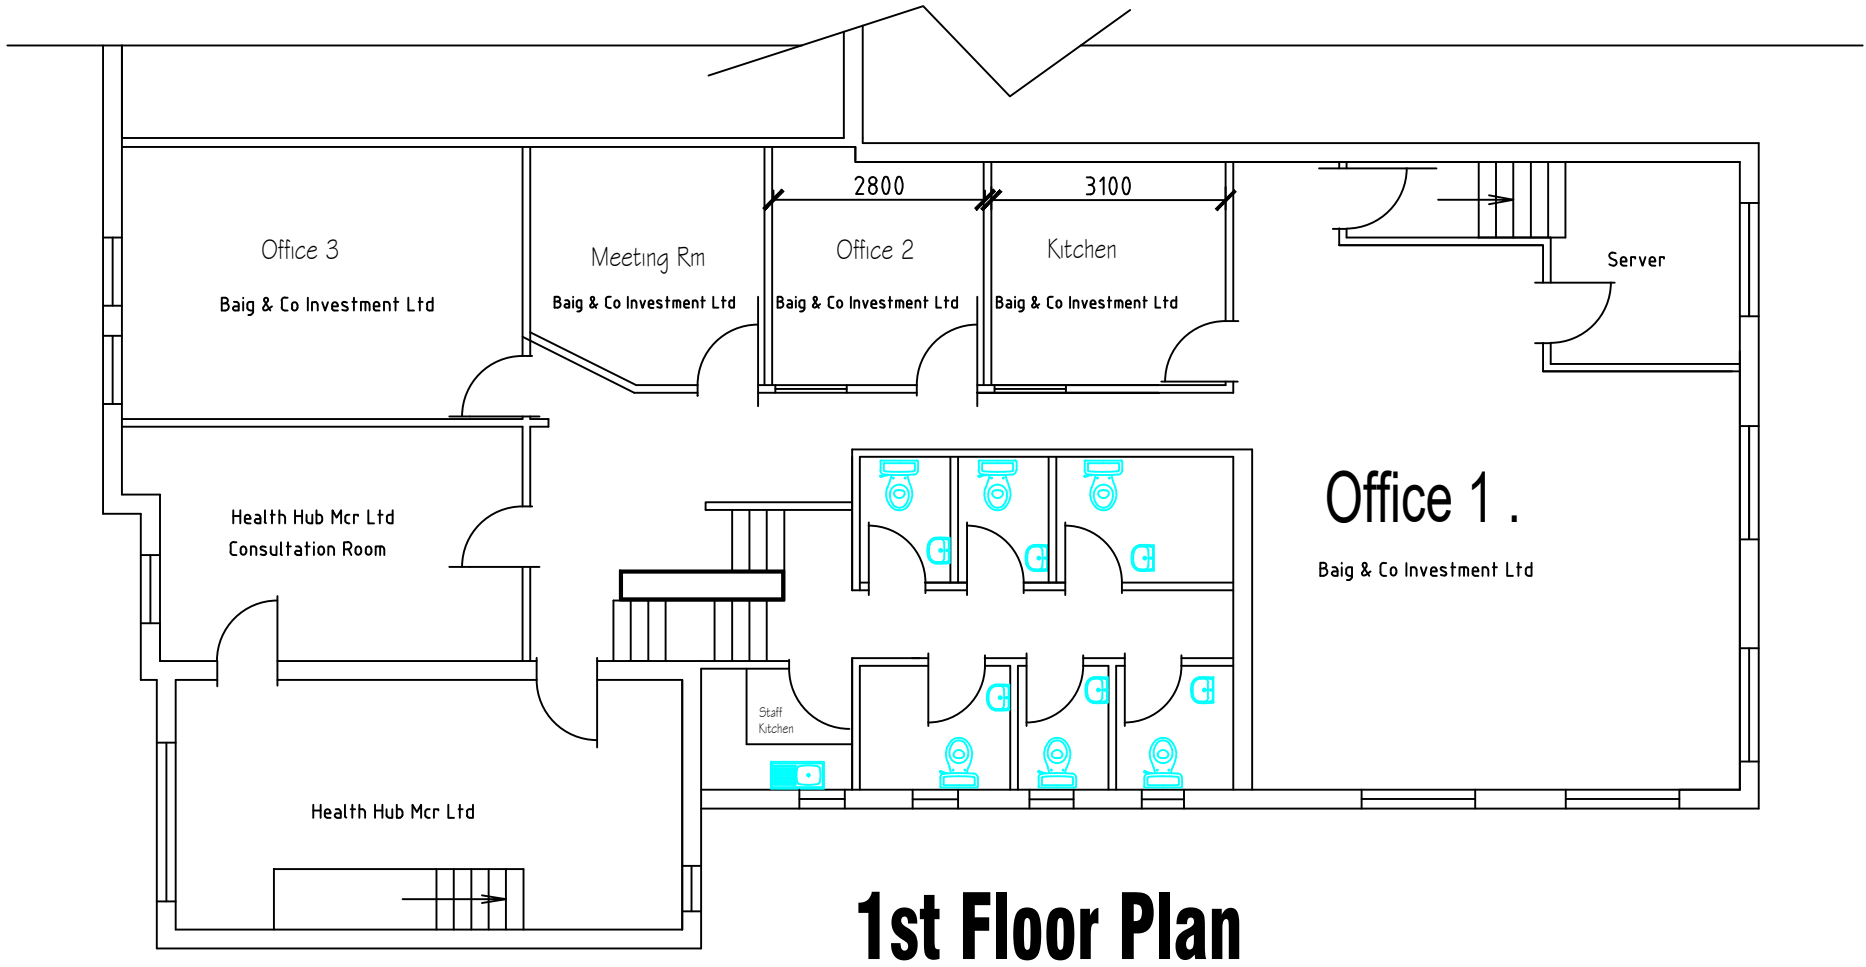

1st Floor Plan

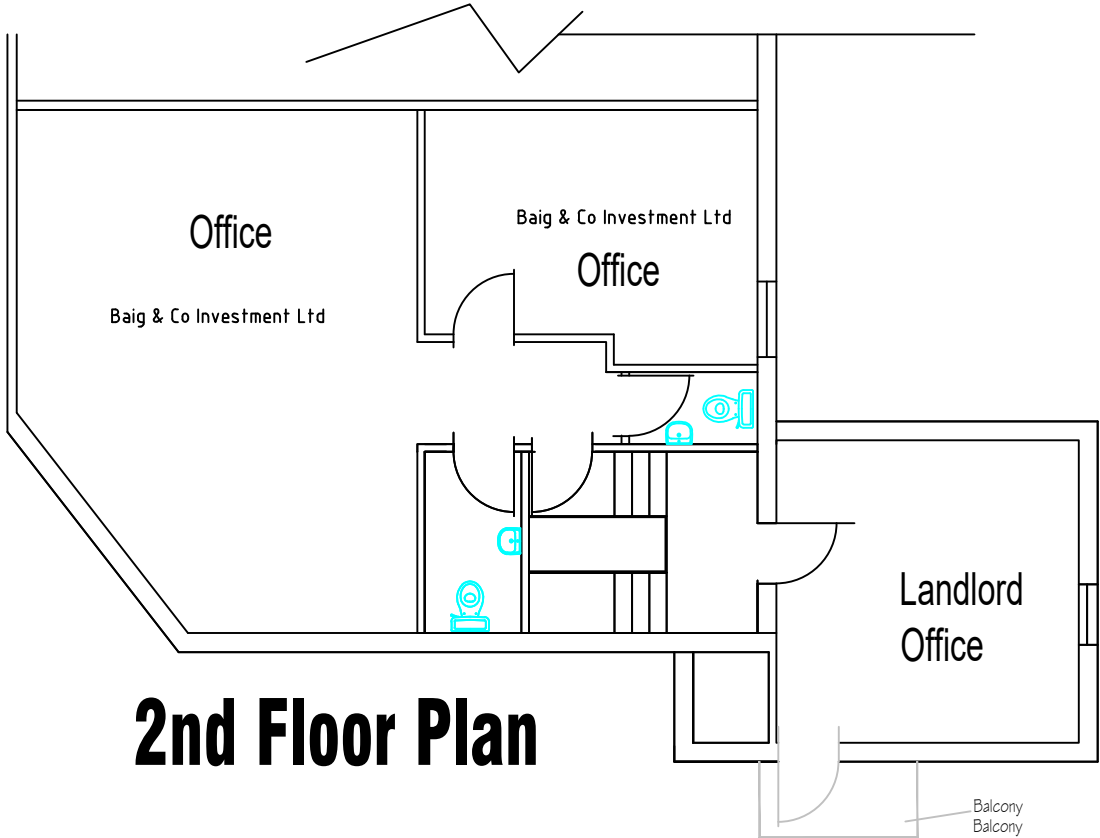

2nd Floor Plan

REVISION			initial
no.	date	description	
A	4.11.24	Planning	
B	28.03.25	Planning	
C	11.04.25	Planning	
D	17.04.25	Planning	

HSB
Engineering Design Services Ltd
428 Cheetham Hill Road Cheetham Manchester
M8 9LE, UK 01617956385,07940197333

project title	3no. class E units with ancillary accommodation at basement level and landlord office on second floor.		
client	Mr Mohammed Saddique		
dwg. title	"As Built 1st & 2nd Floor Plan"		
dwg.no.	sheet no.	scale.	job no.
23D		1:100 @A3	
443 Cheetham Hill Road Cheetham Manchester M8 0PF			
drawn by.	checked by.	approved by.	date
TZ		-	March 2023