


© COPYRIGHT Estates Directorate

Do not scale from drawings. Verify all dimensions on site prior to construction. This drawing is to be read in conjunction with all relevant documents and drawings. Report all discrepancies to Estates Directorate immediately. No unauthorised use, disclosure, storage or copying.

DRAWING NOTES
KEY INFORMATION ETC.

GIA: 1791.31

RESTRICTED

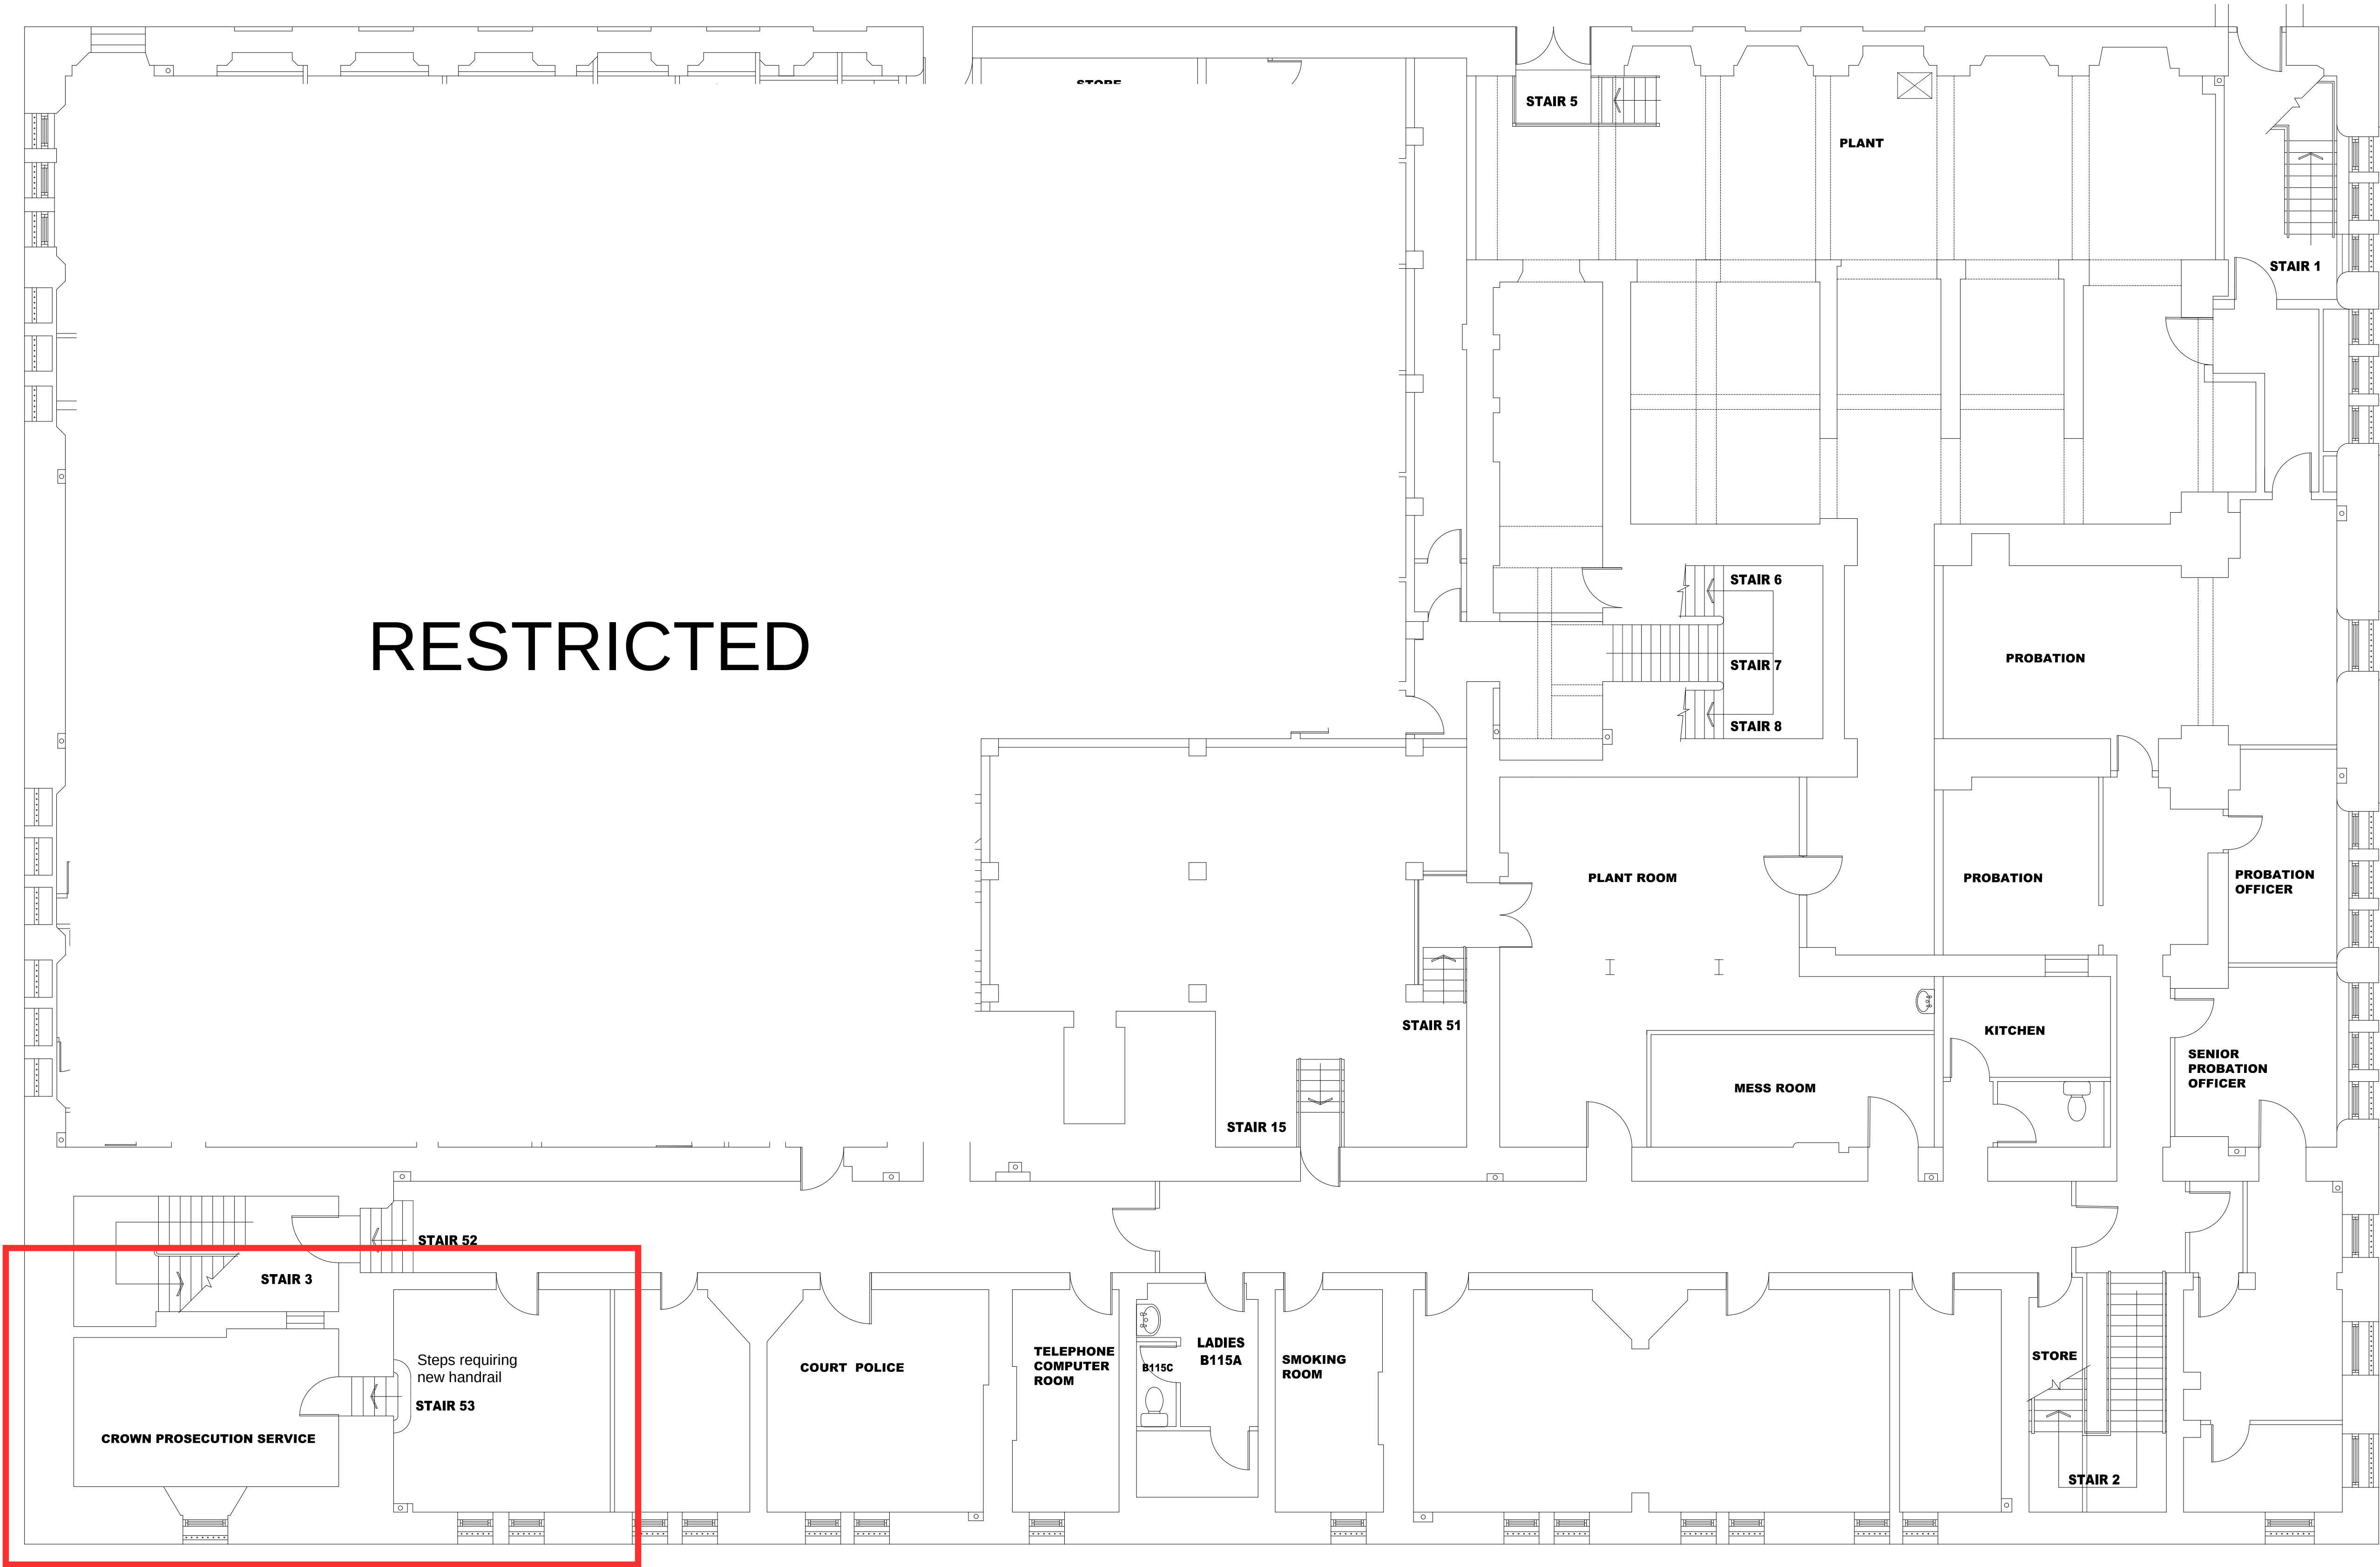

Location of CPS Room

AMENDMENTS DATE

		Estates Directorate 102 Petty France London SW1H 9AJ			
Site		Manchester Crown Court Minshull Street Old Building			
Security Classification		OFFICIAL			
Drawing Number		326944-0000-MoJ-OLD-B1-DR-A-0001-CR-02-0D100			
Project Name if applicable		Record Drawing			
Dwg Title		Basement Layout			
E-PIMS		326944	BPRN No. if applicable	0000	Rev Ref 02
Drawn By: MB		DATE: 26/03/2018		SCALE	NTS