


SITE LOCATION
(Scale 1:50000)
Ordnance Survey map extract
based upon Landranger map series
with the permission of the controller of
Her Majesty's Stationery Office
Licence No. 0100023487
Crown copyright.



SITE PHOTOGRAPH


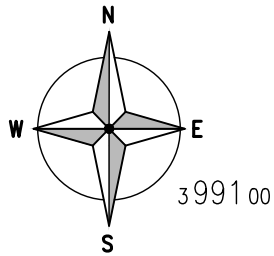


3991 00

3990 00


3855 00

3856 00

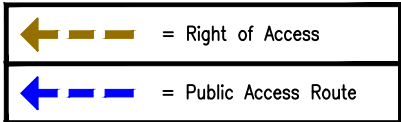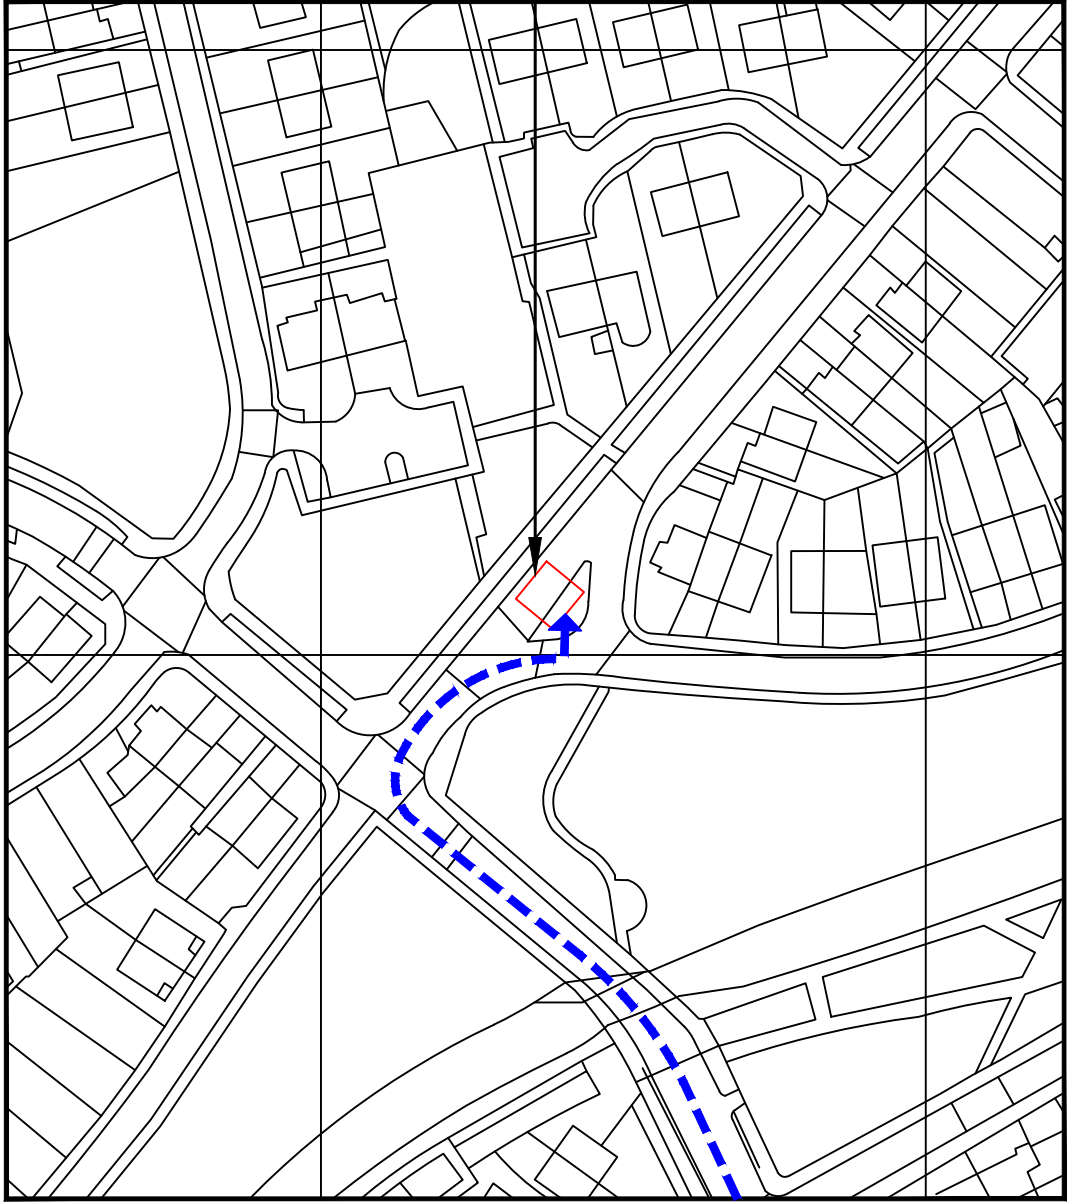

DETAILED SITE LOCATION
(Scale 1:1250)

Based upon Ordnance Survey map extract
with the permission of the Controller of
Her Majesty's Stationery Office.
Crown copyright.
Licence No. 100020449

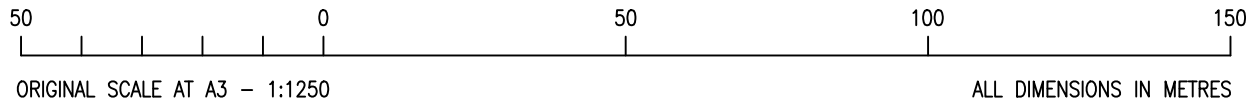

ALL DIMENSIONS ARE IN mm UNLESS NOTED OTHERWISE

N.G.R | E: 385539 | N: 399011

DIRECTIONS TO SITE:

FROM A635(M), MANCHESTER, UK, TAKE RING Rd.
TO EVERY St, HEAD WEST ON A57(M)/A635(M),
TAKE THE A5103 EXIT TOWARD PETERSFIELD, AT THE
ROUNDBOUT, TAKE THE 4th eXIT ONTO THE RING
RD/A57(M)/A635 RAMP TO
ASHTON-UNDER-LYNE/SHEFFIELD/PICCADILLY, MERGE
WITH RING Rd./A57(M), CONTINUE ONTO MANCUNIAN
Wy./RING Rd./A635, CONTINUE ON EVERY St. TAKE
CARRUTHERS St AND BUTLER St TO LOWER VICKERS
St, TURN RIGHT ONTO EVERY St, TURN LEFT ONTO
CARRUTHERS St, TURN RIGHT ONTO OLD MILL St,
TURN LEFT ONTO BUTLER St, TURN RIGHT ONTO
LOWER VICKERS St, DESTINATION WILL BE ON THE
LEFT

NOTES:

A	As Built Issue	ARA	LN	12.02.25
REV	MODIFICATION	BY	CH	DATE



vodafone
CORNERSTONE - BEACON



Cell Name			Opt.
LOWER VICKERS STREET SW 1			-
Cell ID No			
CORNERSTONE	TEF	VF	
30683700	-	21730	

Site Address / Contact Details

LOWER VICKERS STREET
COLLYHURST
MANCHESTER
GREATER MANCHESTER
M40 7LX


Drawing Title:				
SITE LOCATION MAPS				
Purpose of issue:				Dwg Rev:
AS-BUILT				
Drawing Number:				A
100				
Surveyed By:		Original Sheet Size:		Pack Issue:
MITIE		A3		
Drawn:	Date:	Checked:	Date:	A
ARA	12.02.25	LN	12.02.25	

The drawings comply with TEF & Vodafone Standard ICNIRP guidelines.
Designed in accordance with Cornerstone document: SDN0008 & SDN009

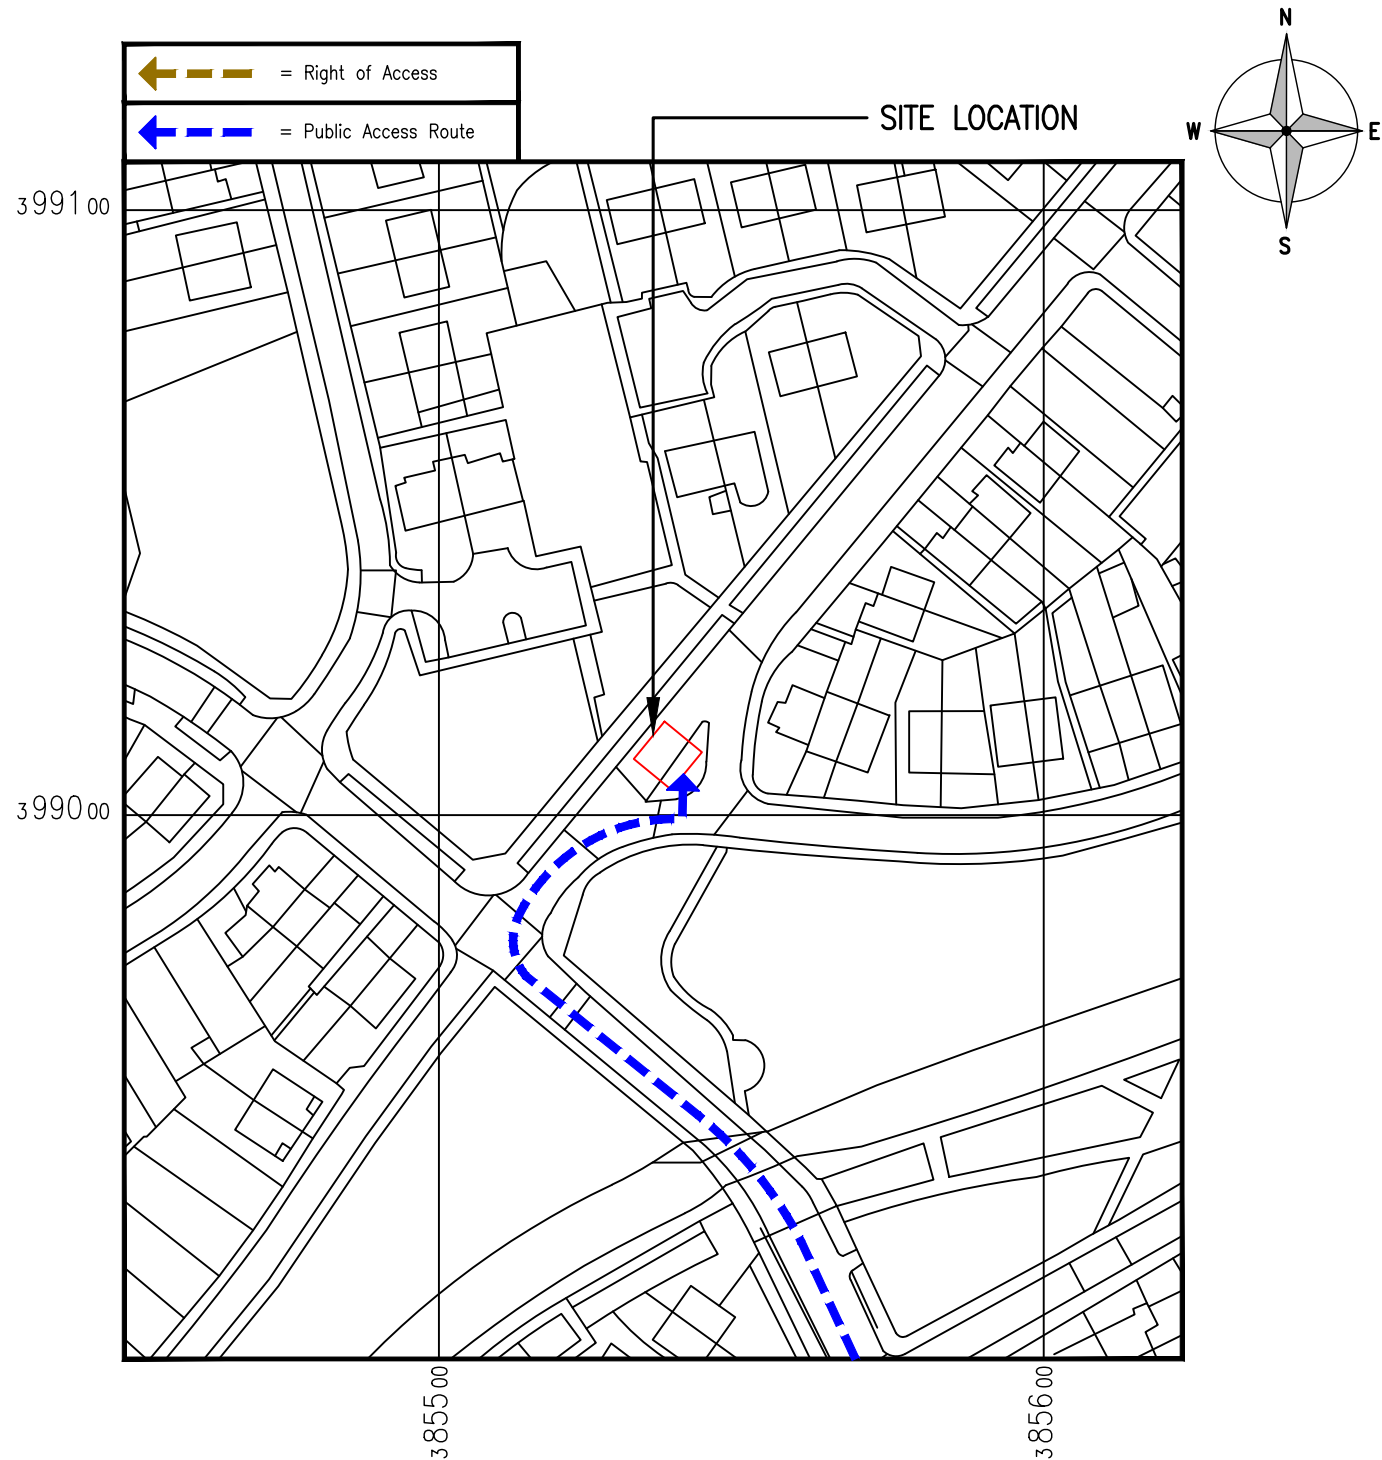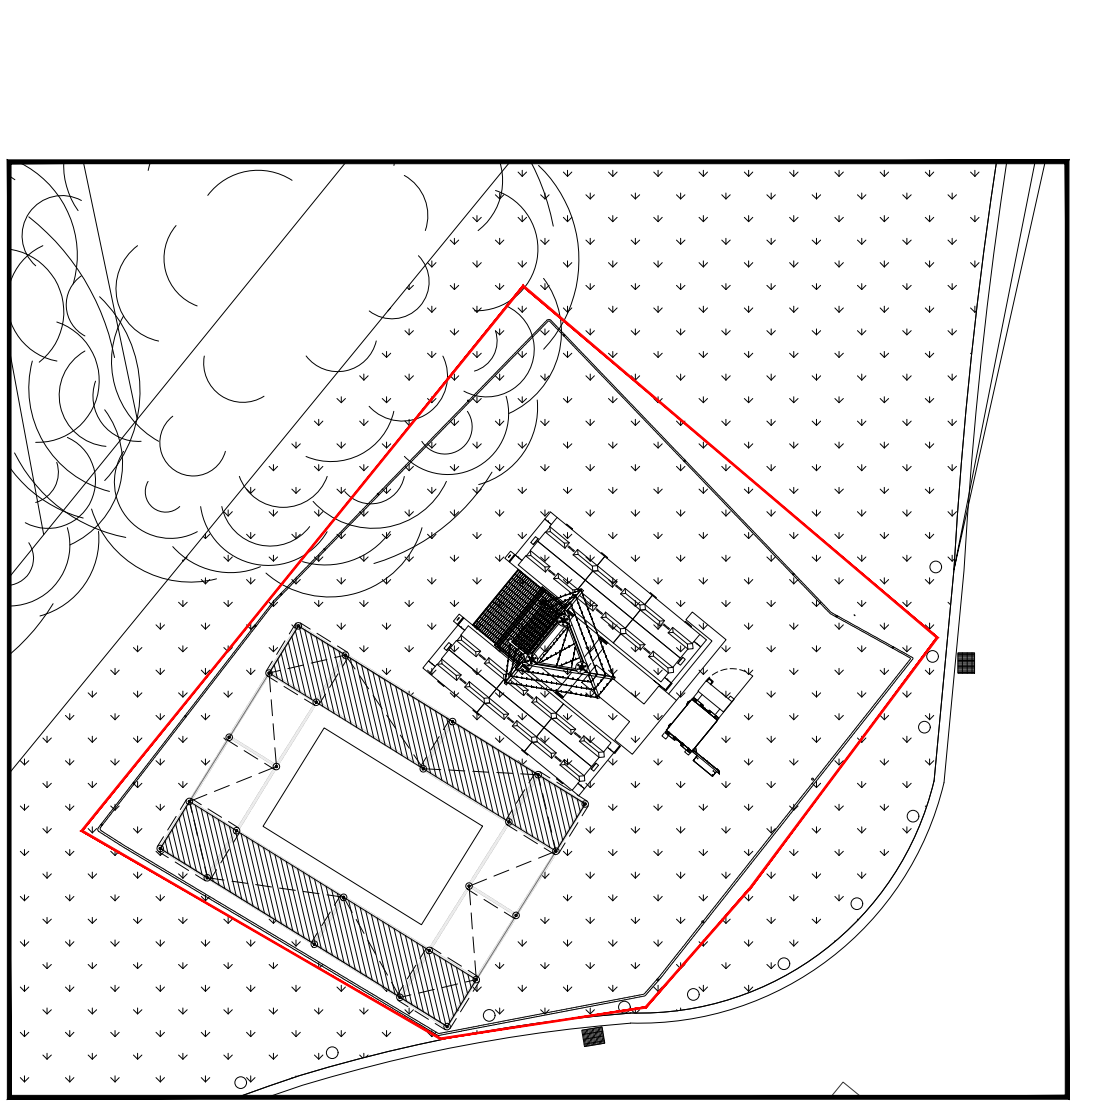

DETAILED SITE LOCATION
(Scale 1:1250)

Based upon Ordnance Survey map extract
with the permission of the Controller of
Her Majesty's Stationery Office.
Crown copyright.
Licence No. 100020449

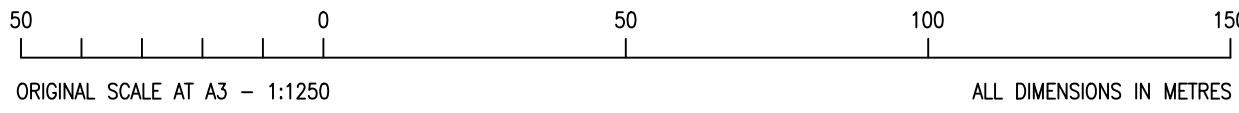

The drawings comply with TEF & Vodafone Standard ICNIRP guidelines.
Designed in accordance with Cornerstone document: SDN0008 & SDN009

ALL DIMENSIONS ARE IN mm UNLESS NOTED OTHERWISE

N.G.R	E: 385539	N: 399011
-------	-----------	-----------

DIRECTIONS TO SITE:


FROM A635(M), MANCHESTER, UK, TAKE RING Rd. TO EVERY St, HEAD WEST ON A57(M)/A635(M), TAKE THE A5103 EXIT TOWARD PETERSFIELD, AT THE ROUNDABOUT, TAKE THE 4th exit ONTO THE RING RD/A57(M)/A635 RAMP TO ASHTON-UNDER-LYNE/SHEFFIELD/PICCADILLY, MERGE WITH RING Rd./A57(M), CONTINUE ONTO MANCUNIAN Wy./RING Rd./A635, CONTINUE ON EVERY St. TAKE CARRUTHERS St AND BUTLER St TO LOWER VICKERS St, TURN RIGHT ONTO EVERY St, TURN LEFT ONTO CARRUTHERS St, TURN RIGHT ONTO OLD MILL St, TURN LEFT ONTO BUTLER St, TURN RIGHT ONTO LOWER VICKERS St, DESTINATION WILL BE ON THE LEFT

NOTES:

A	As Built	Issue	ARA	LN	12.02.25
REV	MODIFICATION		BY	CH	DATE

CORNERSTONE - BEACON

Cell Name		Opt.
LOWER VICKERS STREET SW 1		-
Cell ID No		
CORNERSTONE	TEF	VF
30683700	-	21730
Site Address / Contact Details		
LOWER VICKERS STREET COLLYHURST MANCHESTER GREATER MANCHESTER M40 7LX		
Drawing Title: LEASE DRAWING		
Purpose of issue: AS-BUILT		Dwg Rev:
Drawing Number: 101		A
Surveyed By: MITIE		Original Sheet Size: A3
Drawn: ARA	Date: 12.02.25	Checked: LN
Date: 12.02.25		Pack Issue: A

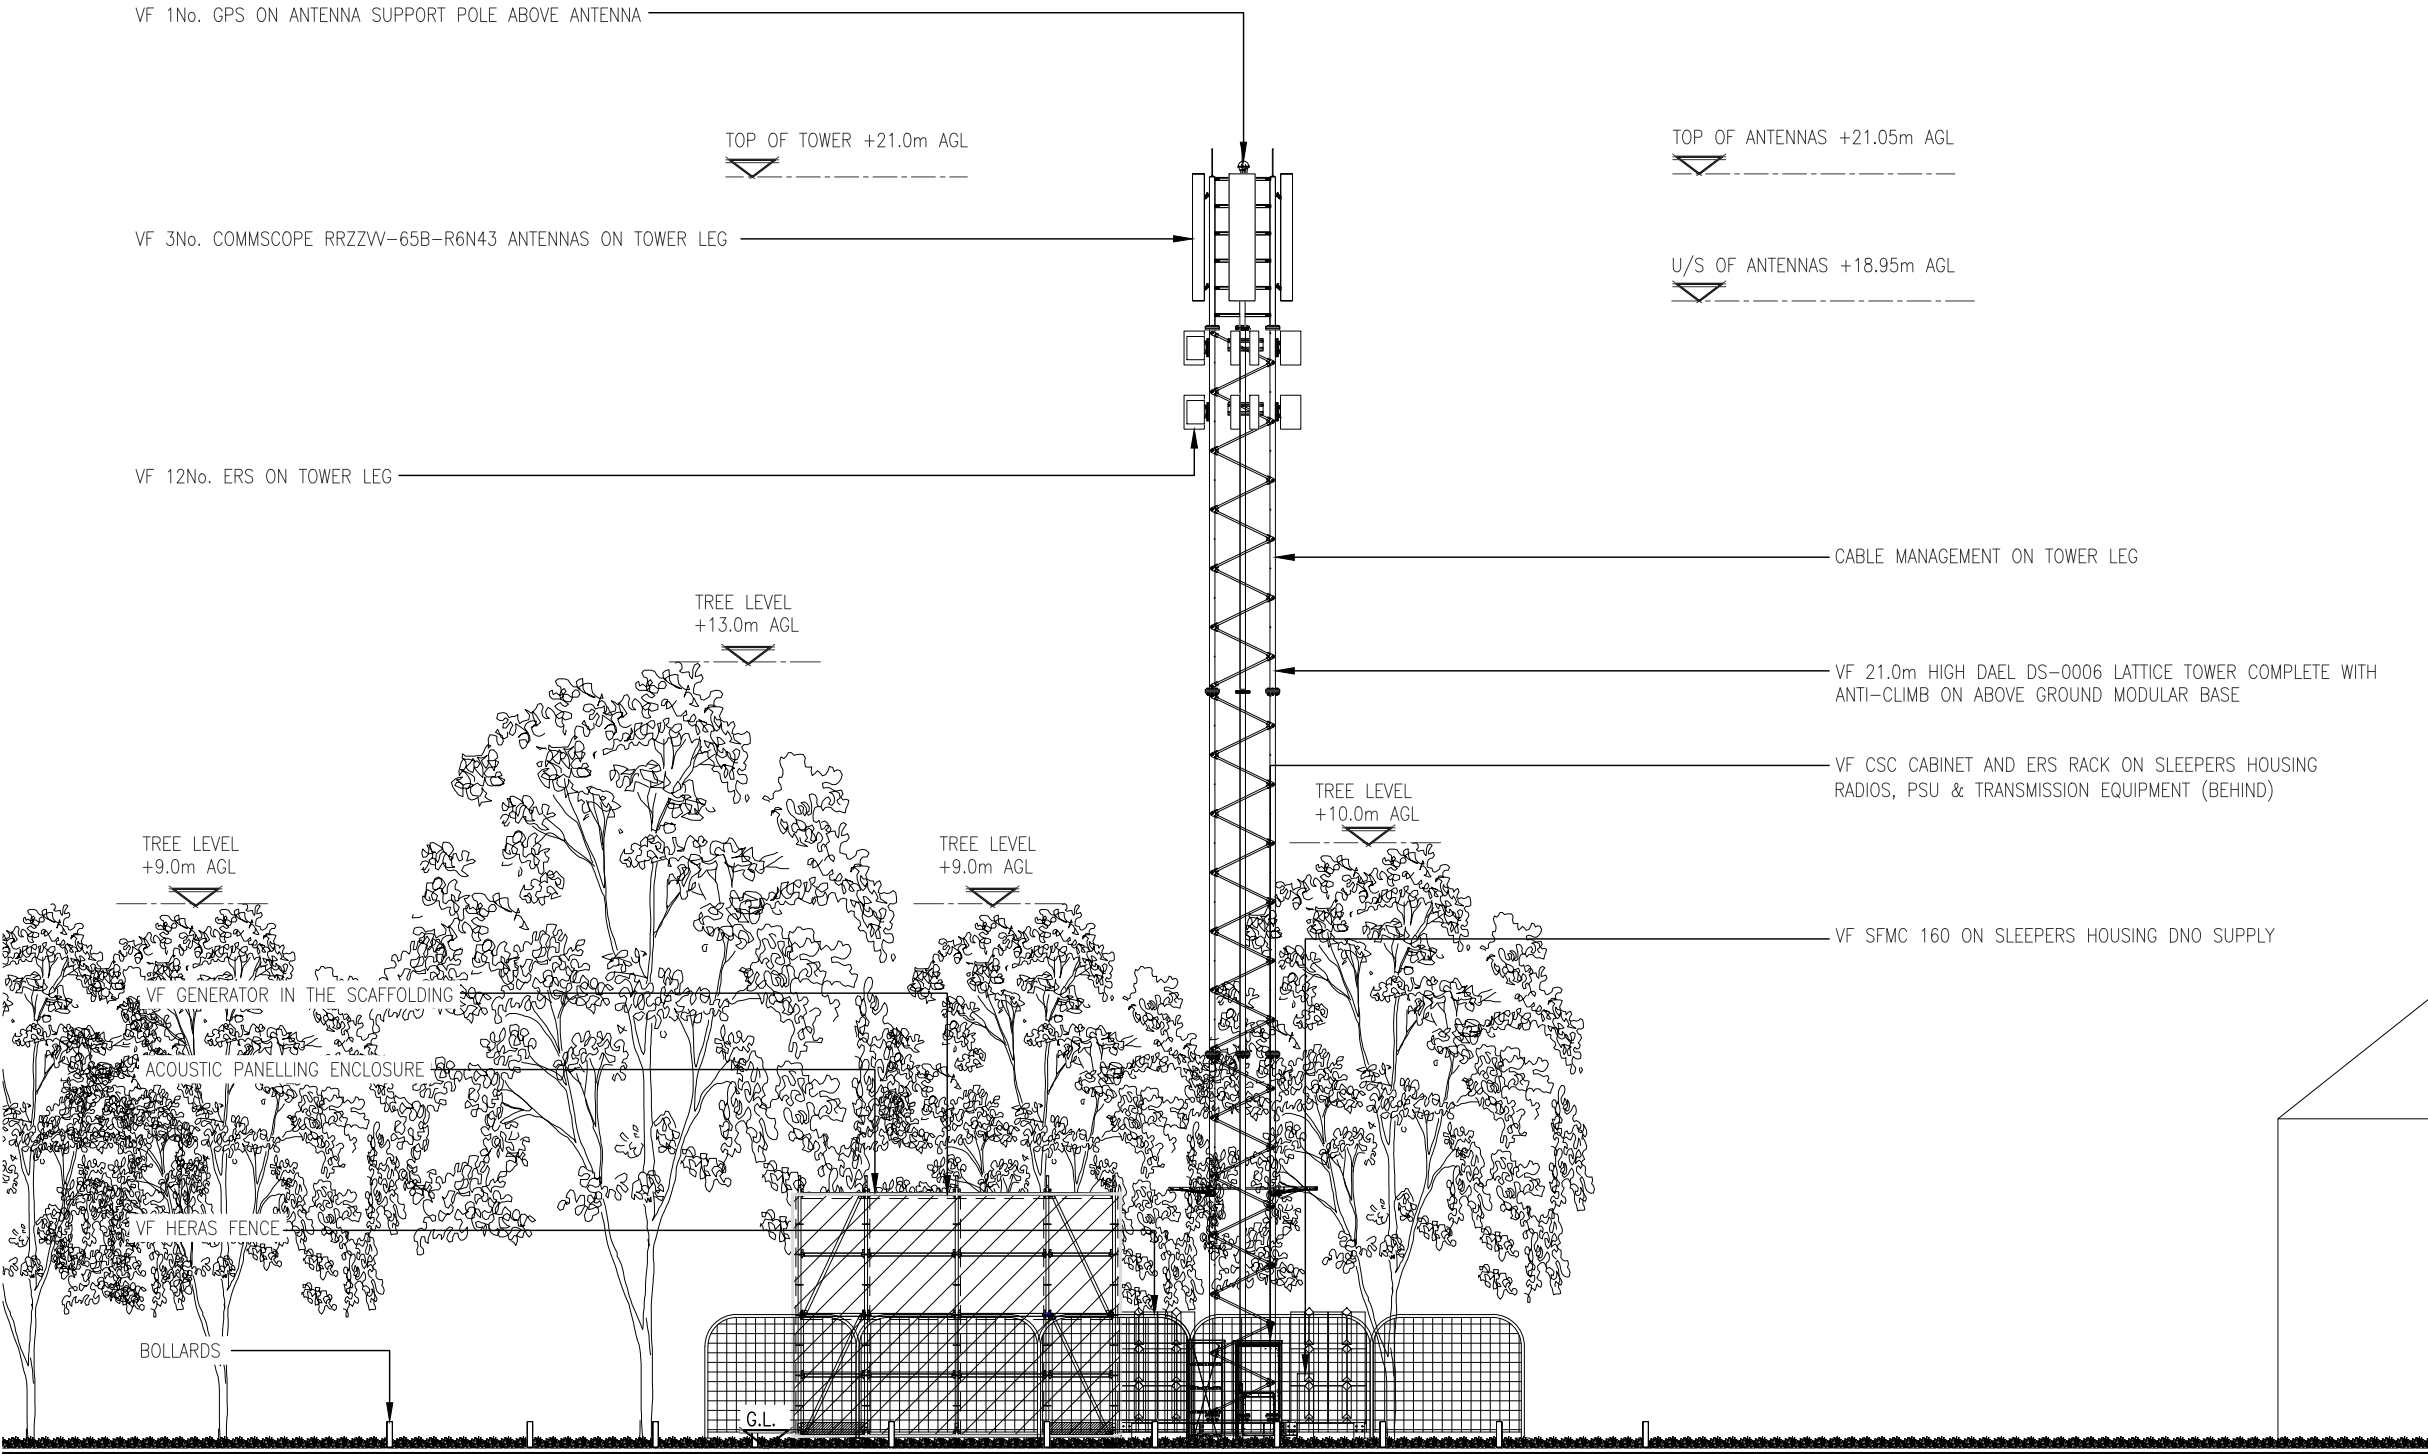

The drawings comply with TEF & Vodafone Standard ICNIRP guidelines.
Designed in accordance with Cornerstone document: SDN0008 & SDN009

ORIGINAL SCALE AT A3 – 1:125
ALL DIMENSIONS IN MILLIMETRES

ALL DIMENSIONS ARE IN mm UNLESS NOTED OTHERWISE

N.G.R | E: 385539 | N: 399011

NOTES:

A	As Built Issue	ARA	LN	12.02.25
REV	MODIFICATION	BY	CH	DATE



Cell Name			Opt.
LOWER VICKERS STREET SW 1			–
Cell ID No			
CORNERSTONE	TEF	VF	
30683700	–	21730	

Site Address / Contact Details		
LOWER VICKERS STREET COLLYHURST MANCHESTER GREATER MANCHESTER M40 7LX		

Drawing Title:					SITE ELEVATION			
Purpose of issue:				AS-BUILT		Dwg Rev:		
Drawing Number:				300		A		
Surveyed By:			MITIE		Original Sheet Size:		Pack Issue:	
Drawn:			Date:		Checked:		Date:	
ARA			12.02.25		LN		12.02.25	
							A	