




First Floor Plan
145.26 sqm (1563.5 sq ft)

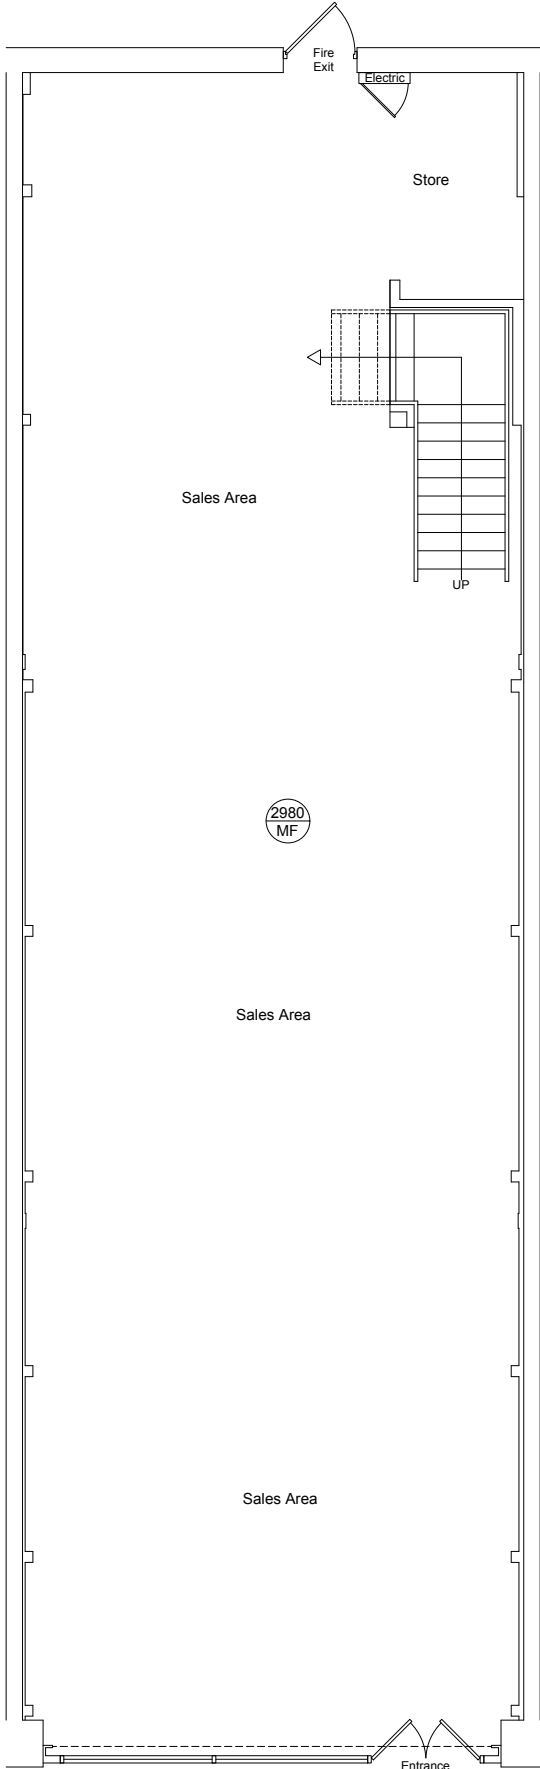

Ground Floor Plan
157.85 sqm (1699.1 sq ft)

Total Floor Area
303.11 sqm (3262.6 sq ft)

© Copyright Heavenly Desserts Ltd

This intellectual property in any design or other work is the property of Heavenly Desserts Ltd. No part of this design shall be copied or reproduced without prior permission of Heavenly Desserts Ltd.

DRAWING CHECKED & APPROVED BY

Signed

Company

Date

REVISIONS

NO DIMENSIONS TO BE SCALED FROM THIS DRAWING

THIS DRAWING TO BE READ IN CONJUNCTION WITH THE FOLLOWING DRAWINGS :-

HEAVENLY
DESSERTS
2008

SITE
MANCHESTER - CHEETHAM HILL

SITE ADDRESS
40 BURY OLD ROAD, (UNIT 2)
CHEETHAM HILL SHOPPING CENTER
MANCHESTER, M8 5DP

DRAWING TITLE
AS BUILT

SCALE
DRAWN BY
DRAWING
NUMBER

DATE
17/03/2025

CHECKED BY
REV