
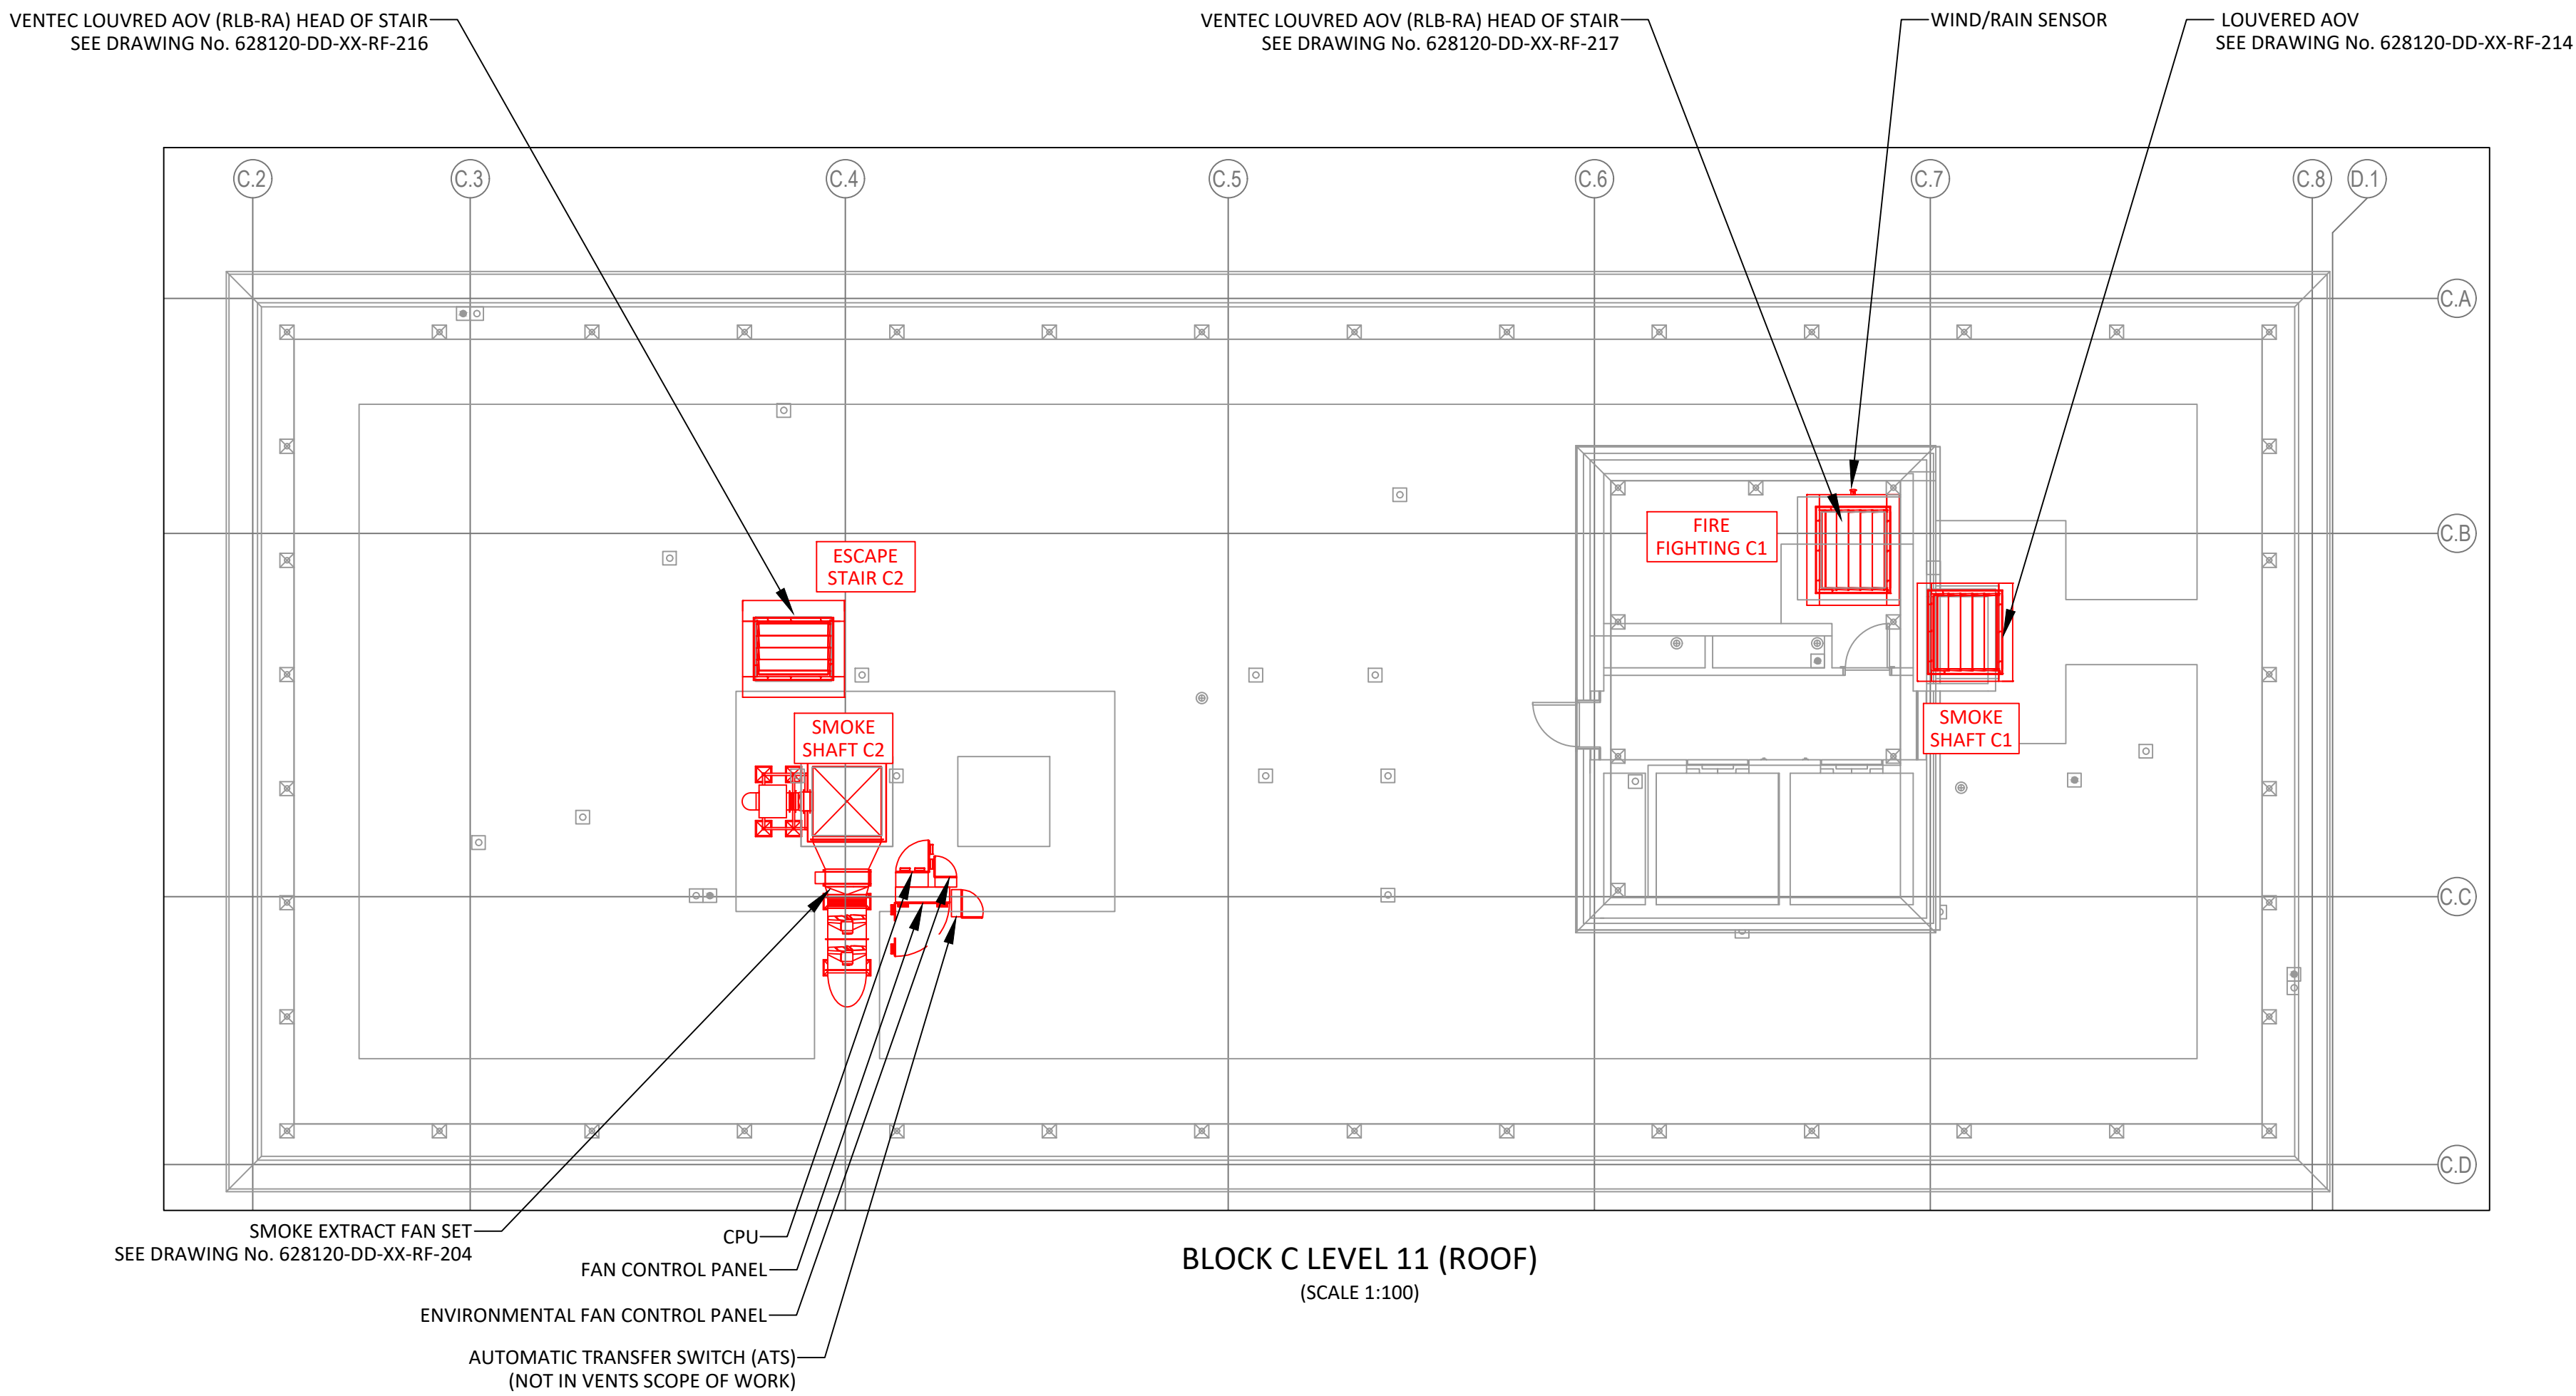


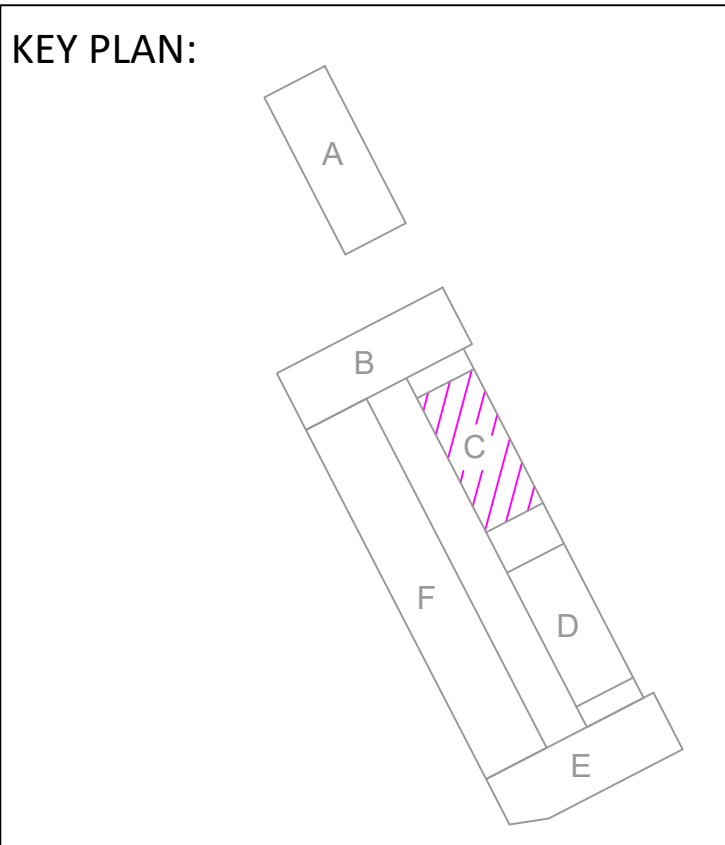

ALL DIMENSIONS ARE IN MILLIMETRES
IF IN DOUBT ASK

NOTE:
THE SMOKE SHAFT IS A BUILDERS WORK RISER (NOT IN VENT'S SCOPE OF WORKS). IT MUST BE TO THE AGREED DIMENSIONS, WITH A SMOOTH INTERNAL FINISH & SUFFICIENTLY SEALED TO LIMIT THE LEAKAGE RATE TO 3.8m³/h/m² AT 50 Pa. NO OTHER BUILDING SERVICES SHOULD BE CONTAINED WITHIN THE SMOKE SHAFT.

AB0	17.10.24	AS BUILT	CR13	HW	AJM
CO0	10.10.24	CONSTRUCTION ISSUE	CR09	HW	AJM
R02	23.08.24	UPSTAND SIZES UPDATED HEAD OF STAIR NO. UPDATED	CR06/07	MC	AJM
R01	01.03.24	HEAD OF STAIR ACCESS ADV & INLET SHAFT UPDATED WITH NEW NUMBER	CR03 & CR04	RA	AJM
R00	11.01.24	FIRST ISSUE FOR APPROVAL		RA	AM
REV	DATE	DETAILS	DRW BY	CHK BY	

DRAWING REVISION DETAILS



VENTEC HOUSE
UNIT 16 CHALWYN INDUSTRIAL ESTATE
POOLE, DORSET. BH12 4PE
TEL. +44(0)1202 744958
www.vent.co.uk

© 2023 Ventec 100 Ltd

CLIENT:
MATIC BUILDING SERVICES LTD

PROJECT:
WATERHOUSE GARDENS
MANCHESTER

SALES ORDER No:
628120

DRAWING TITLE:
FLOOR PLAN FOR BLOCK C
LEVEL 11 (ROOF)

DRAWING STATUS:
☐ APPROVAL
☐ CONSTRUCTION
☒ AS BUILT

DRAWN: DATE: 11.01.24 SCALE: SHEET: AS SHOWN A1

DRAWING No. 628120-FP-BC-RF-115 REV: AB0

BACKGROUND DETAIL TAKEN FROM: Architects 'Studio Power'
Drawing No. 0022-SP-B3-02-DR-A-03311 REV: T1