


SCALE
0m 1m 2m 3m 4m 5m 6m 7m 8m 9m 10m

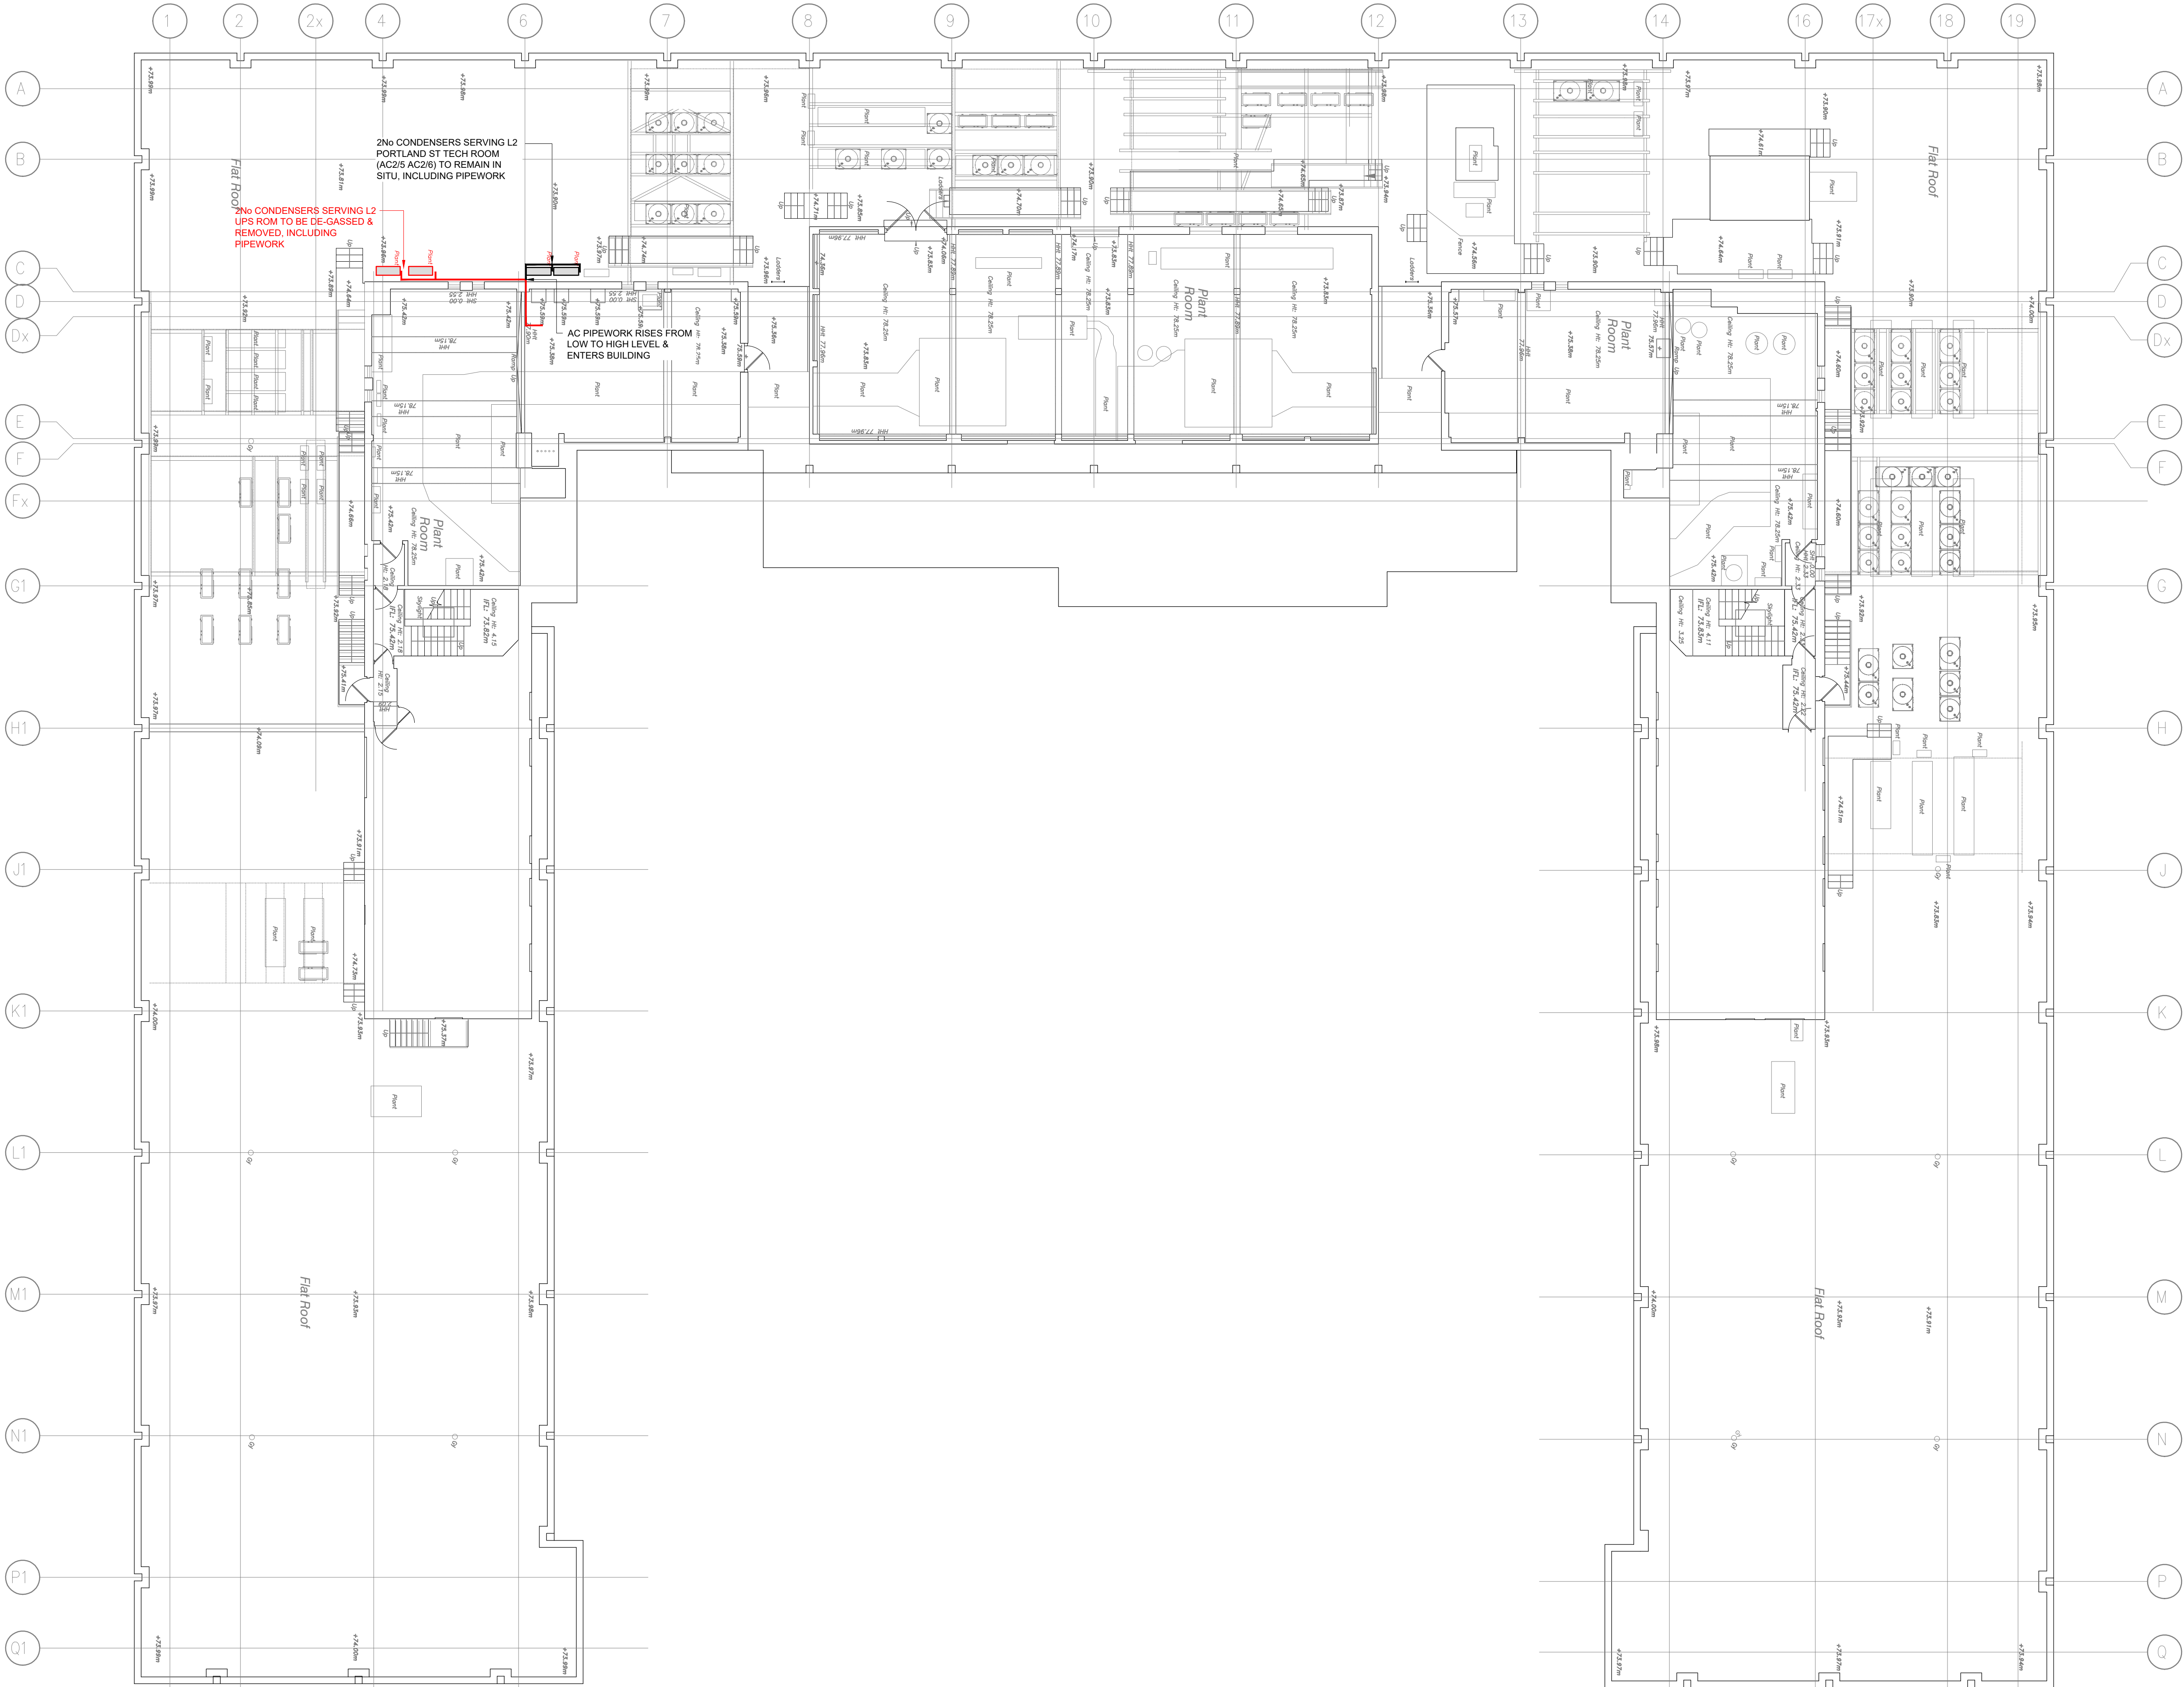

NOTES:

1. THIS DRAWING TO BE READ IN CONJUNCTION WITH ALL CONSTRUCTION ISSUED PROJECT INFORMATION - DRAWINGS, REPORTS AND SPECIFICATIONS.

P02	AC PIPEWORK INDICATED	GD	16/1/25
P01	FIRST ISSUE	GD	20/12/24

CONTRACTORS PROPOSAL

DL PROJECT No

C/24/4076

DL

M&E BUILDING SERVICES LTD

info@dl-bsl.co.uk

01942 842 507

King House,
Stotts Park,
James Street,
Westthroughton,
Bolton. BL5 3QR

dl-bsl.co.uk

THIS DRAWING IS THE PROPERTY OF
DL M&E BUILDING SERVICES LIMITED.
AND MUST NOT BE COPIED OR
REPRODUCED WITHOUT
THE PERMISSION IN WRITING OF
DL M&E BUILDING SERVICES LIMITED.

QMS

ISO
9001 : 2015
REGISTERED

LLOYDS BANKING GROUP

ALL DIMENSIONS TO BE VERIFIED PRIOR TO COMMENCING WORK. DRAWING TO BE READ IN CONJUNCTION WITH PROJECT SPECIFICATIONS.

THIS DRAWING IS THE PROPERTY OF LLOYDS BANKING GROUP AND COPYRIGHT IS RESERVED BY THEM. THE DRAWING IS ISSUED ON CONDITION THAT IT IS NOT COPIED OR DISCLOSED BY OR TO ANY UNAUTHORISED PERSONS WITHOUT PRIOR CONSENT IN WRITING TO LLOYDS BANKING GROUP. GROUP PROPERTY. ALL MODIFIED DRAWINGS SHOULD BE RETURNED TO LLOYDS BANKING GROUP. THIS STATEMENT APPLIES ONLY WHEN RECORD DRAWINGS ARE COMPLETED.

GROUP PROPERTY

BRISTOL - PO Box 112, Canons House, Canons Way, BRISTOL, BS99 7LB
EDINBURGH - Sighthill South, 12 Bankhead Crossway South, EDINBURGH, EH11 4EN
HALIFAX - Trinity Road, HALIFAX, West Yorkshire, HX1 2RG

PROJECT ADDRESS Corporate 11 Portland Street Manchester M1 3HU	SCALE A1 - 1:125
DRAWING DESCRIPTION Roof Mechanical Services Condenser Strip-Out	DATE Dec 2024
DRAWING NUMBER 50960488-LBG-CP-02-M2-ML-2701	DRAWN BY GD
	REVISION P02