
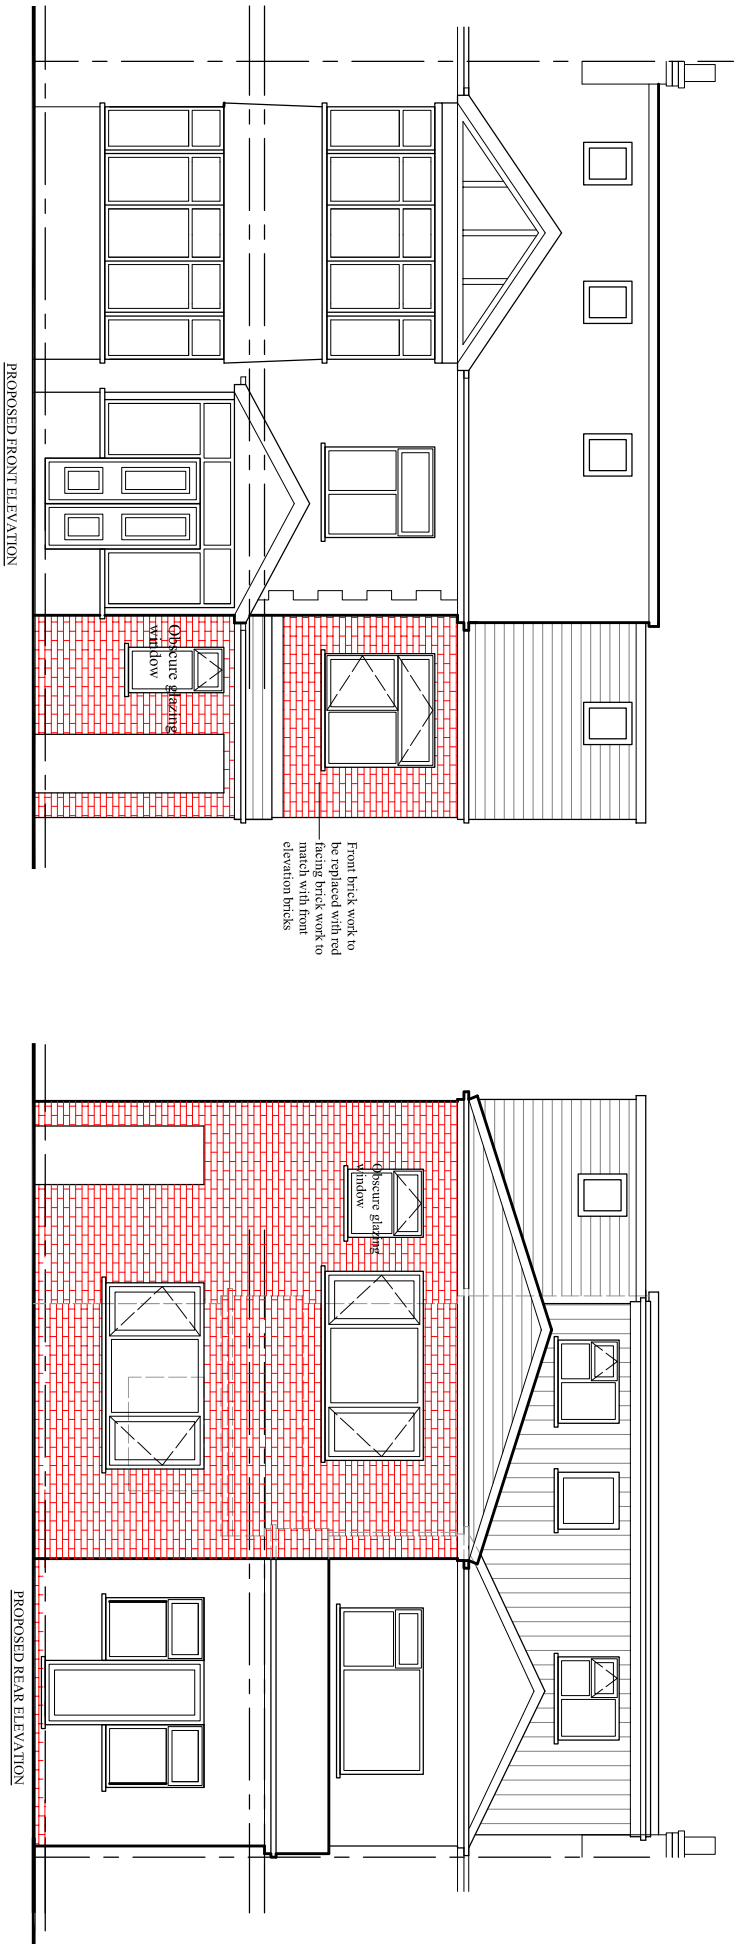


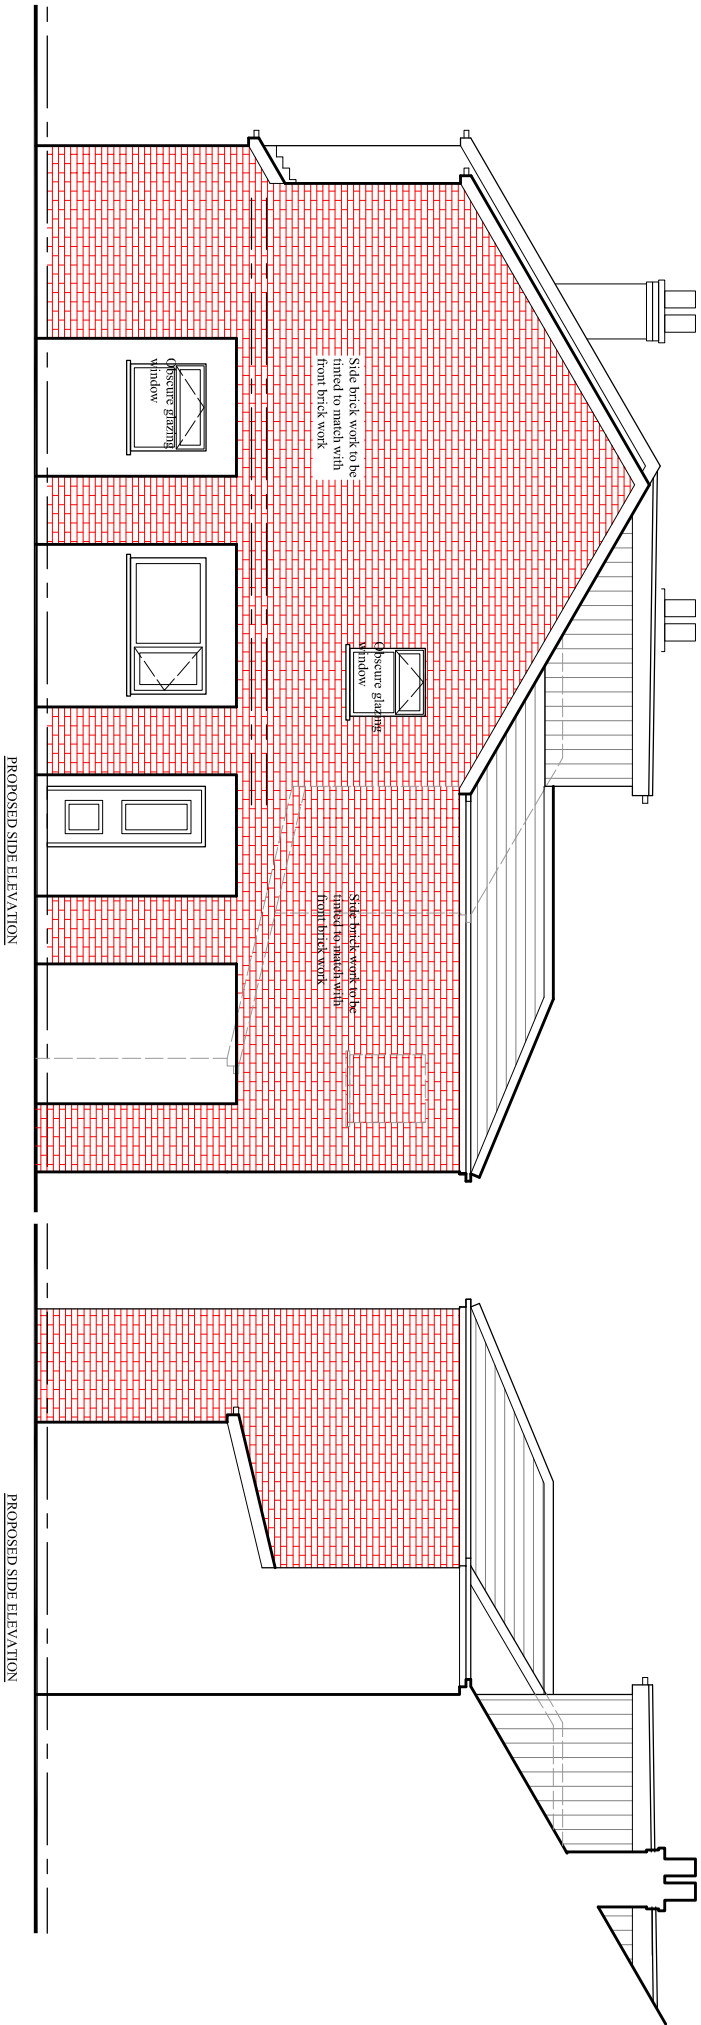

Rev. C. 17.01.25 Part dormer removed
Rev. B. 15.01.25 FF front setback
Rev. A. 18.11.24 As built plans

PROJECT
4, St Brannocks Road,
Chorton

CLIENT

DRAWING TITLE
Proposed Elevation

JOB No DRAWING No
NA-P03

SCALE DATE REVISION
1:100@A3 May 2015
DRAWN CHECKED BY
NA C

t: 0782 895 3405
e: niamat@hotmail.co.uk