




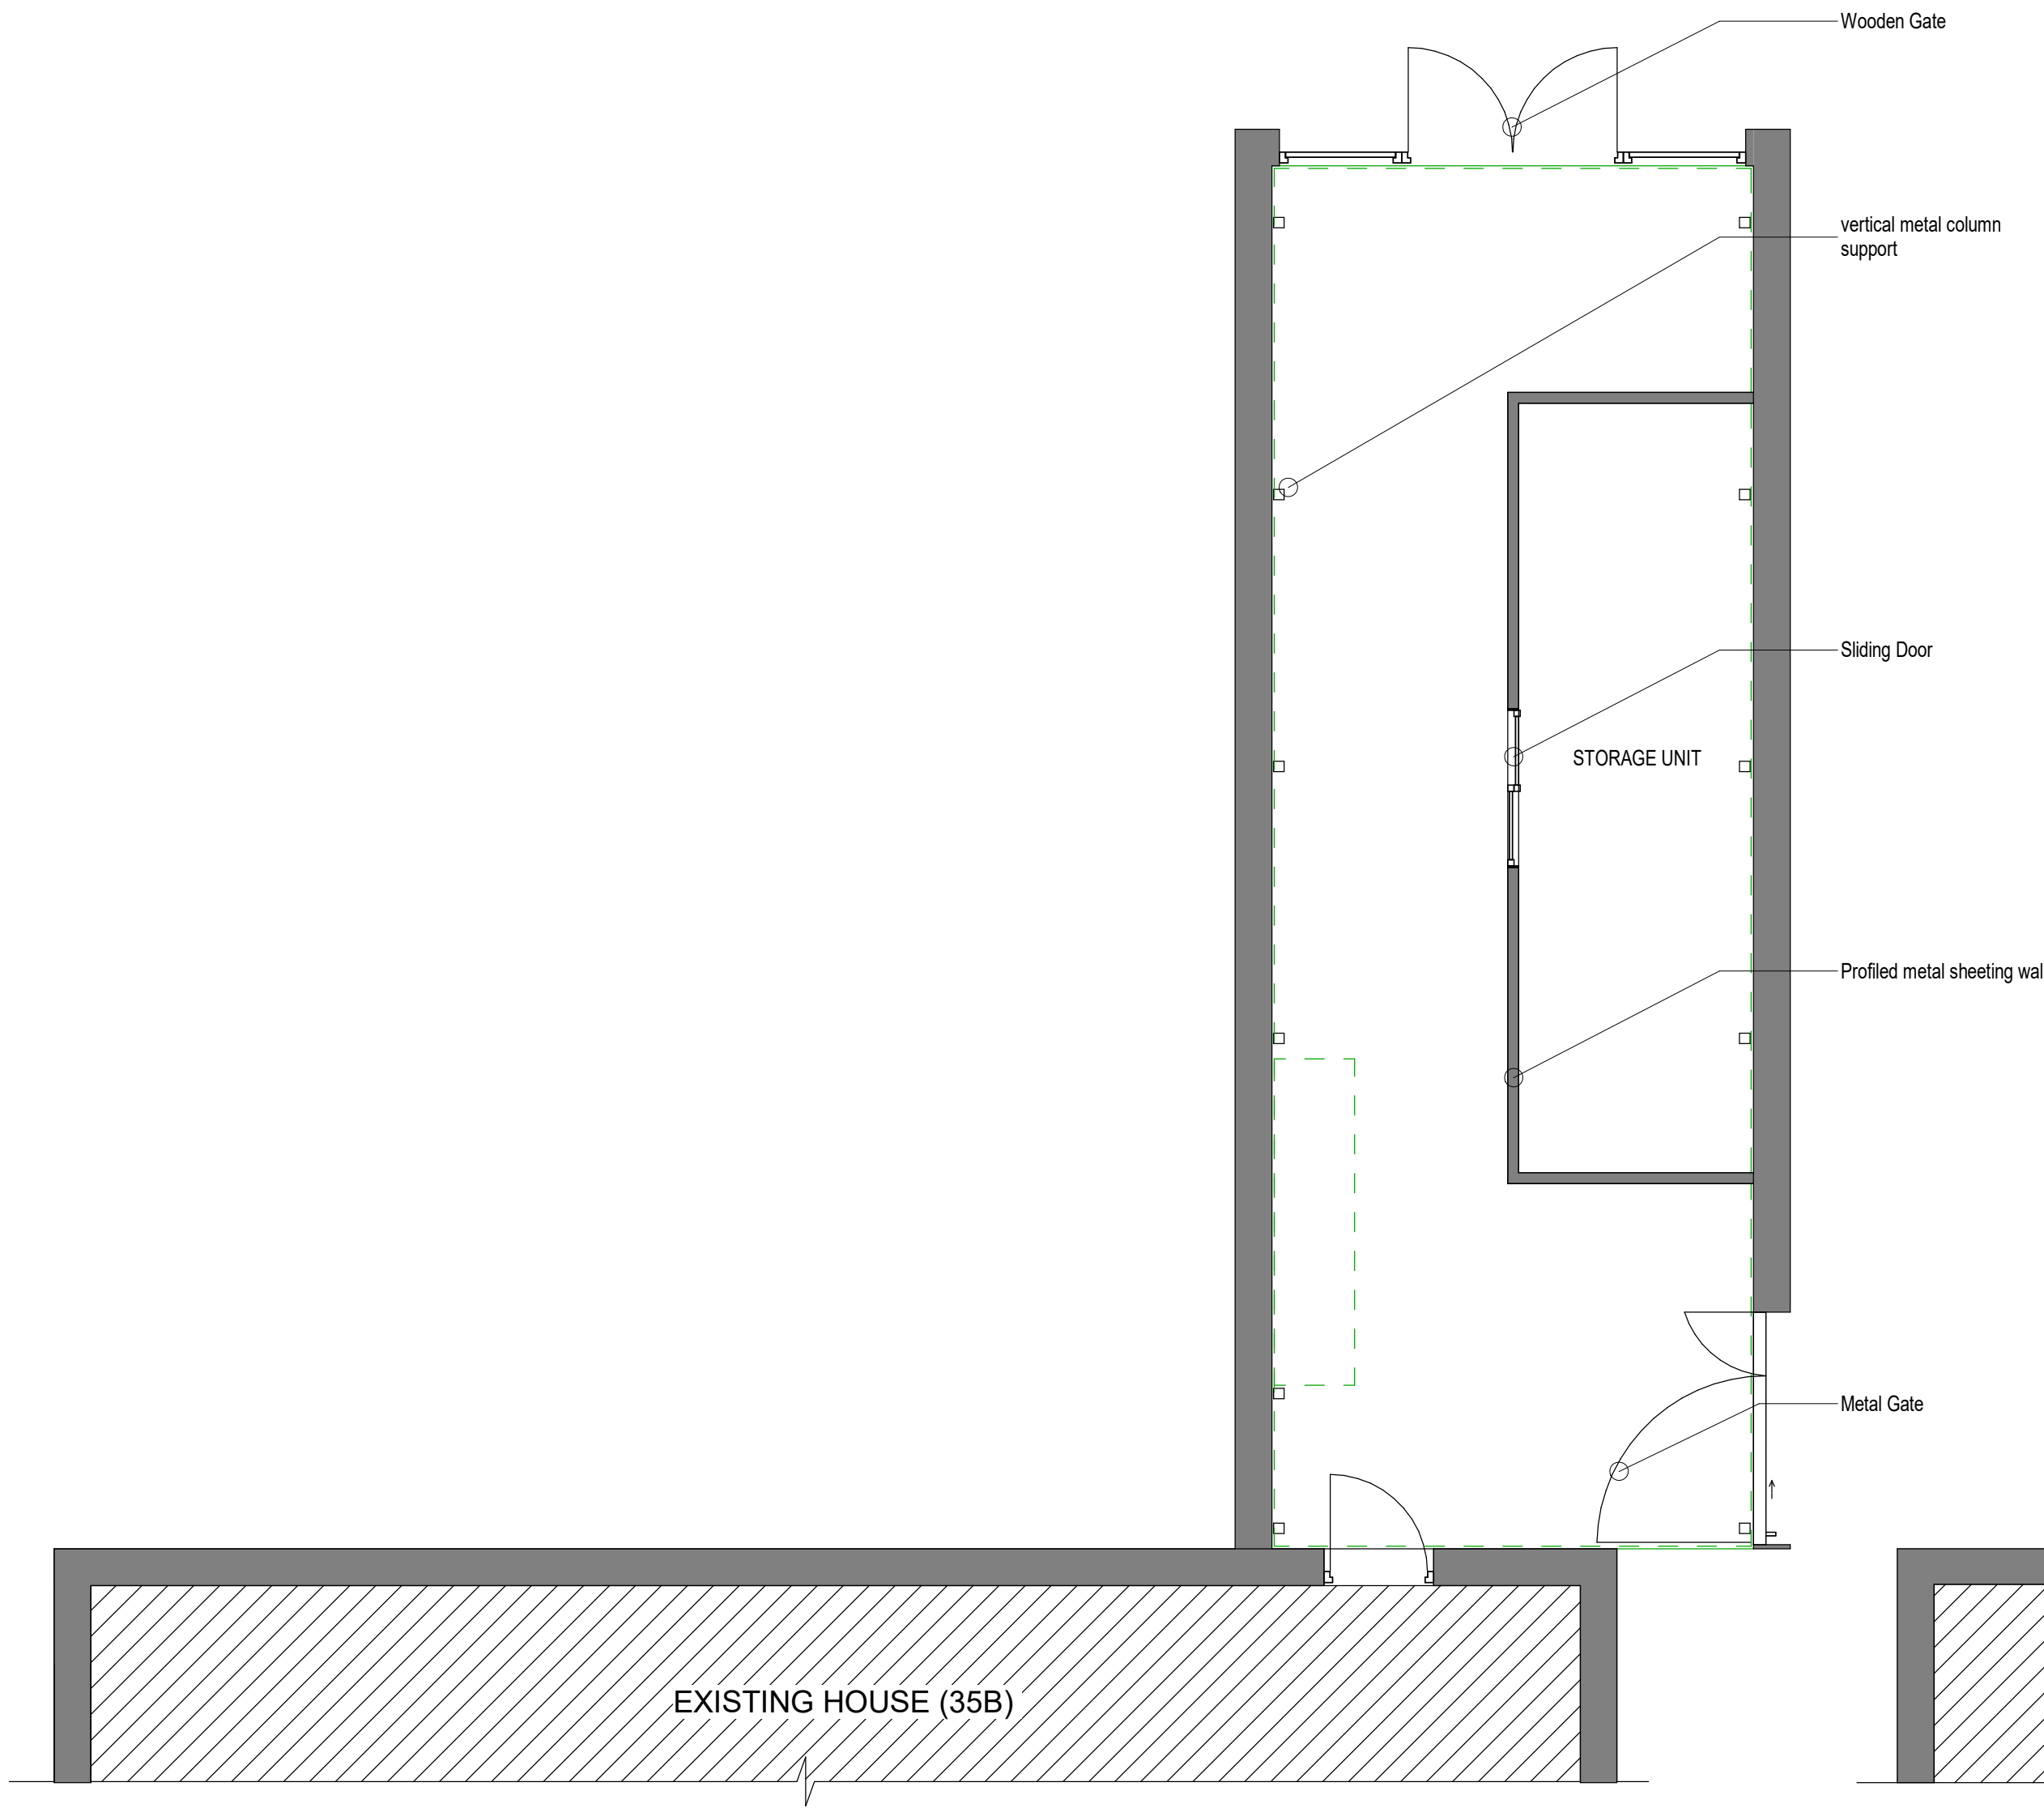


As-Built Ground Floor plan
1 : 50

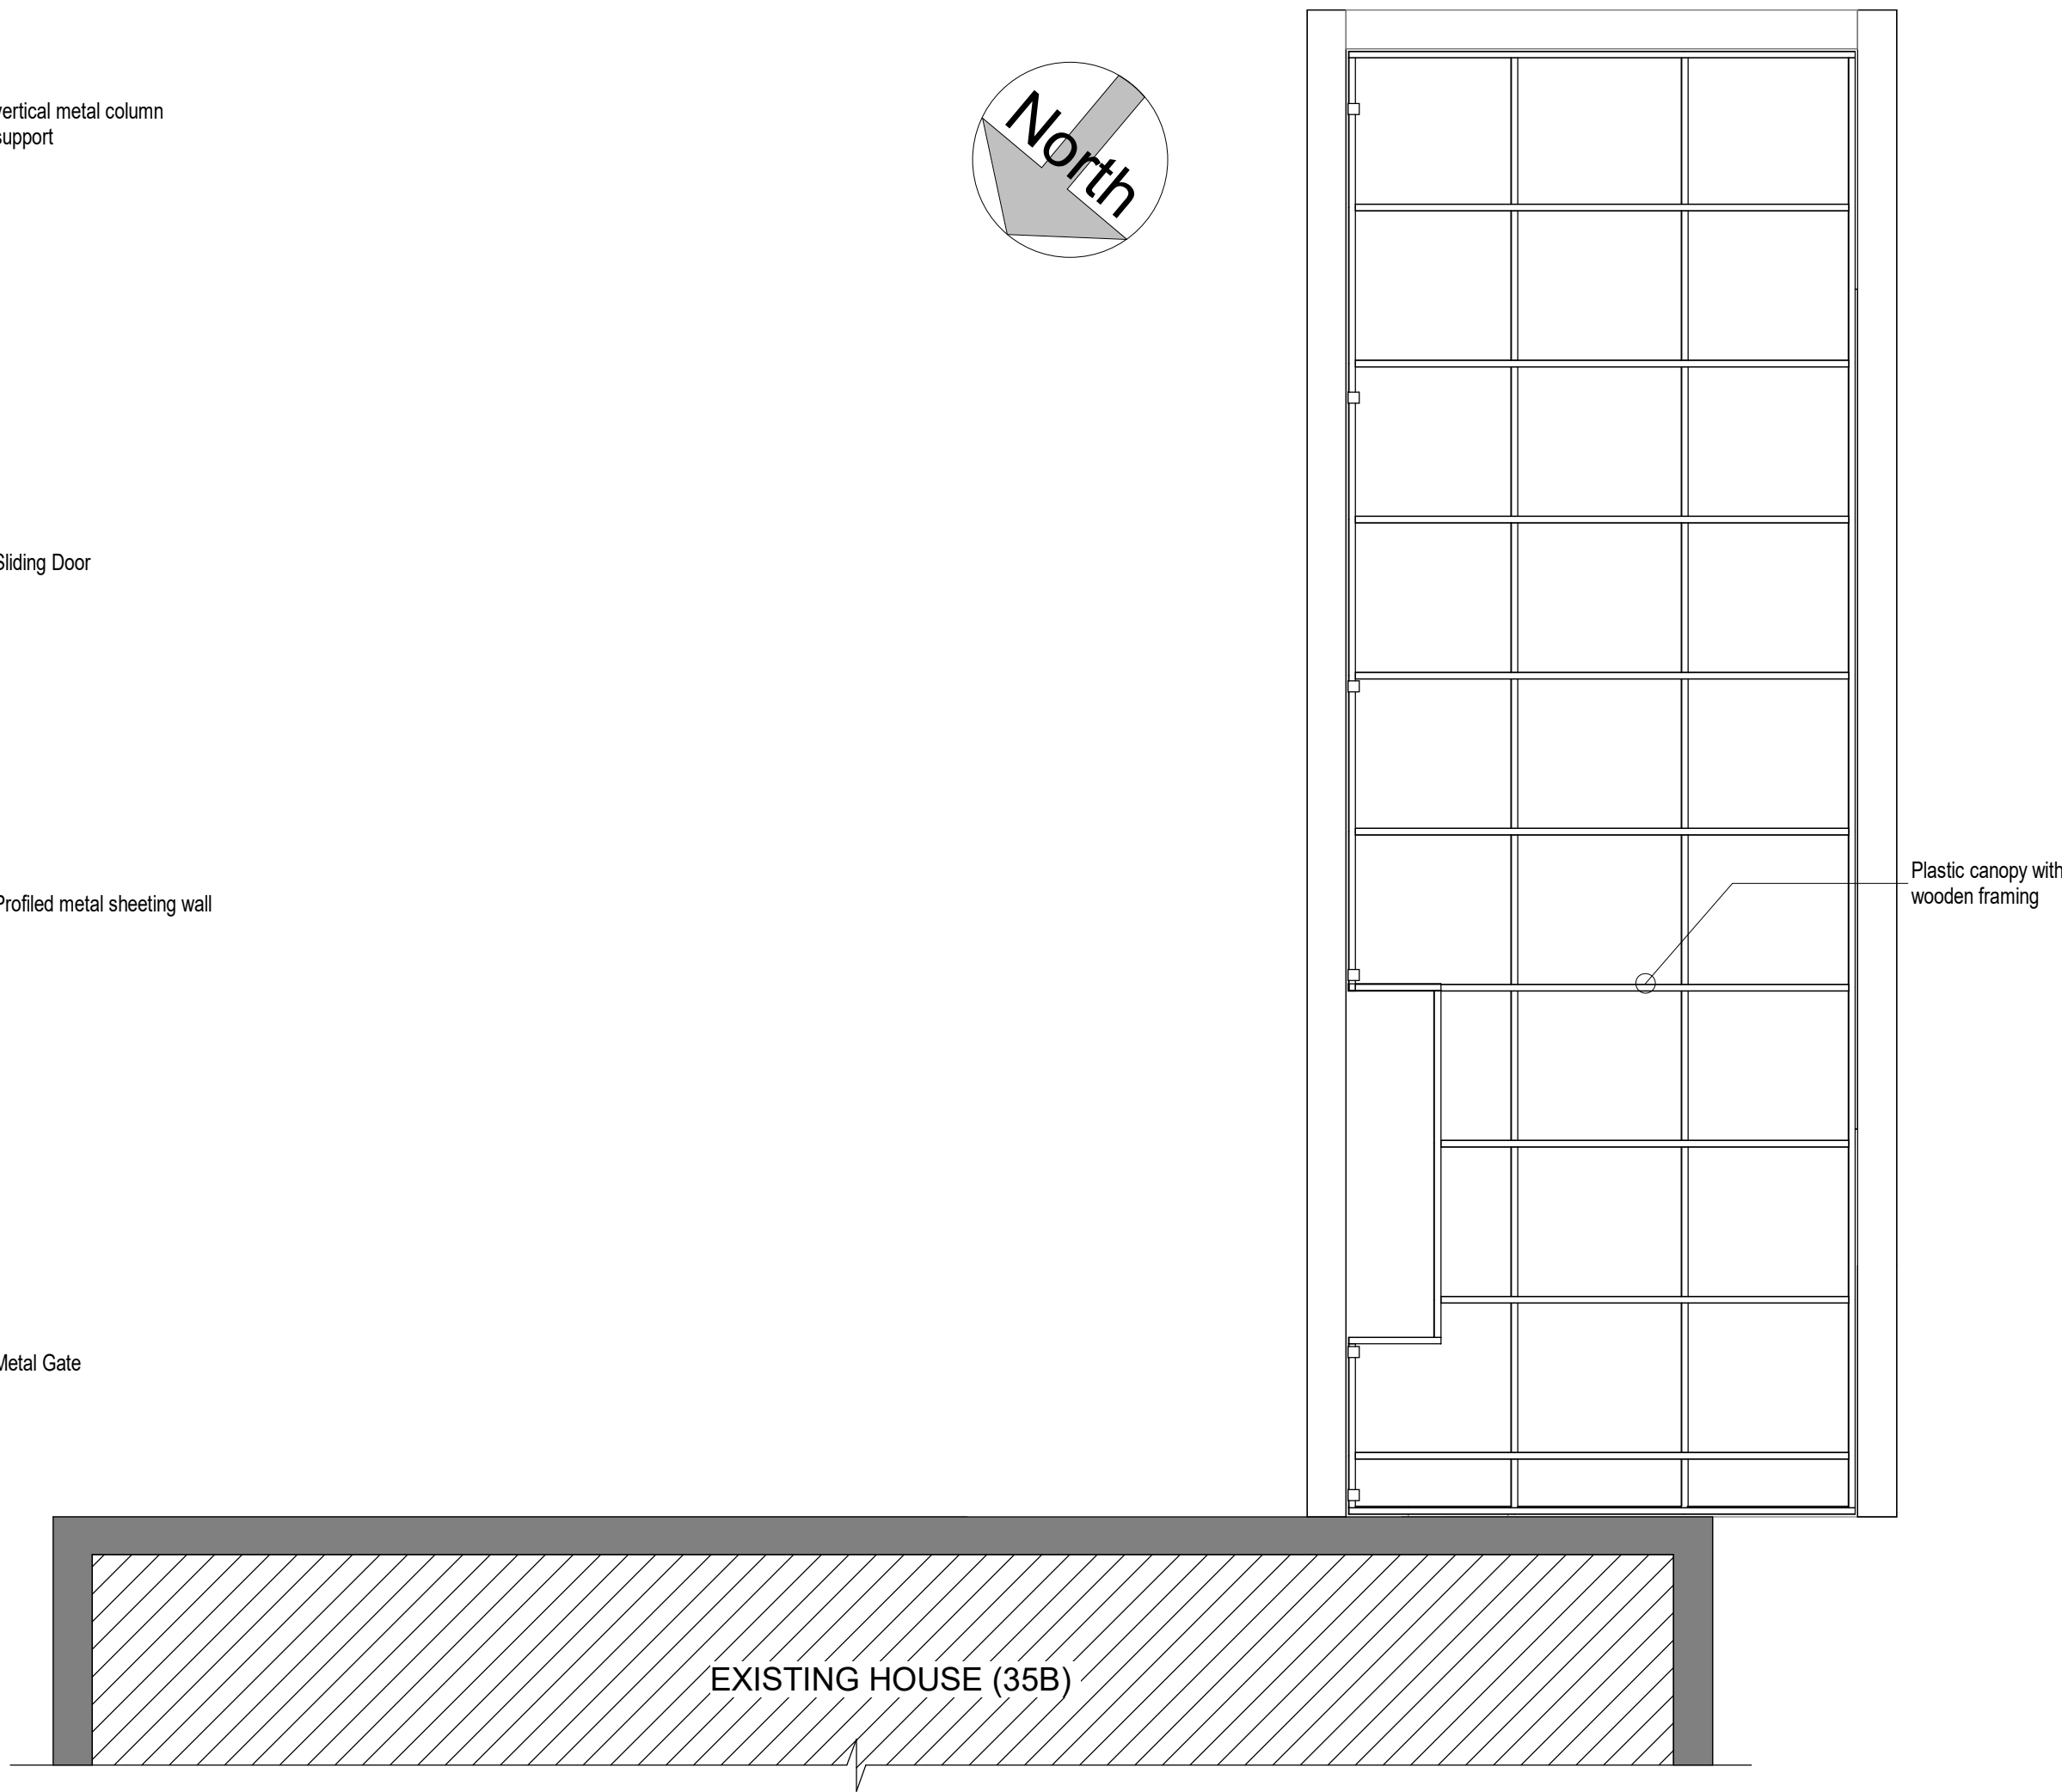

As-Built First Floor Plan
1 : 50

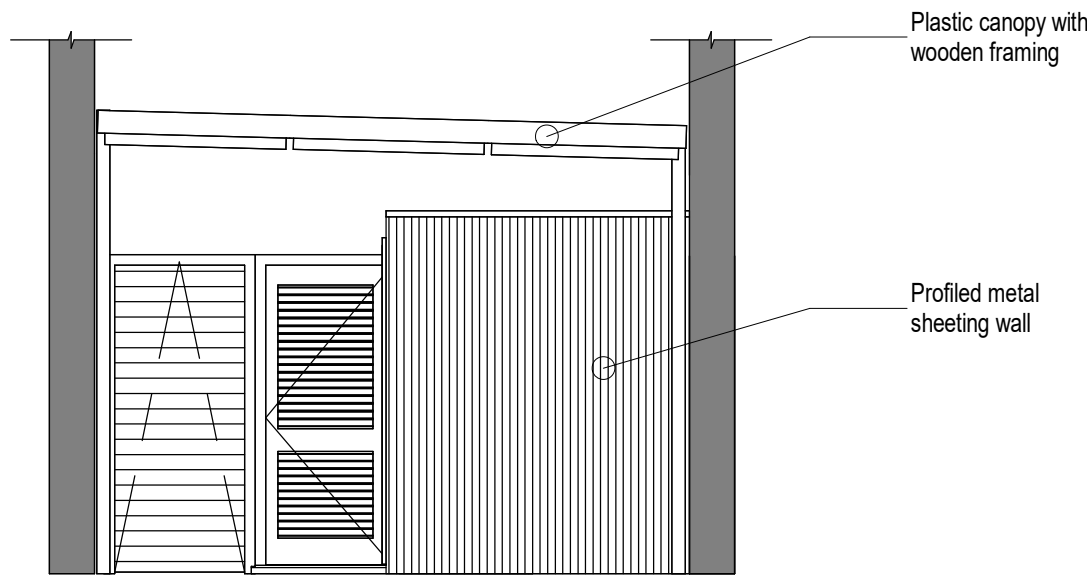

As-Built Front Elevation
1 : 50

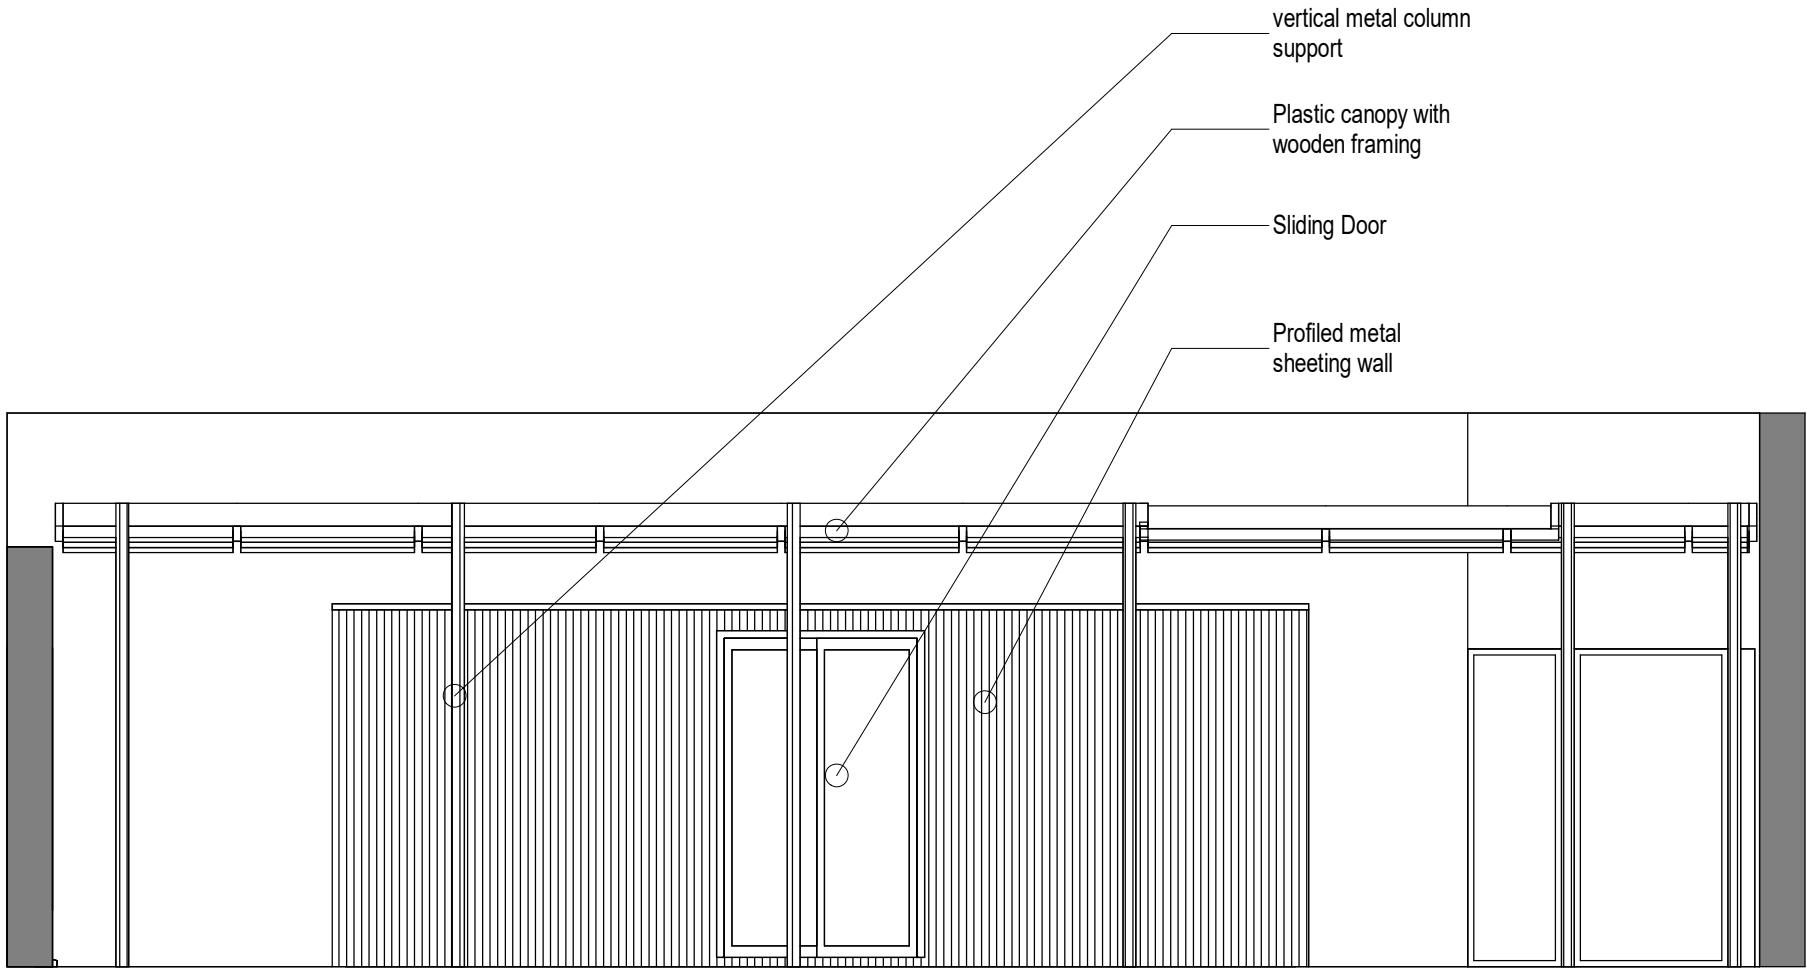


As-Built Left-Side Elevation
1 : 50

All dimensions to be checked on site.
Do not scale.
All levels to be checked on site and refer to Ordnance Survey Datum Newlyn unless alternative datum given.
All errors and omissions to be reported to the Architect prior to commencement.
This drawing must be read in conjunction with the relevant specification clauses.
This drawing must not be used on site unless issued for construction.

Scale 1 : 1250
0 10 20 30 40 50 60 70 80 90 100



Location Plan
1 : 1250

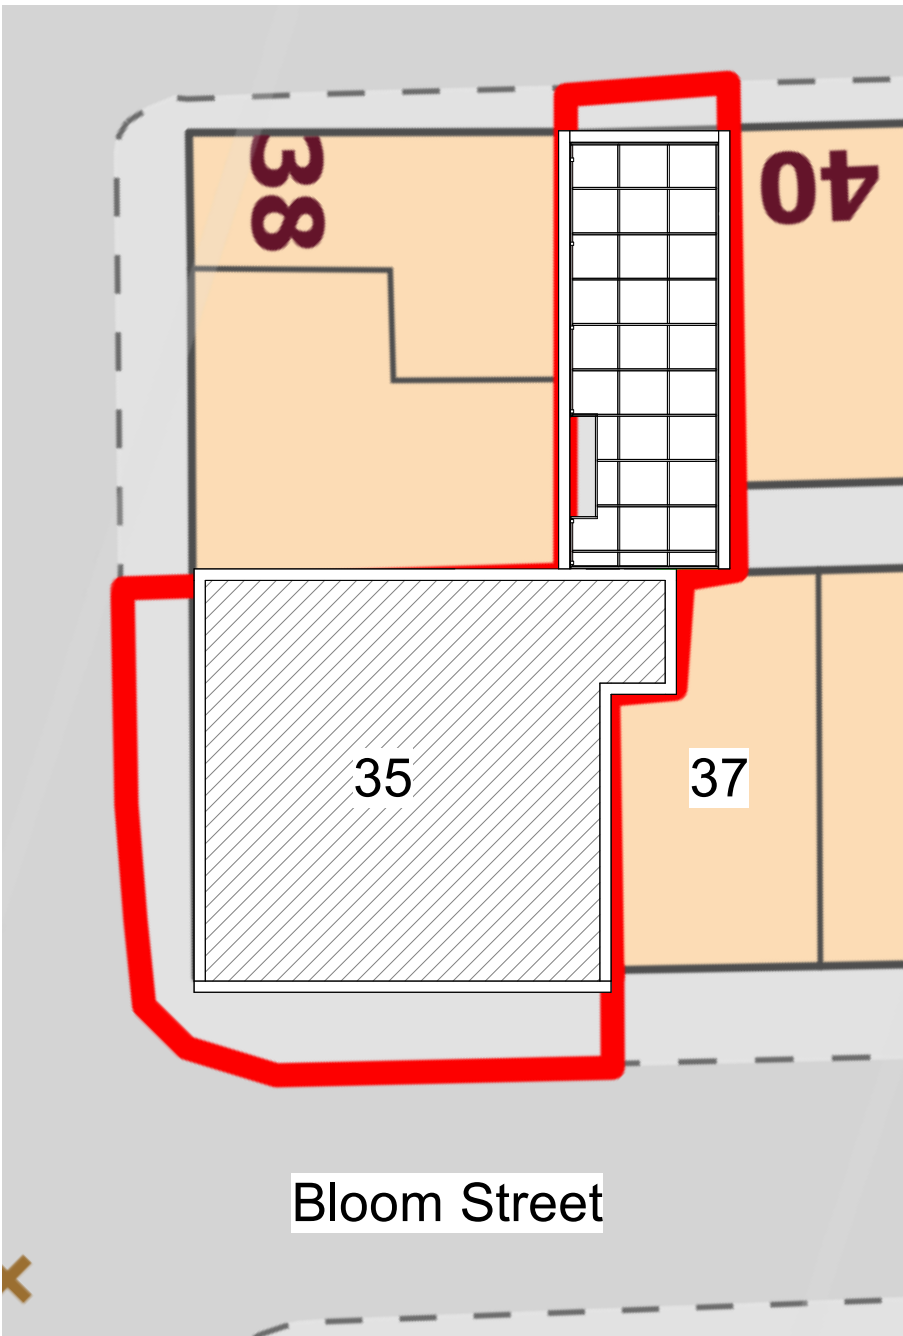

As-Built Site Plan
1 : 200

0 1 2 3 4 5
GRAPHIC SCALE 1:50
0 8 12 16 20
GRAPHIC SCALE 1:200

Proposed Outbuilding		
		
LDM Design		
PROJECT :	35 Bloom Street, Napoleons night club, M1 3LY	
SHEET :	As Built Drawings	
CLIENT :	Miss Lin LUI	
Scale (@ A1) :	As indicated	
Drawn by :	BA	DRAWING NUMBER :
Checked by :	KK	A1-002a
		REV : A