


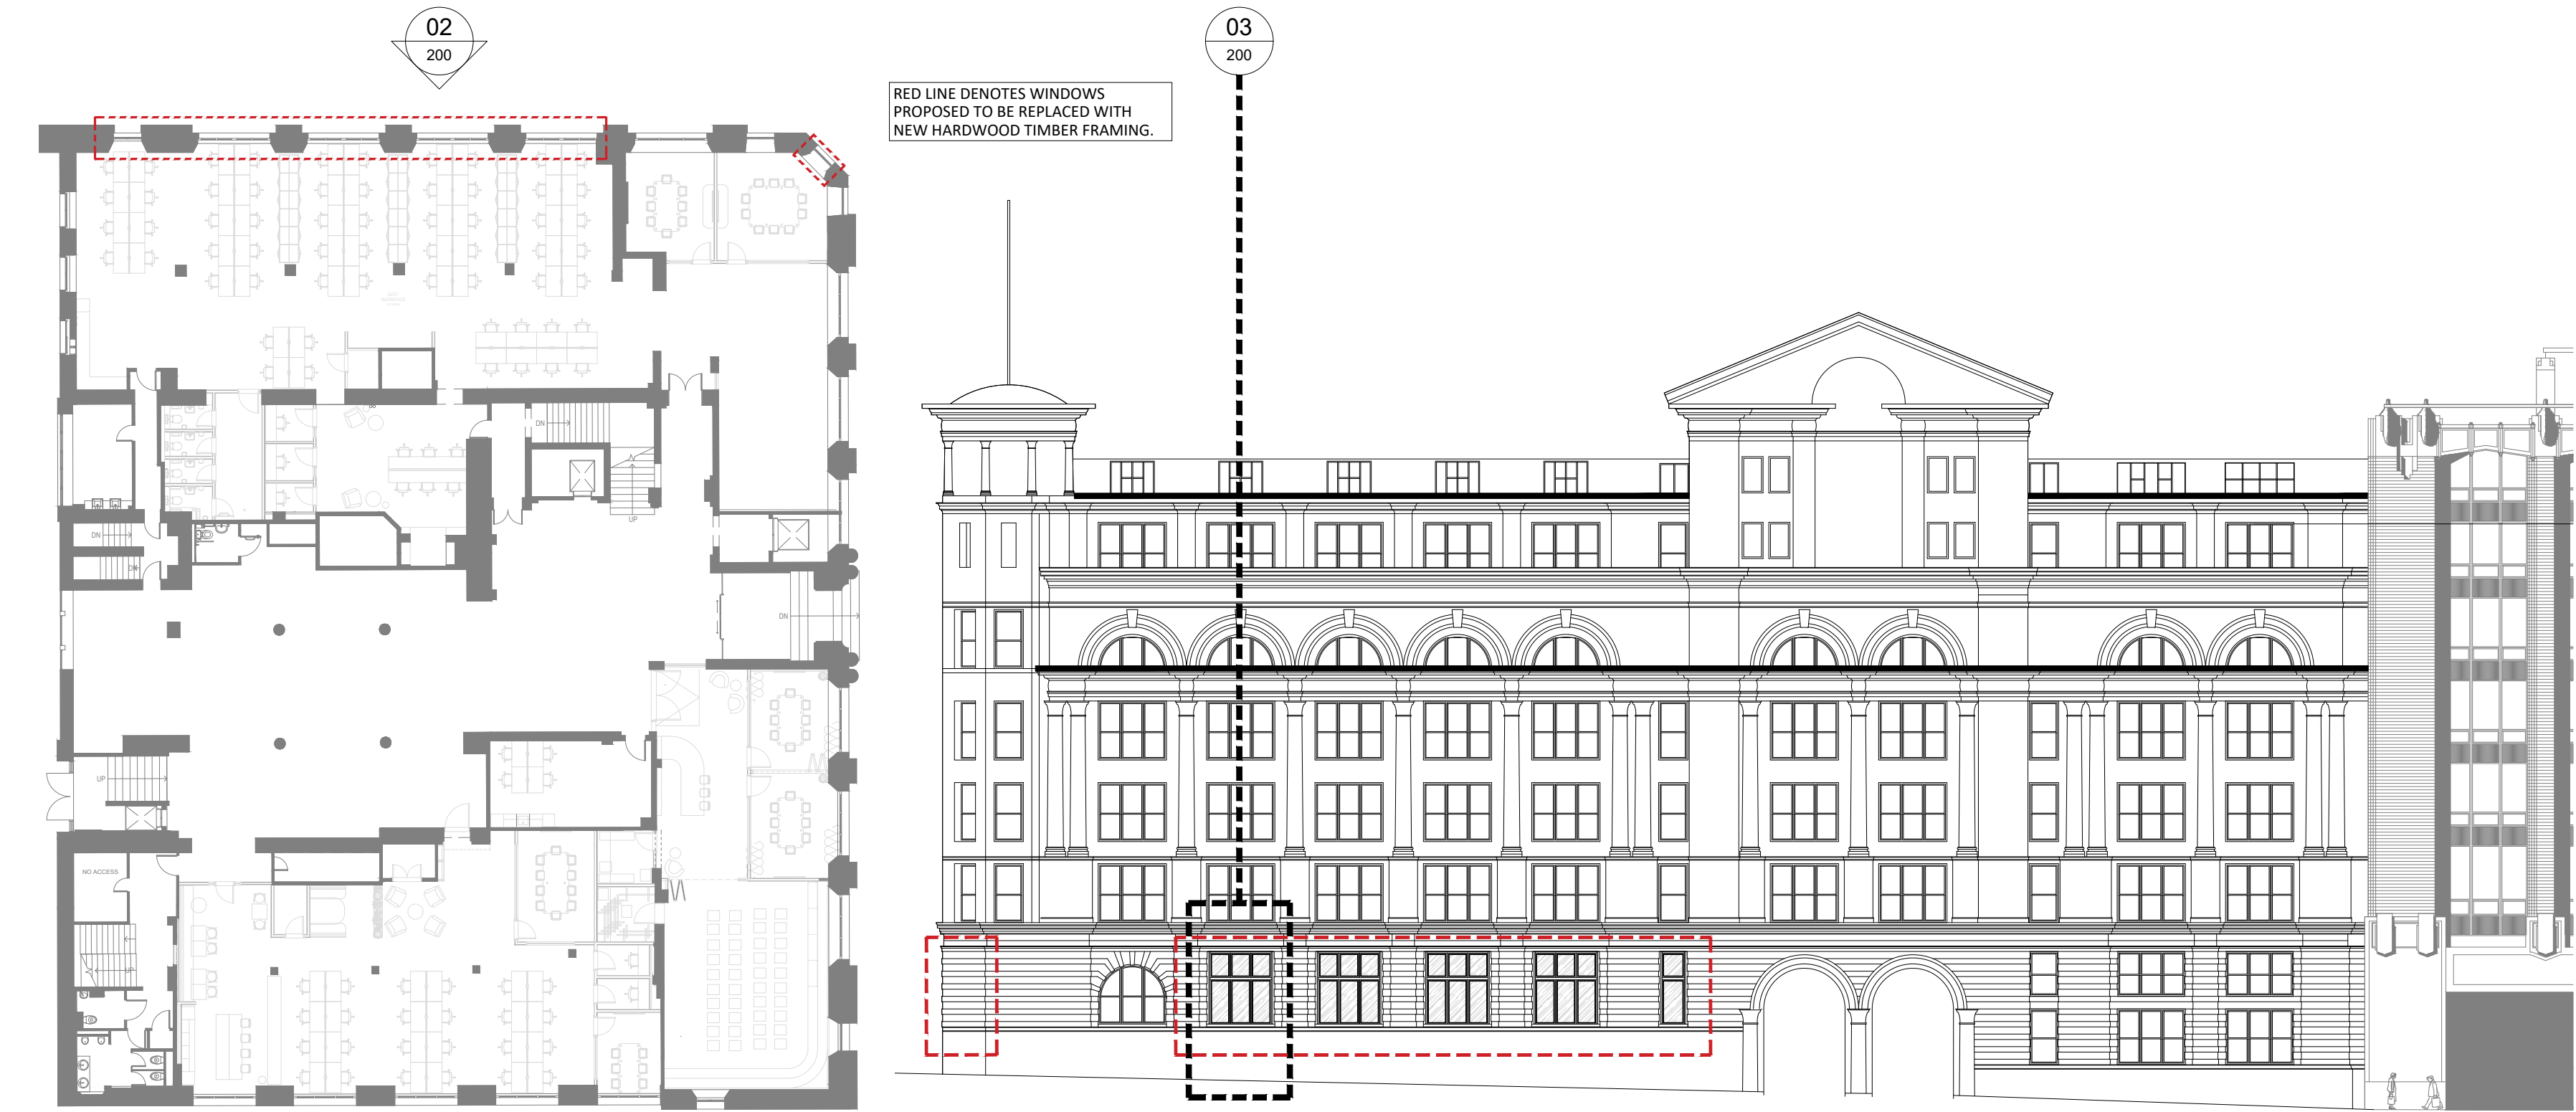

RED LINE DENOTES WINDOWS
PROPOSED TO BE REPLACED WITH
NEW HARDWOOD TIMBER FRAMING.

RED LINE DENOTES WINDOWS
PROPOSED TO BE REPLACED WITH
NEW HARDWOOD TIMBER FRAMING.

NEW DOUBLE GLAZED WINDOWS TO BE
INSTALLED IN PLACE OF EXISTING.
NEW WINDOWS ARE TO BE STRUCTURED
TO AKIN TO THE LAYOUT OF WINDOWS
TO UPPER FLOORS ABOVE.


NEW HARDWOOD TIMBER FRAMING
WITH ORNATE MOLDING DETAILS IS TO
RECEIVE PAINTED FINISH TO MATCH
FARROW AND BALL - OFF BLACK.

REFER TO SECTION DETAILS FOR FURTHER
INSIGHT INTO ORNATE DETAILING AND
HOW THE NEW FRAMING WILL SIT
WITHIN THE OPEN REVEALS.


01 GROUND FLOOR PLAN
200 SCALE - 1:250 @ A1
AS PROPOSED

02 GREAT BRIDGEWATER STREET EXTERNAL ELEVATION
200 SCALE - 1:250 @ A1
AS PROPOSED


03 NEW WINDOW EXTERNAL ELEVATION CALL OUT
200 SCALE - 1:50 @ A1
AS PROPOSED

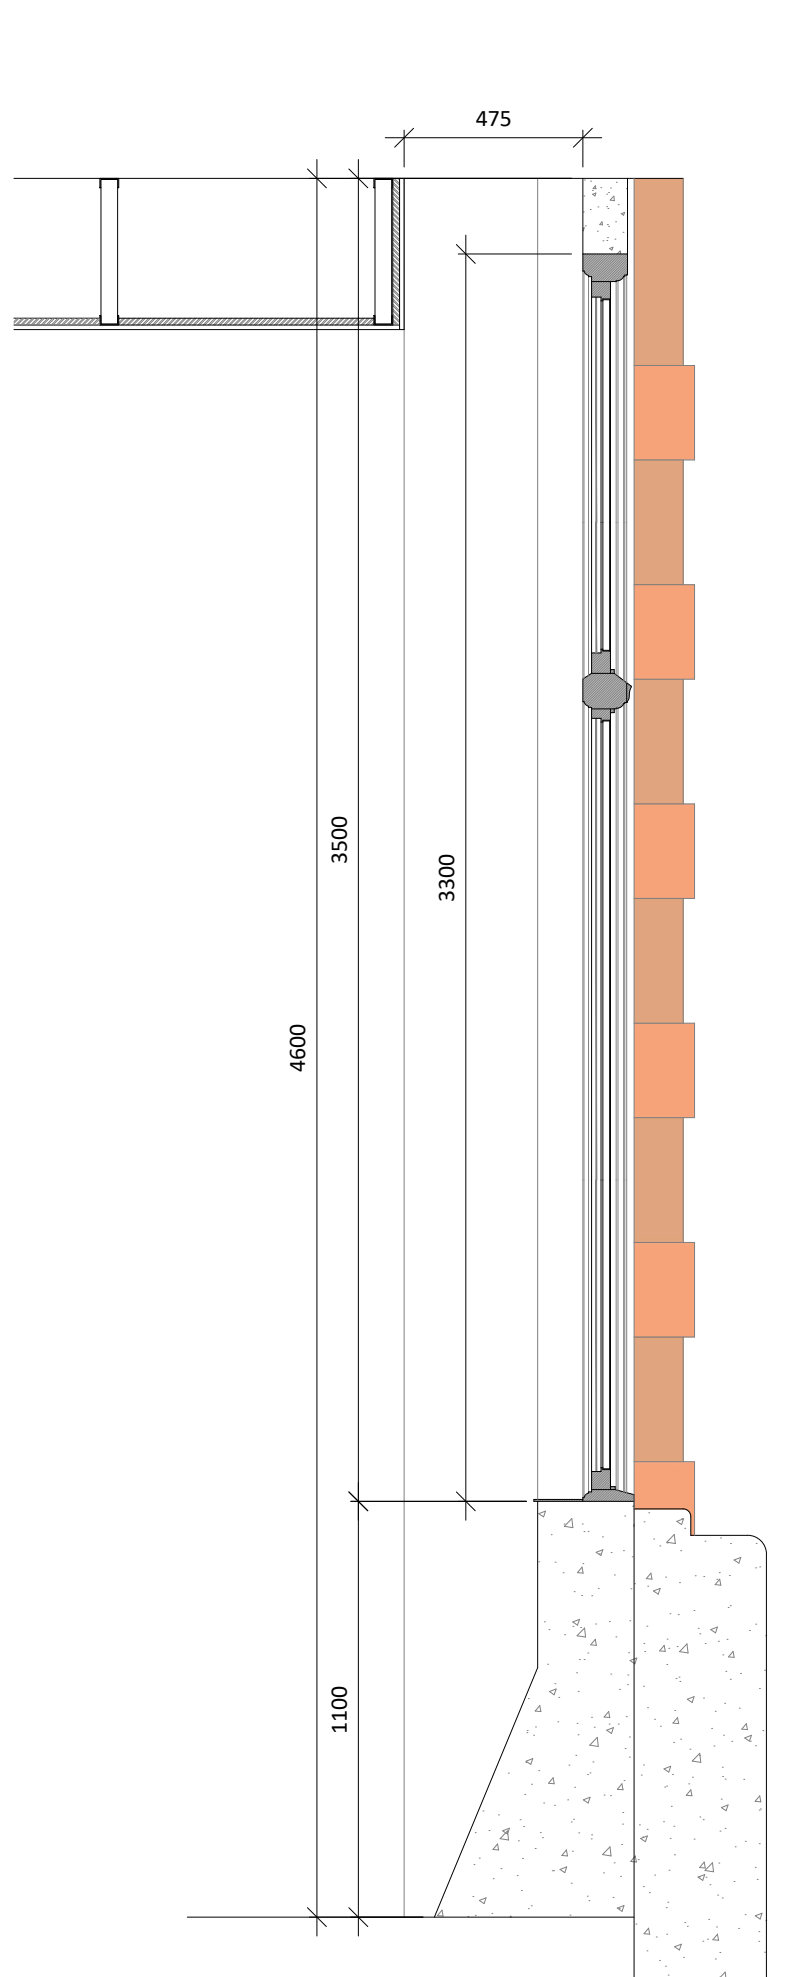


04 NEW GLAZING SECTION
200 SCALE - 1:20 @ A1
AS PROPOSED

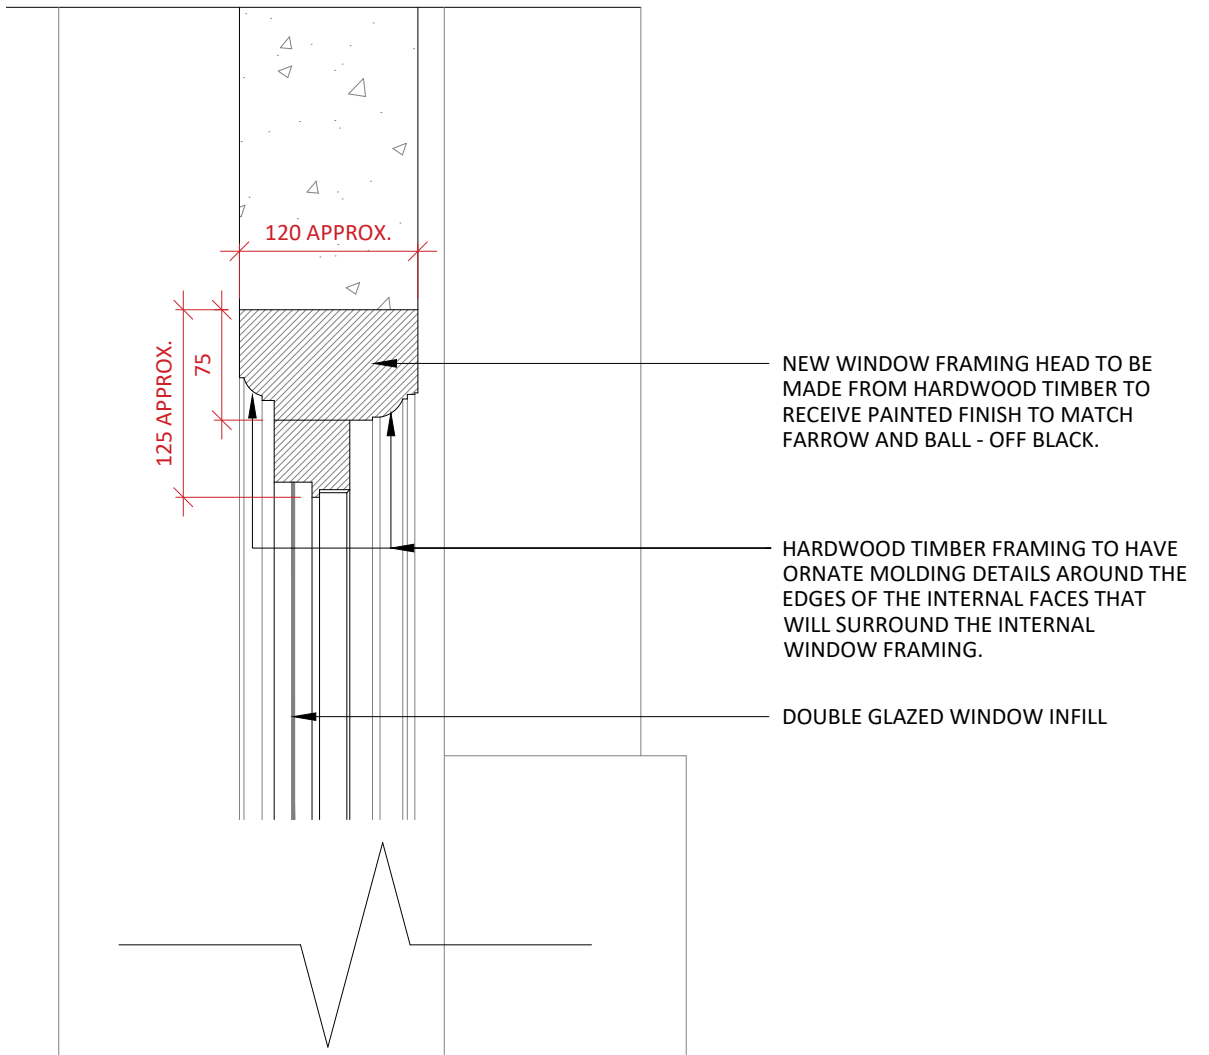

05 NEW GLAZING HEAD SECTION
200 SCALE - 1:5 @ A1
AS PROPOSED

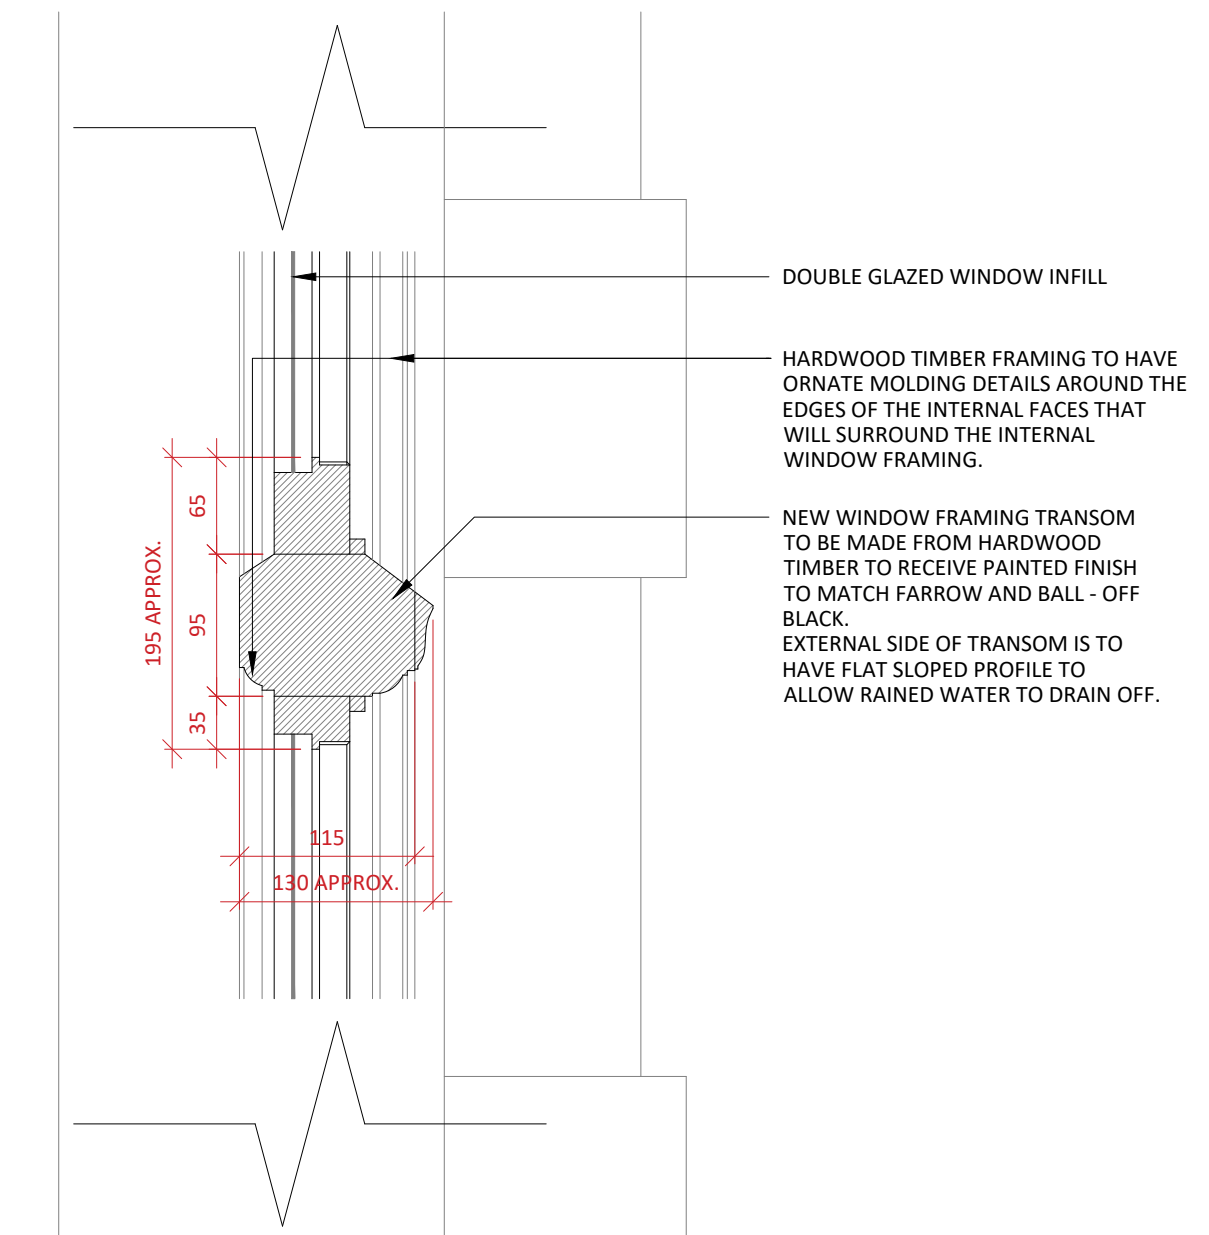

06 NEW GLAZING TRANSOM SECTION
200 SCALE - 1:5 @ A1
AS PROPOSED

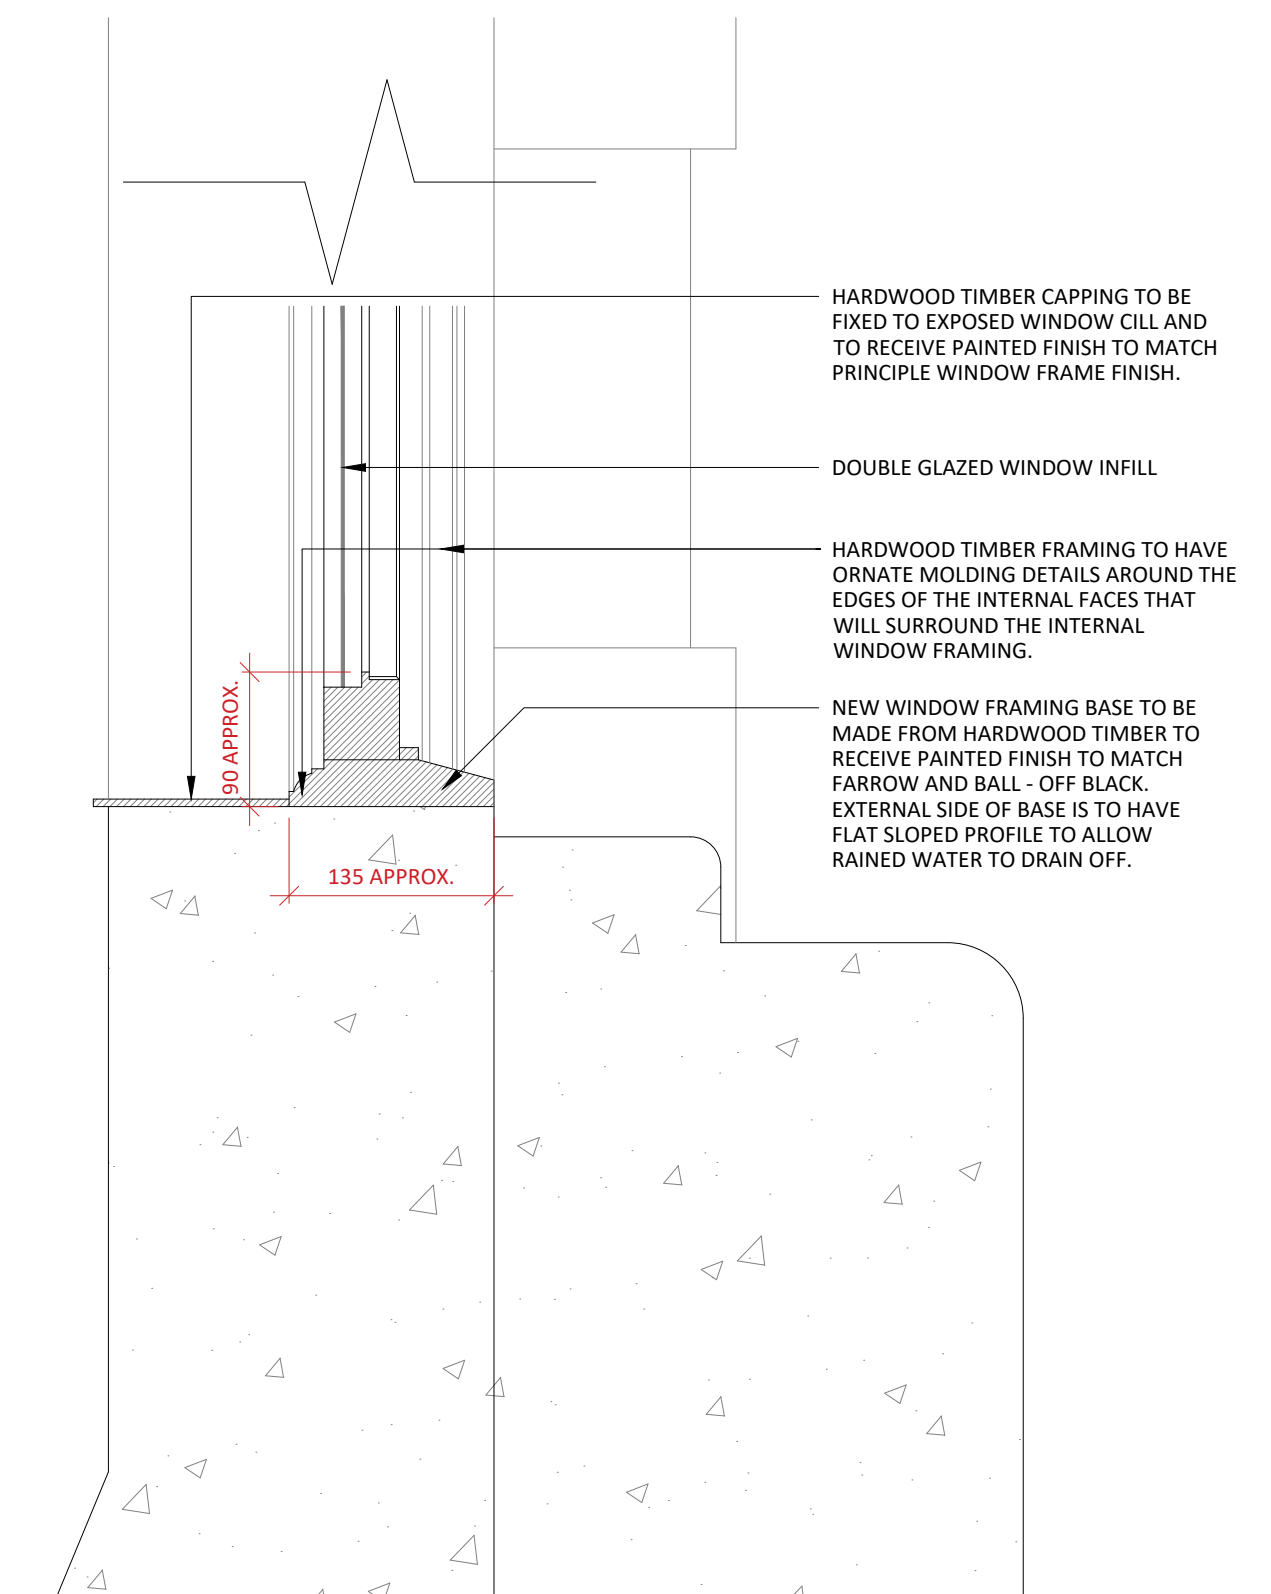

07 NEW GLAZING BASE SECTION
200 SCALE - 1:5 @ A1
AS PROPOSED




08 EXTERNAL FRAME SAMPLE
200 SCALE - NTS
AS PROPOSED



09 INTERNAL FRAME SAMPLE
200 SCALE - NTS
AS PROPOSED



10 FRAME BASE SAMPLE
200 SCALE - NTS
AS PROPOSED

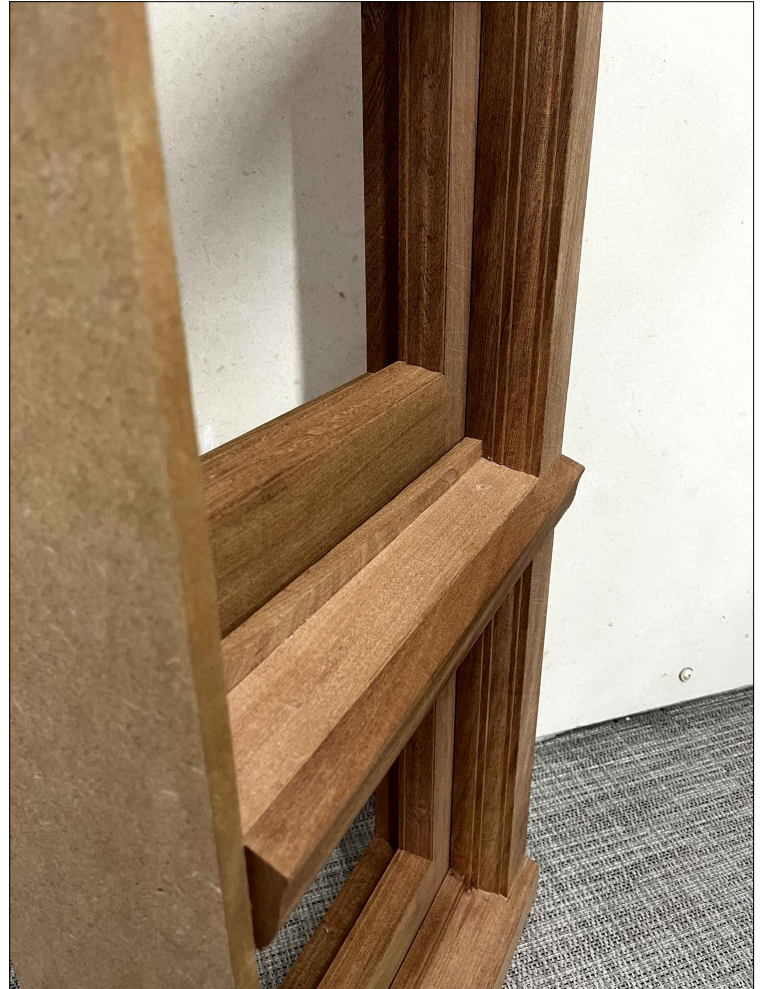

11 FRAME TRANSOM SAMPLE
200 SCALE - NTS
AS PROPOSED

DO NOT SCALE FROM THIS DRAWING.
ALL DIMENSIONS TO BE CHECKED ON SITE.
(DRAWINGS MAYBE SCALED FOR LOCAL AUTHORITY & PLANNING PURPOSE ONLY)
COPYRIGHT PROTECTED.

FOR PLANNING
DO NOT USE FOR CONSTRUCTION

CONSULTANT REFERENCES IN DRAWING:

STRUCTURAL - REF/REVISION

GENERAL NOTES:

THE CONTRACTOR IS NOT TO SCALE FROM THIS DRAWING BUT FOLLOW THE WRITTEN
FINISHED DIMENSIONS. ANY DISCREPANCIES BETWEEN THE DRAWING AND THE
OTHER CONTRACT DOCUMENTS OR ANY DISCREPANCIES WITHIN A DRAWING OR
BETWEEN DRAWINGS MUST BE REPORTED IMMEDIATELY TO THE ARCHITECT.

THE CONTRACTOR IS TO INSPECT THE SITE PRIOR TO TENDER AND IS RESPONSIBLE FOR
STRIPPING OUT IN ACCORDANCE WITH THE DRAWINGS ENSURING THAT THE WORK IS
UNDERTAKEN SAFELY.

THE CONTRACTOR WILL BE RESPONSIBLE FOR THE SETTING OUT OF THE WORKS.

CONTRACTOR IS TO ALLOW FOR ALL FIRE STOPPING THROUGH WALLS, CEILINGS AND
FLOORS.

THE ELECTRICAL INSTALLATION IS TO BE IN ACCORDANCE WITH THE CURRENT EDITION
OF THE IEE REGULATIONS AND ALL CABLEING TO BE LSF.

THE CONTRACTOR IS RESPONSIBLE FOR THE DETAILED SERVICES DESIGN INCLUDING
LOADINGS, CABLE AND PIPEWORK ROUTES AND PIPEWORK / CABLE SIZING AND
SPECIFICATION. ALL CABLE TRAY, MS CONDUIT AND OTHER SERVICES ARE TO BE
EXPPOSED BELOW SLAB/ CEILINGS.

ANY H&V PROPOSAL IS INDICATIVE ONLY AND THE SPECIALIST CONTRACTOR IS TO BE
RESPONSIBLE FOR THE DETAIL DESIGN & ALL SWITCH/ SOCKET OUTLETS TO COMPLY
WITH CLIENT'S STANDARD SPECIFICATION. ANY SOCKETS IN RETAIL AREA TO BE
FINISHED BRUSHED STAINLESS STEEL.

NOTE - ALL EXISTING FIRE RESISTING ENCLOSURES TO SERVICE RISERS TO BE
MAINTAINED OR MADE GOOD WHERE DISTURBED. NEW AND EXISTING CABLES,
PIPES AND DUCTS PASSING THROUGH FIRE RESISTING CONSTRUCTION TO BE
ADEQUATELY FIRE STOPPED. NEW AND EXISTING DUCTWORK PASSING THROUGH
FIRE RESISTING CONSTRUCTION TO HAVE FIRE DAMPERS.


ANY WALL, CEILING LININGS TO BE TO EUROCLASS A (CLASS 0 EQUIVALENT).

CONTRACTOR AND SUPPLIERS OF SPECIALIST JOINERY/ EQUIPMENT TO ENSURE ALL
TIMBER MATERIALS ARE TREATED WITH FIRE RETARDANT FINISH TO ACHIEVE CLASS 0
RATING. MDF TO BE ACHIEVE CLASS 0 RATED.

CONTRACTOR AND SUPPLIERS OF SPECIALIST EQUIPMENT TO PROVIDE FIRE RATING
CERTIFICATES FOR ALL SPECIALIST LININGS AND LAMINATES TO BE USED FOR NWR
APPROVAL.

ALL PAINTS TO BE WATER BASED

ALL DIMENSIONS TO BE CHECKED ON SITE PRIOR TO ANY MANUFACTURE OR
CONSTRUCTION OF EQUIPMENT, FINISH, SIGNAGE ETC.

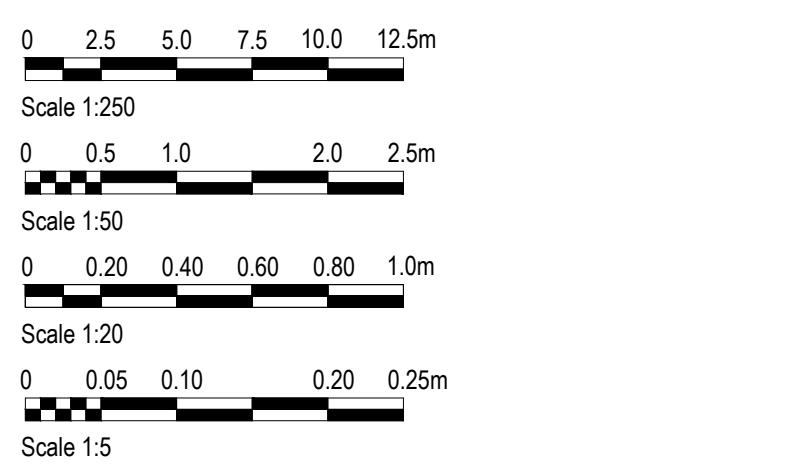

3.00	14/01/25	ISSUED FOR PLANNING	JW	ARB
REV	DATE	DESCRIPTION	DRAWN	CHECKED

AXI

ADDRESS : 4th FLOOR CALICO 53-55 MOSLEY STREET,
MANCHESTER, M2 3HQ
TELEPHONE : +44 (0)161 875 7357
EMAIL : www.axi.studio
COMPANY NO : 11847325



PROJECT
TOOTAL BUILDINGS
BROADHURST HOUSE,
56 OXFORD ST MANCHESTER

DRAWING REFERENCE
NEW WINDOW DETAILS
TO GROUND FLOOR
AS PROPOSED

JOB REFERENCE	DRAWING SCALE	DATE	DRAWN	CHECKED
23 - 141	varies@A113/01/2025	JW	ARB	

DRAWING REFERENCE	STAGE	REV
AXI - 200	3	00