


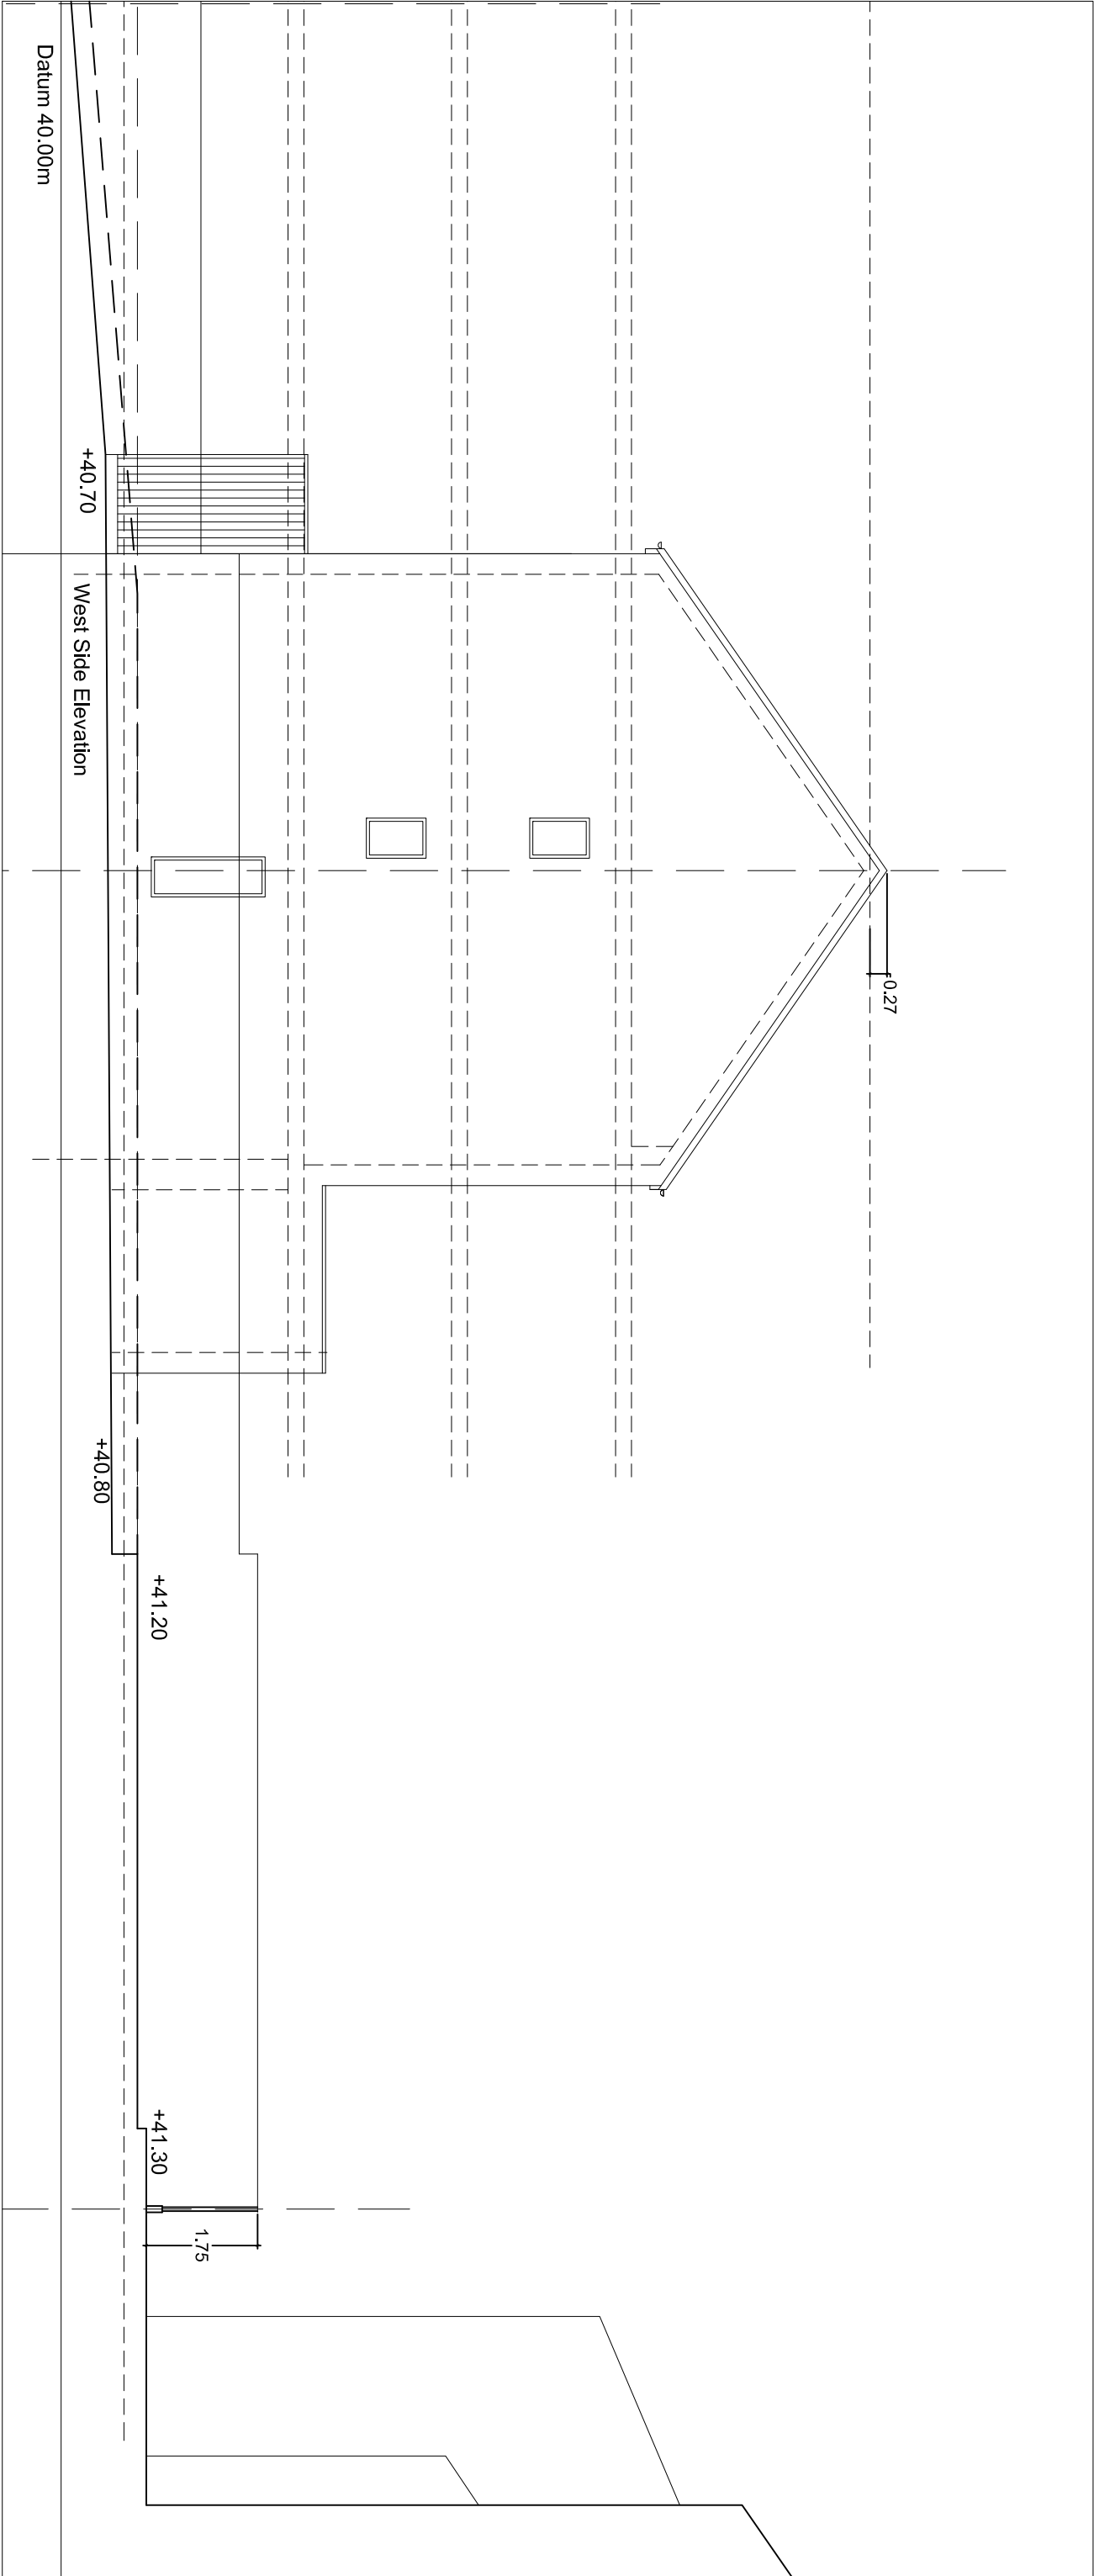

As built Side Elevation and Garden Section

PROJECT				66 & 68 Moseley rd, Fallowfield.			
SCALE		1 : 100 @ A3		CLIENT		AIRSHACK LTD	
DWG No.		169-SK- SEC1		DRAWING TITLE			
CONTRACT NO:		STAGE CODE		As built West Elevation &Garden section			
169		sketch		REV.		-	
ISSUED		19/01/25		-		sj simon james architect	