


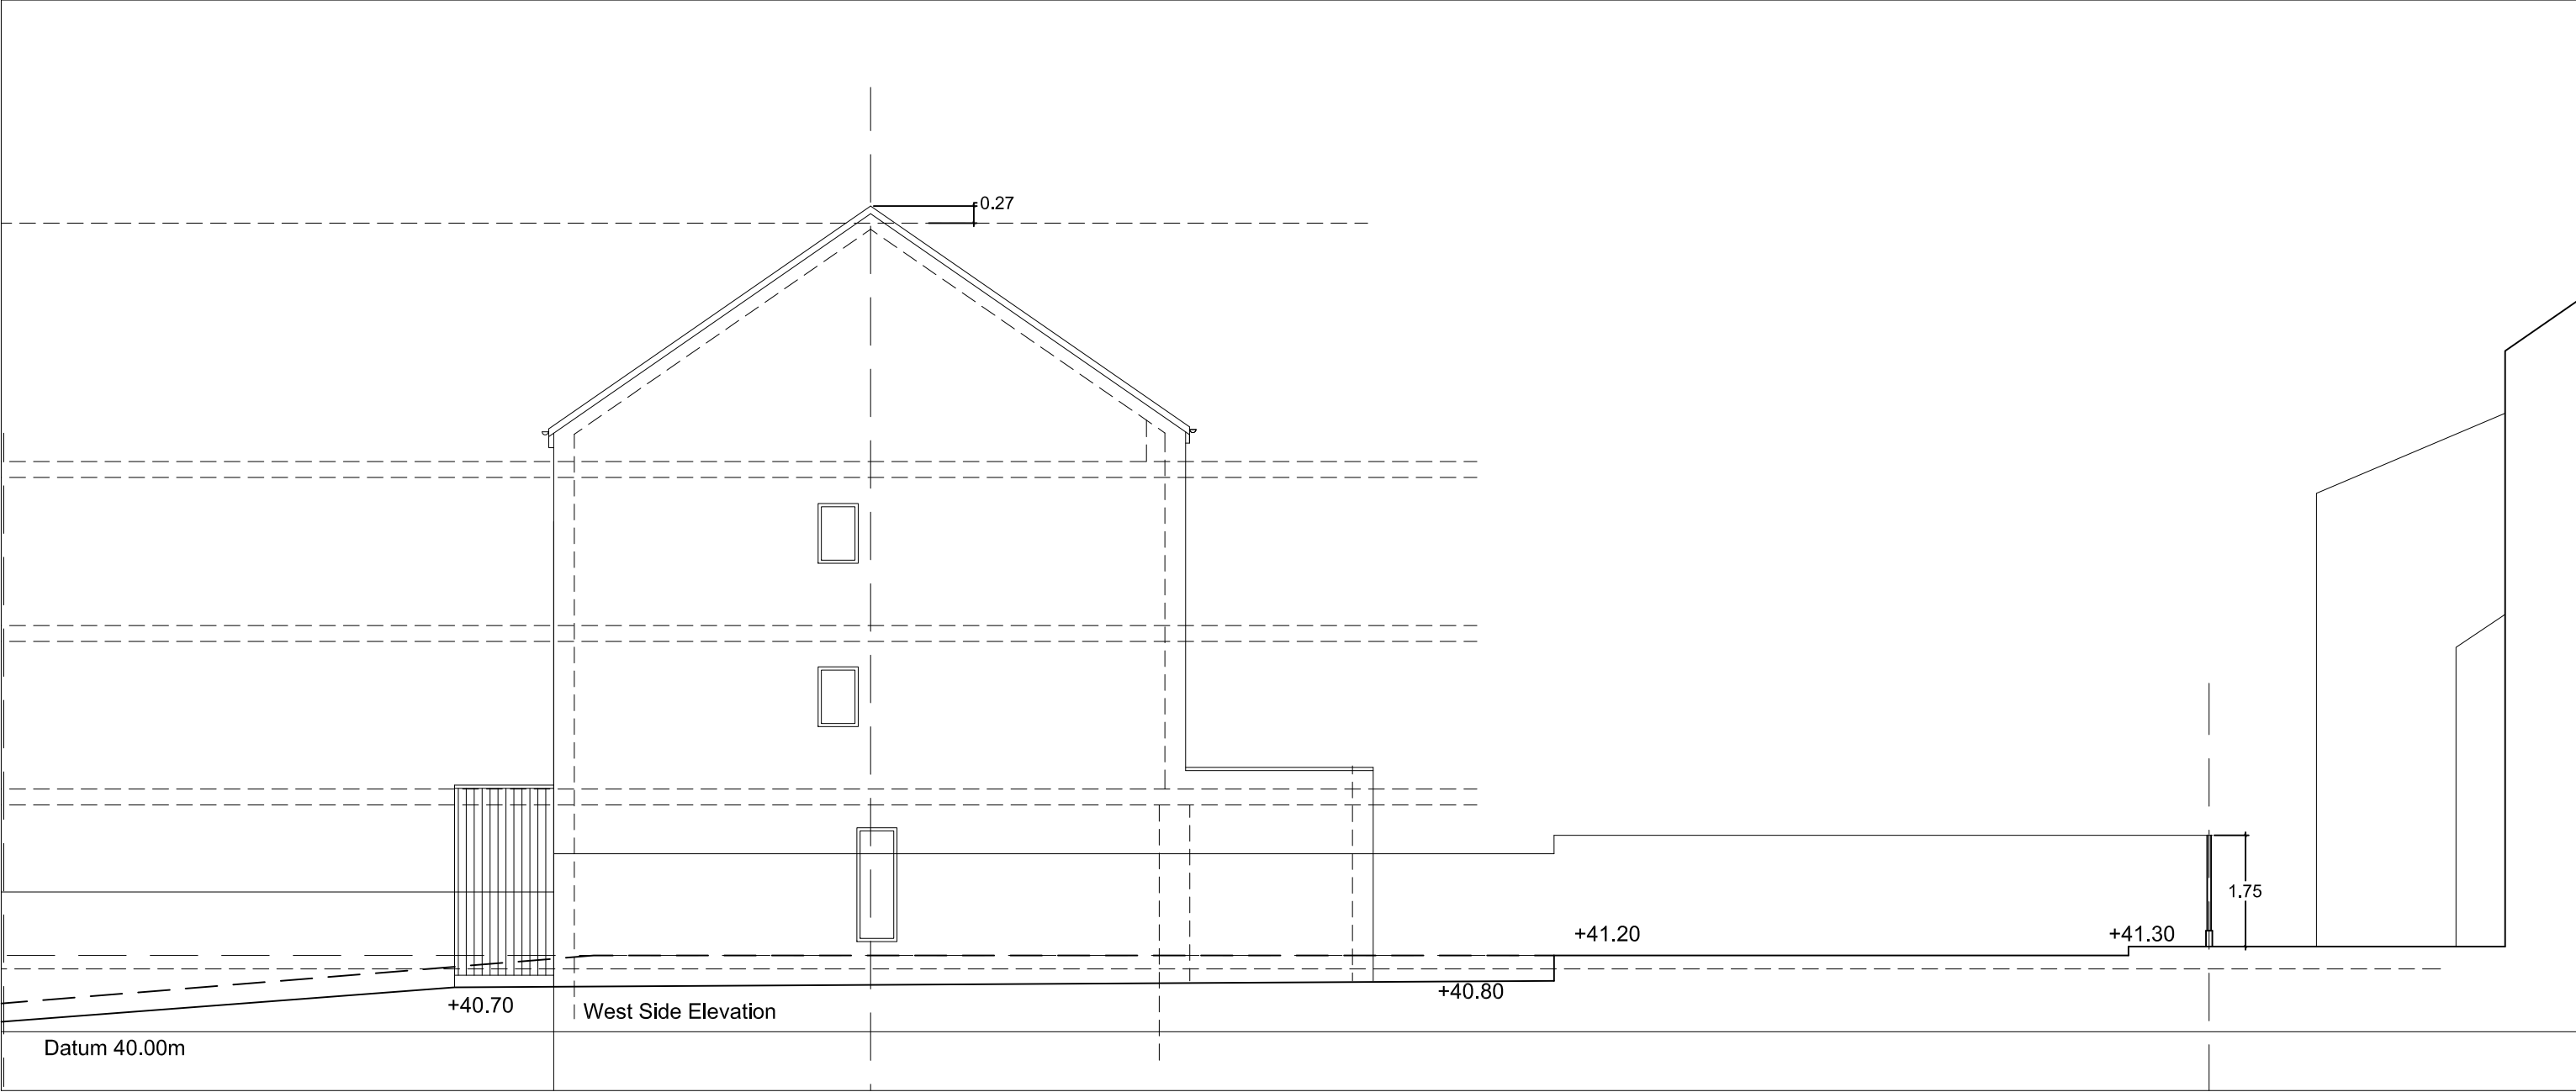

As built Side Elevation and Garden Section

PROJECT				66 & 68 Moseley rd, Fallowfield.	
SCALE			CLIENT AIRSHACK LTD		
1 : 100 @ A3					
DWG No.			DRAWING TITLE		
169-SK- SEC1					
CONTRACT NO:		STAGE CODE	REV.	As built West Elevation &Garden section	
169		sketch	-		
ISSUED	19/01/25		-	sj simon james architect	