


05 - Boundary Treatment Site Plan

1 : 200

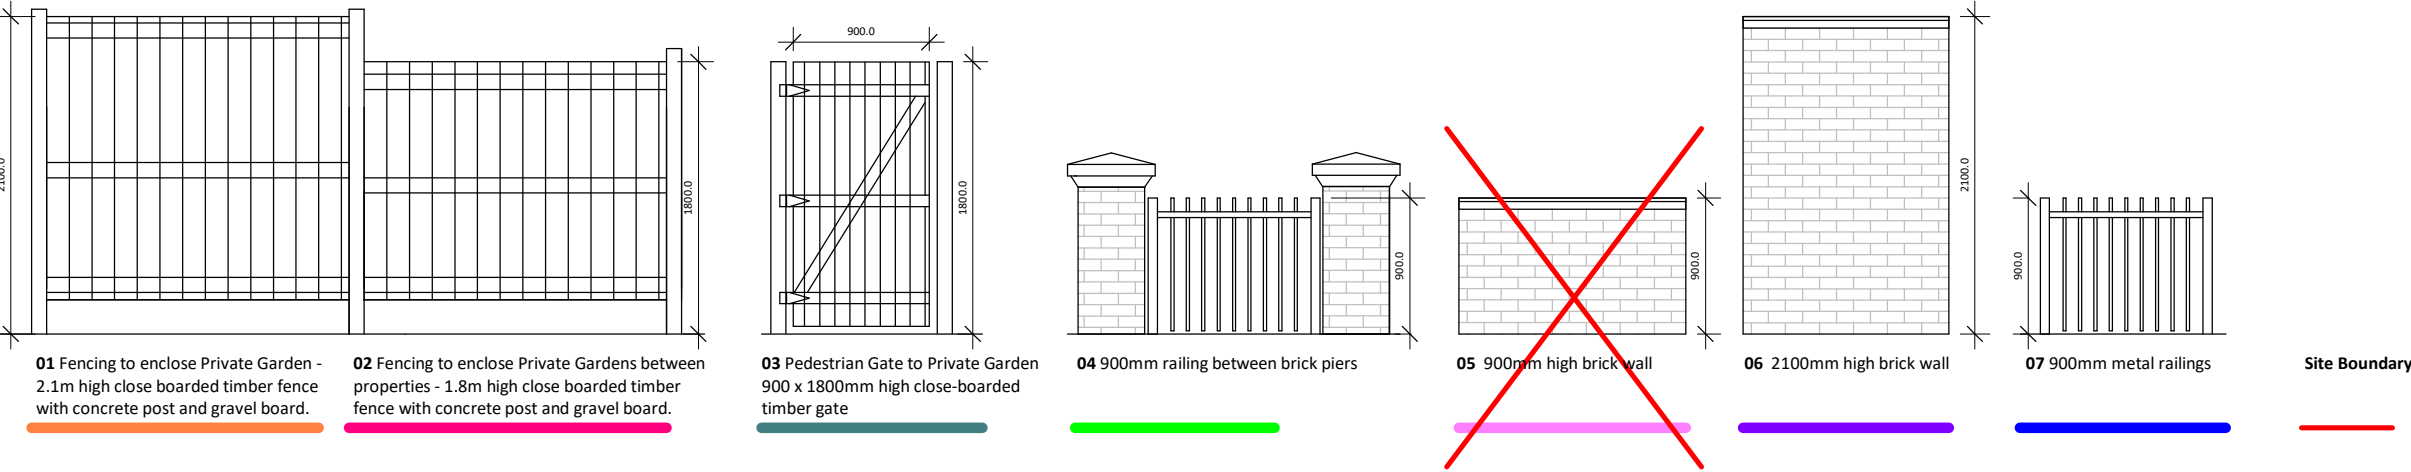

Layout subject to confirmation of red line boundary, all statutory approvals including highways, planning and building regulations, relevant surveys and reports such as topographical, ecology, trees, ground investigation and flood risk.

5	13.11.24	JW	Drawings revised prior to planning submission
4	11.11.24	JW	Planning pack updated in line with planning officer feedback
3	01.10.24	JW	Schedule added to proposed site plan and removed from boundary plan
2	13.09.24	JW	Planning package finalised prior to planning submission
1	05.08.24	JW	Site Layout amended to incorporate landscaping design
Rev	Date	Int	Description

btp
ARCHITECTS

RIBA
Chartered Practice

CLIENT:
One Manchester

PROJECT:
P500 - Winston Road, Hodge Street and Lordship Close

DESCRIPTION:
Proposed Boundary

PURPOSE OF ISSUE:
Planning

DRAWN BY: CHECKED DATE: SCALE @ A1:
JW VS 18.04.24 As indicated

JOB NO: STATUS CODE: DRAWING NO: REV
3793 S2 209 5

FILE IDENTIFIER:
P5-BTP-00-SP-DR-A-3793_209.5

Elizabeth House 486 Didsbury Road Heaton Mersey Stockport SK4 3BS
0161 443 1221 info@bernardtaylor.co.uk www.btparchitects.co.uk