



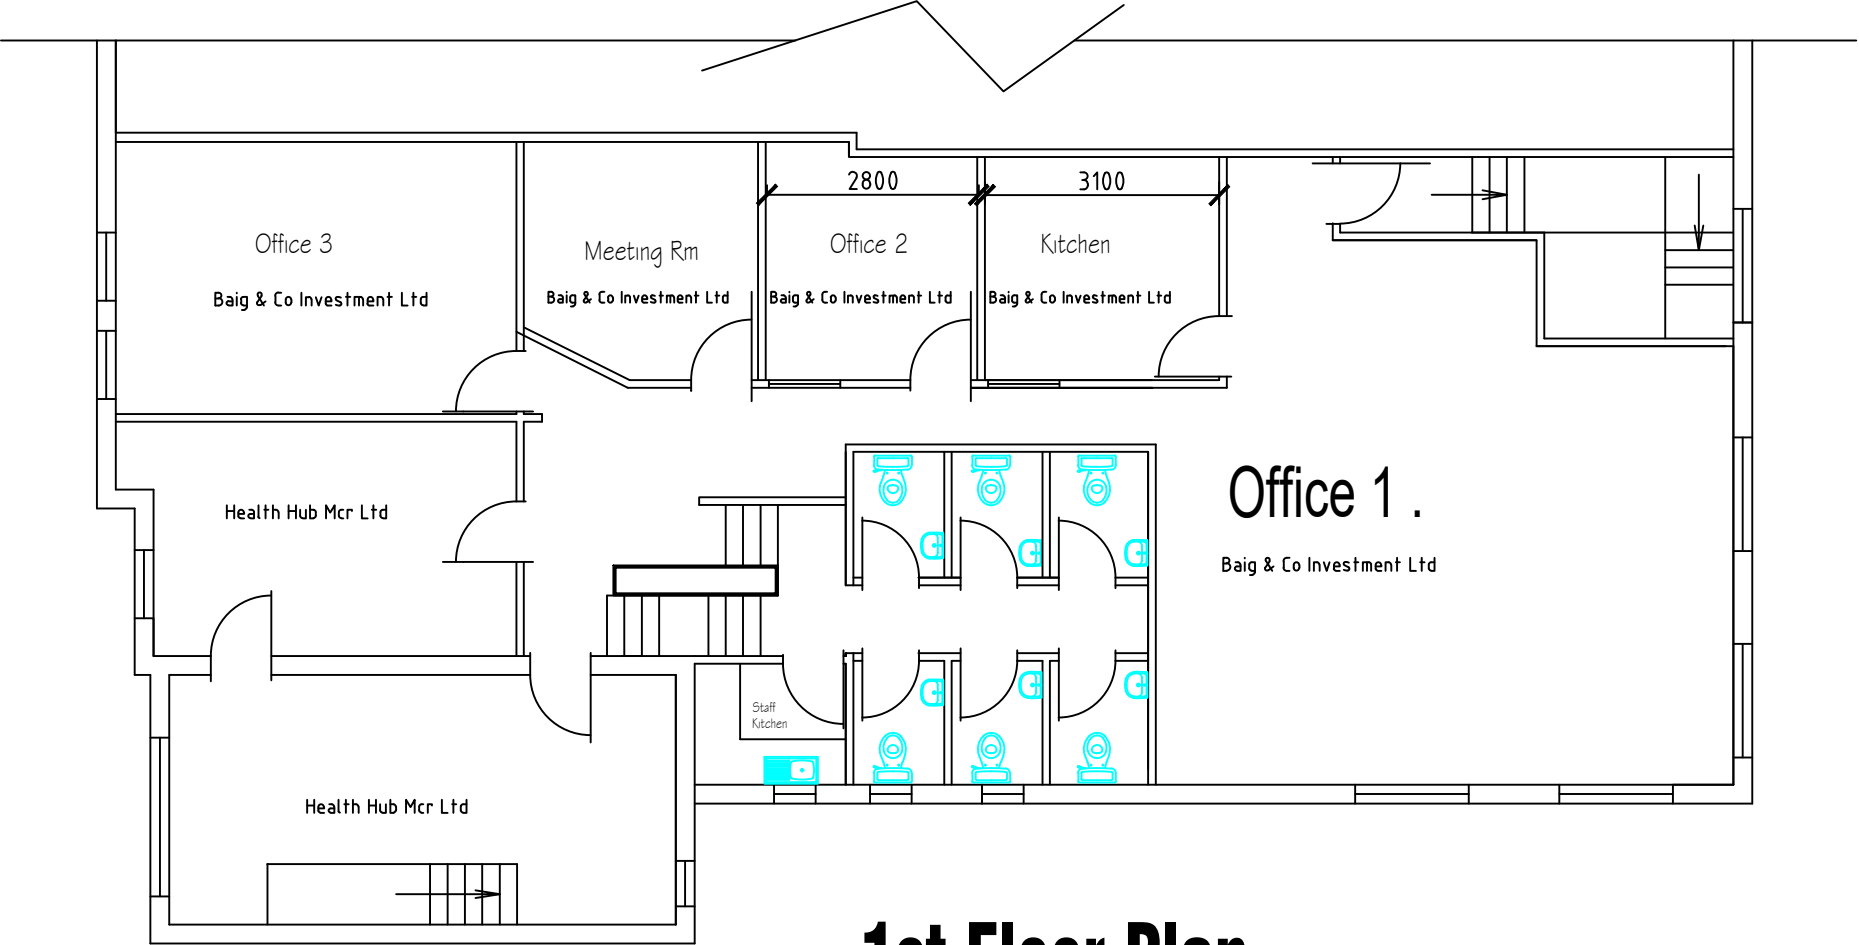

1st Floor Plan

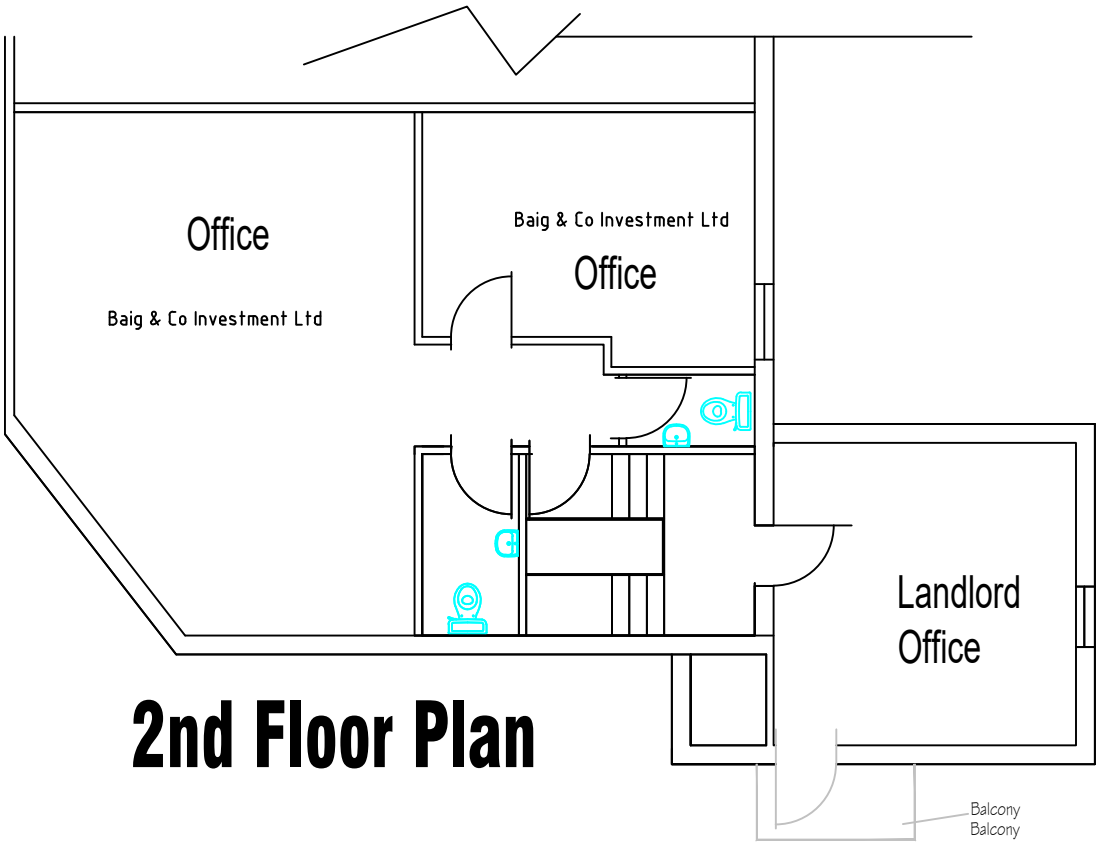

2nd Floor Plan

The builder must check the site and the approved drawings before commencing the works and must take any working measurements as necessary. Any discrepancy in the drawing must be reported to the client .

REVISION			initial	
no.	date	description		
A	4.11.24	Planning		

HSB
Engineering Design Services Ltd
428 Cheetham Hill Road Cheetham Manchester
M8 9LE. UK 01617956385,07940197333



project title	3no. class E units with ancillary accommodation at basement level and landlord office on second floor.		
client	Mr Mohammed Saddique		
dwg. title	"As Built 1st & 2nd Floor Plan"		
dwg. no.	sheet no.	scale.	job no.
23A		1:100 @A3	
443 Cheetham Hill Road Cheetham Manchester M8 OPF			
drawn by.	checked by.	approved by.	date
TZ			March 2023