



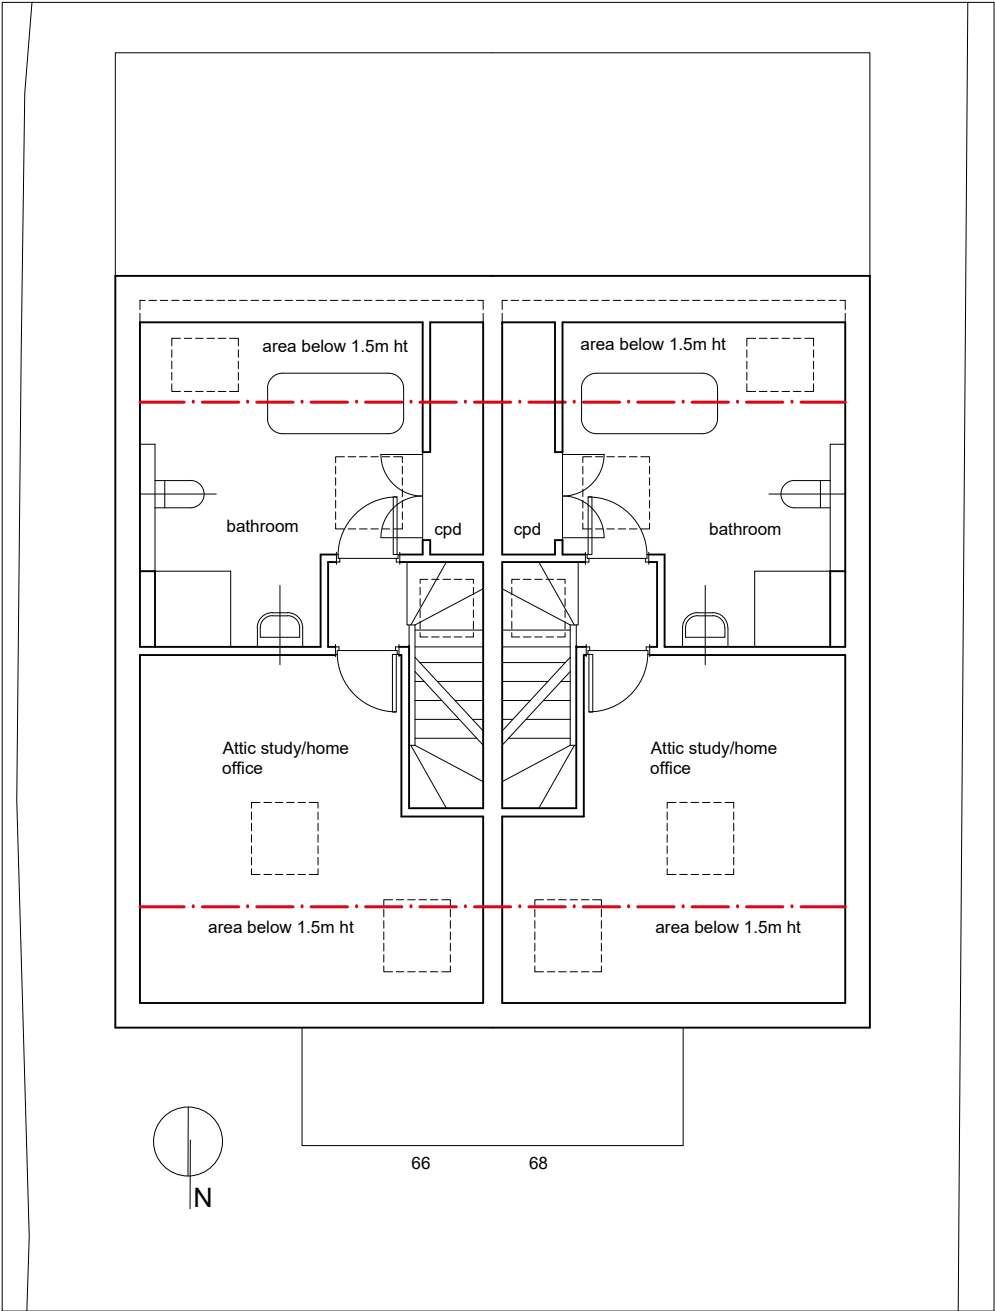


As built Attic fl plan

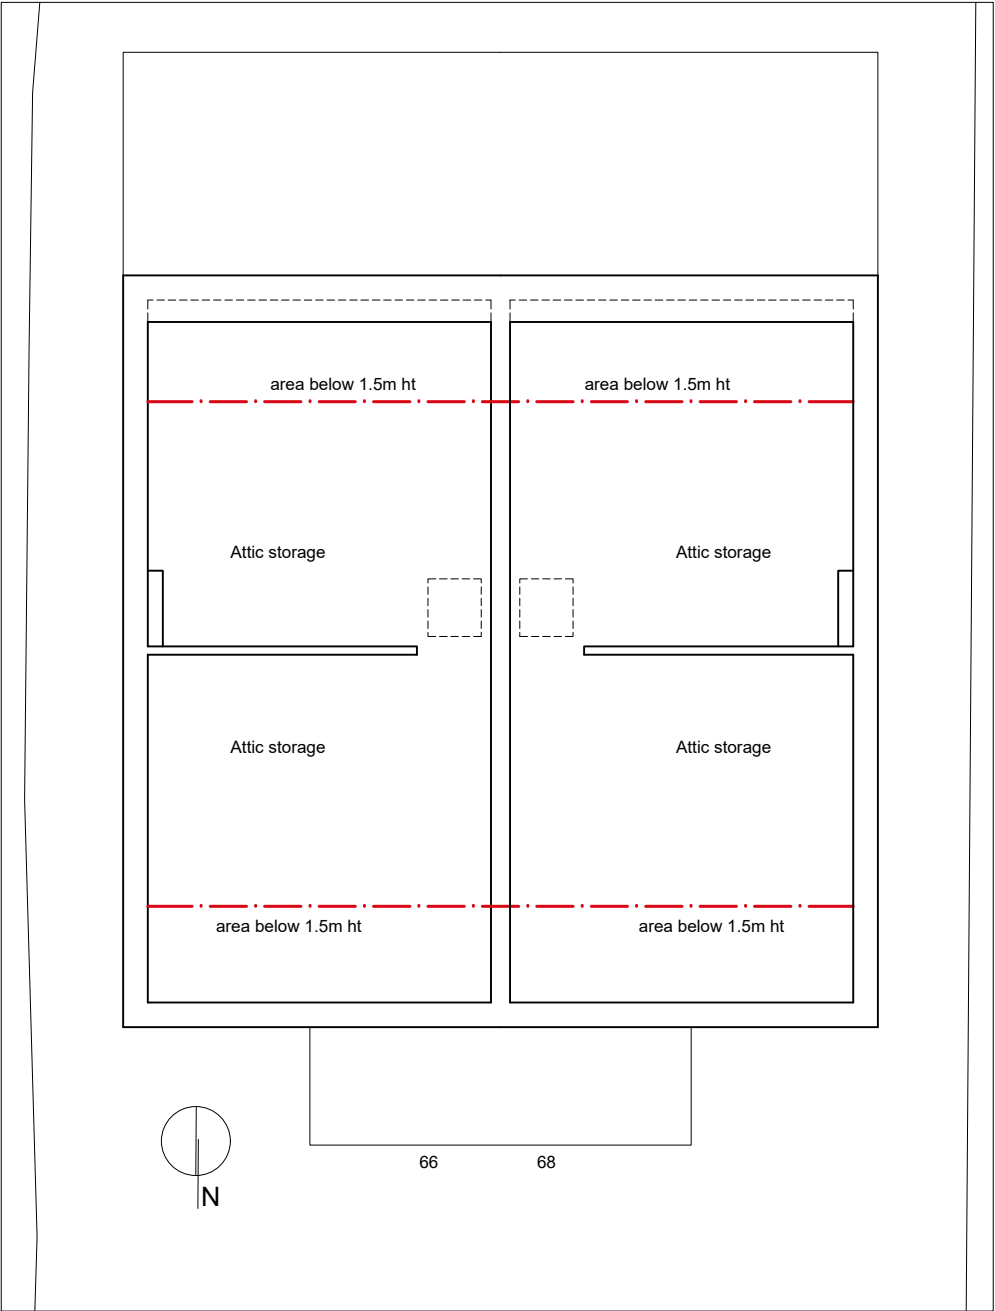


Roof void not drawn for planning application


PROJECT				66 & 68 Moseley rd, Fallowfield.	
SCALE		1 : 100 @ A3		CLIENT	
DWG No.		169-SK- GA4(2)		AIRSHACK LTD	
CONTRACT NO.		STAGE CODE	REV.	DRAWING TITLE	
169		sketch	-	Proposed Attic & As built plan	
ISSUED	20/07/24		-	sj simon james architect	

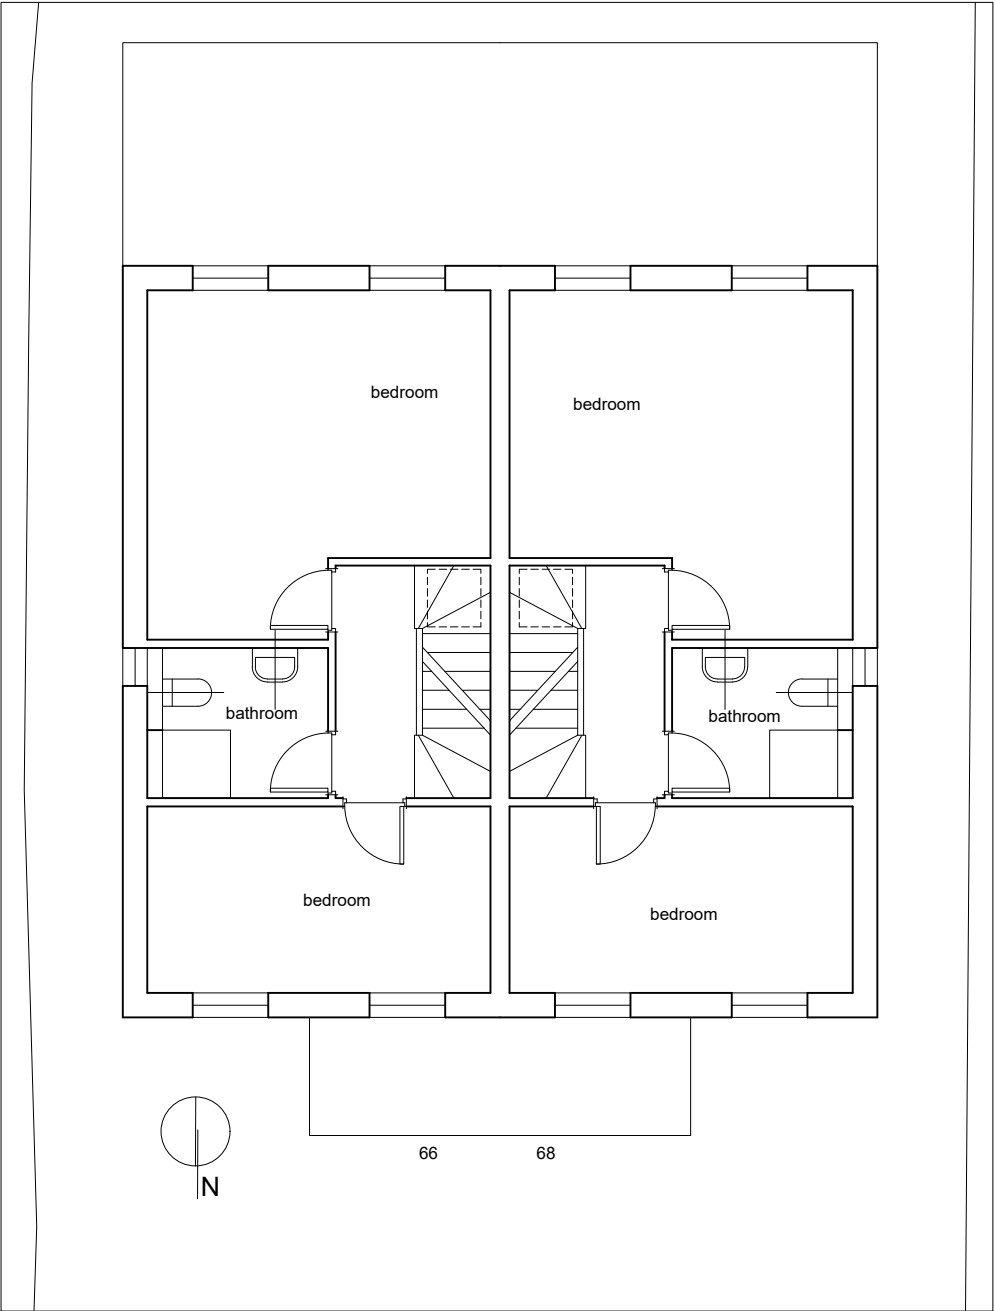

As built 2nd fl plan

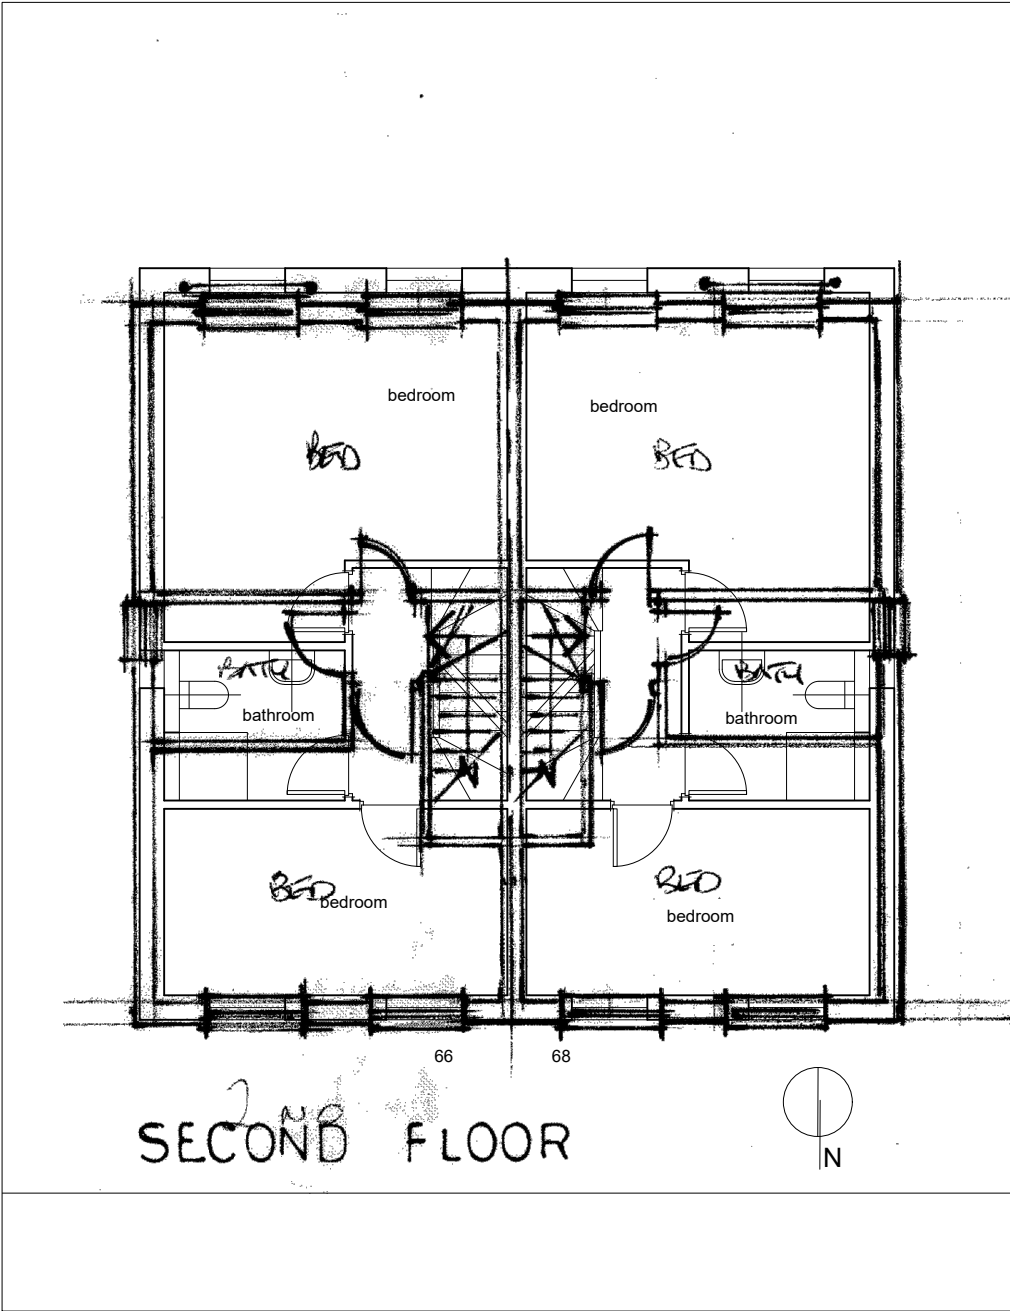


Planning approved & As built 2nd fl plan overlay

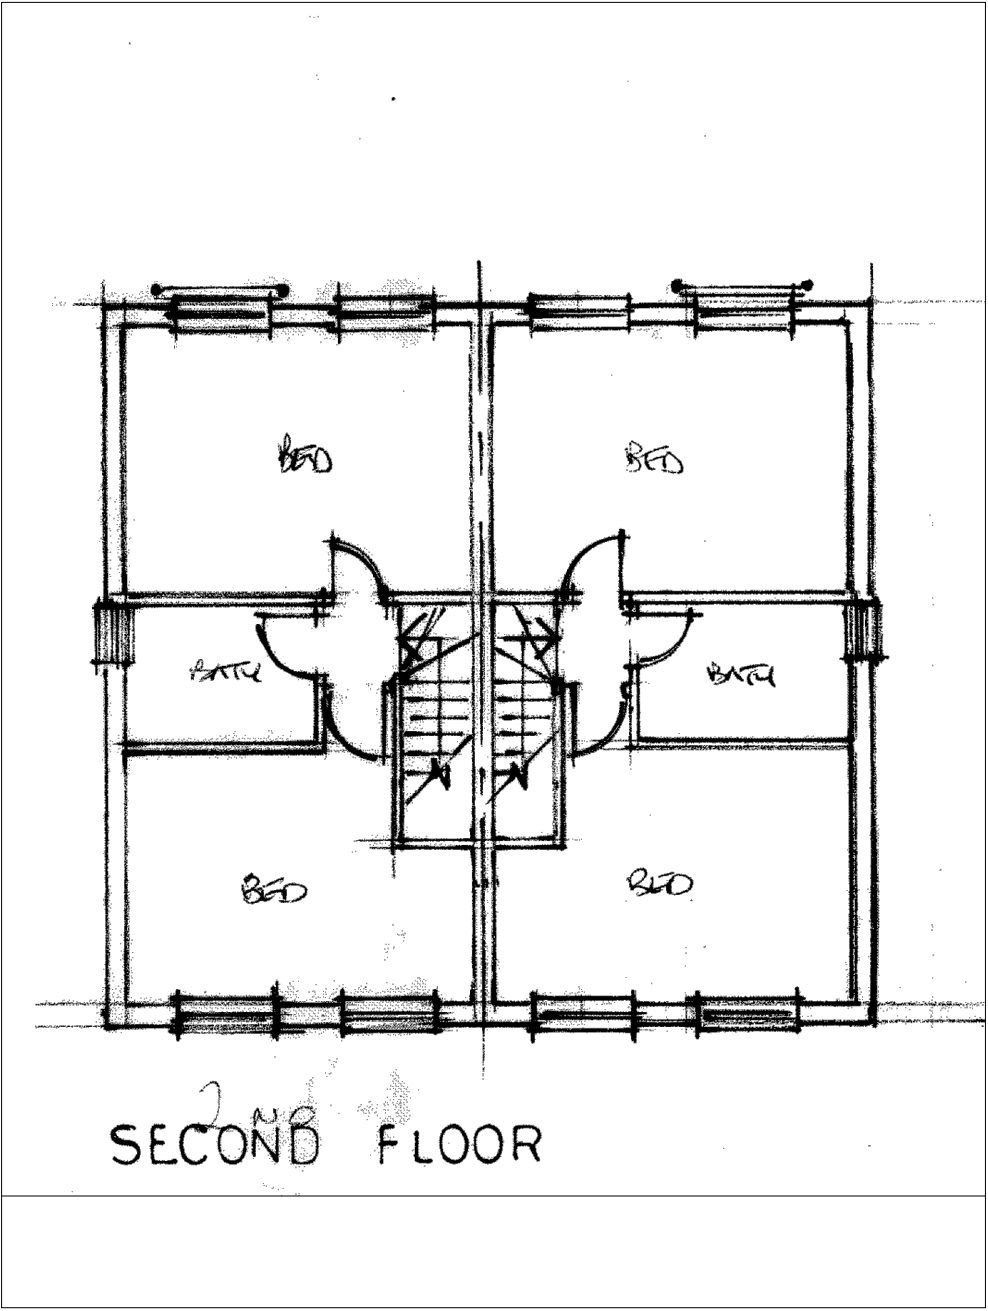


Planning approved 2nd Floor plan


PROJECT				66 & 68 Moseley rd, Fallowfield.	
SCALE		1 : 100 @ A3		CLIENT	
DWG No.		169-SK- GA3(2)		AIRSHACK LTD	
CONTRACT NO:		STAGE CODE	REV.	DRAWING TITLE	
169		sketch	-	Approved & As built 2nd fl plan overlays	
ISSUED	20/07/24		-	sj simon james architect	

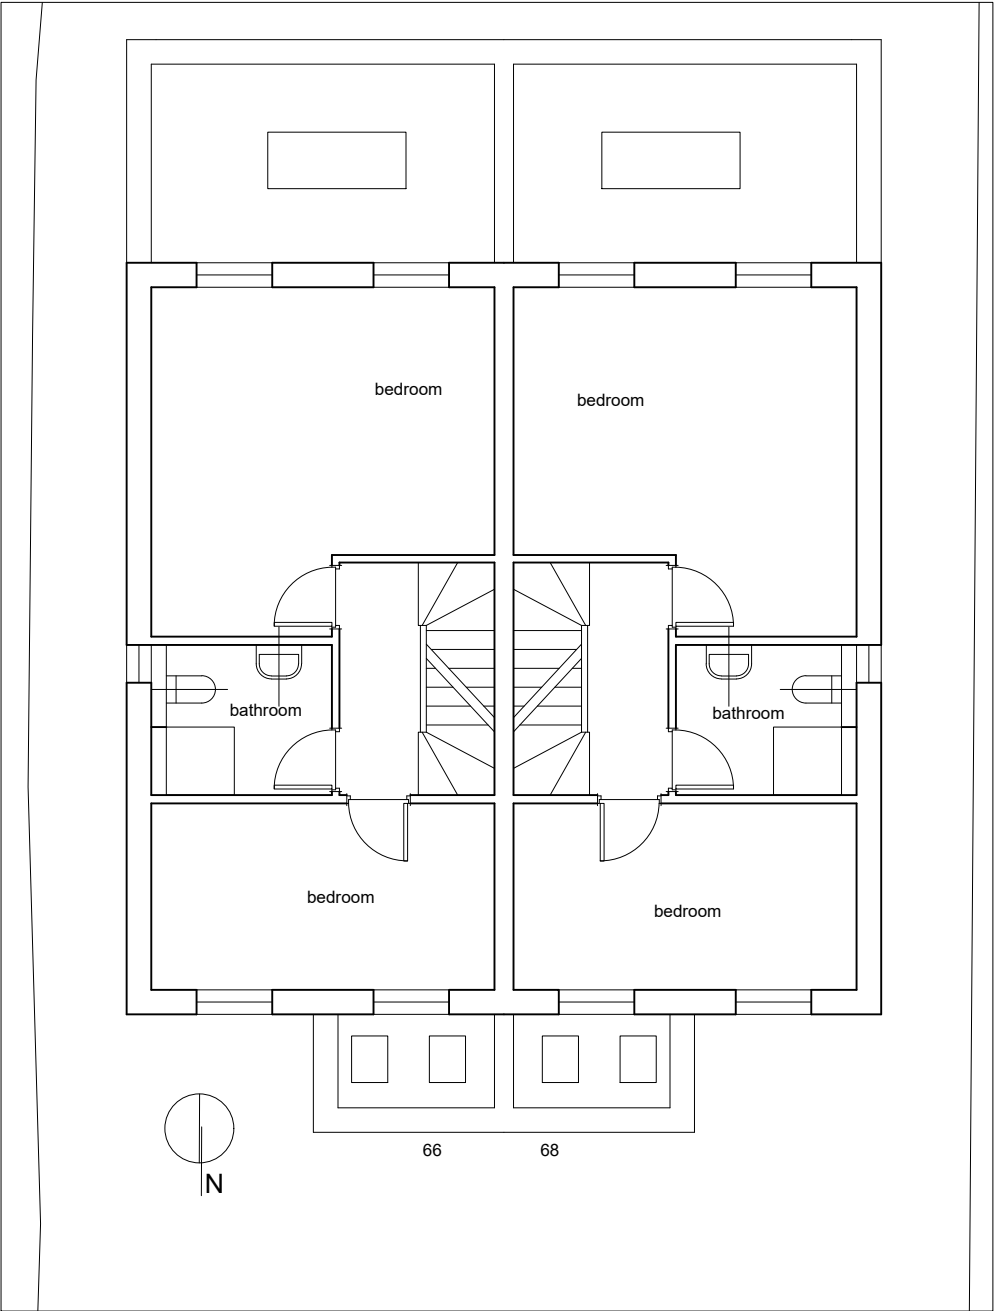

As built 1st fl plan

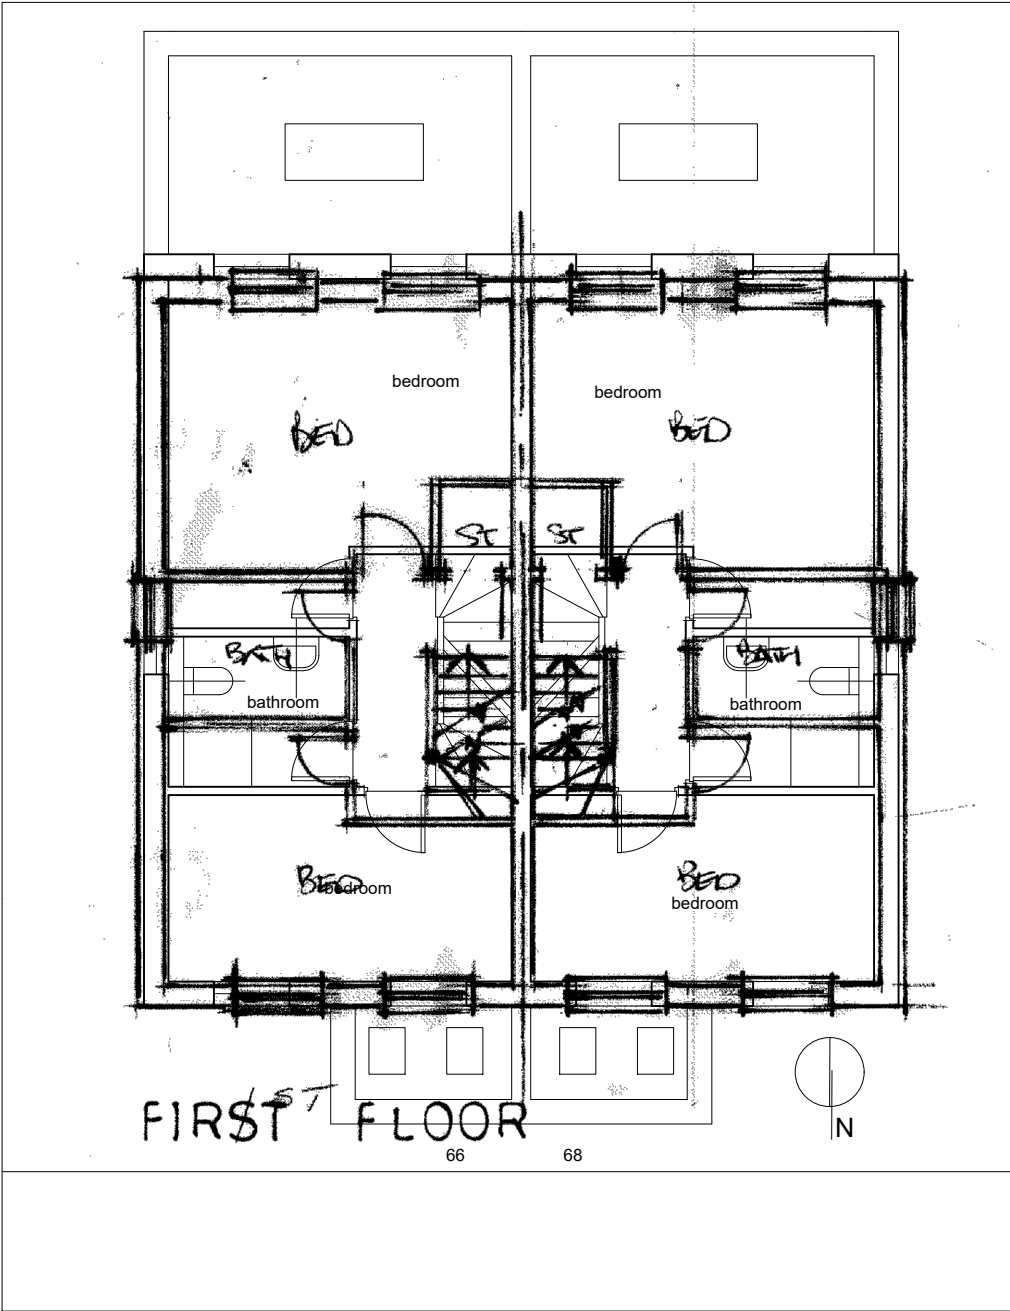


Planning approved & As built 1st fl plan overlay

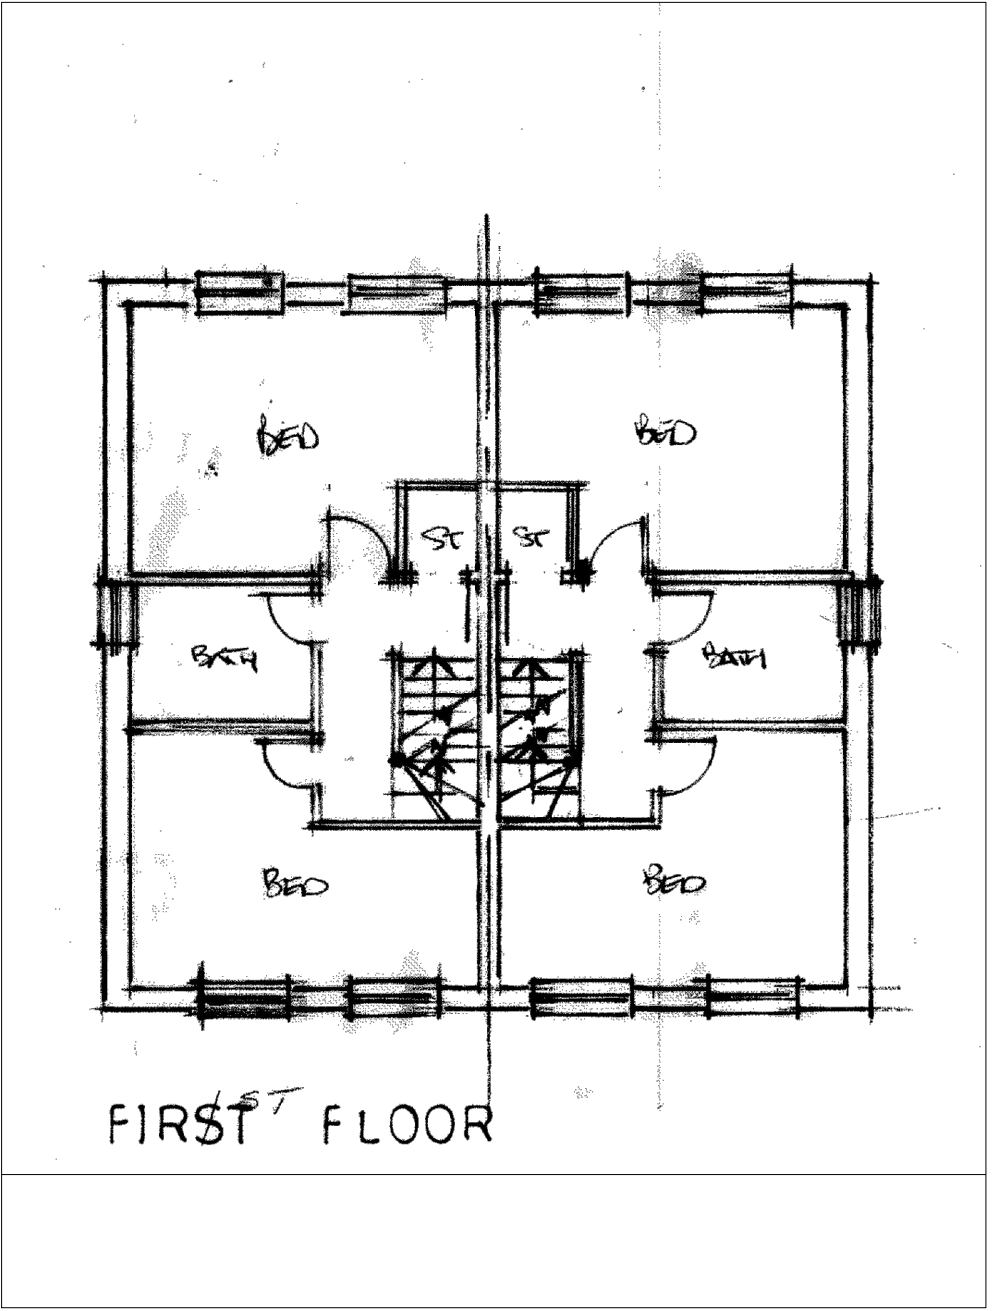


Planning approved 1st Floor plan


PROJECT				66 & 68 Moseley rd, Fallowfield.	
SCALE		1 : 100 @ A3		CLIENT	
DWG No.		169-SK-GA2(2)		AIRSHACK LTD	
CONTRACT NO.		STAGE CODE	REV.	DRAWING TITLE	
169		sketch	-	Approved & As built 1st fl plan overlays	
ISSUED	20/07/24		-	sj simon james architect	

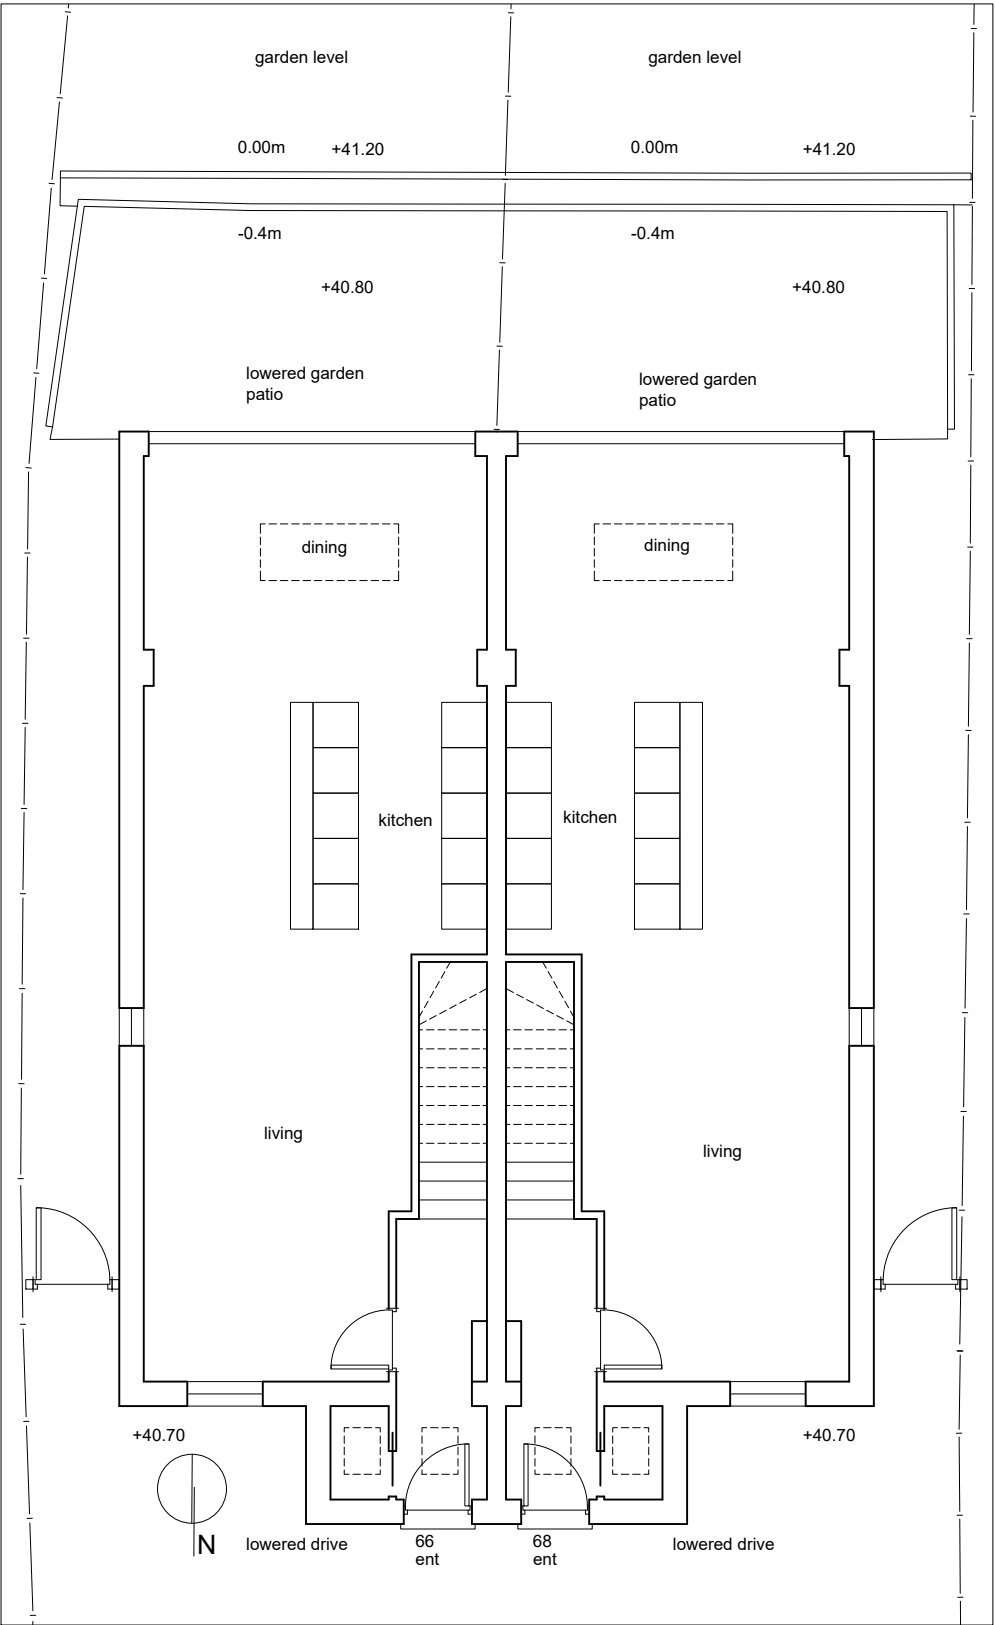

As built Grd fl plan



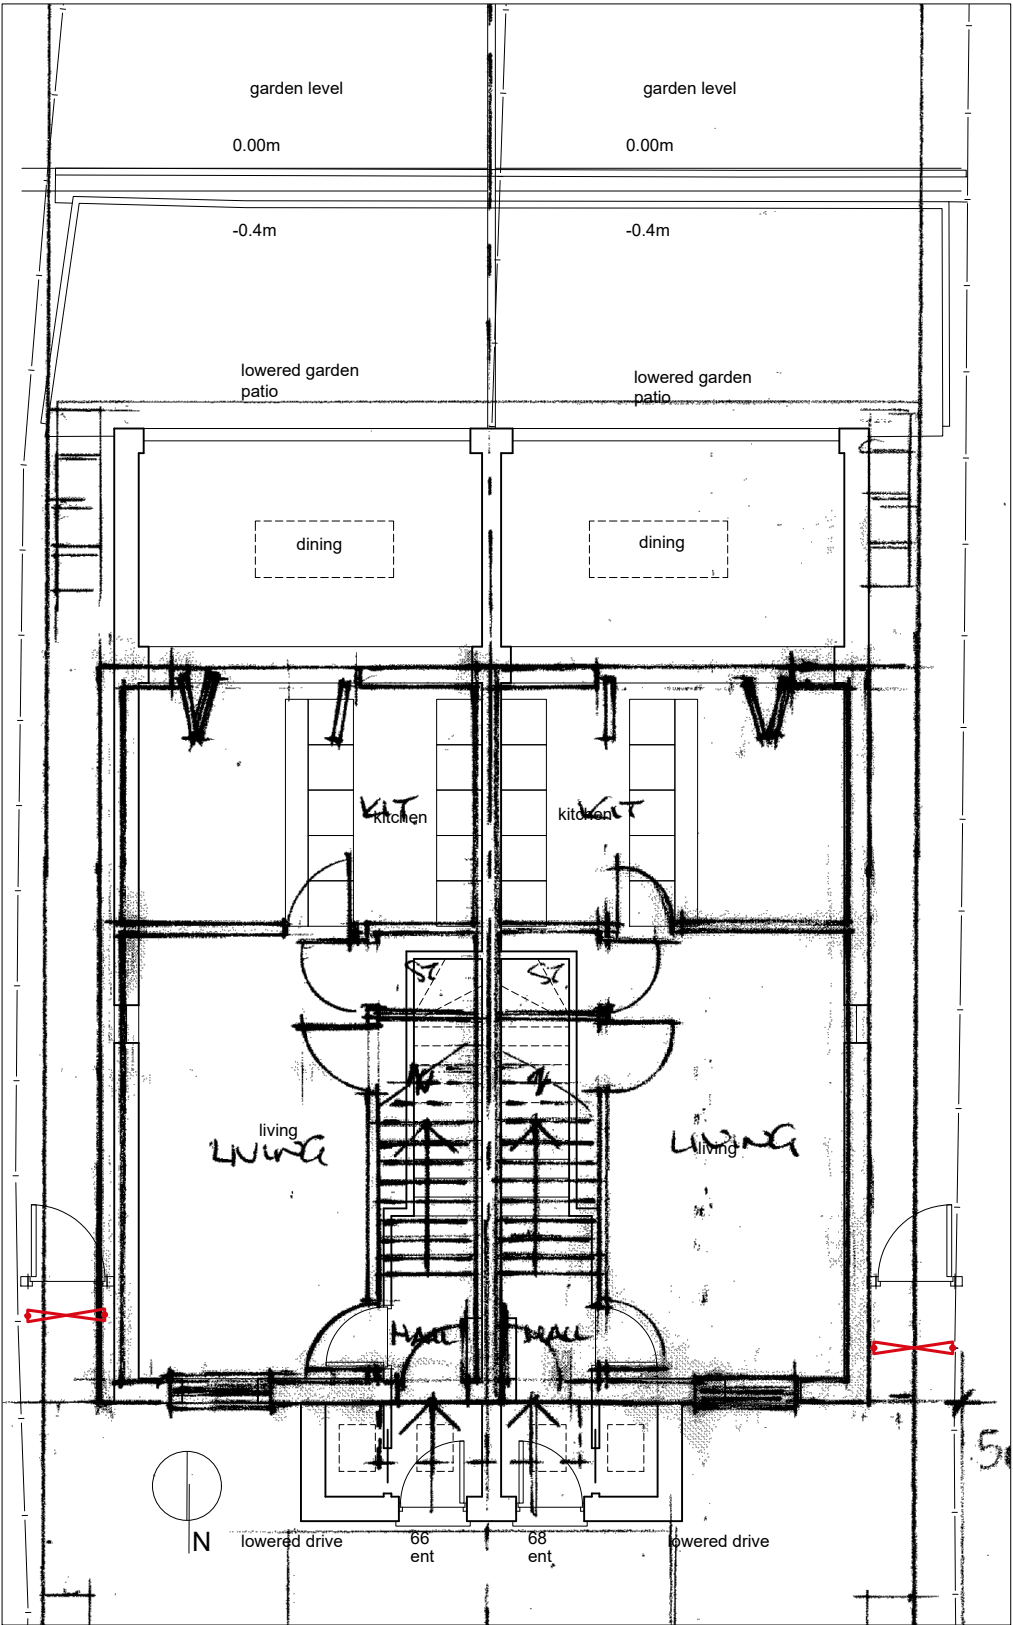


Planning approved & As built Grd fl plan overlay

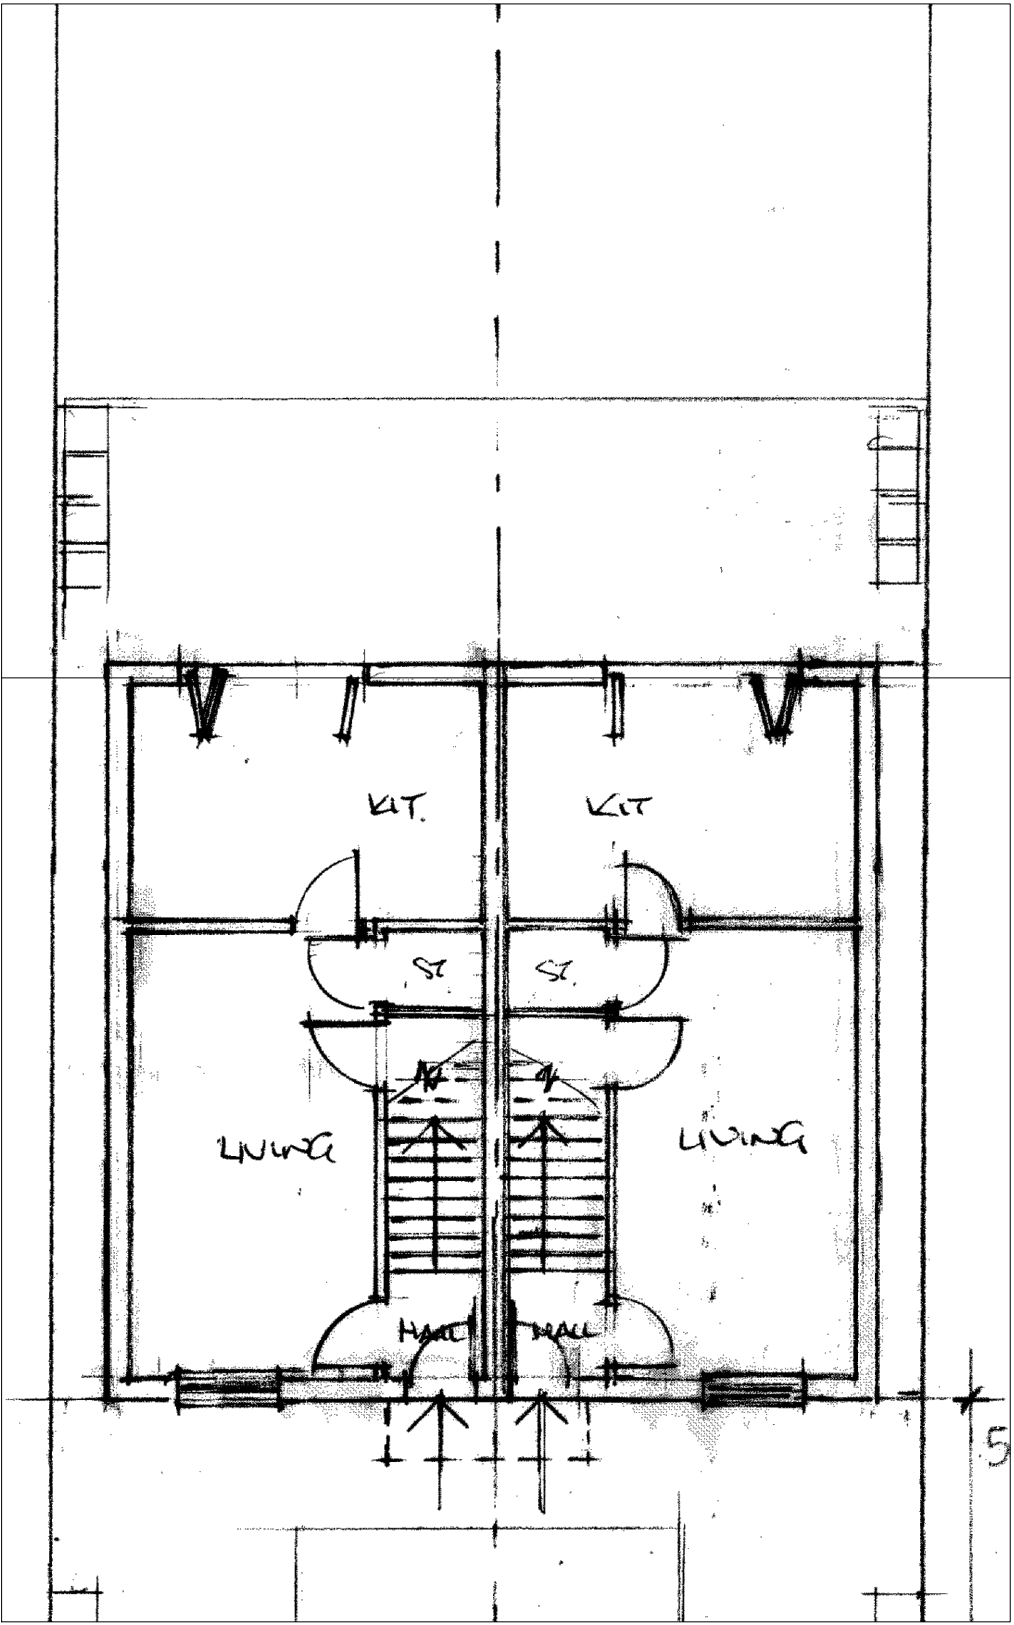


Planning approved Ground Floor plan

PROJECT				66 & 68 Moseley rd, Fallowfield.	
SCALE			CLIENT AIRSHACK LTD		
1 : 100 @ A3					
DWG No.			DRAWING TITLE		
169-SK-GA1 (2)					
CONTRACT NO.		STAGE CODE	REV.	Approved & As built Grd fl plan overlays	
169		sketch	-		
ISSUED	20/07/24		-	sj simon james architect	

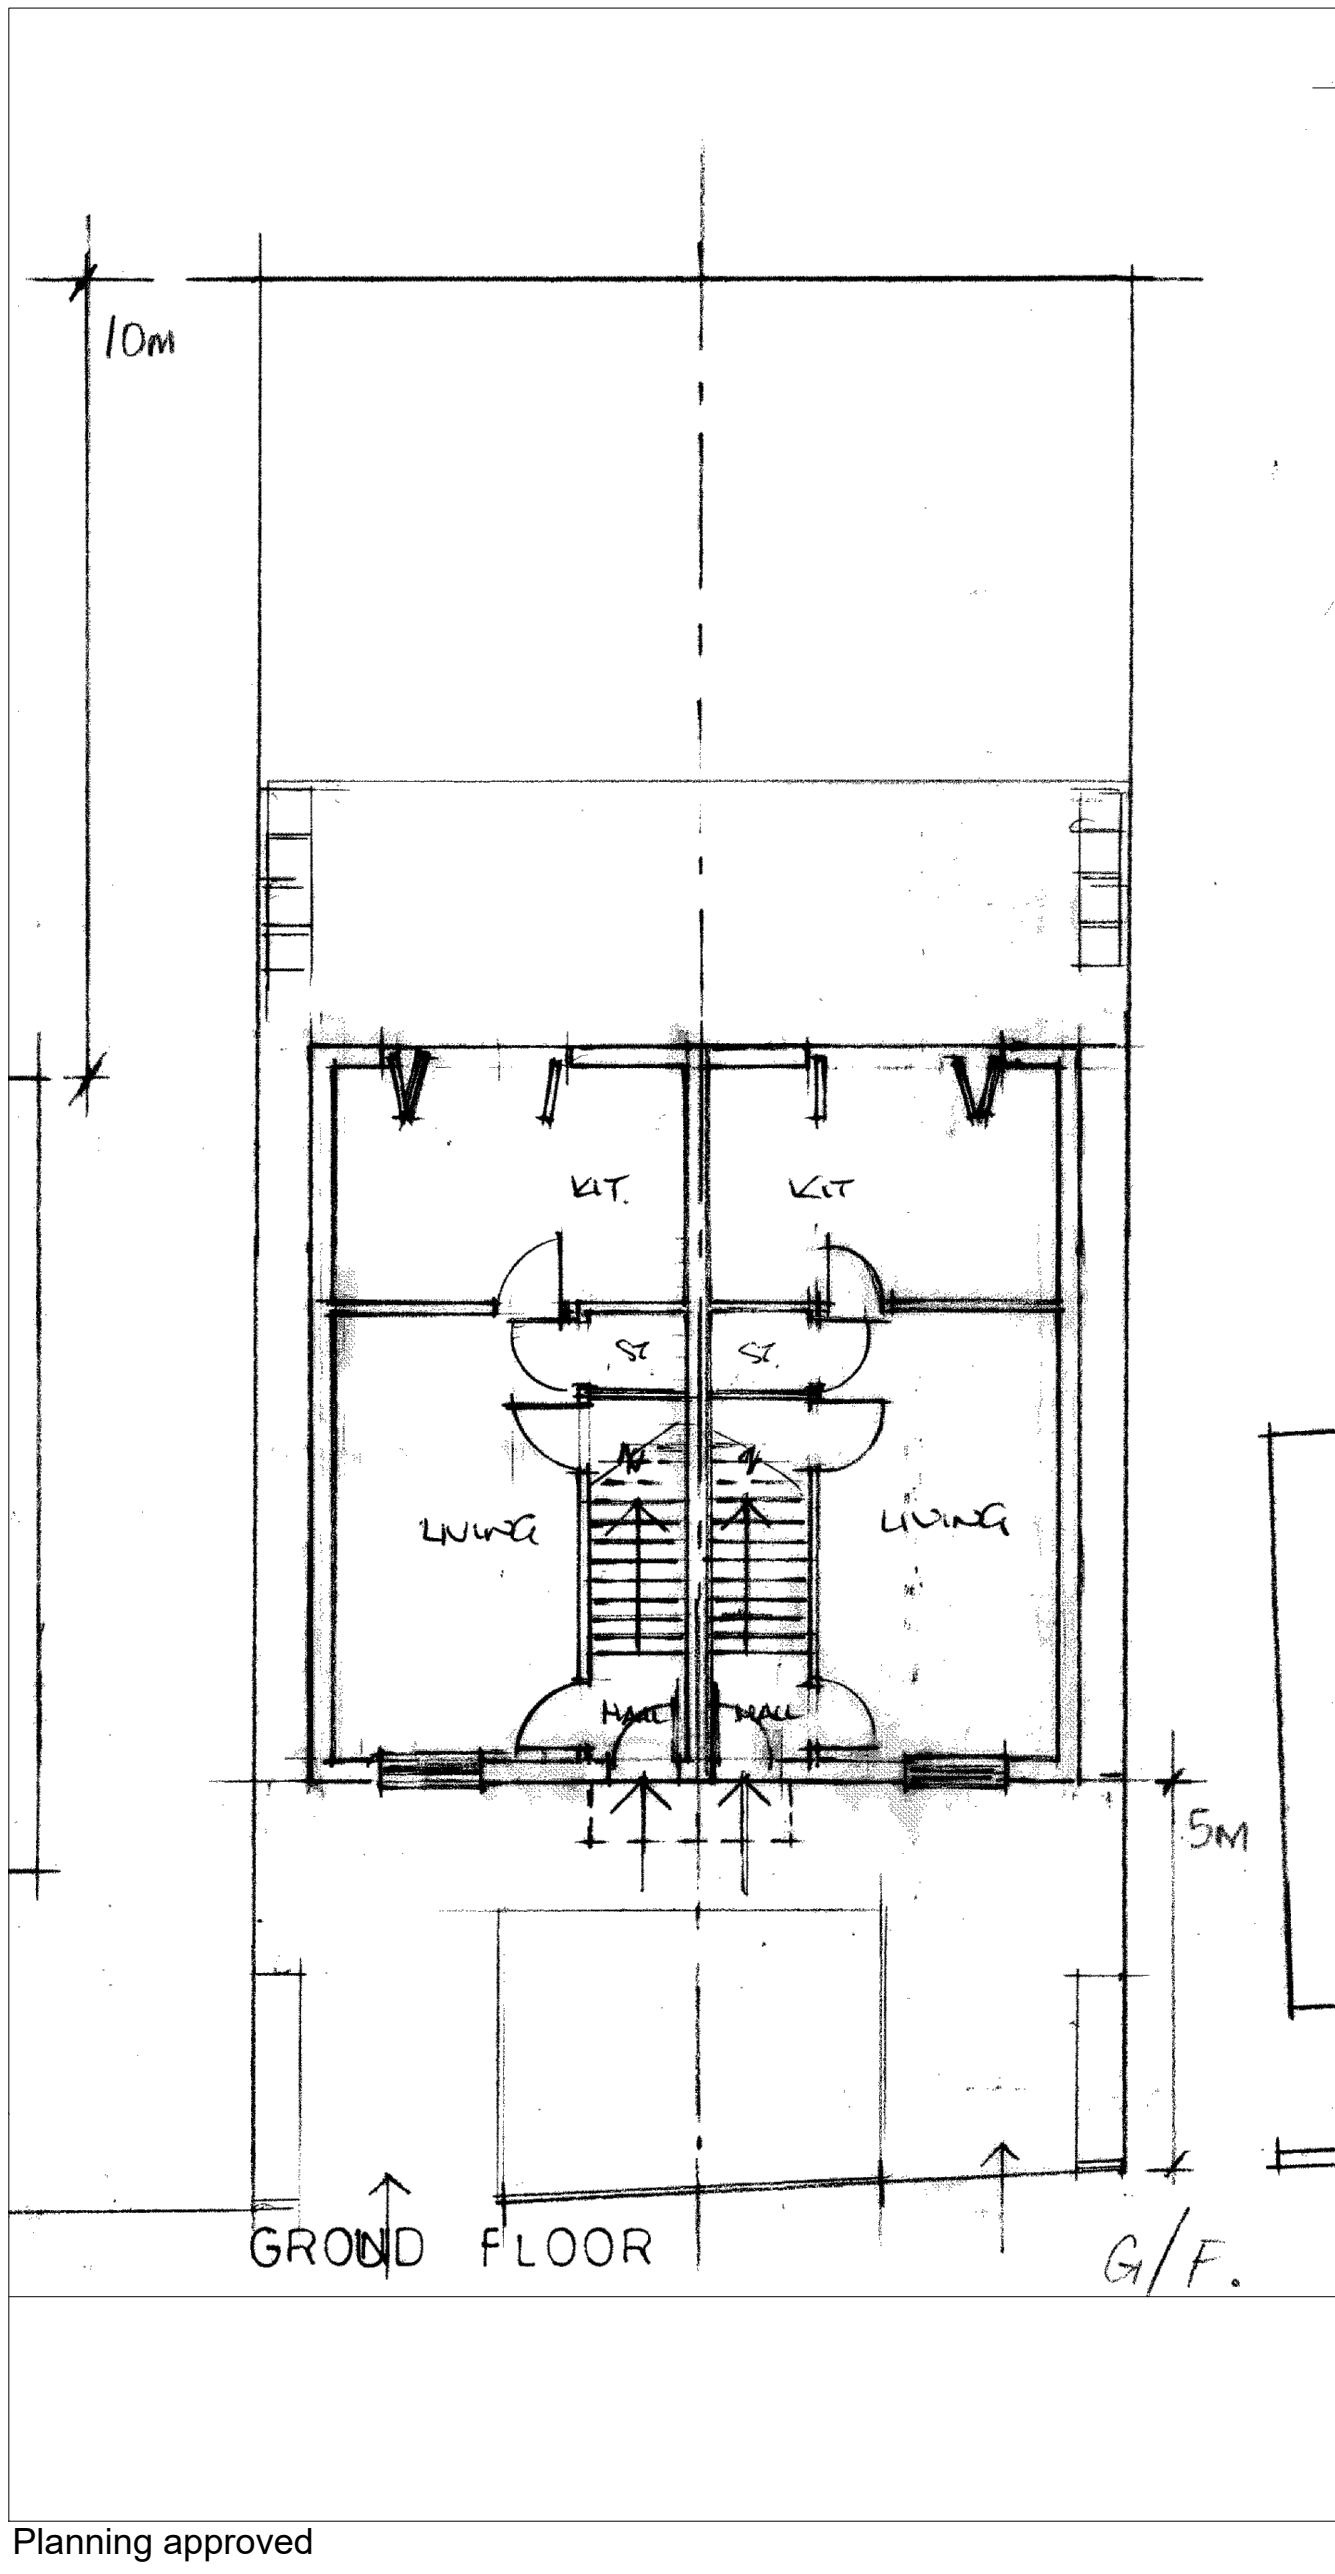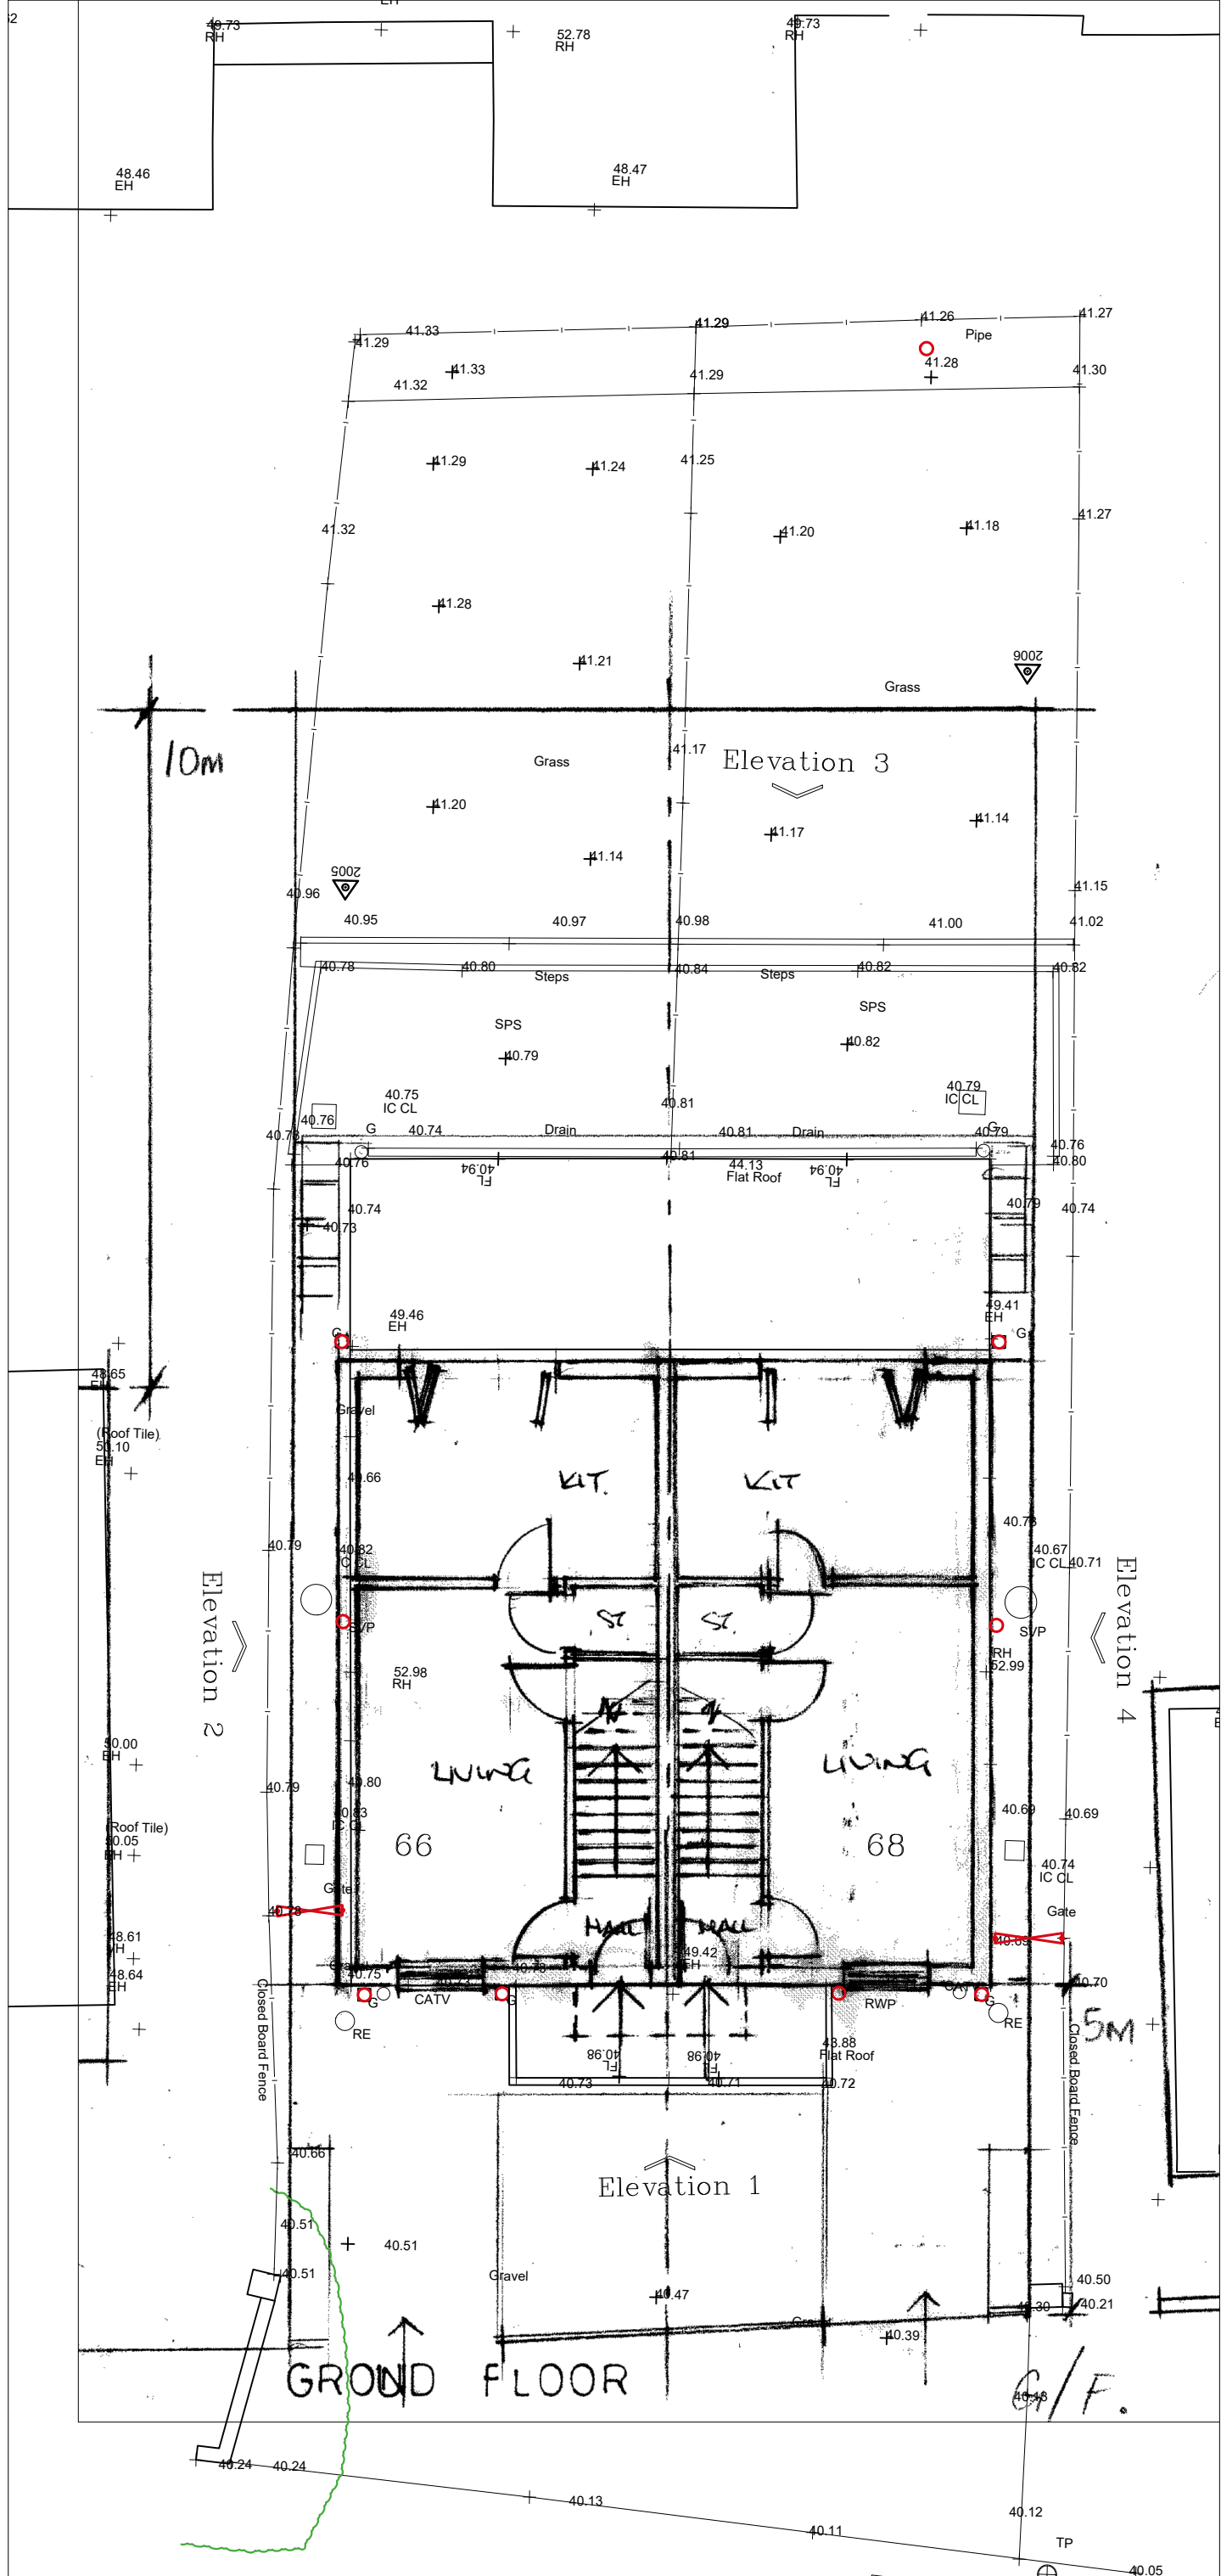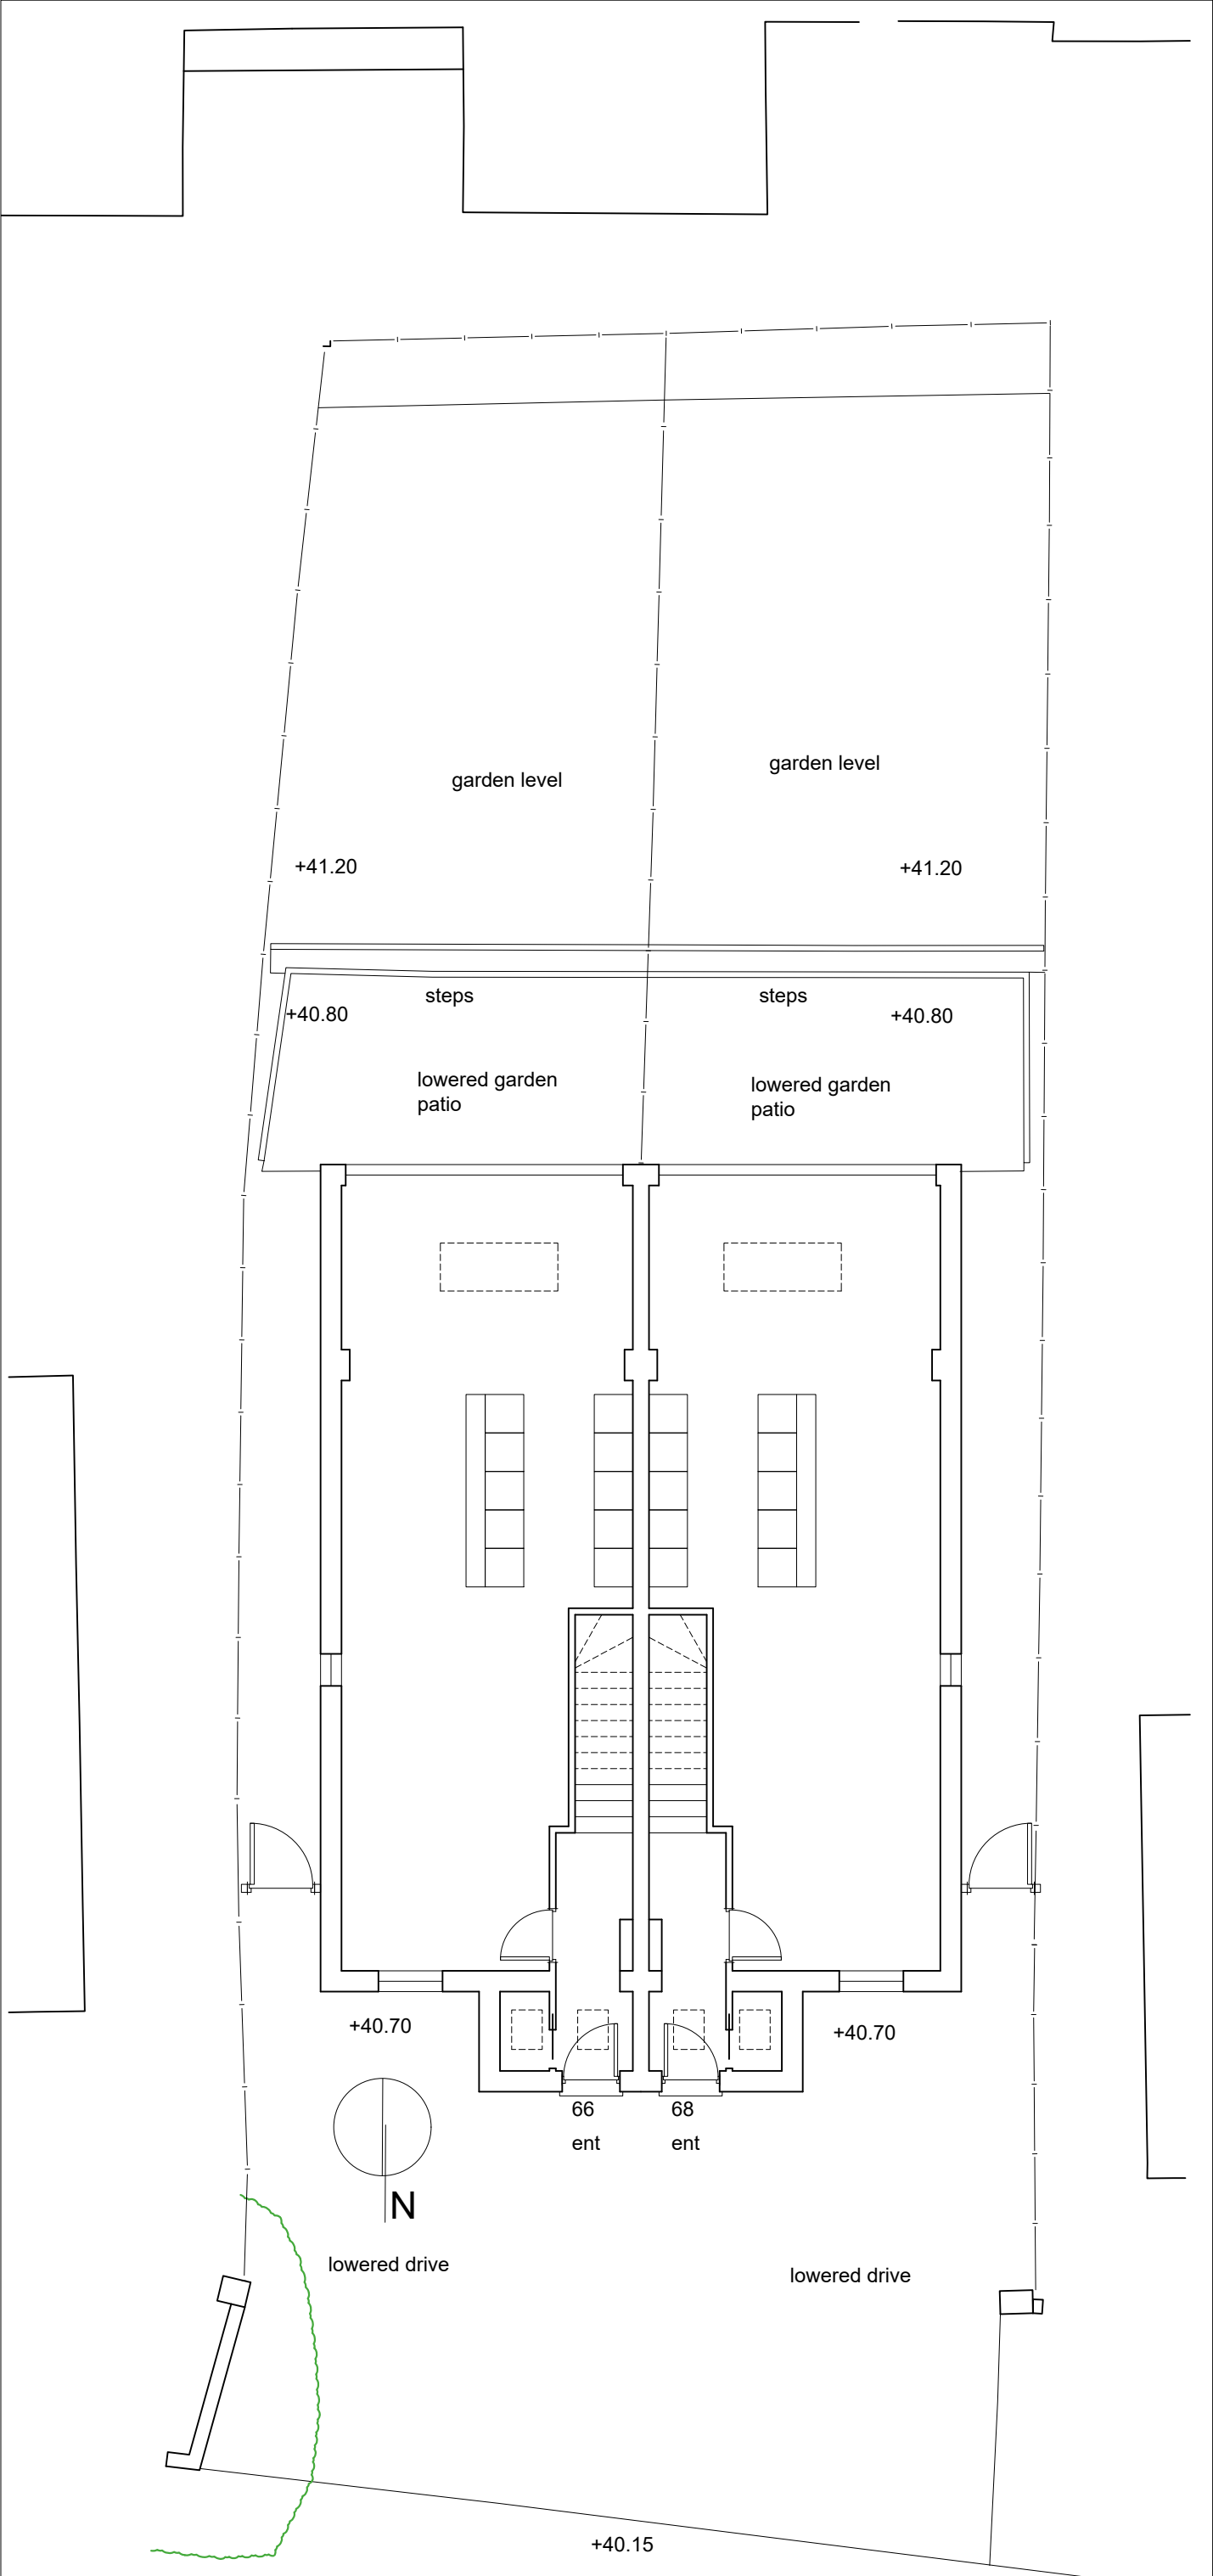

PROJECT				
66 & 68 Moseley rd, Fallowfield.				
SCALE 1 : 200 @ A2			CLIENT AIRSHACK LTD	
DWG No. 169-SK-GL1(2)			DRAWING TITLE Planning approved & As built Site plan	
CONTRACT NO. 169		STAGE CODE sketch	REV. -	
ISSUED	20/07/24		-	sj simon james architect

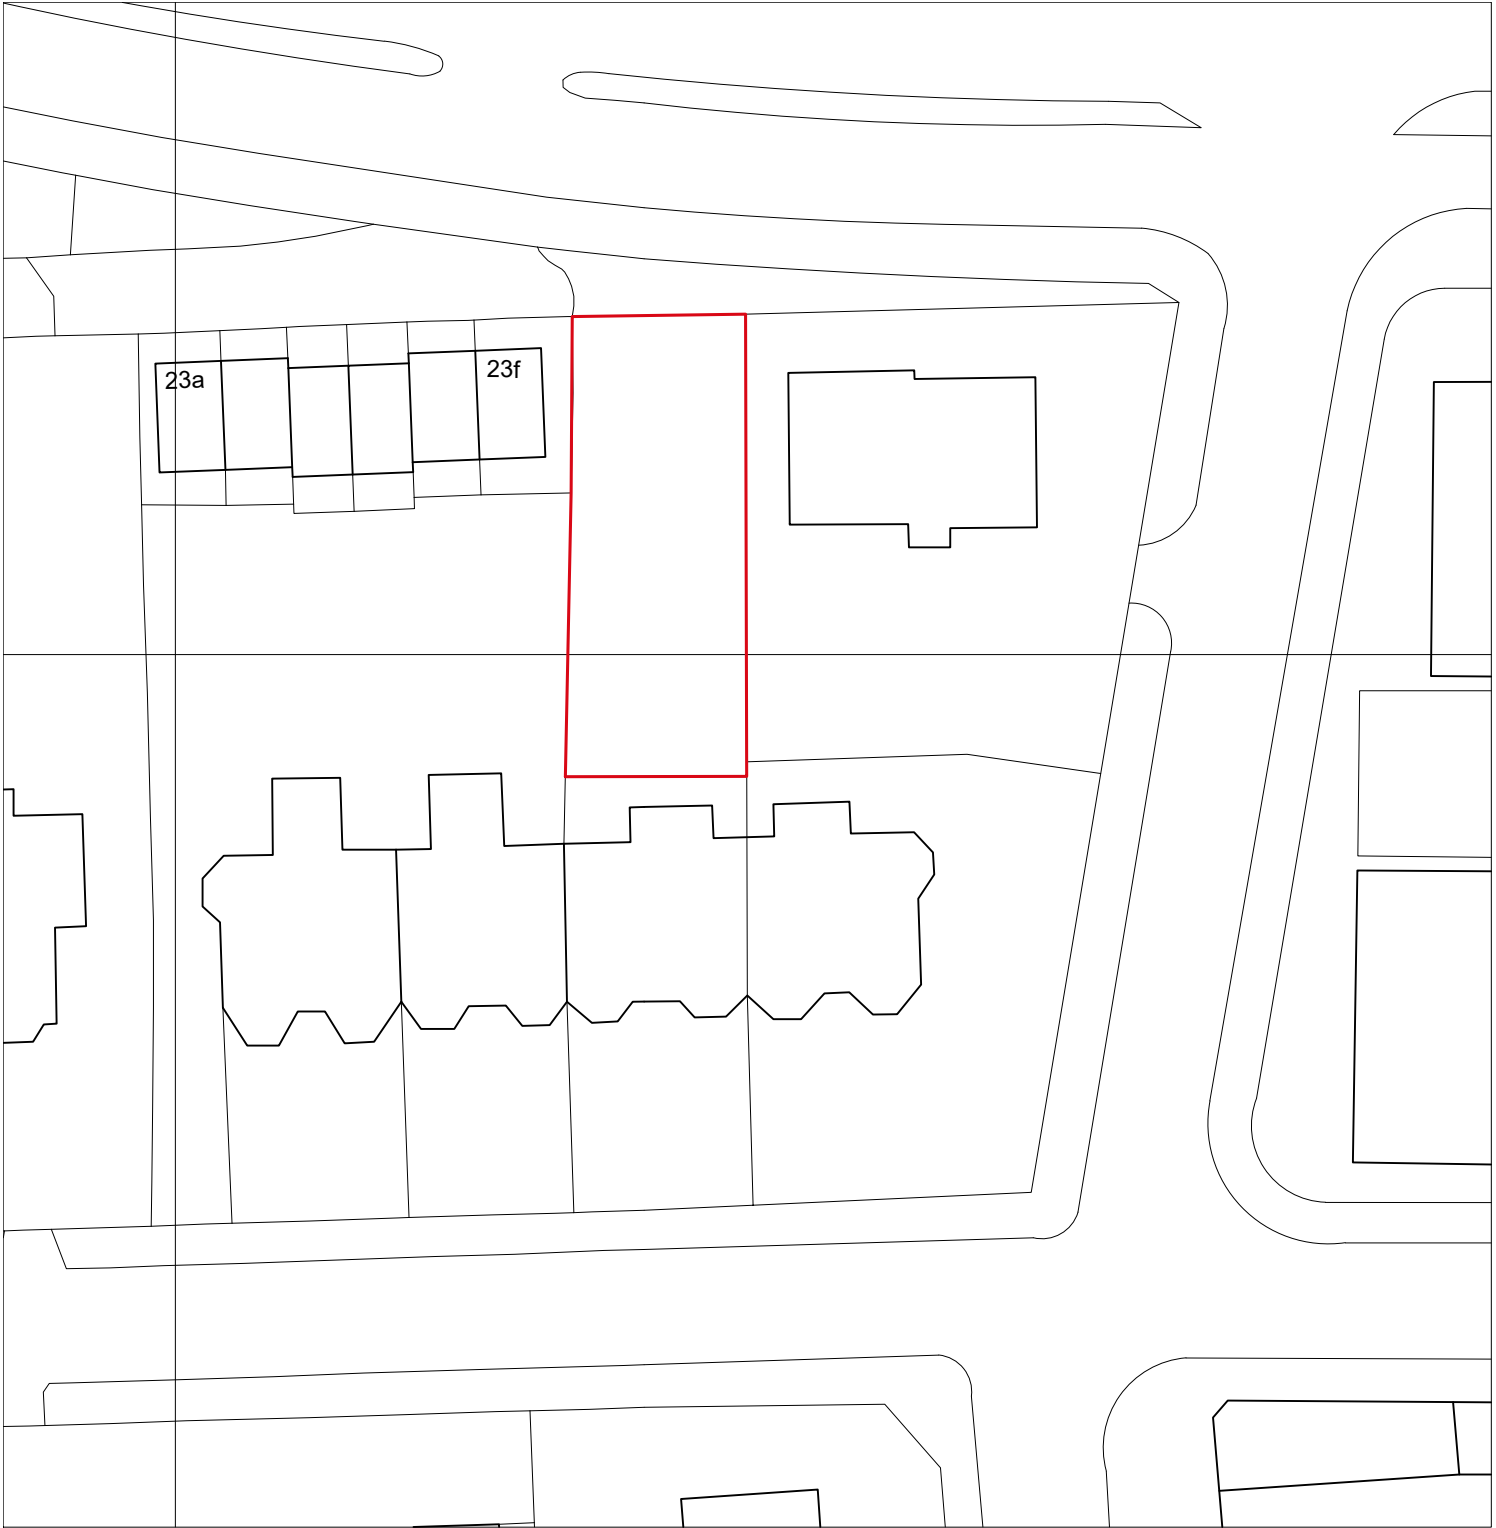

PROJECT				66 & 68 Moseley rd, Fallowfield.	
SCALE		1 : 500 @ A4		CLIENT	
DWG No.		169-SK-GL1		AIRSHACK LTD	
CONTRACT NO:		STAGE CODE	REV.	DRAWING TITLE	
169		sketch	-	O.S. Location plan	
ISSUED	20/07/24		-	sj simon james architect	