




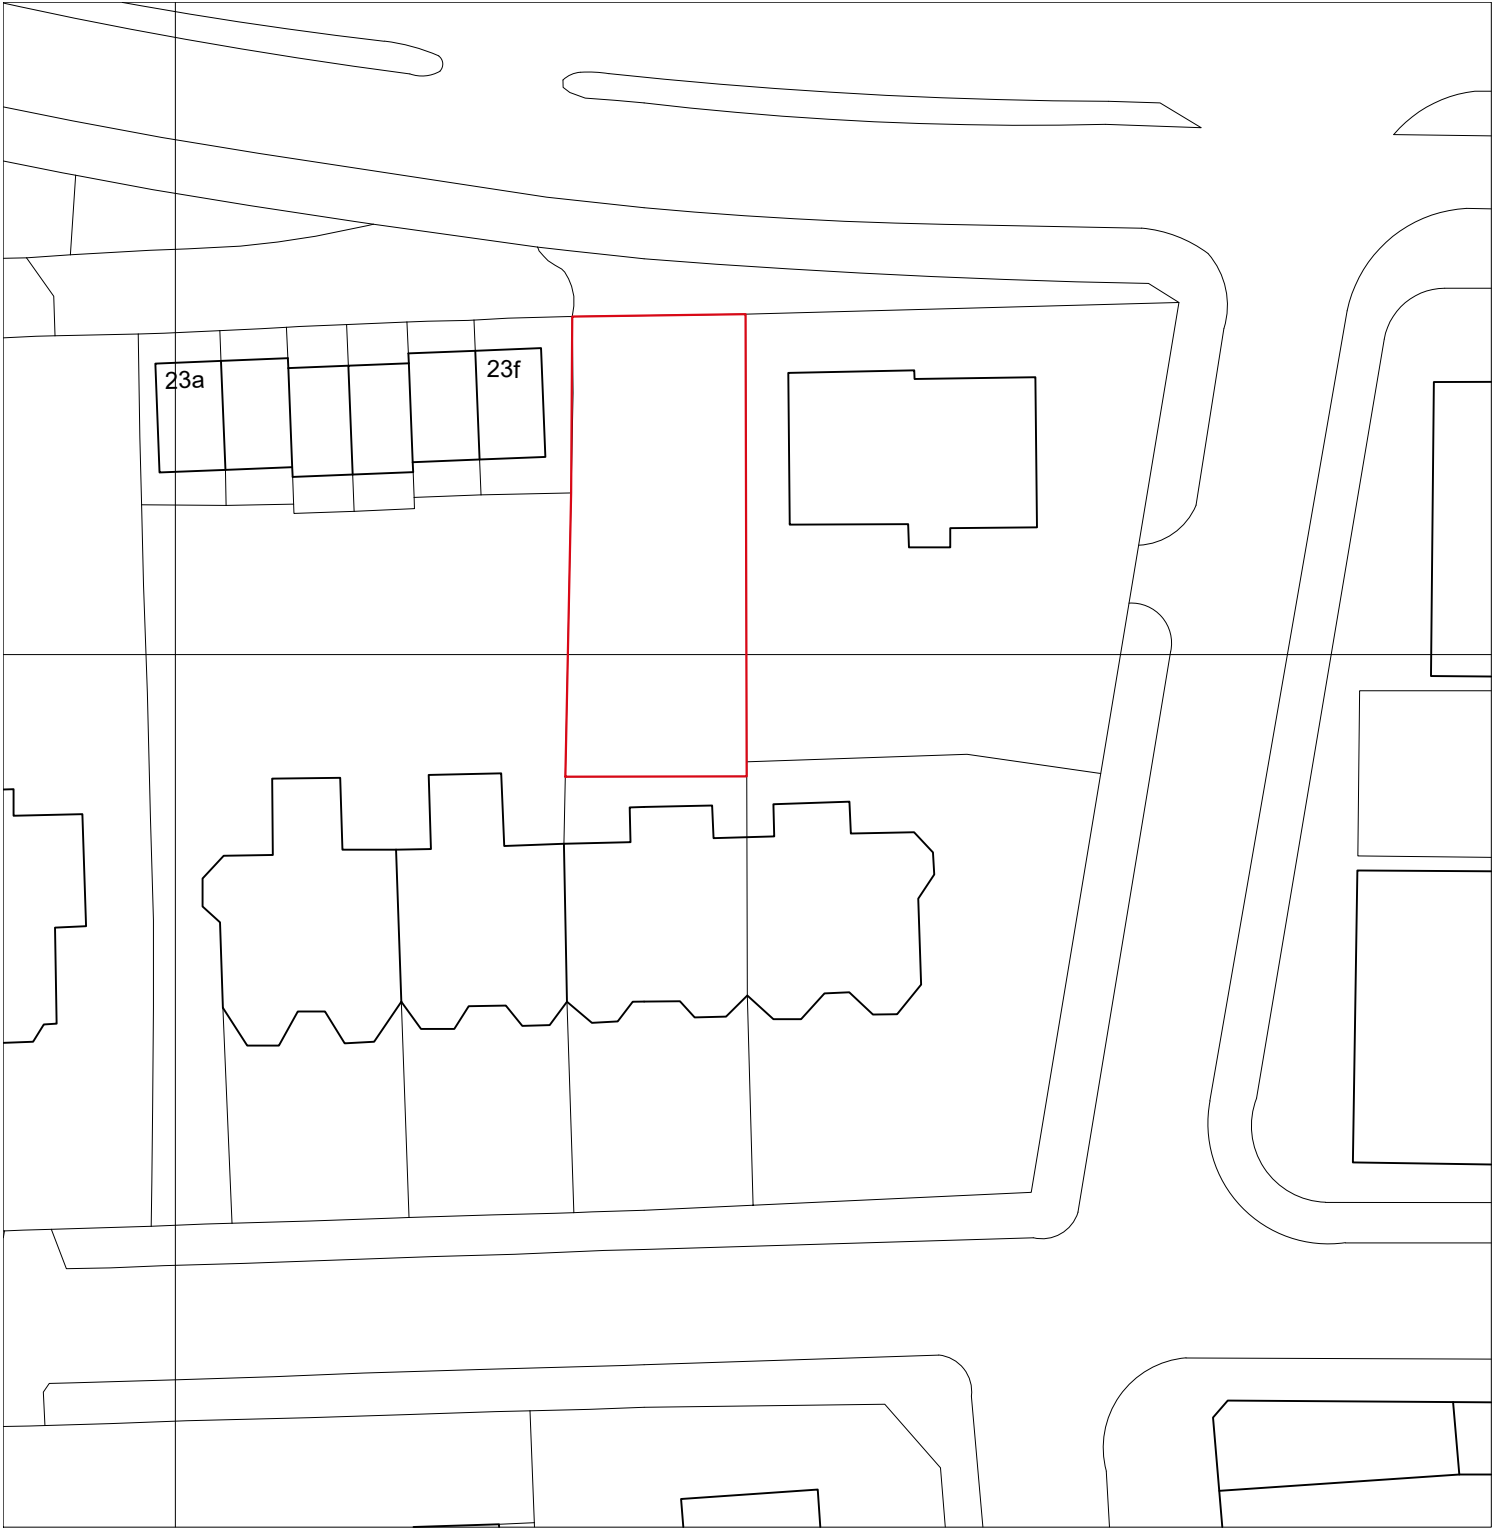

PROJECT				66 & 68 Moseley rd, Fallowfield.	
SCALE 1 : 500 @ A4			CLIENT AIRSHACK LTD		
DWG No. 169-SK-GL1					
CONTRACT NO: 169		STAGE CODE sketch	REV. -	DRAWING TITLE O.S. Location plan	
ISSUED	20/07/24		-	sj simon james architect	

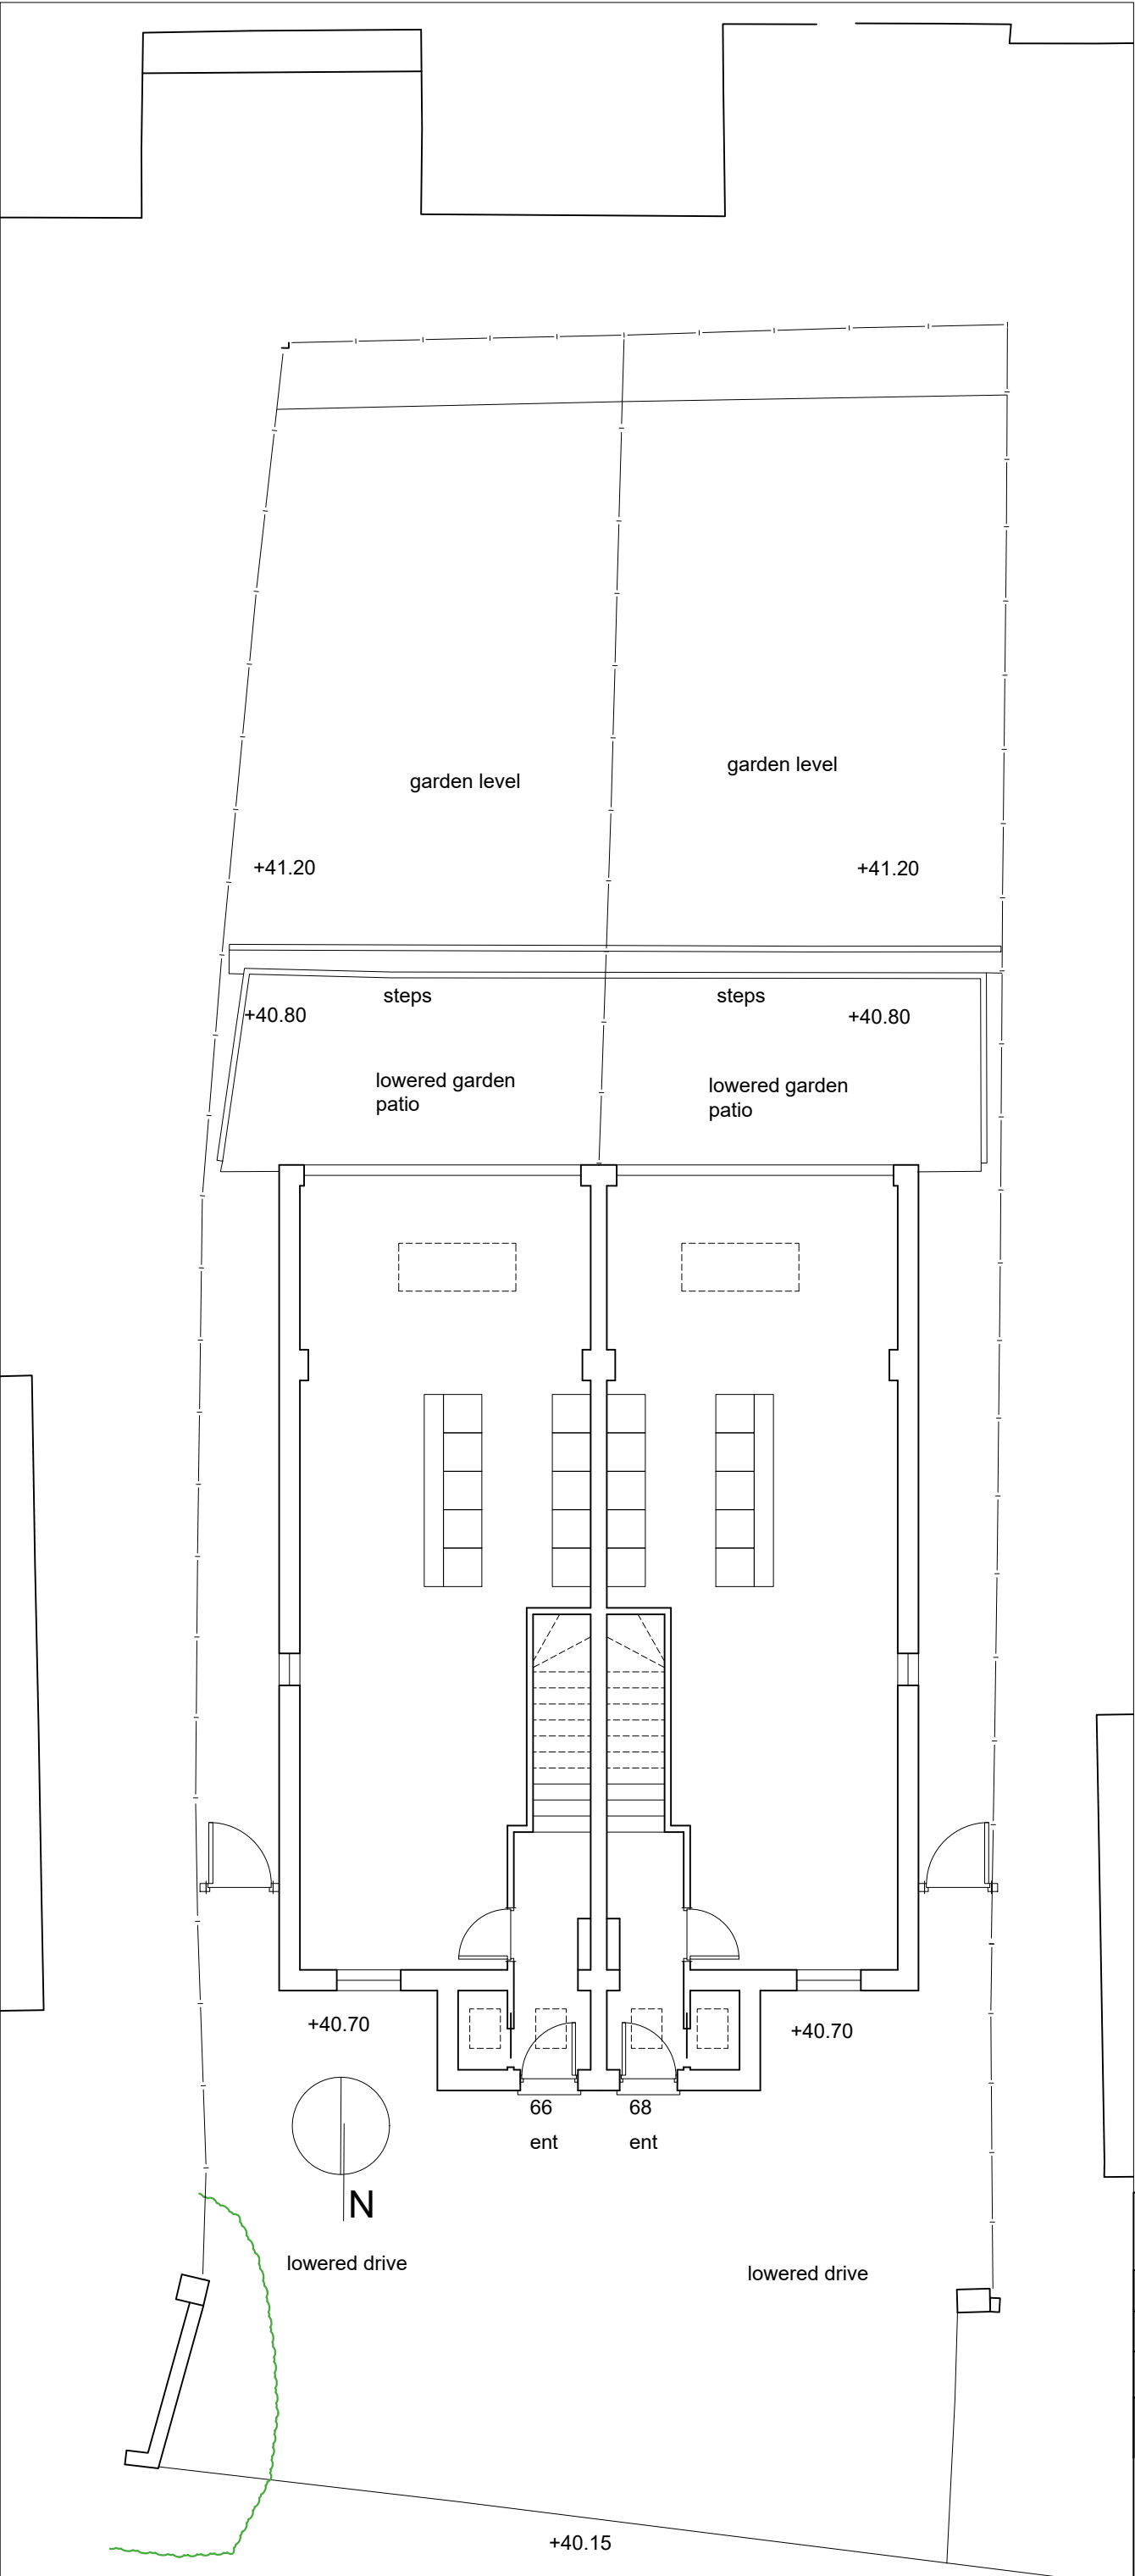


PROJECT				66 & 68 Moseley rd, Fallowfield.	
SCALE		1 : 200 @ A2		CLIENT	
DWG No.		169-SK-GL1		AIRSHACK LTD	
CONTRACT NO.		STAGE CODE	REV.	DRAWING TITLE	
169		sketch	-	As built Site plan	
ISSUED	20/07/24		-	sj simon james architect	

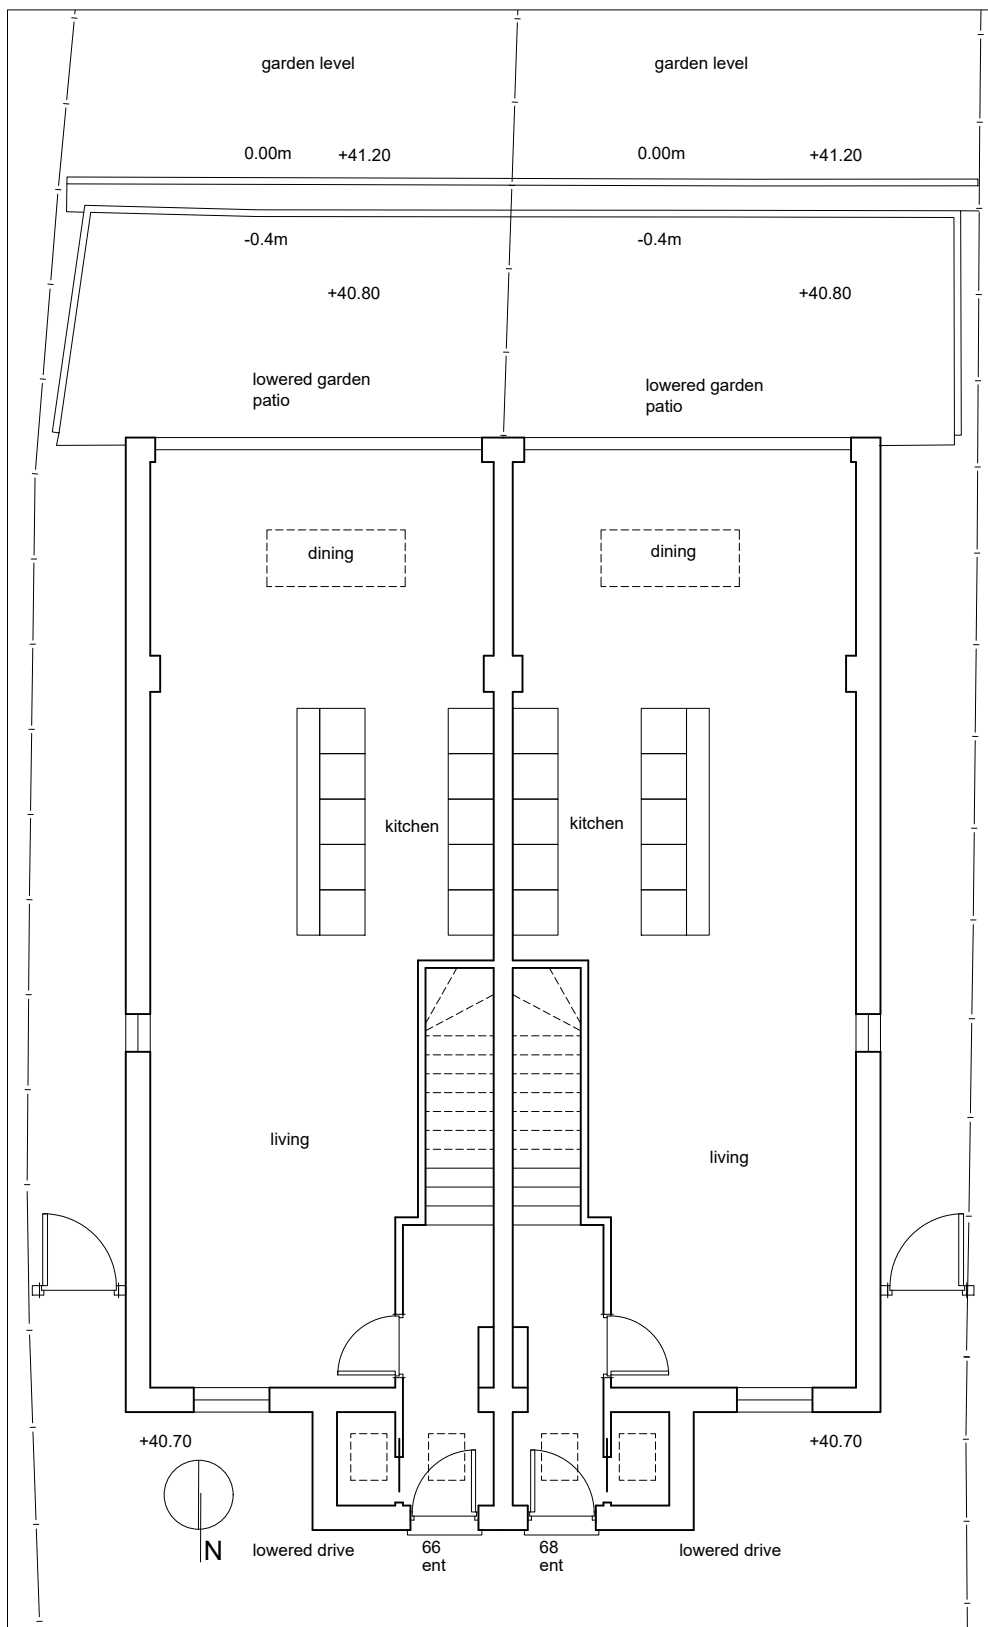


As built Grd fl plan

PROJECT			66 & 68 Moseley rd, Fallowfield.		
SCALE		1 : 100 @ A4		CLIENT AIRSHACK LTD	
DWG No.		169-SK-GA1			
CONTRACT NO:		STAGE CODE	REV.	DRAWING TITLE	
169		sketch	-	As built Grd fl plan	
ISSUED	20/07/24		-	sj simon james architect	

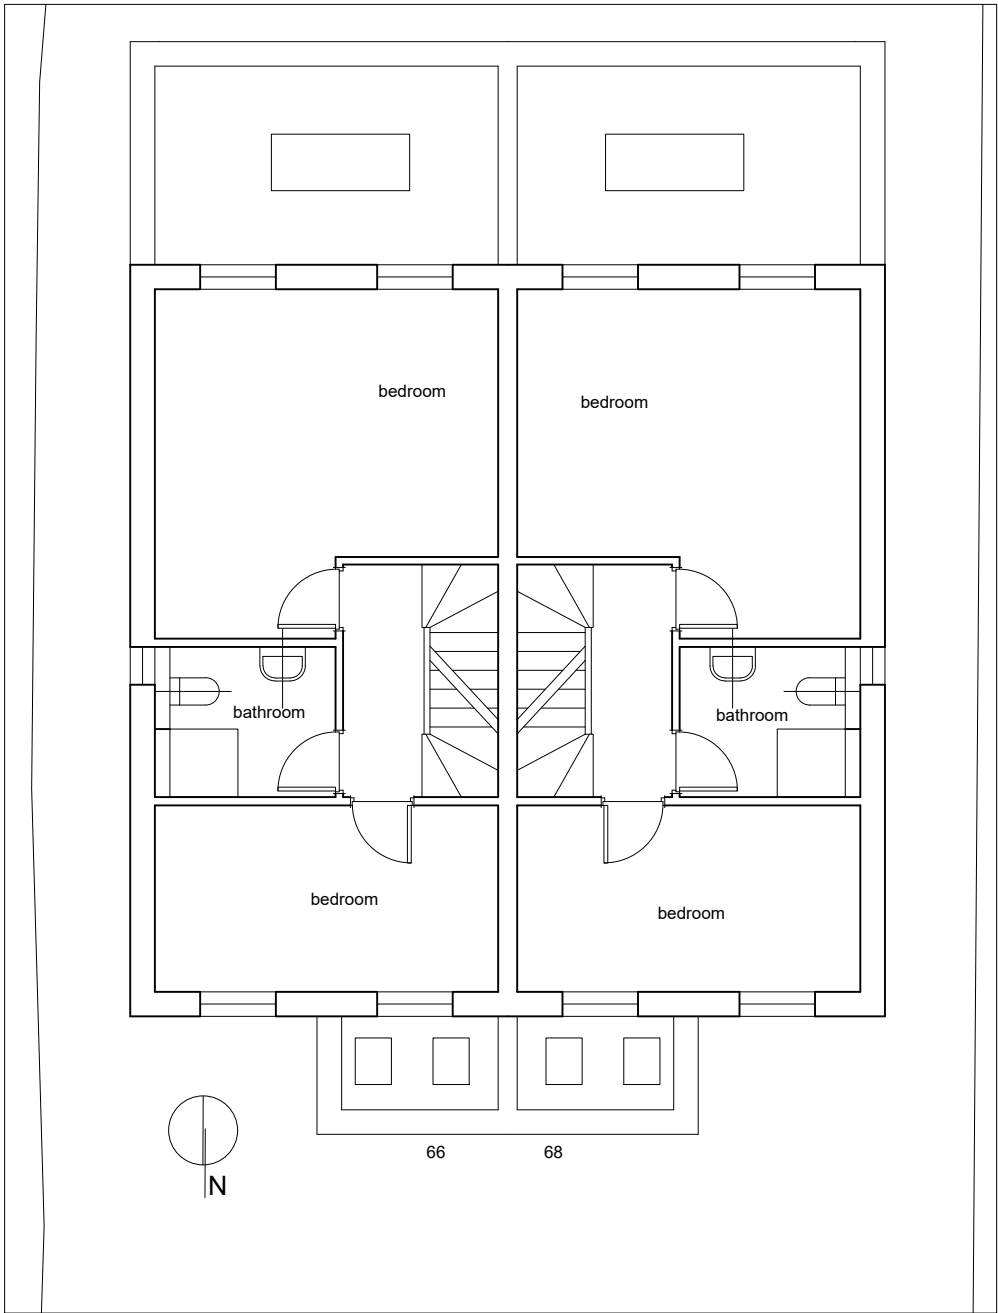


As built 1st fl plan

PROJECT			
66 & 68 Moseley rd, Fallowfield.			
SCALE		CLIENT	
1 : 100 @ A4		AIRSHACK LTD	
DWG No.		DRAWING TITLE	
169-SK-GA2		As built 1st fl plan	
CONTRACT NO:	STAGE CODE	REV.	
169	sketch	-	
ISSUED	20/07/24	-	sj simon james architect

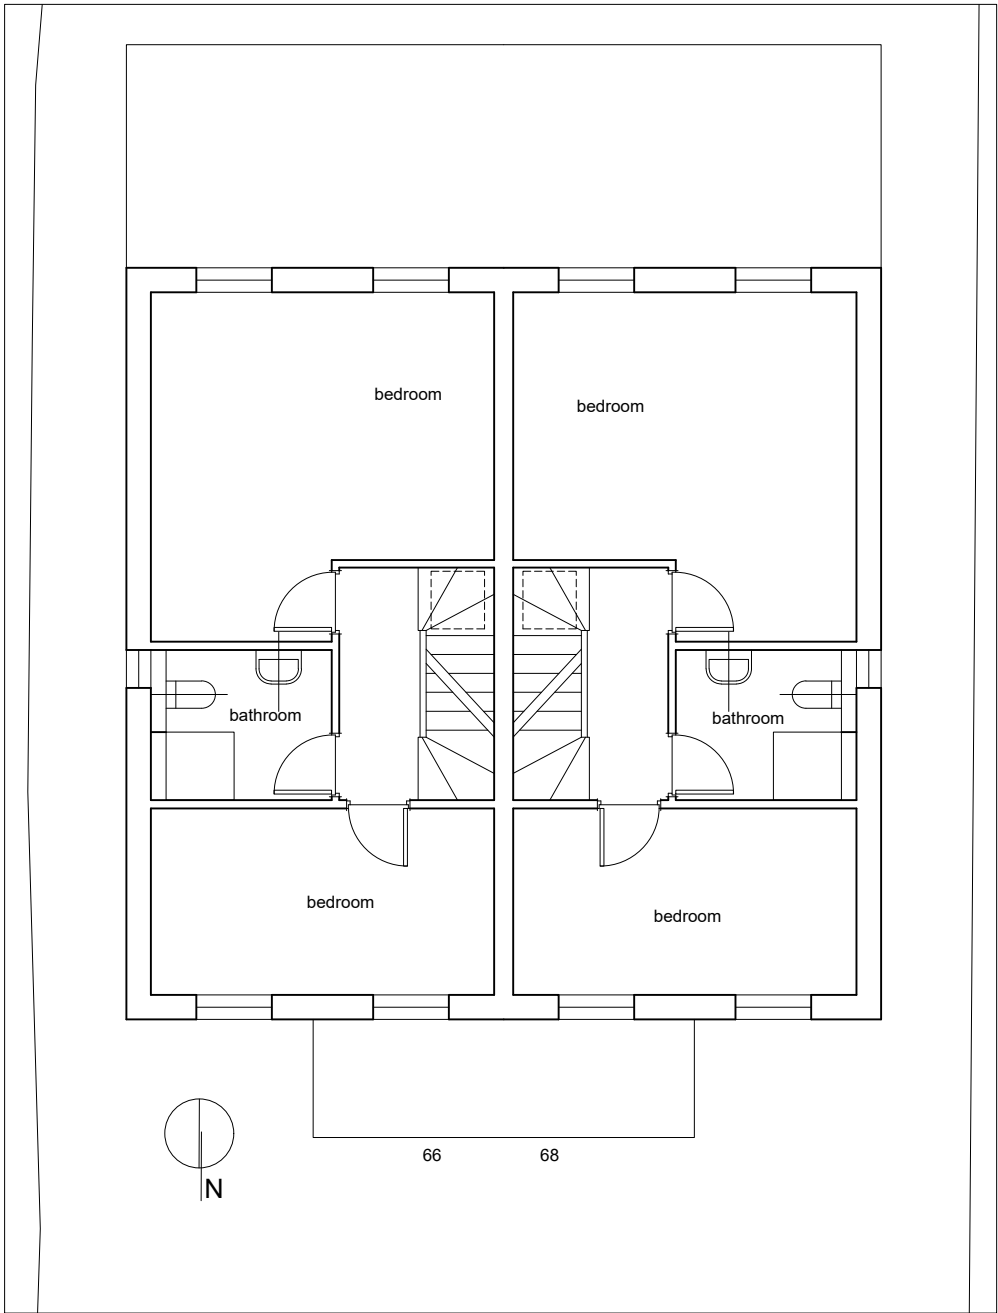


As built 2nd fl plan

PROJECT				66 & 68 Moseley rd, Fallowfield.	
SCALE 1 : 100 @ A4			CLIENT AIRSHACK LTD		
DWG No. 169-SK- GA3					
CONTRACT NO: 169		STAGE CODE sketch	REV. -	DRAWING TITLE As built 2nd fl plan	
ISSUED	20/07/24		-	sj simon james architect	

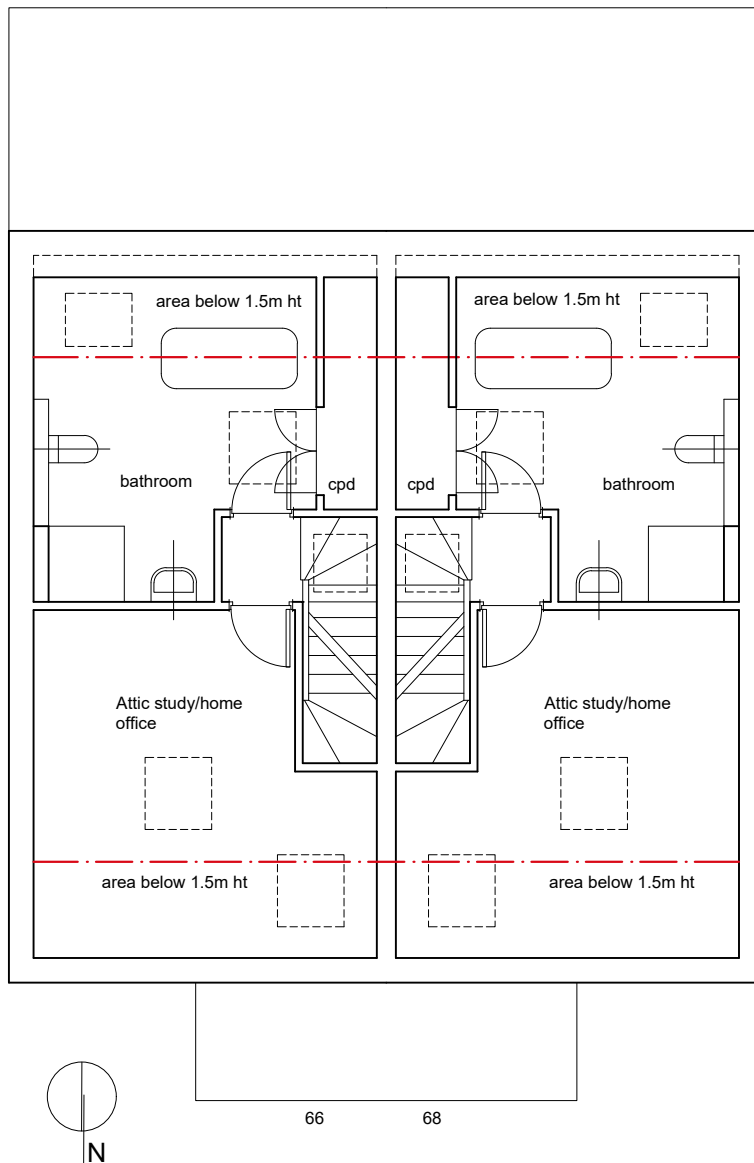


As built Attic fl plan


PROJECT				66 & 68 Moseley rd, Fallowfield.			
SCALE 1 : 100 @ A4			CLIENT AIRSHACK LTD				
DWG No. 169-SK- GA4							
CONTRACT NO: 169		STAGE CODE sketch	REV. -	DRAWING TITLE As built Attic fl plan			
ISSUED	20/07/24		-	sj simon james architect			

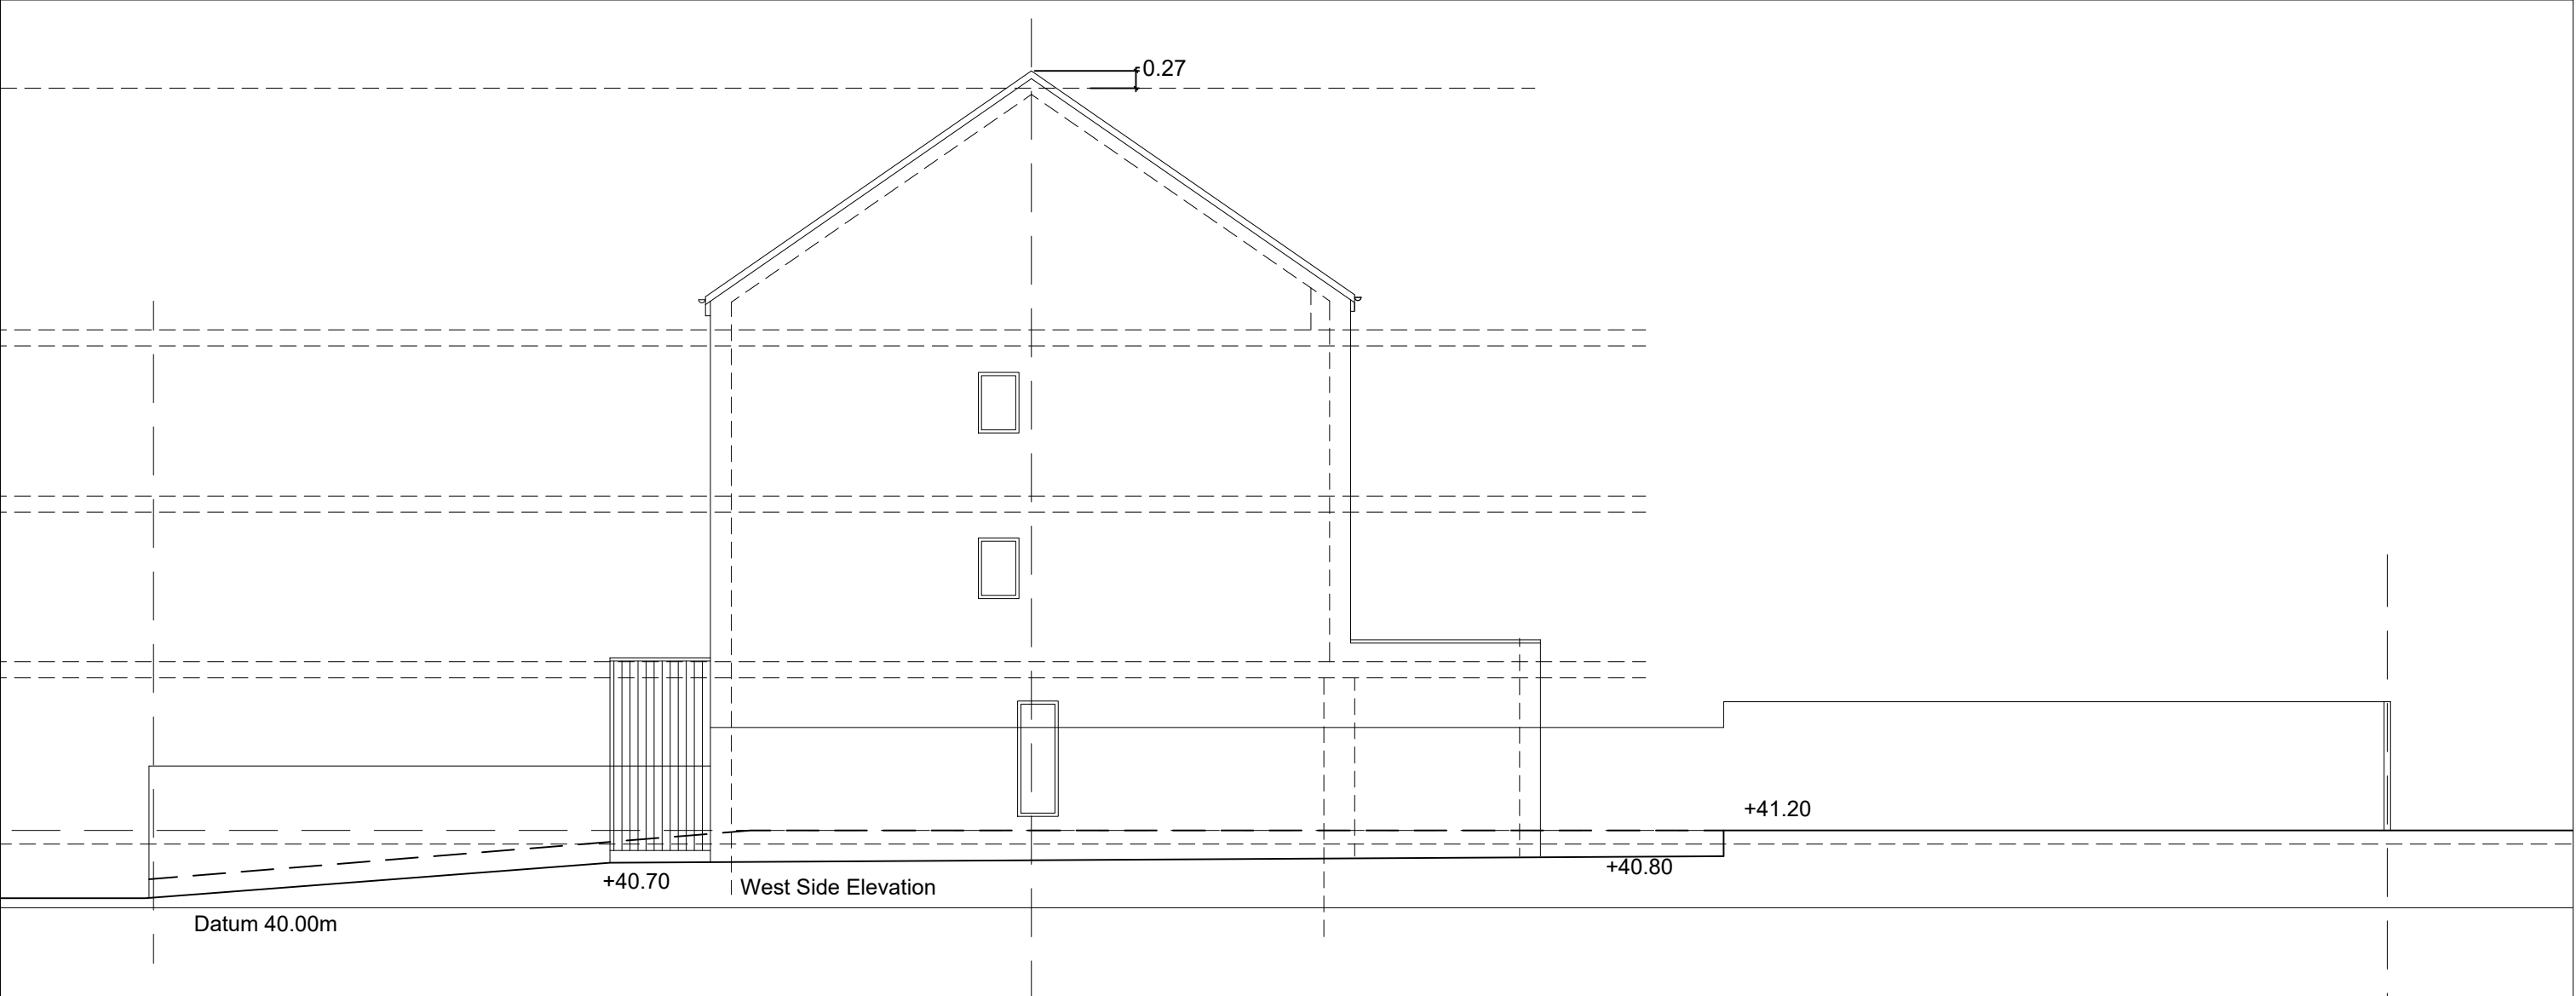


PROJECT			66 & 68 Moseley rd, Fallowfield.		
SCALE		1 : 100 @ A3		CLIENT	
DWG No.		169-SK- ELE1		AIRSHACK LTD	
CONTRACT NO:		STAGE CODE	REV.	DRAWING TITLE	
169		sketch	-	As built West Elevation	
ISSUED	20/07/24		-	sj simon james architect	

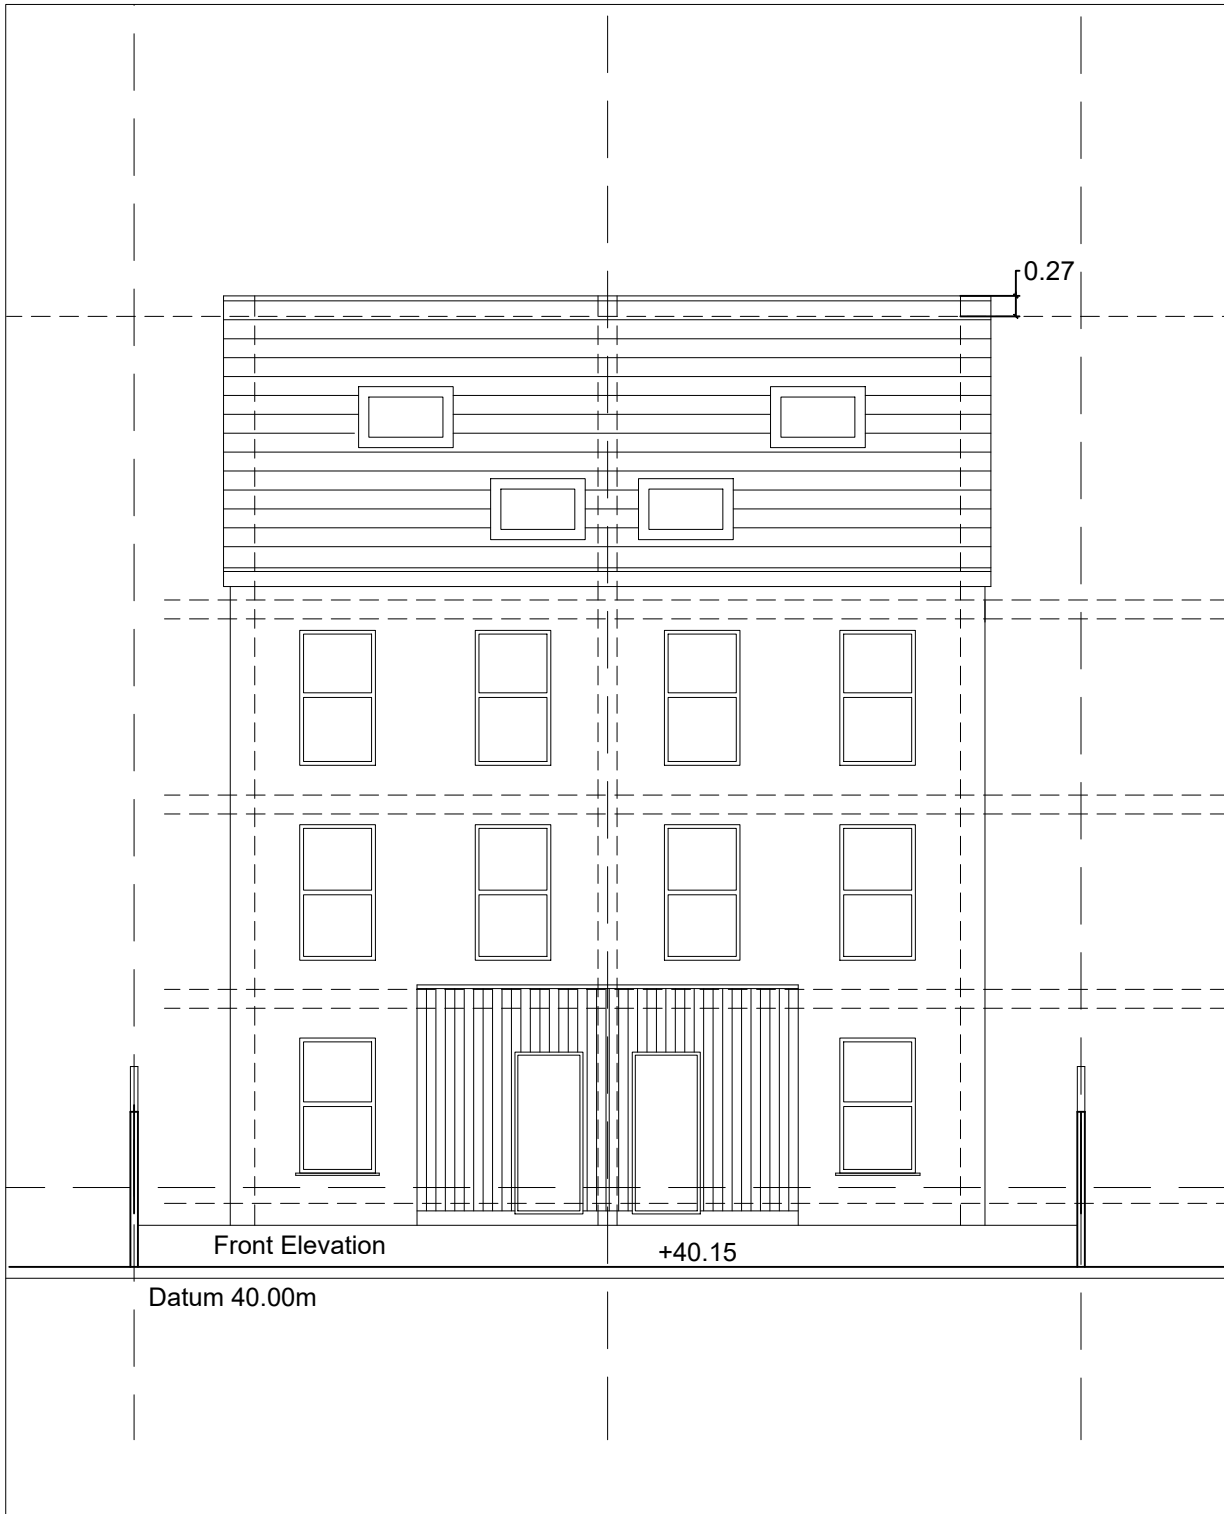

PROJECT			66 & 68 Moseley rd, Fallowfield.		
SCALE		1 : 100 @ A3		CLIENT AIRSHACK LTD	
DWG No.		169-SK-ELE2			
CONTRACT NO.		STAGE CODE	REV.	DRAWING TITLE	
169		sketch	-	As built Front Elevation	
ISSUED	20/07/24		-	sj simon james architect	

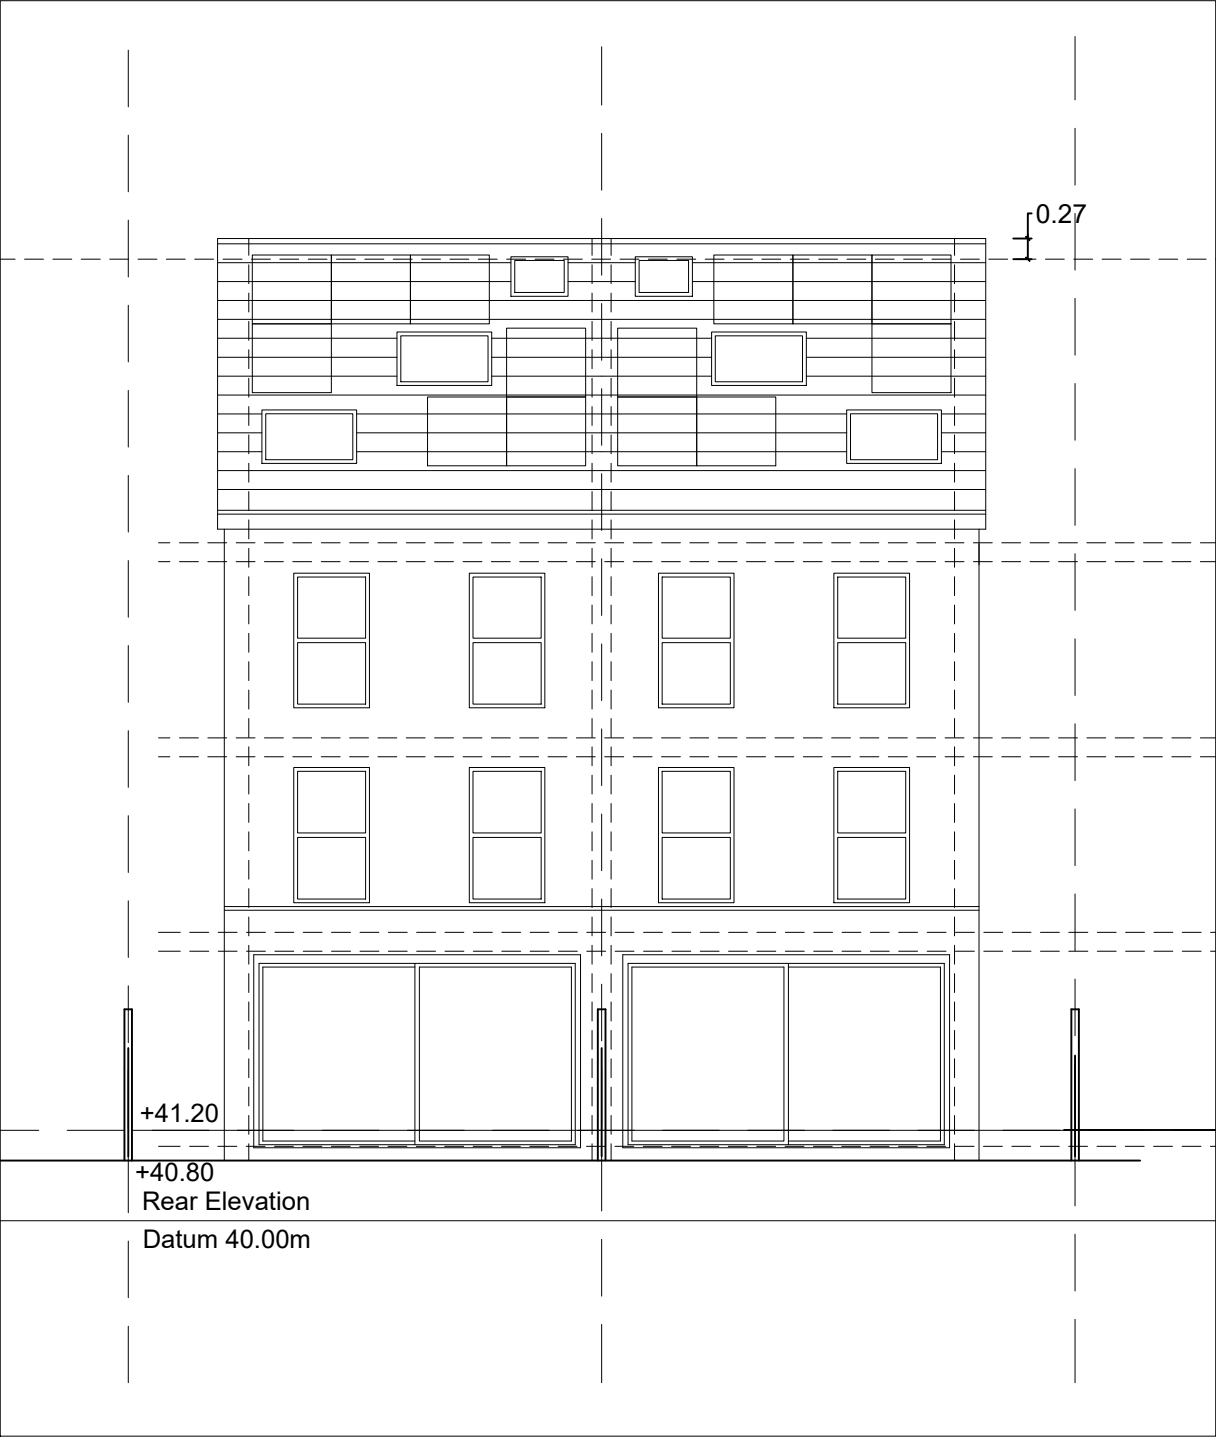

PROJECT				66 & 68 Moseley rd, Fallowfield.	
SCALE		1 : 100 @ A3		CLIENT	
DWG No.		169-SK-ELE3		AIRSHACK LTD	
CONTRACT NO.		STAGE CODE	REV.	DRAWING TITLE	
169		sketch	-	As built Rear Elevation	
ISSUED	20/07/24		-	sj simon james architect	

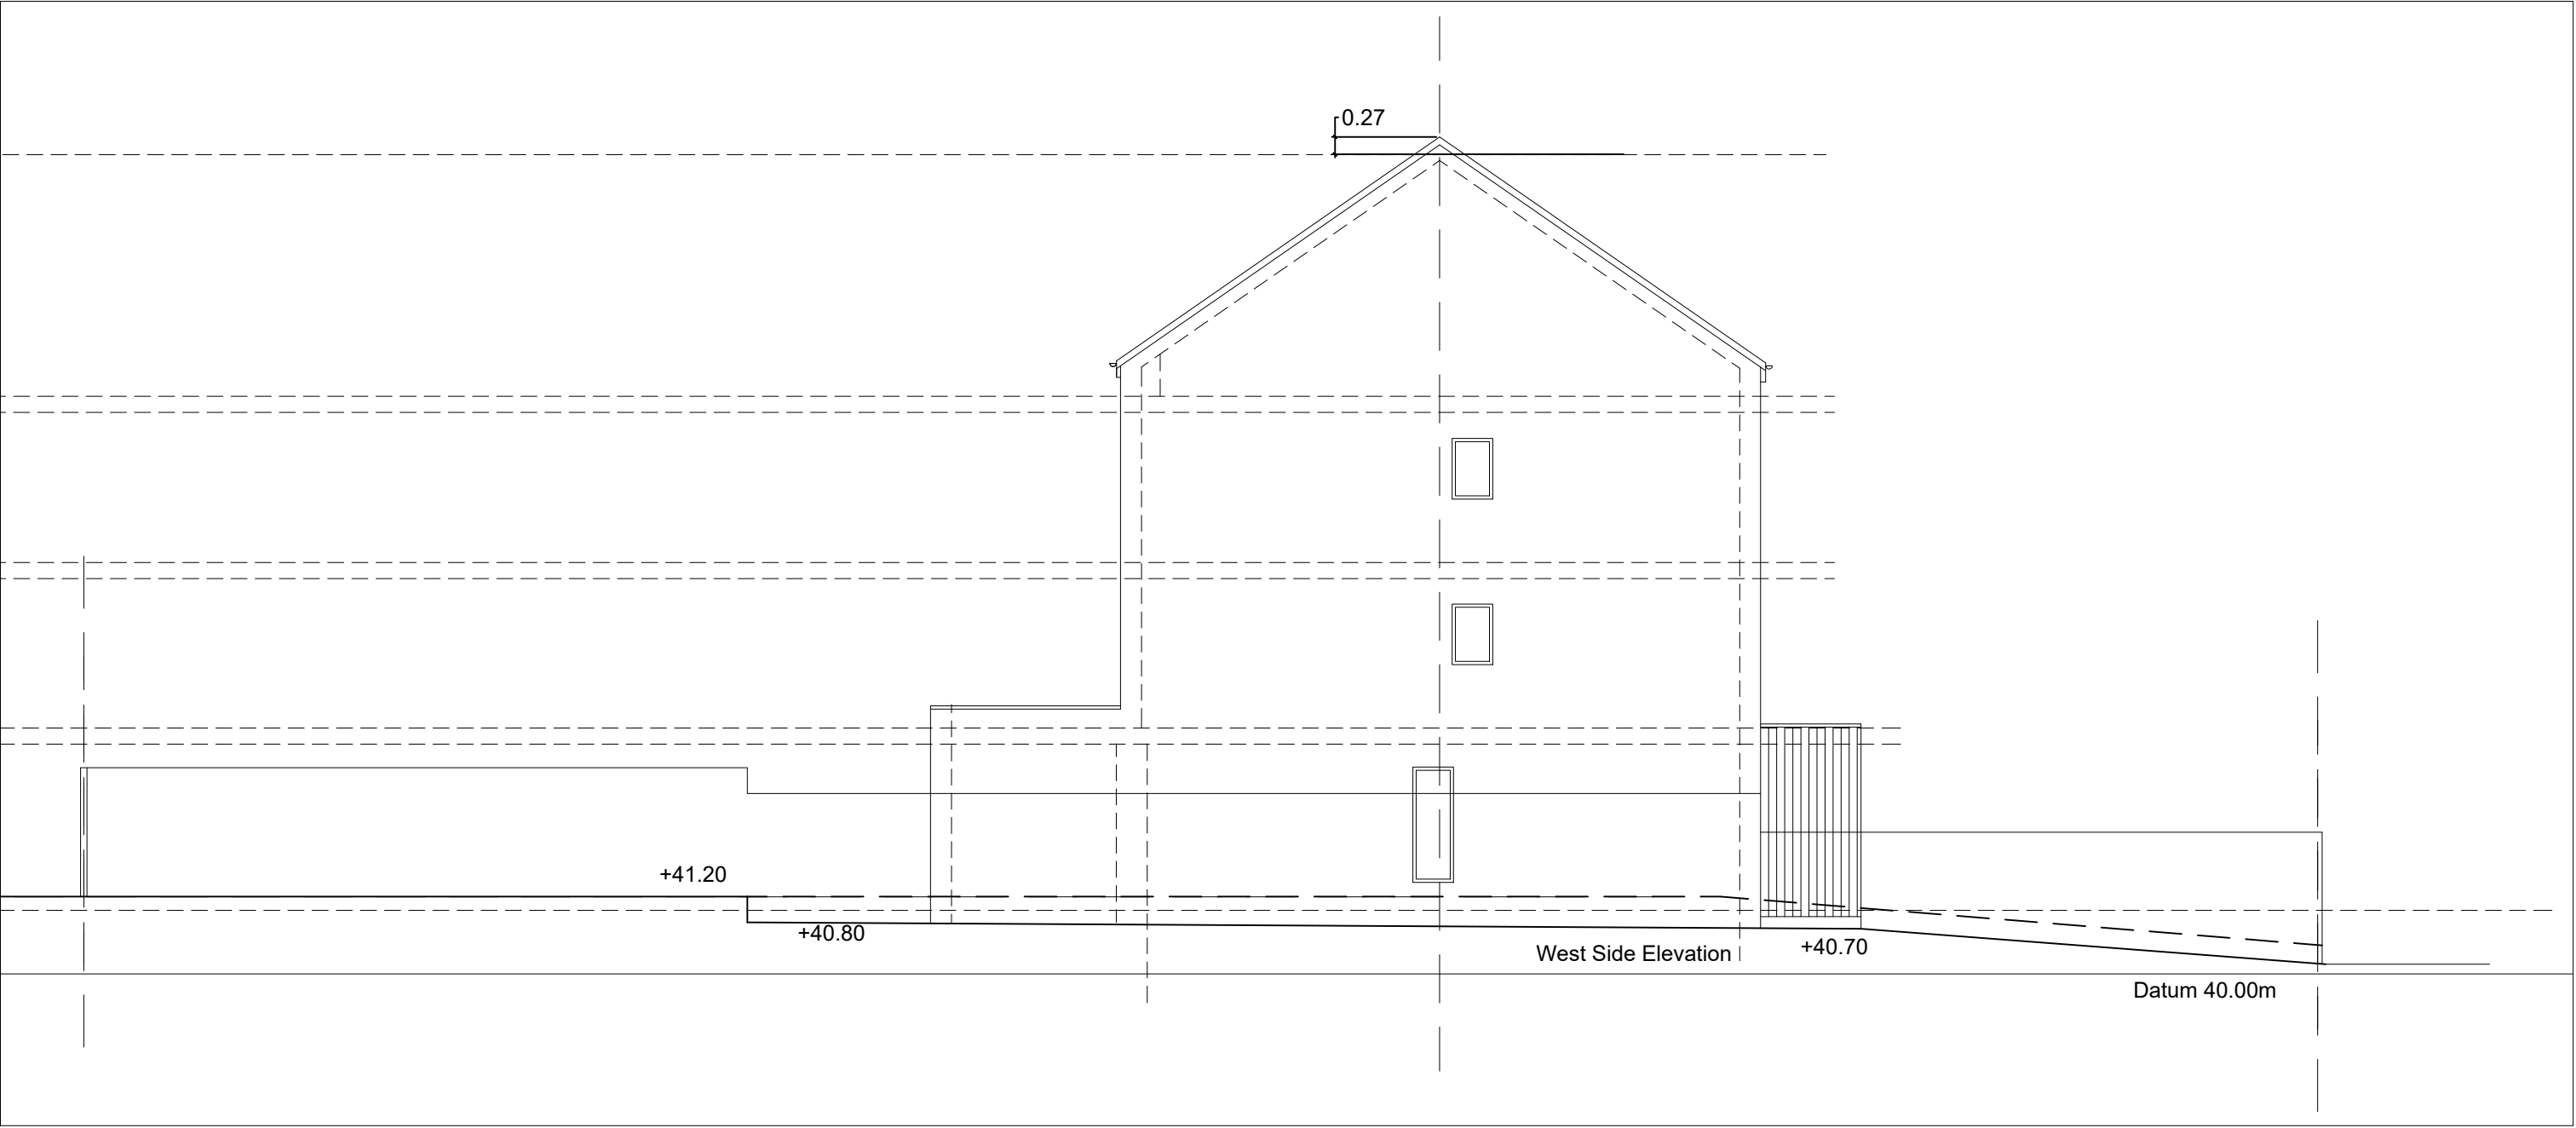

PROJECT				66 & 68 Moseley rd, Fallowfield.	
SCALE		1 : 100 @ A3		CLIENT	
DWG No.		169-SK- ELE4		AIRSHACK LTD	
CONTRACT NO.		STAGE CODE	REV.	DRAWING TITLE	
169		sketch	-	As built East Elevation	
ISSUED	20/07/24		-	sj simon james architect	