

SKETCH

Please note this is a sketch drawing and any information contained on it should be taken as indicative.


Key

Clear zone behind retained facade




01 Sketch - Lever Street - Retained Facade Elevation

1 : 50

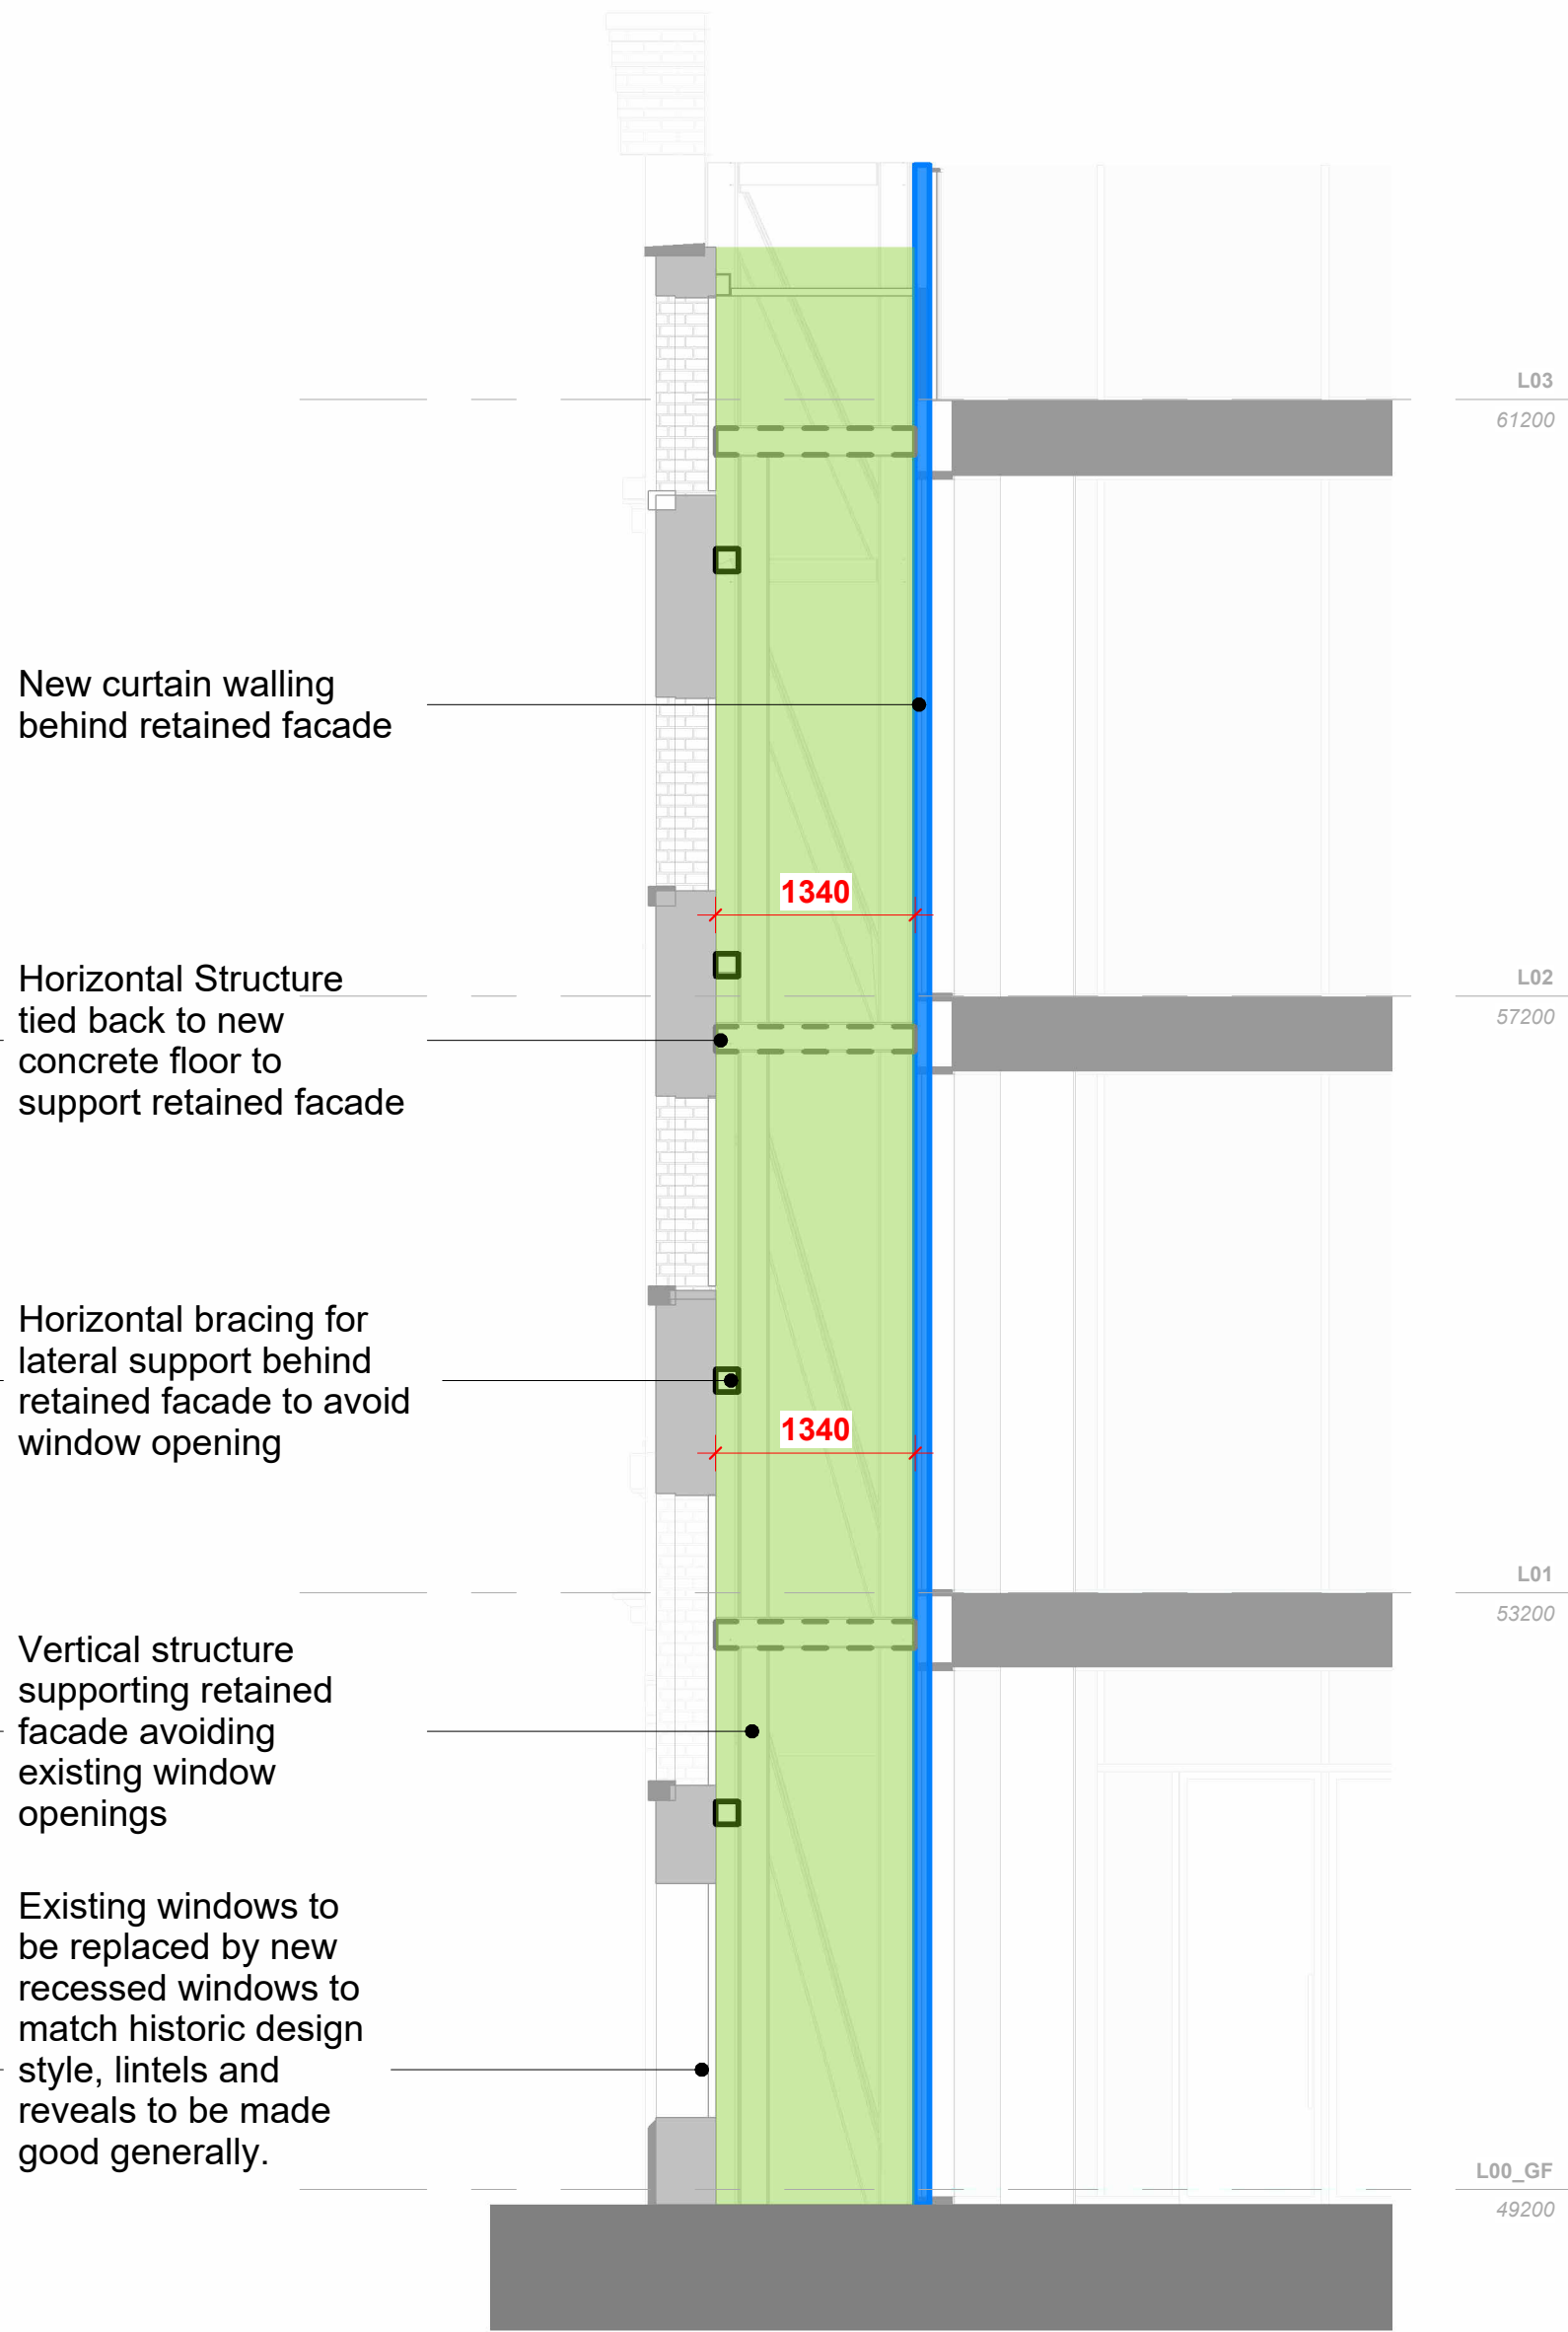

02 Sketch - Lever Street Retained Facade Section

1 : 50

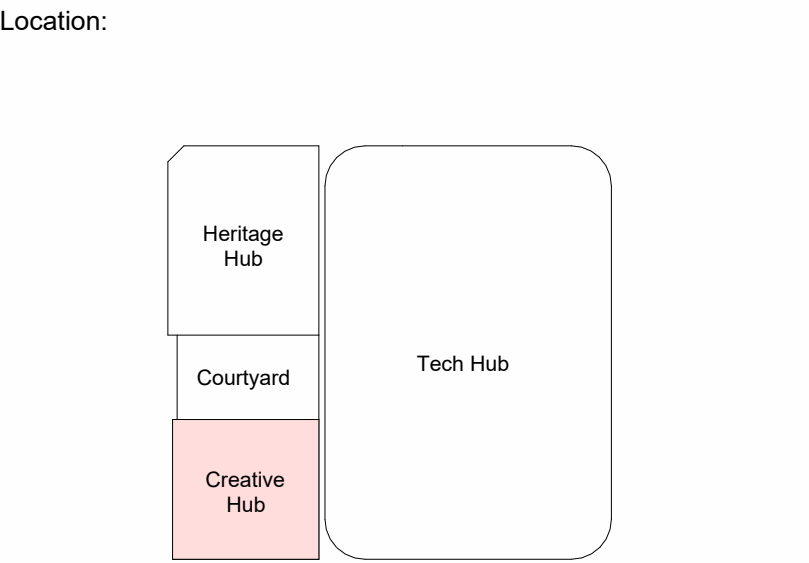

Status:

Revision History:	Checked: Checker
P01 Planning Update	17/09/2024 DJ
P02 Planning Update	01/11/2024 DJ

Project & Client:
Lever Street Manchester working with Soller Group

File Title: Retained Structure Mark up 01

Scale: As indicated @A1

File ID: 2510-HWS-A-SK-240916-01

Revision: P02