



NOTES
ALL DIMENSIONS TO BE CHECKED ON SITE PRIOR TO ANY MANUFACTURING OR FABRICATION AND ANY ANOMALIES TO BE BROUGHT TO THE ATTENTION OF THE ARCHITECT.



AS BUILT FRONT ELEVATION
1:50

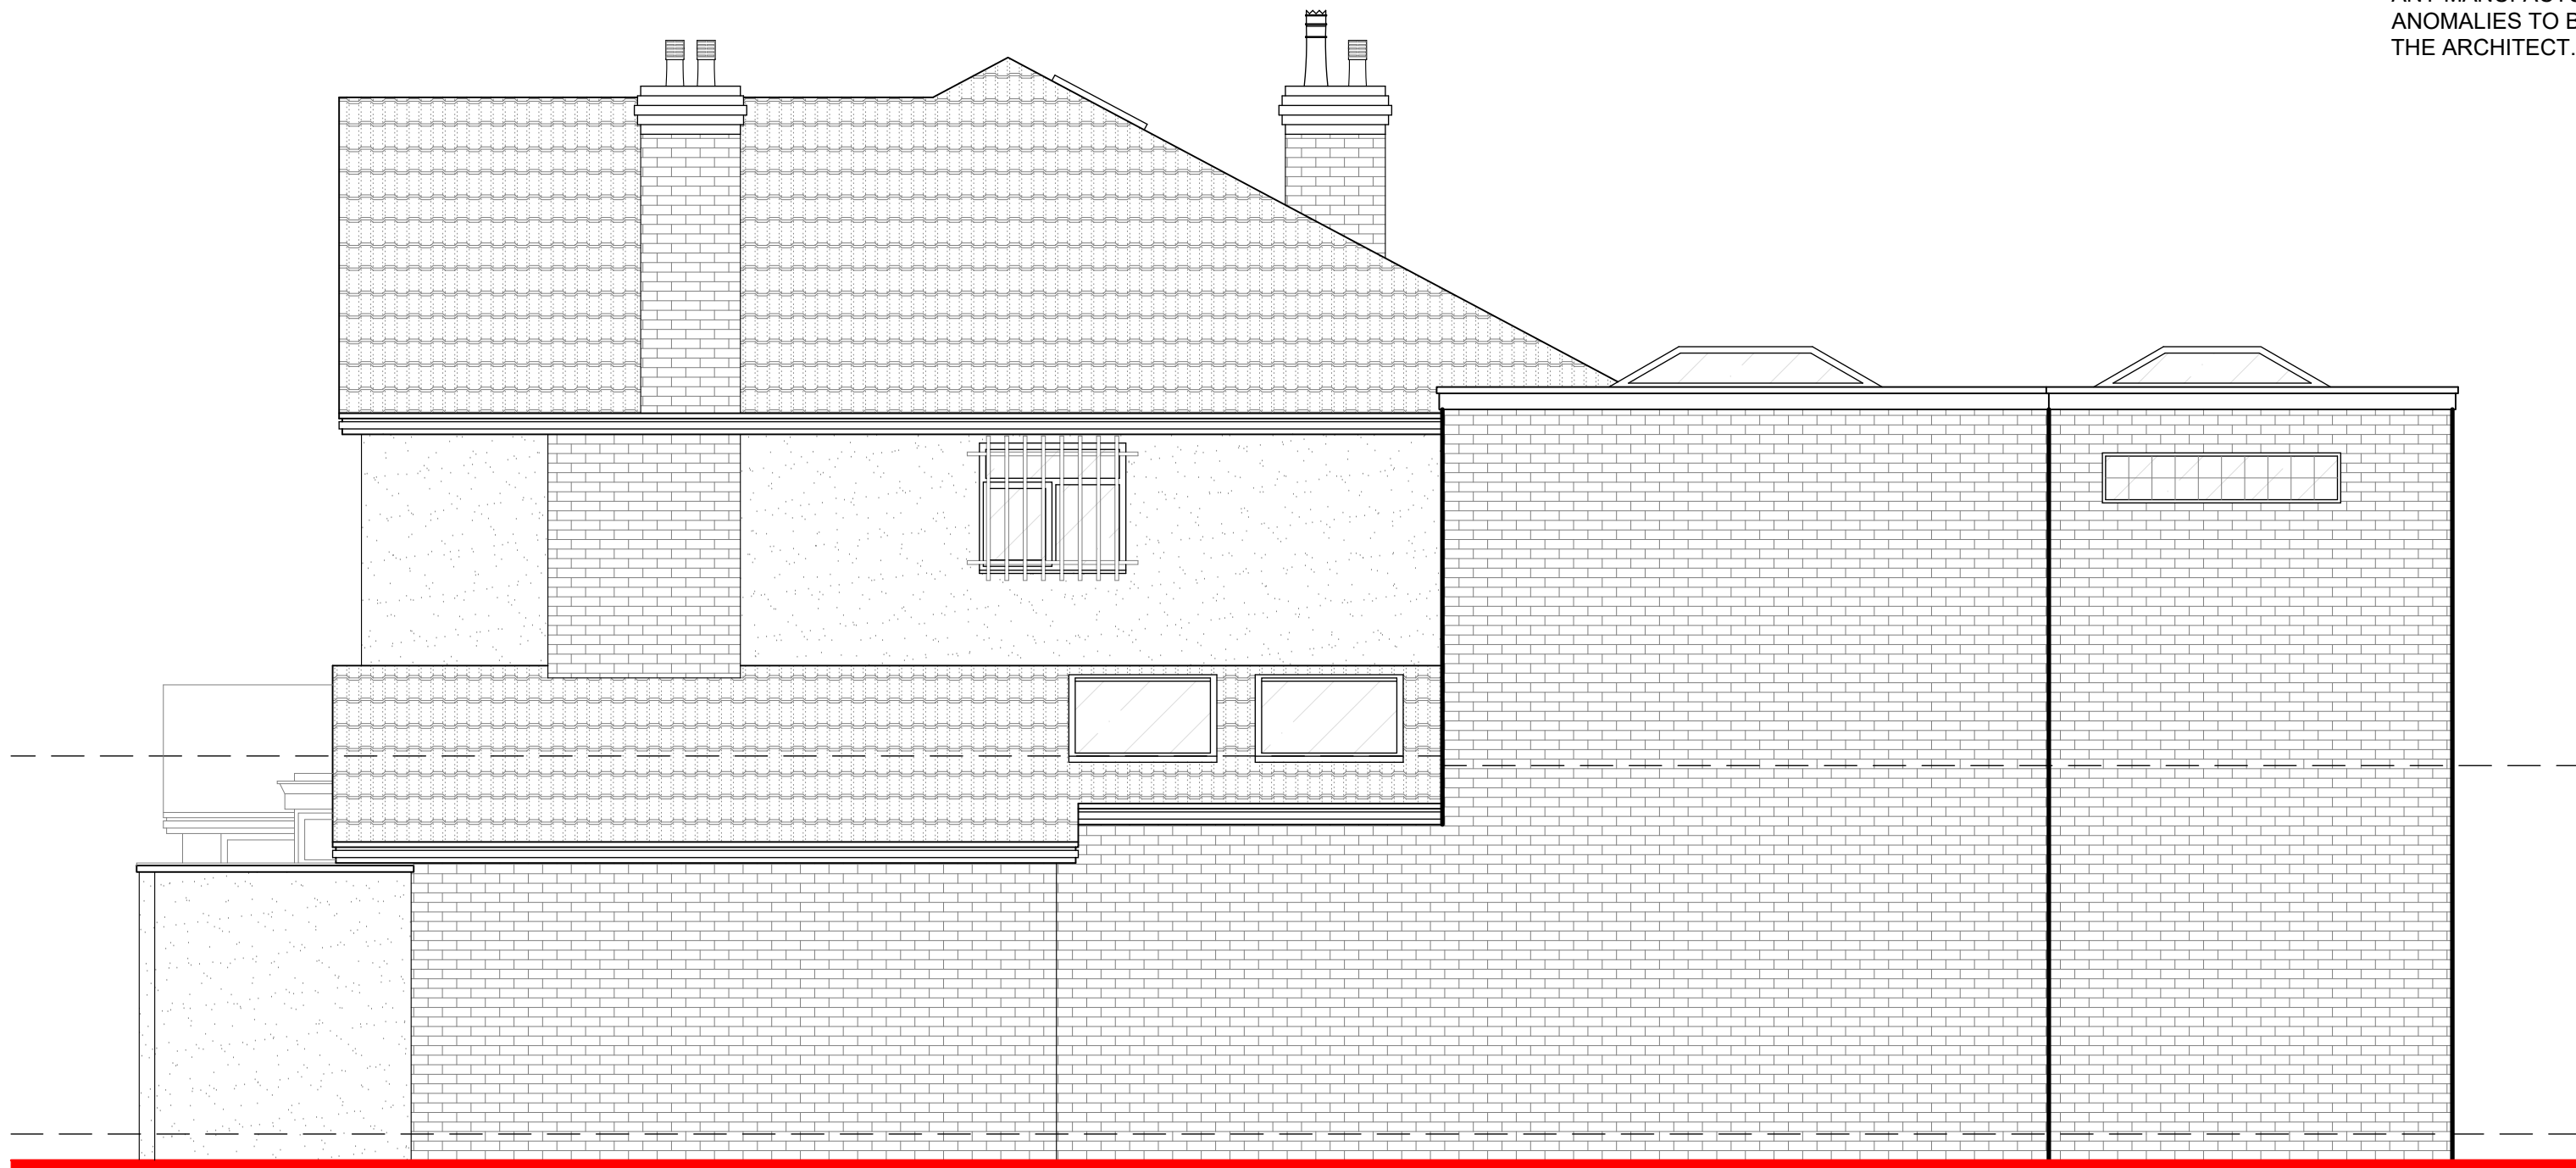

AS BUILT SIDE ELEVATION
1:50

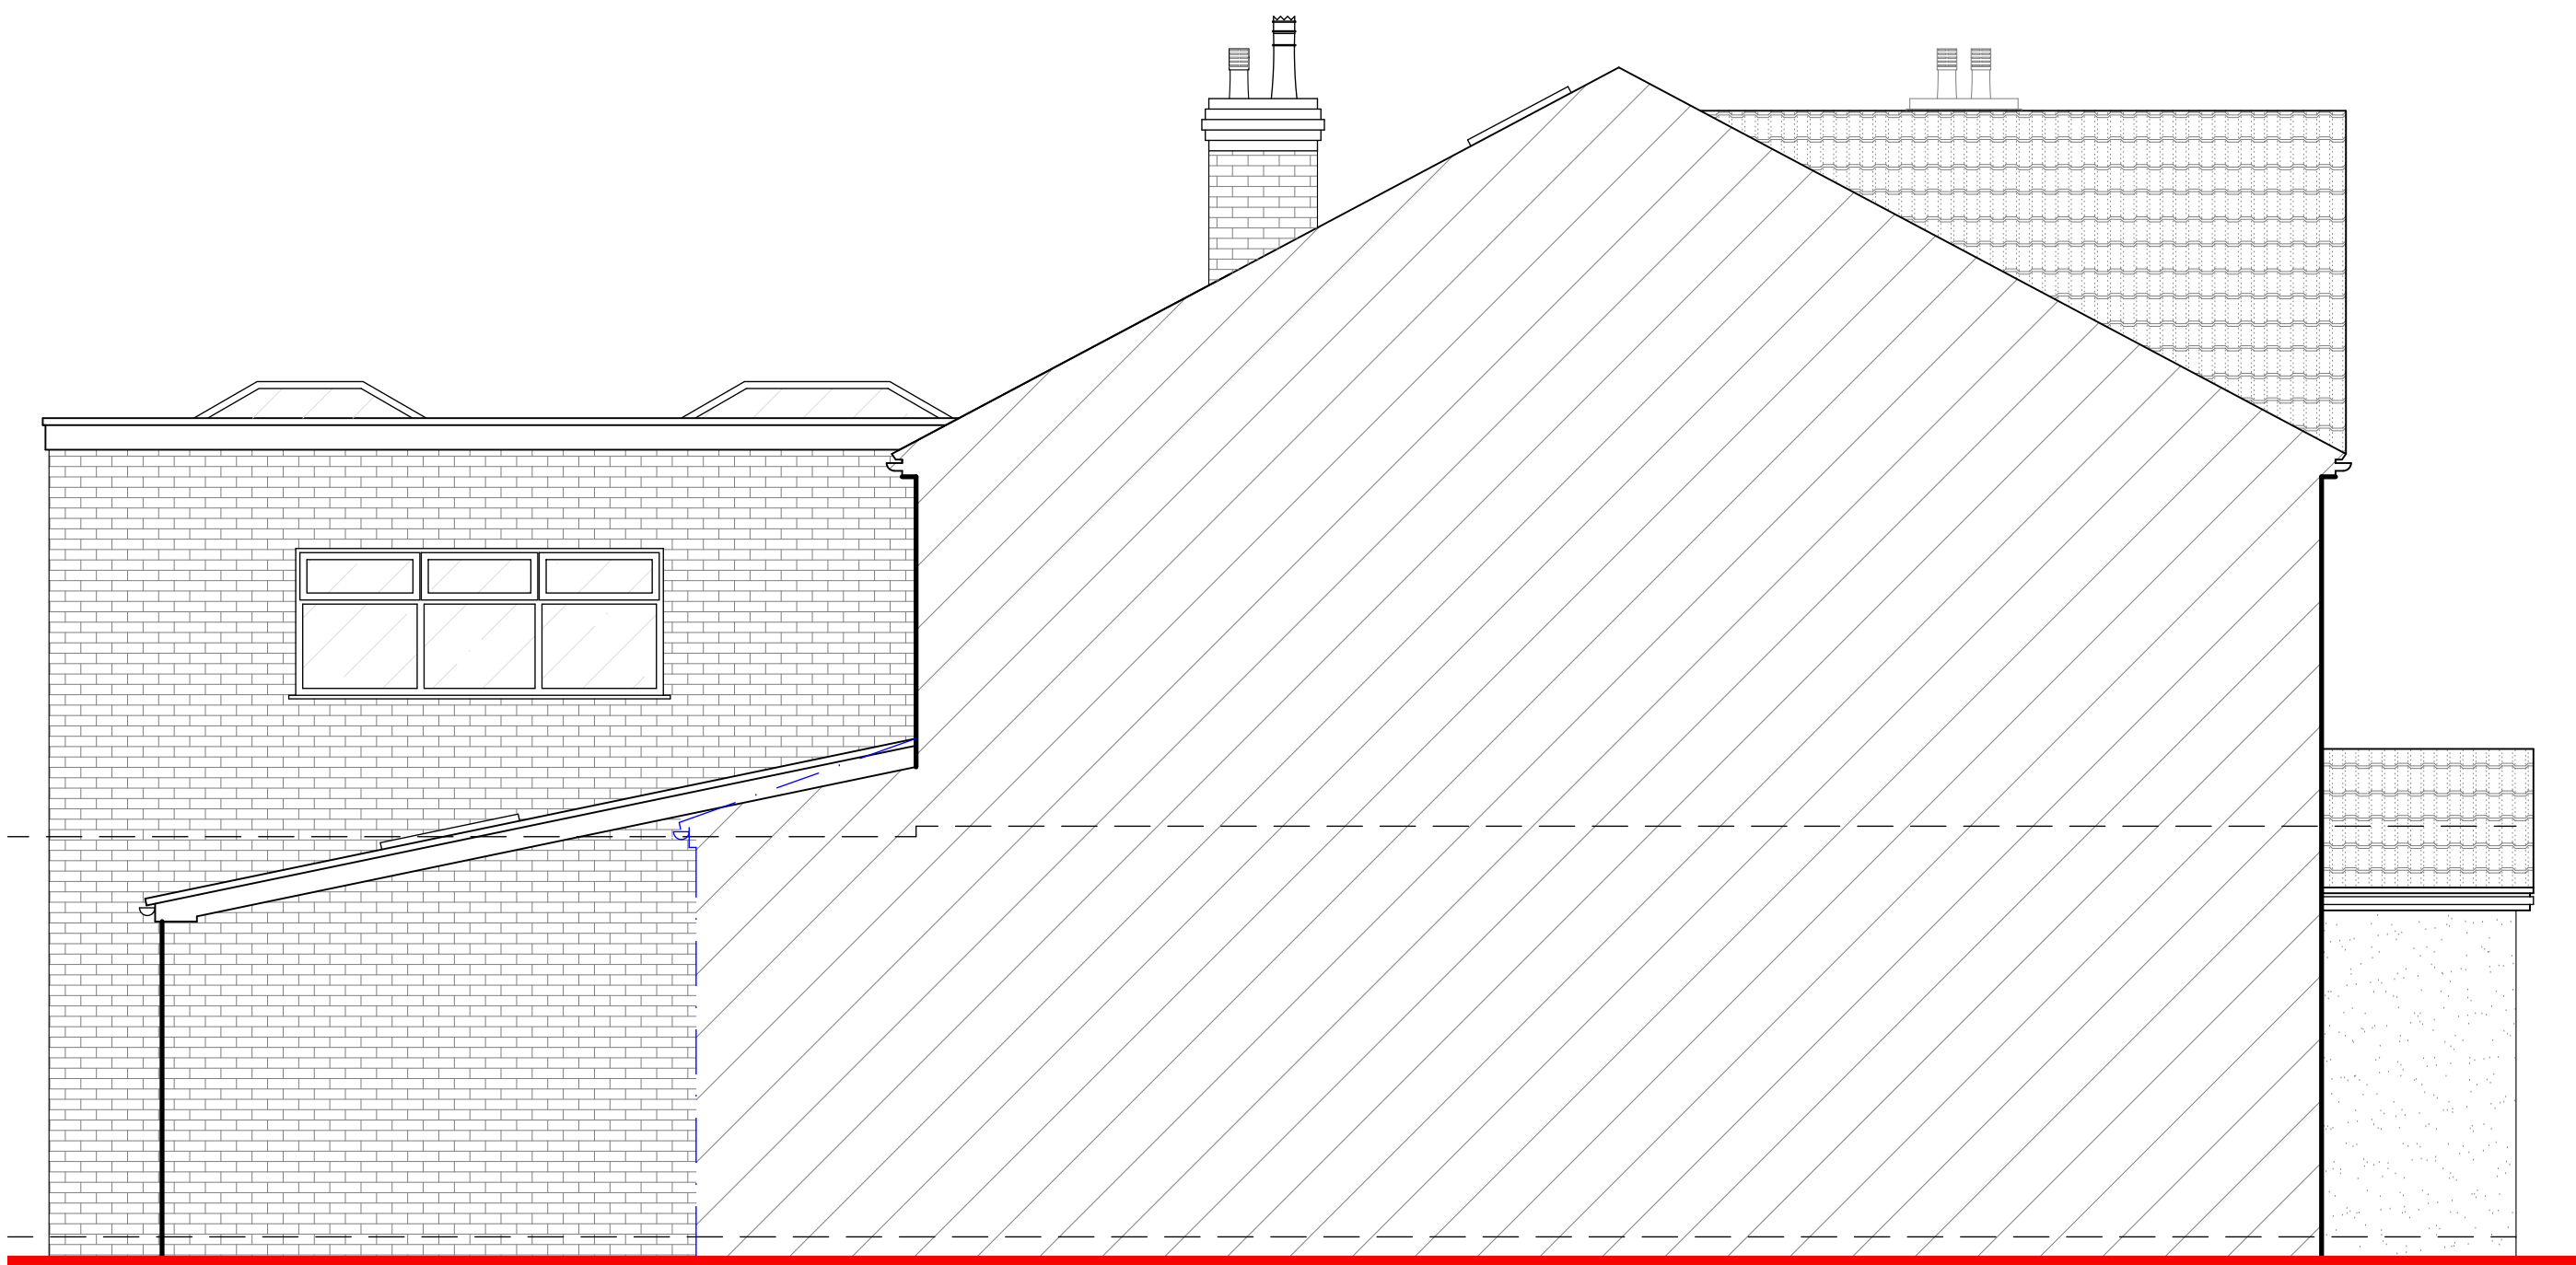

AS BUILT SIDE ELEVATION
1:50



AS BUILT REAR ELEVATION
1:50

0 1 2m
SCALE 1:50

AS BUILT ISSUE
THIS DRAWING IS A RECORD DRAWING AND IS NOT SUBJECT TO CHANGE

A	FIRST ISSUE	TB	17.12.24
REV	AMENDMENTS	BY	DATE
PROJECT			
PROPOSED ALTERATIONS/EXTENSION 77 BIRCHFIELDS ROAD LONGSIGHT MANCHESTER M13 0XX			
CLIENT			
MR MOHAMMED SHARIF			
DRAWING TITLE			
AS BUILT ELEVATIONS			
DRAWN TB		DATE 17.12.2024	
CHECKED		SCALE 1:50 (A1)	
APPROVED			
 HOWARD & SEDDON A.R.I.B.A. CHARTERED ARCHITECTS 64 WASHWAY ROAD SALE, CHESHIRE, M33 7RE TEL NO. 0161 - 973 8296 FAX NO. 0161 - 962 3485 E-MAIL : ADMIN@HOWARDANDESDDON.CO.UK			
JOB No.		DRG No.	REVISION
15,760		02	C