


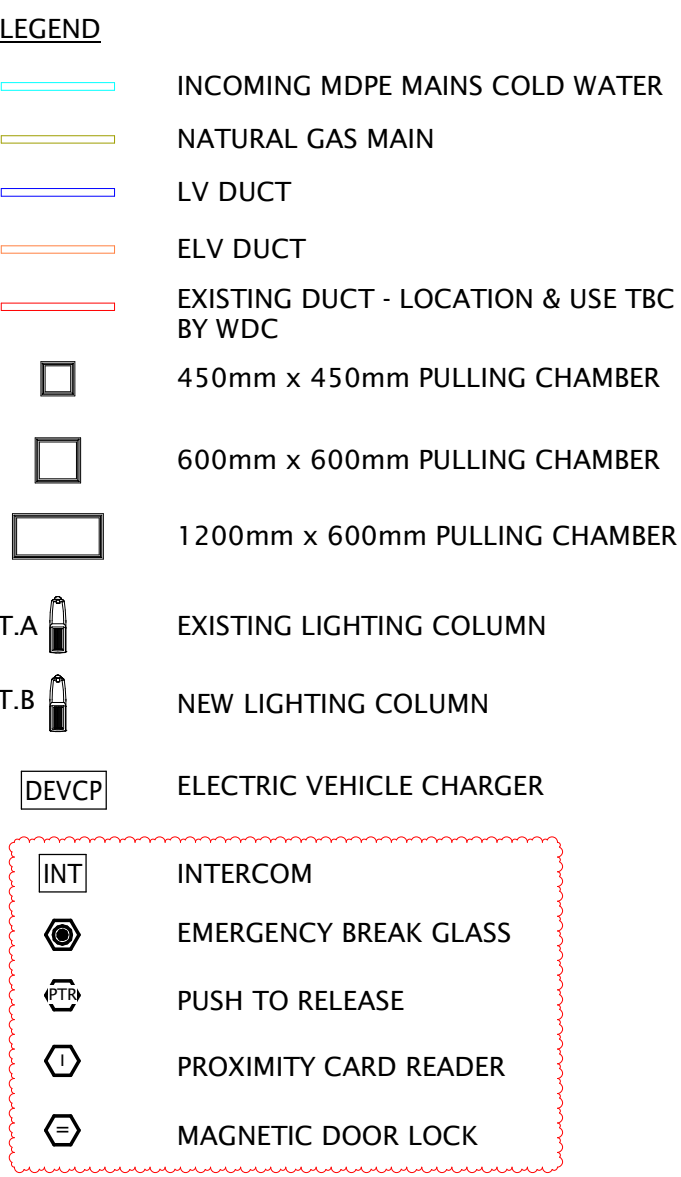

1. THIS DRAWING IS TO BE READ IN COLOUR
2. ALL DIMENSIONS ARE IN MILLIMETRES UNLESS OTHERWISE INDICATED
3. PULLING CHAMBERS TO BE INSTALLED NO MORE THAN 20M ALONG ROUTE OF DUCT
4. REFER TO INCOMING MD&S SERVICES LAYOUT CFFH2-AME-21-00-DR-ME-5001 FOR FURTHER DETAILS
5. EXISTING SERVICES FOR PHASE 1 TO BE PRESERVED ON SITE PRIOR TO ANY ADDITIONAL CONNECTIONS
6. EXTERNAL COLUMN MOUNTED CCTV LOCATIONS TO BE CONFIRMED. POSITIONS TO BE DEPENDANT ON WORKS ALONG SITE BOUNDARY
7. NJUG TRENCH DETAILS TO BE FOLLOWED FOR DEPTHS AND COLOURS OF DUCTS

3. CLIENT TO ENGAGE WITH TELECOMS PROVIDER TO CONFIRM OPTIONS FOR THE INCOMING TELEPHONE SERVICE TO BE EITHER PROTECTED OR DIVERTED.
4. DIVERT POWER AND DATA LINES LOCATED IN THE SUBSTATION FROM THE PAVING AREA TO THE PERIMETER DUCT TO RECONNECT THE PARKING BARRIER AND PERIMETER DUCT RUN.
5. REMOVE AND STORE EVC CHARGING POINTS FOR USE BY CLIENT.
6. SUBSTATION EARTH NEST HAS BEEN INSTALLED WITHIN THE SUBSTATION PAVEMENT AREA. AS PER MARKUP RECEIVED FROM WDC. WDC TO LIAISE WITH SPECIALIST TO RETEST.
7. FIRE HYDRANT LOCATION INDICATED AS PER WDC MARKUP.
8. DUCTS TO CYCLE STORE TO BE REMOVED FROM THE SUBSTATION, AND CXTY TO BE STRIPPED OUT AND RETURNED FOR CLIENT USE.
9. ANY UNDETAINED INCOMING SERVICE ROUTES TO THE BUILDING TO BE MADE GOOD / SEALED.
10. CONFIRMATION OF BEAR CAGE INTERCOM REQUIREMENTS NEEDED.
11. FOR THE EXTERNAL SERVICES POSITIONS NEED TO BE VERIFIED ON SITE BEFORE FOUNDATION INSTALLATION.
12. WDC SHALL CONFIRM LOCATION OF EXISTING DUCTS BELOW GROUND SURFACE.
13. WDC SHALL CO-ORDINATE NEW BELOW GROUND SERVICES WITH BELOW GROUND ATTENUATION TANKS.